



O.D.O.T. DISTRICT 2 SURVEY OFFICE (USE ONLY)

PERSONNEL _____ REFERENCE NO. 34 SHEET 9 OF 12
 NOTES RHOADES DATE 8/22/22 ROUTE SR 53
 H.C. NIESE WEATHER CLOUDY COUNTY OTTAWA
 R.C. AUBLE TEMP. 72° TOWNSHIP PORTAGE
 DWG BY RHOADES PID 102905 SECTION 35
 T 7 N R 17 E

TYPE MONUMENT MONBOX W/1" IPIN
 ON SURFACE - ~~BELOW~~ ON
 OFFSET \varnothing PAVEMENT 3.4' LT : ~~RT~~
9.4' TO LT EDGE PAVEMENT
 STATION: 689+13.49

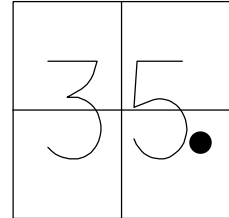

HORZ.DATUM: NAD83 2011 GEOID: NAVD88 2018
 GRID: NORTHING: 675797.596 EASTING: 1870227.193

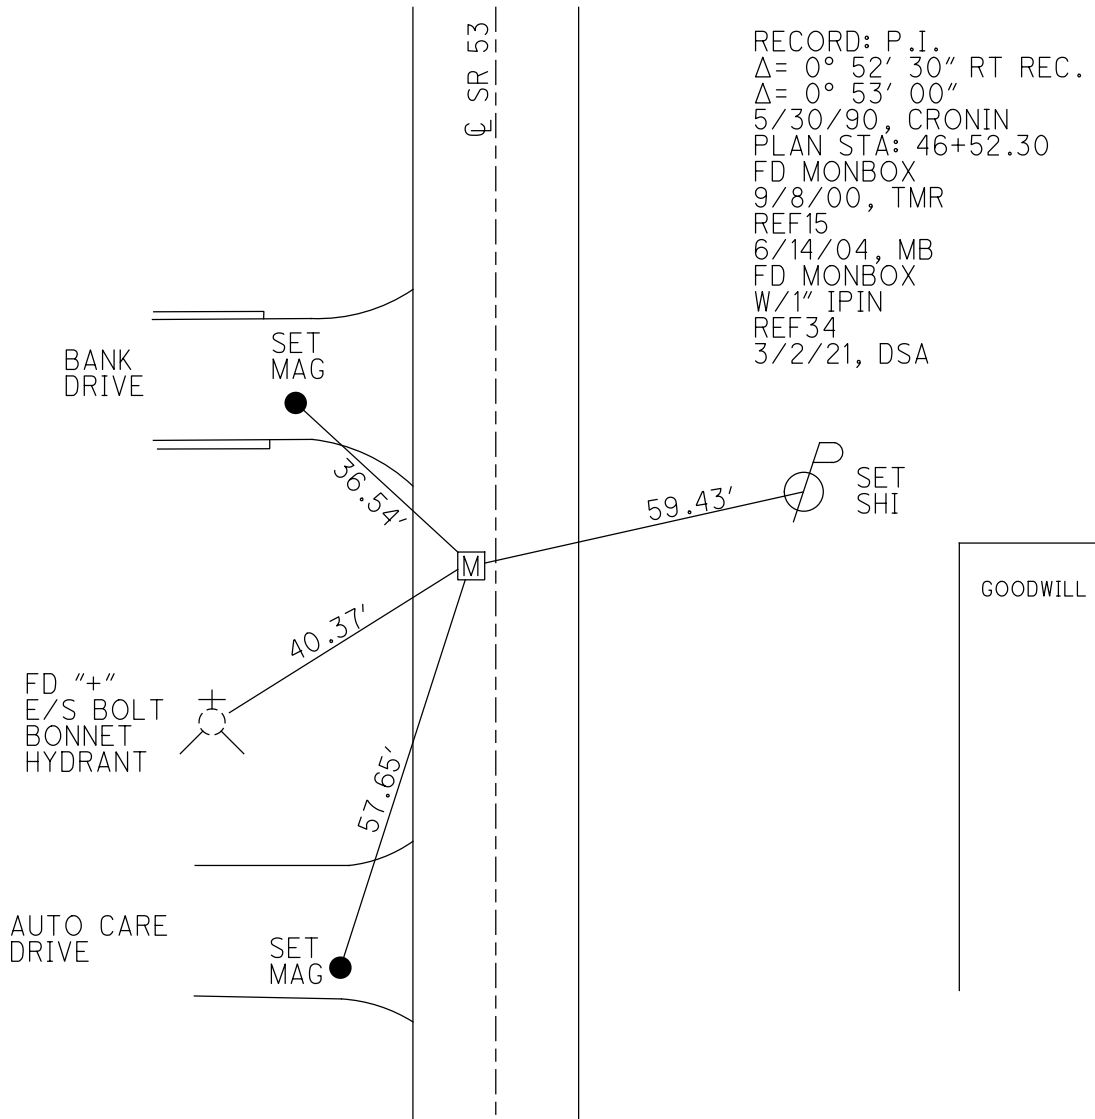


O.D.O.T. DISTRICT 2 SURVEY OFFICE (USE ONLY)

PERSONNEL _____ REFERENCE NO. 34 SHEET 8 OF 11


NOTES VAN DUSEN DATE 9/8/00 ROUTE SR 53
 H.C. ROUSOS WEATHER CLOUDY COUNTY OTTAWA
 R.C. BROWN TEMP. 72° TOWNSHIP PORTAGE
 _____ SECTION 35
 _____ T 7 N R 17 E

TYPE MONUMENT MON BOX
 ON SURFACE - ~~BELOW~~ ON
 LEFT - ☉ PAV'T - ~~RIGHT~~ 3.4'
9.4' TO LT EDGE PAVEMENT
 S.L.M. 689+13.49

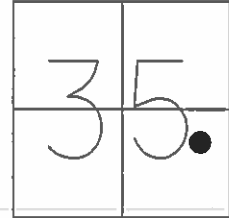

GRID: NORTHING: 675867.98 EASTING: 1870421.69

RECORD: P.I.
 $\Delta = 0^\circ 52' 30''$ RT REC.
 $\Delta = 0^\circ 53' 00''$
 5/30/90, CRONIN
 PLAN STA: 46+52.30
 GPS, 15
 6/14/04, MB

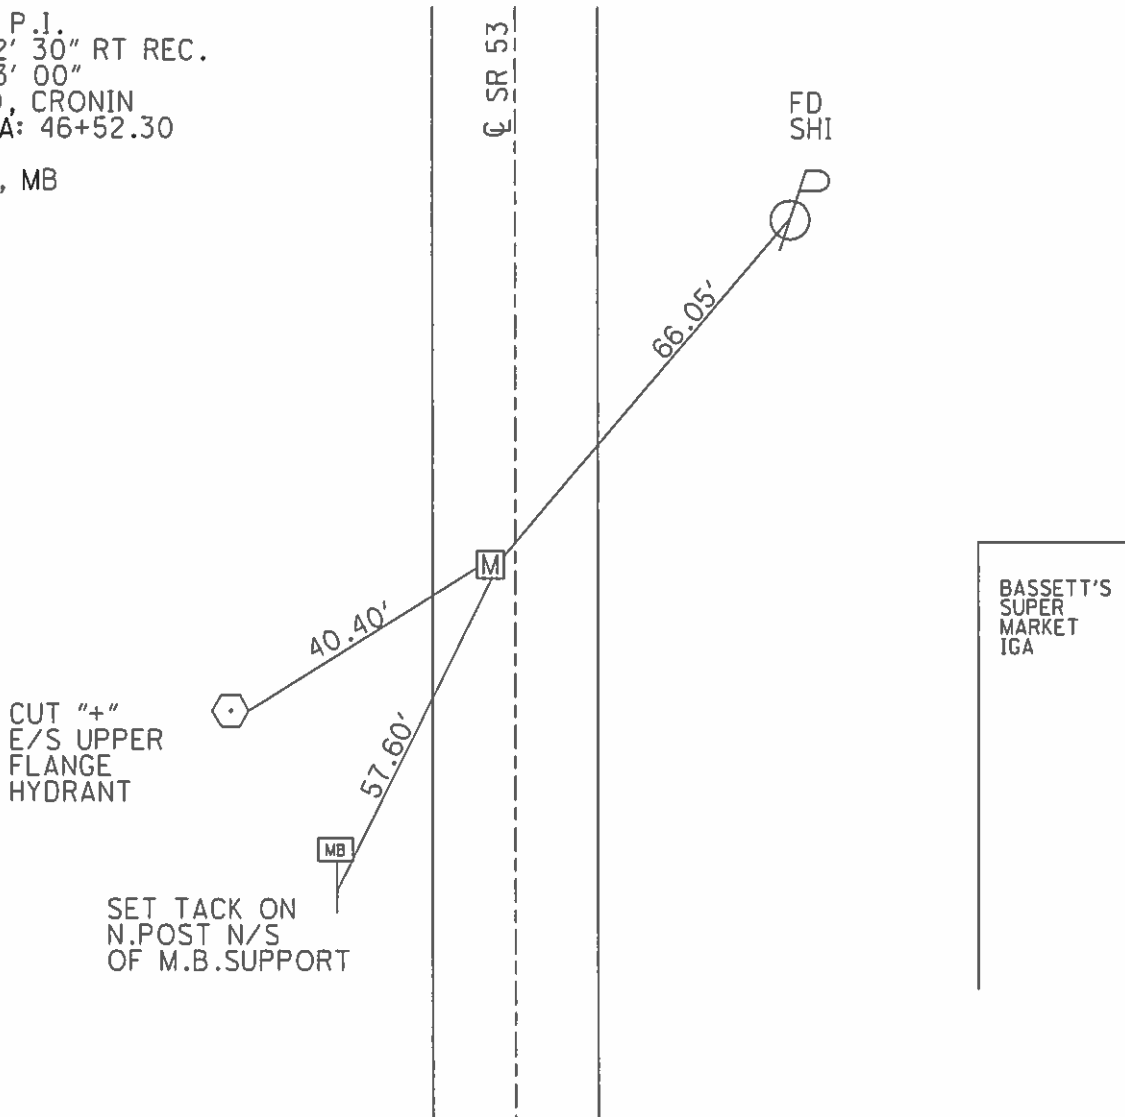

O.D.O.T. DISTRICT 2 SURVEY OFFICE (USE ONLY)

PERSONNEL

REFERENCE NO. 34

SHEET 8 OF 11

NOTES VAN DUSEN

DATE 9/8/00

ROUTE SR 53

H.C. ROUSOS

WEATHER CLOUDY

COUNTY OTTAWA

R.C. BROWN

TEMP. 72°

TOWNSHIP PORTAGE

SECTION 35

T 7 N R 17 E

TYPE MONUMENT MONBOX


ON SURFACE - ~~BELOW~~ ON

LEFT - Q PAV'T - ~~RIGHT~~ 3.4'

9.4' TO LT EDGE PAVEMENT


S.L.M. 689+13.49

Grid: Northing: 675867.98 Easting: 1870421.69

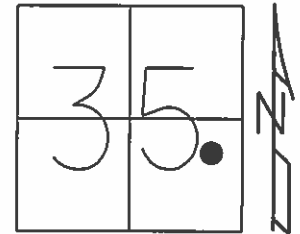

RECORD: P.I.
 $\Delta = 0^\circ 52' 30''$ RT.REC.
 $\Delta = 0^\circ 53' 00''$
 5/30/90, CRONIN
 PLAN STA: 46+52.30

GPS, 15
 6/14/04, MB

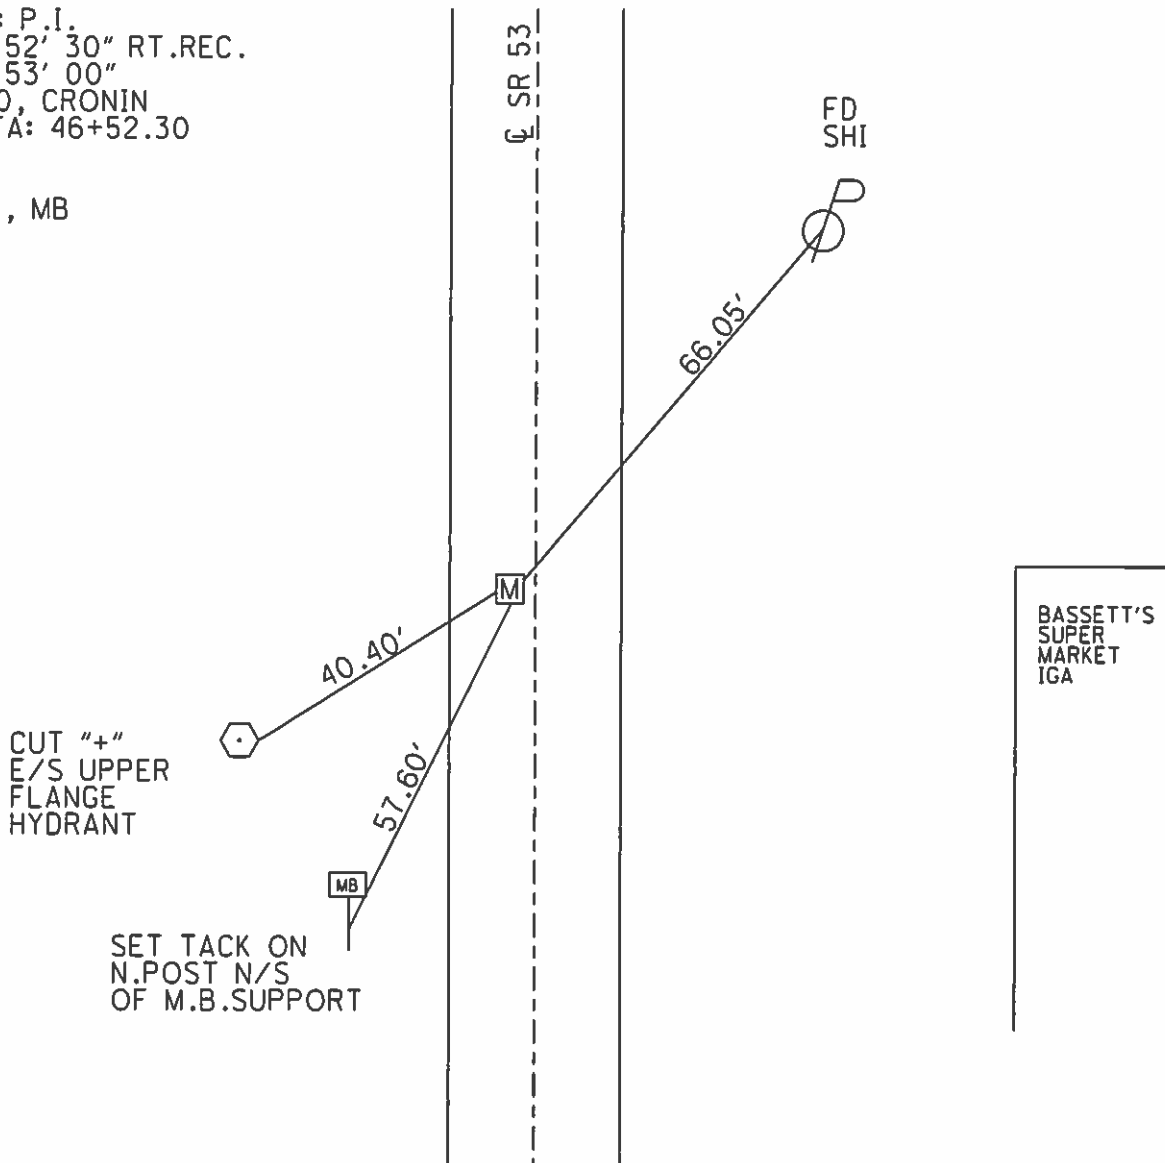

O.D.O.T. DISTRICT 2 SURVEY OFFICE

PERSONNEL

REFERENCE NO. 34

SHEET 7 OF 8

NOTES Van Dusen

H.C. Rousos

DATE 9-8-00

ROUTE SR 53

R.C. Brown

WEATHER Cloudy

COUNTY OTTAWA

TEMP. 72°

TOWNSHIP Portage

SECTION 35

T 7 N R 12 E


TYPE MONUMENT Iron Pin in Monument Box

ON SURFACE - BELOW Yes

LEFT-☉ PAV'T. - RIGHT 3.4

9.4 TO Lt EDGE PAVEMENT

S.L.M. 670 + 89.10

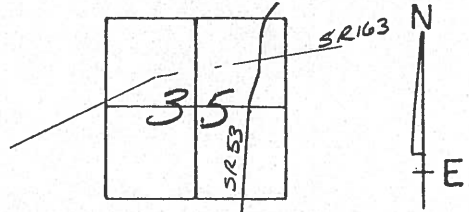


RECORD:

P.I.

$\Delta = 0^{\circ}52'30''$ RT RECORD

$\Delta = 0^{\circ}53'00''$

by CROWIN 5.30.90

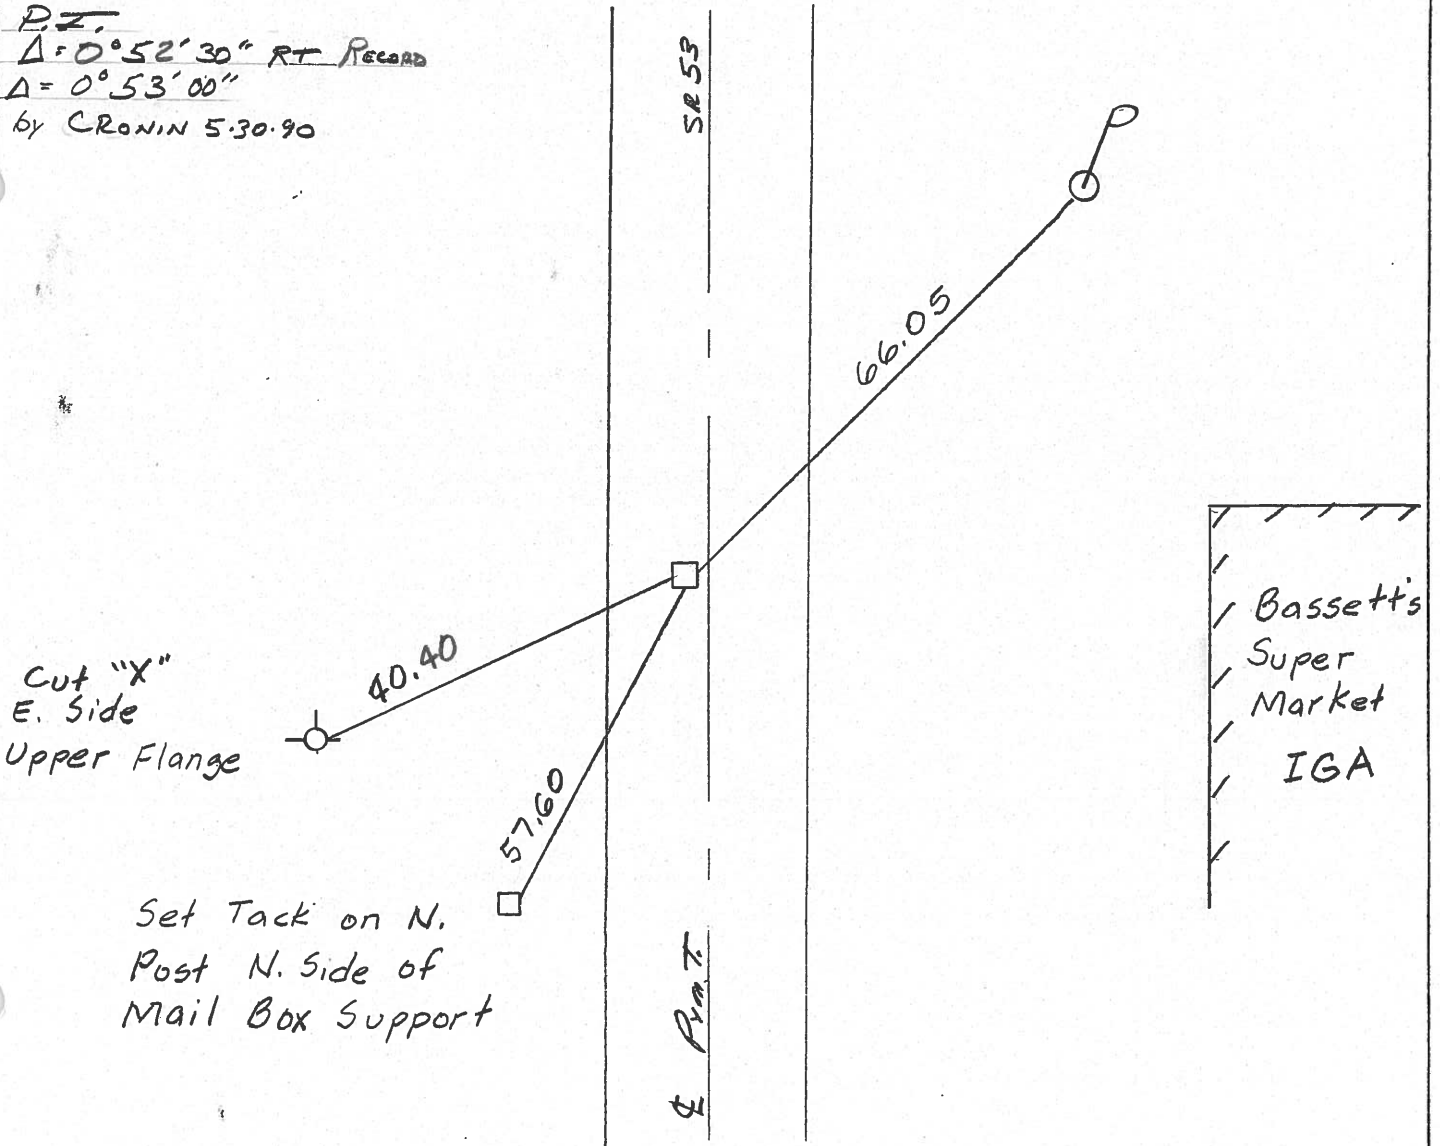

O.D.O.T. DISTRICT 2 SURVEY OFFICE

PERSONNEL

REFERENCE NO. 34

SHEET OF

NOTES BARNHISEL

H.C. " "

DATE 9-14-90

ROUTE SR 53

R.C. BARBOR

WEATHER cloudy

COUNTY OTTAWA

Ripple


TEMP. +76°

TOWNSHIP PORTAGUE

SECTION 35

T 7 N R 17 E

TYPE MONUMENT I, PIN IN MON. BOX
 ON SURFACE - BELOW Box AT SURFACE, I.P. IS 0.7 BELOW
 LEFT - & PAV'T. - RIGHT 3.4
9.4 TO LT. EDGE PAVEMENT
 S.L.M. 670 + 89.10

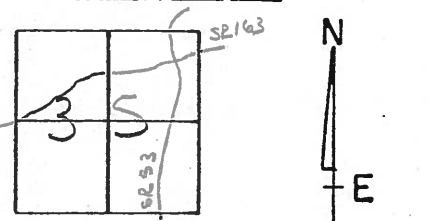


RECORD!

P.I.

$\Delta = 0^\circ - 52' - 30''$ Rt. - Record

$\Delta = 0^\circ - 53' - 00''$ Rt. - MEAS.

by Cronin 5.30-90

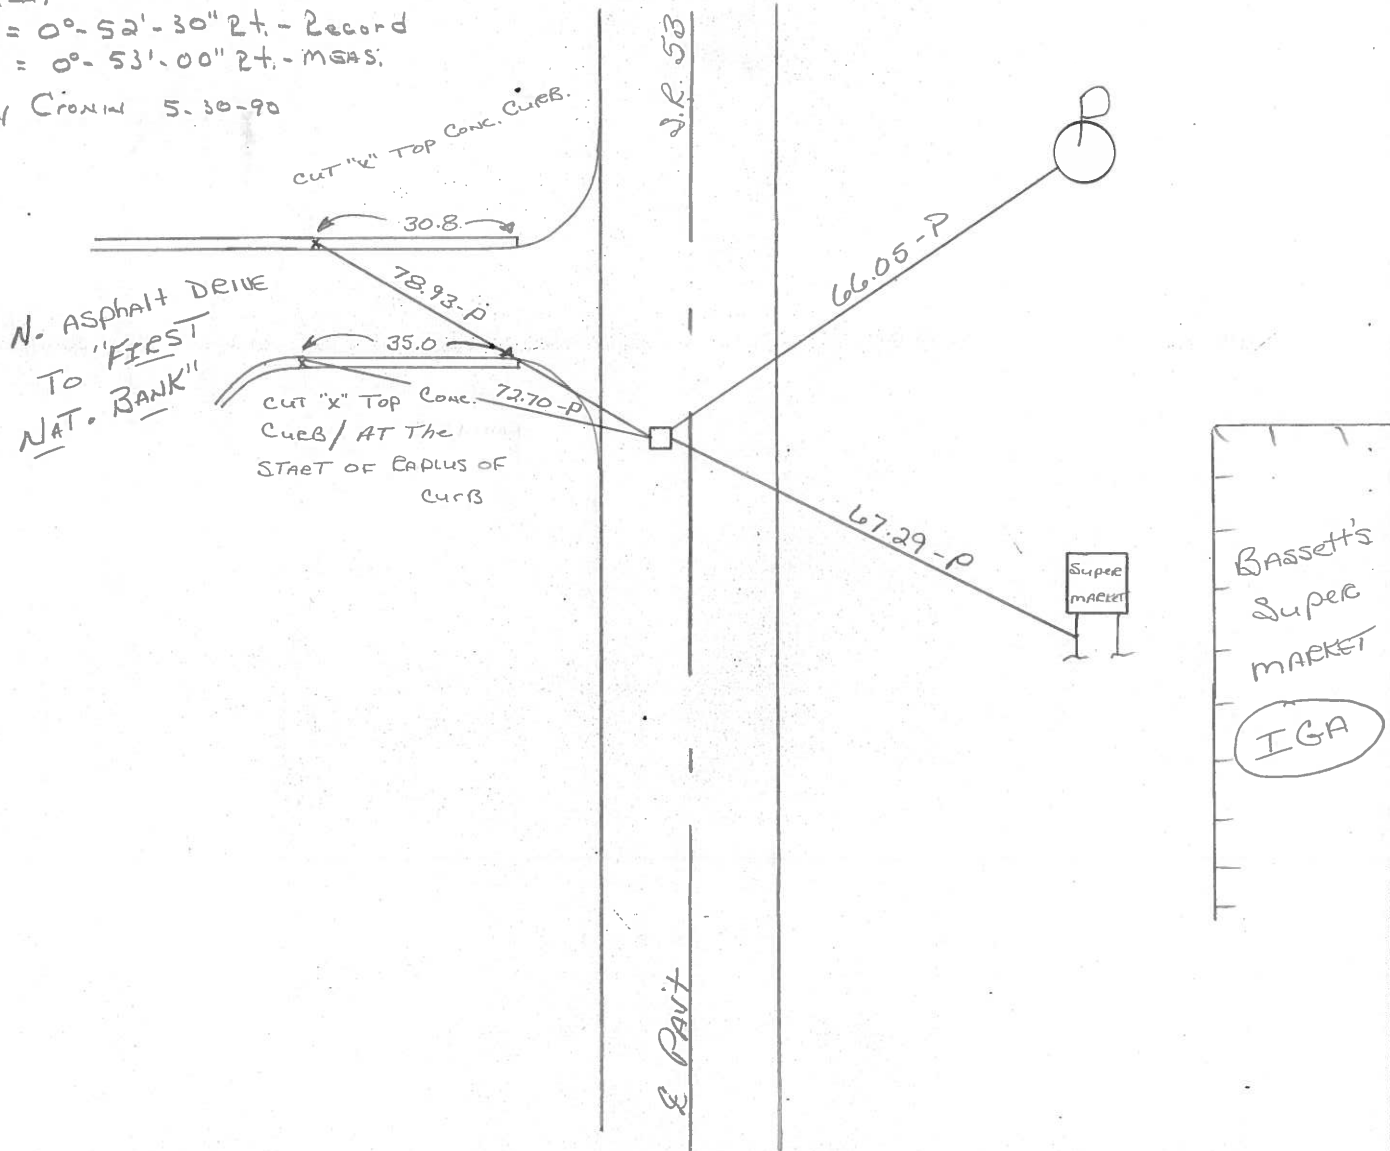

PERSONNEL TITLE PERSONNEL TITLE

COUNTY Ottawa DATE 6-19-72

S. R. 53 WEATHER Fair

SEC. 11.85-12.90 TEMP. 78°

DESCRIPTION Parage Twp. JOB NO.

