

O.D.O.T. DISTRICT 2 SURVEY OFFICE (USE ONLY)

PERSONNEL \_\_\_\_\_ REFERENCE NO. 34 SHEET 9 OF 12

NOTES RHOADES DATE 8/22/22 ROUTE SR 53  
 H.C. NIESE WEATHER CLOUDY COUNTY OTTAWA  
 R.C. AUBLE TEMP. 72° TOWNSHIP PORTAGE

DWG BY RHOADES PID 102905 SECTION 35  
 T 7 N R 17 E

TYPE MONUMENT MONBOX W/1" IPIN

ON SURFACE - ~~BELOW~~ ON


OFFSET  $\varnothing$  PAVEMENT 3.4' LT : ~~RT~~

9.4' TO LT EDGE PAVEMENT


STATION: 689+13.49

HORZ.DATUM: NAD83 2011 GEOID: NAVD88 2018

GRID: NORTHING: 675797.596 EASTING: 1870227.193

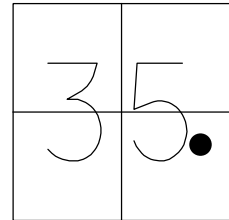

RECORD: P.I.  
 $\Delta = 0^\circ 52' 30''$  RT REC.  
 $\Delta = 0^\circ 53' 00''$   
 5/30/90, CRONIN  
 PLAN STA: 46+52.30  
 FD MONBOX  
 9/8/00, TMR  
 REF15  
 6/14/04, MB  
 FD MONBOX  
 W/1" IPIN  
 REF34  
 3/2/21, DSA

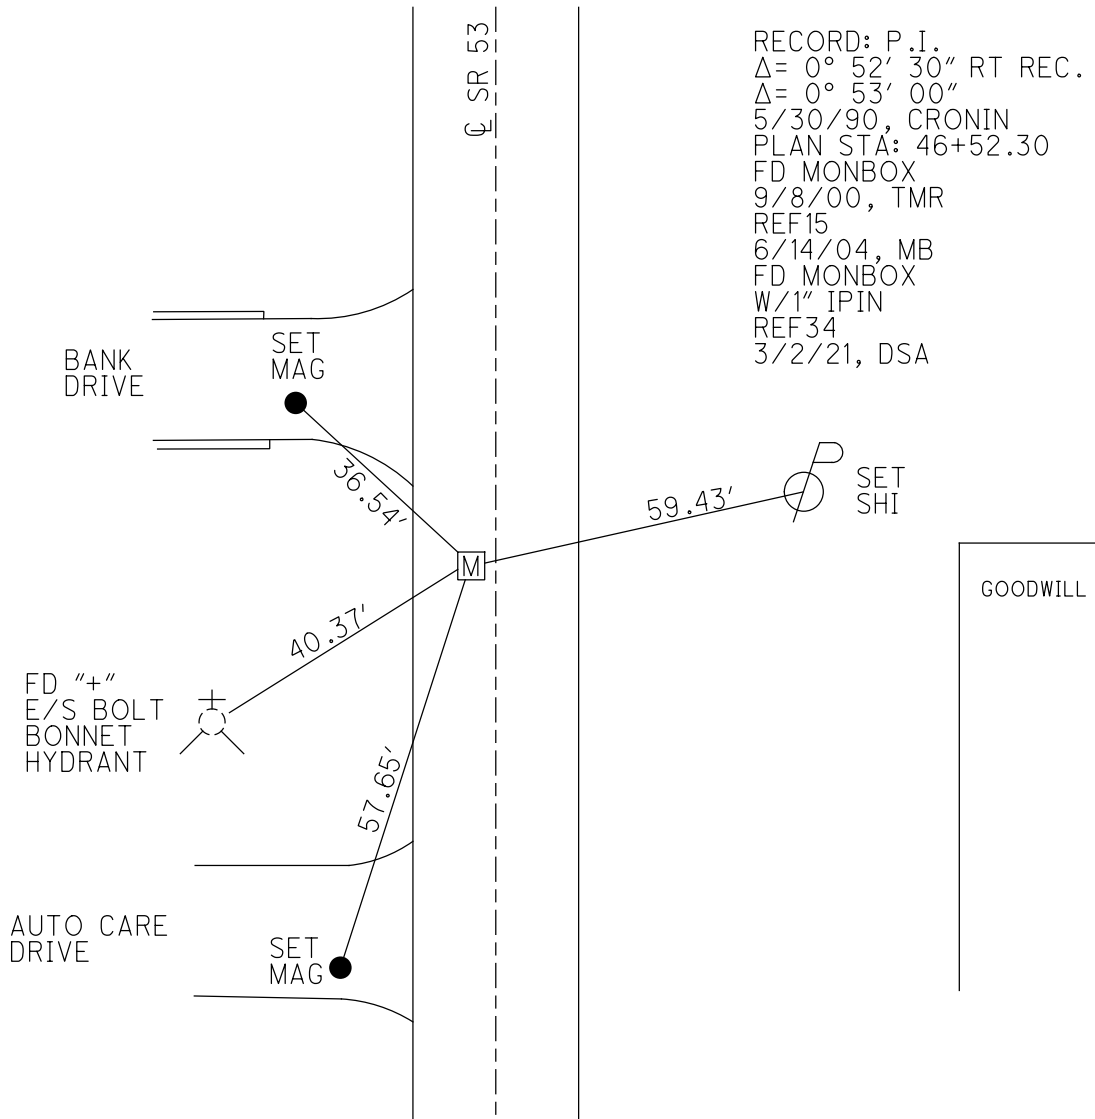

O.D.O.T. DISTRICT 2 SURVEY OFFICE (USE ONLY)

PERSONNEL

REFERENCE NO. 34

SHEET 8 OF 11

NOTES VAN DUSEN

DATE 9/8/00

ROUTE SR 53

H.C. ROUSOS

WEATHER CLOUDY

COUNTY OTTAWA

R.C. BROWN

TEMP. 72°

TOWNSHIP PORTAGE

SECTION 35

T 7 N R 17 E

TYPE MONUMENT MONBOX


ON SURFACE - ~~BELOW~~ ON

LEFT - Q PAV'T - ~~RIGHT~~ 3.4'


9.4' TO LT EDGE PAVEMENT

S.L.M. 689+13.49

Grid: Northing: 675867.98 Easting: 1870421.69

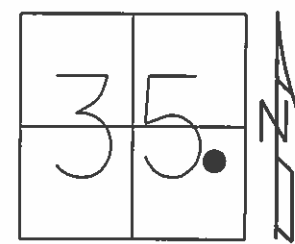

RECORD: P.I.  
 $\Delta = 0^\circ 52' 30''$  RT.REC.  
 $\Delta = 0^\circ 53' 00''$   
 5/30/90, CRONIN  
 PLAN STA: 46+52.30  
 GPS, 15  
 6/14/04, MB

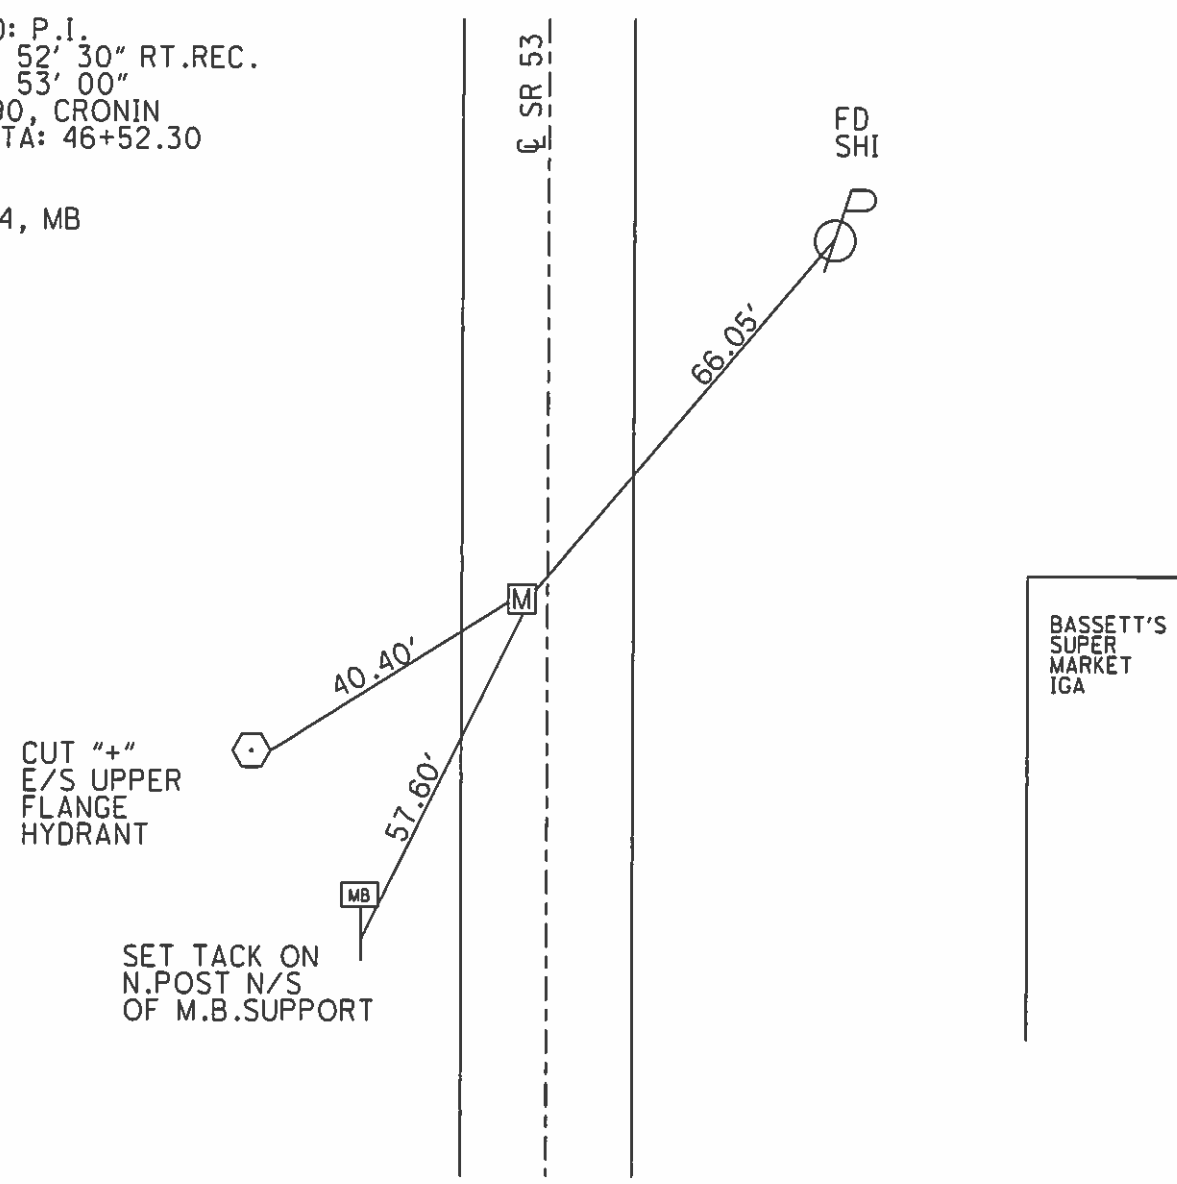

PERSONNEL TITLE PERSONNEL TITLE

COUNTY Ottawa DATE 6-19-72

S. R. 53 WEATHER Fair

SEC. 11.85-12.90 TEMP. 75°


DESCRIPTION Portage Twp.

JOB NO.

LEFT

CENTER LINE

RIGHT

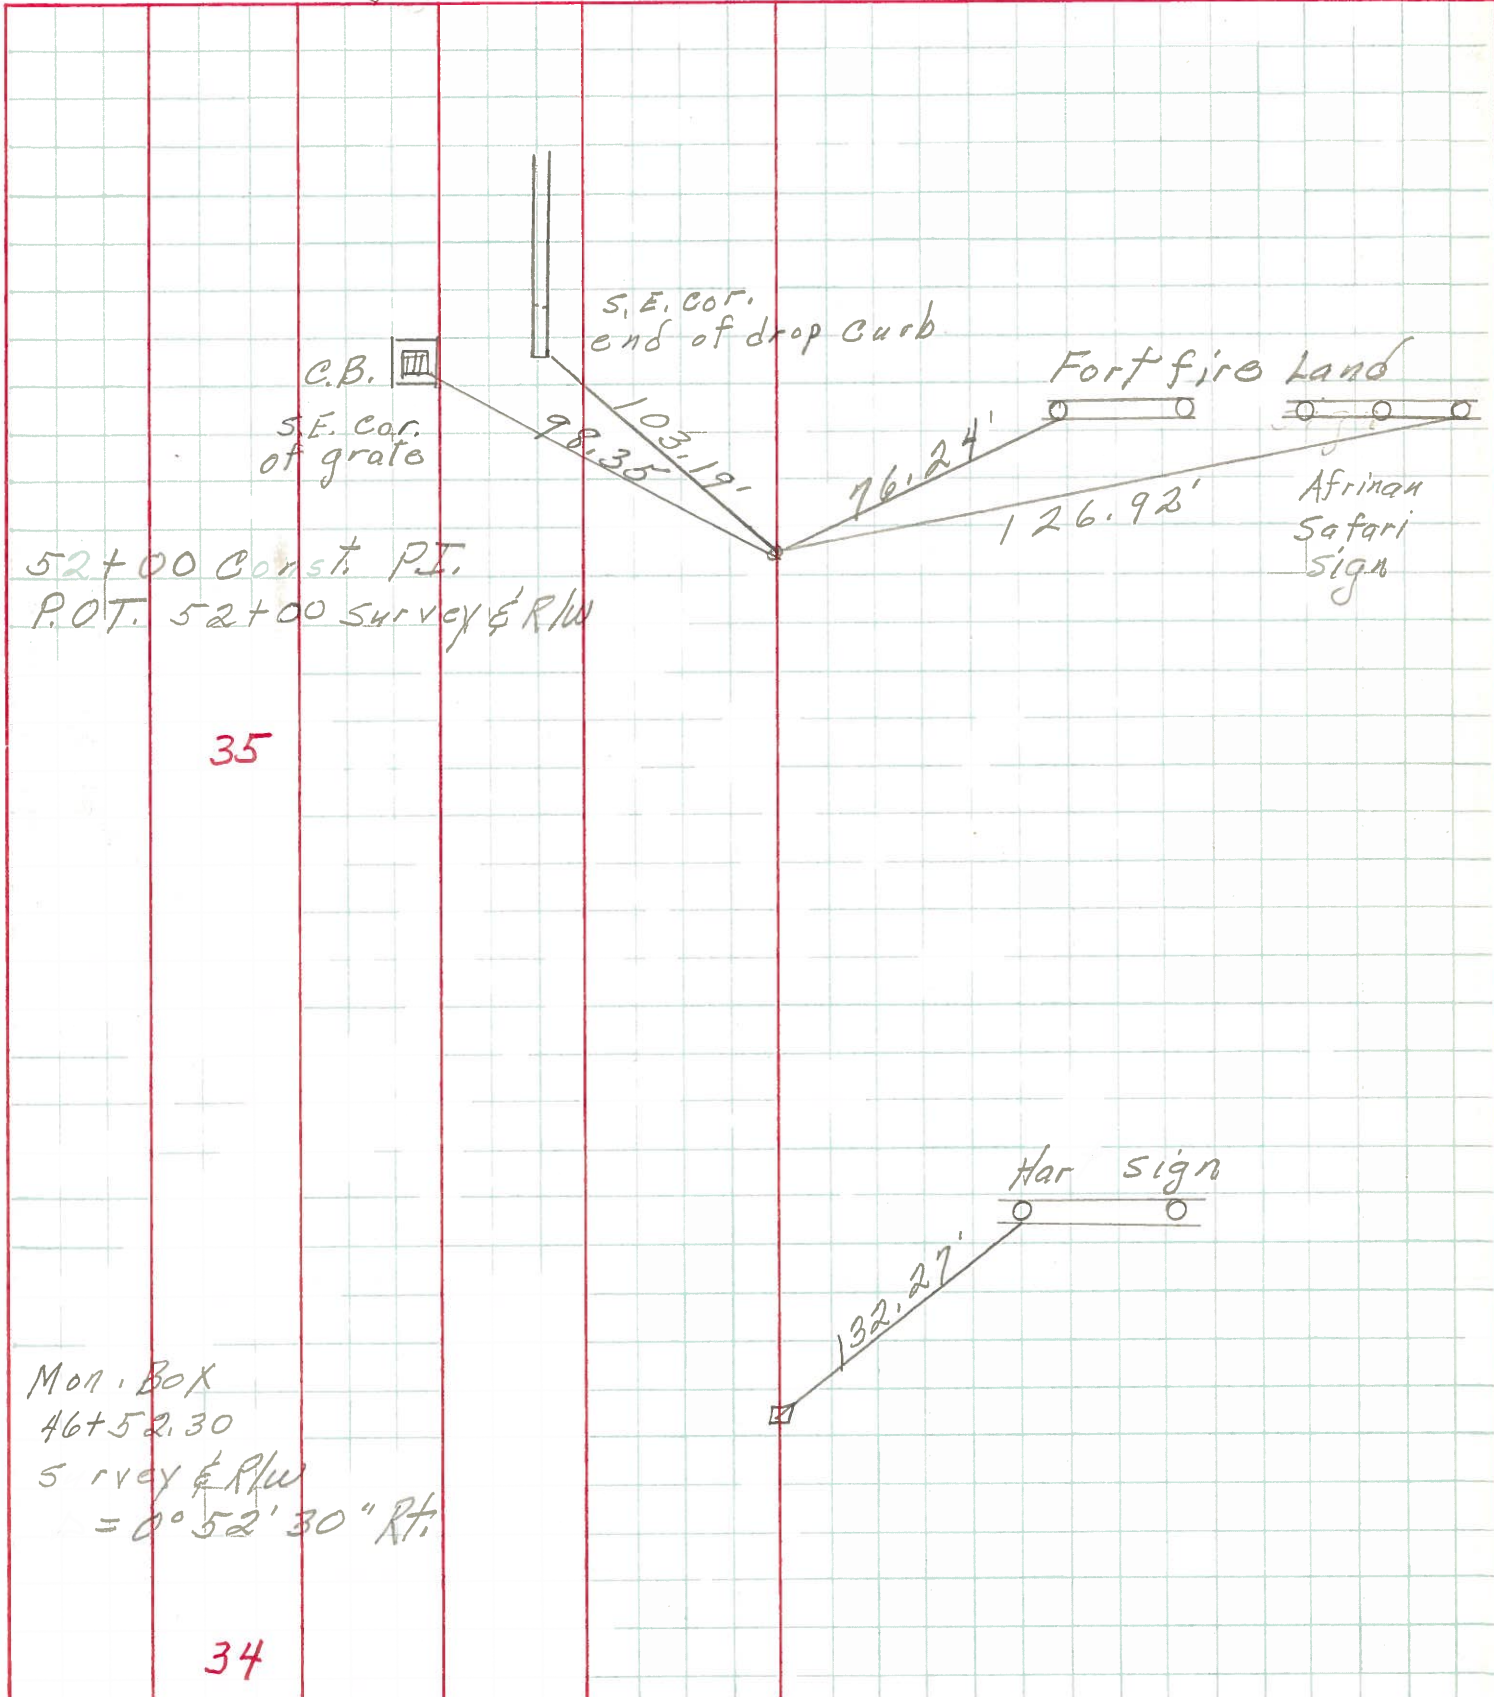

PERSONNEL TITLE PERSONNEL TITLE


COUNTY Ott. DATE 7/1/69

S. R. Old S. R 357 WEATHER \_\_\_\_\_

SEC. \_\_\_\_\_ TEMP. \_\_\_\_\_

DESCRIPTION LEFT CENTER LINE RIGHT JOB NO.

NASHI.  
P.I. 52+00 Const.  
P.O.T. 52+00 SURF P/W

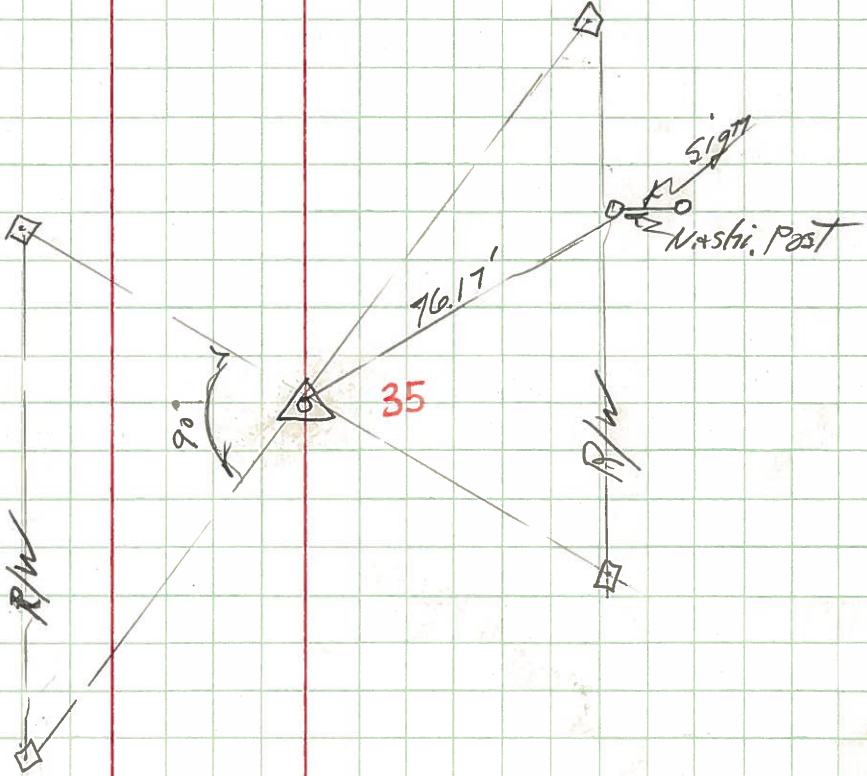

Moth. Box

P.R. 5 1/2".  
P.I. 46+52.30 ✓  
Surf P/W  
A = 0°-52'-30" RT.

