

O.D.O.T. DISTRICT 2 SURVEY OFFICE (USE ONLY)

PERSONNEL _____ REFERENCE NO. 40 SHEET 11 OF 12
 NOTES RHOADES DATE 8/22/22 ROUTE SR 53
 H.C. NIESE WEATHER CLOUDY COUNTY OTTAWA
 R.C. AUBLE TEMP. 72° TOWNSHIP PORTAGE
 SECTION 35
 DWG BY RHOADES PID 102905 T 7 N R 17 E

TYPE MONUMENT MONBOX W/1" IPIN

ON SURFACE - ~~BELOW~~ ON


OFFSET 11.5' LT : RT

ON TO RT EDGE PAVEMENT


STATION: 689+04.69

HORIZ.DATUM: NAD83 2011 GEOID: NAVD88 2018

GRID: NORTHING: 677549.706 EASTING: 1870313.863

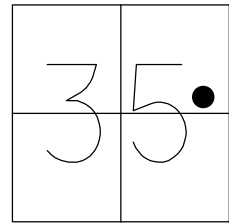


RECORD: P.I.
 STA. 706+67.82
 $\Delta = 13^\circ 50' \text{ LT}$
 FD MONBOX
 6/8/95, CL
 REF17
 6/14/04, MB
 FD MONBOX
 W/ 1" IPIN
 REF37
 3/2/21, DSA

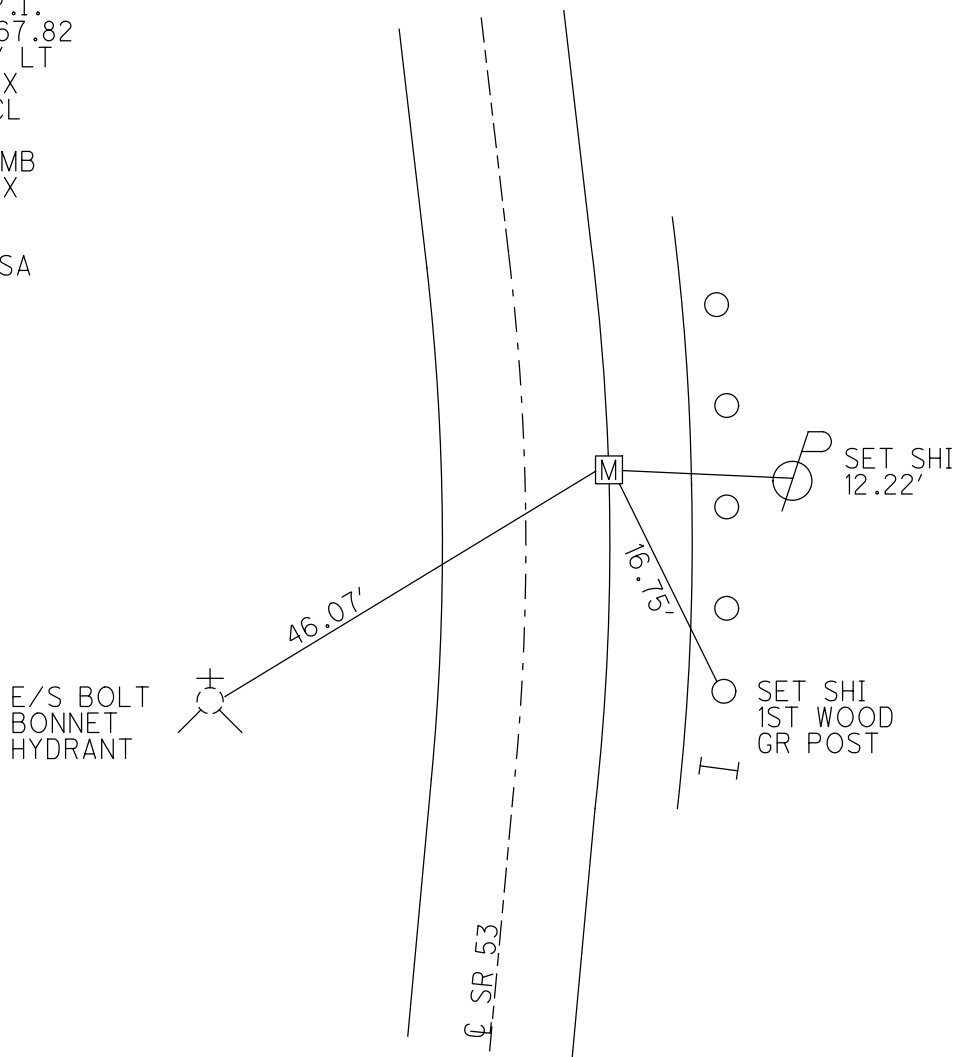


O.D.O.T. DISTRICT 2 SURVEY OFFICE (USE ONLY)

PERSONNEL _____ REFERENCE NO. 37 SHEET 2 OF 36
 NOTES LOEHRKE DATE 6/8/95 ROUTE SR 53
 H.C. CANTERBURY WEATHER CLOUDY COUNTY OTTAWA
 R.C. ROUSOS TEMP. 60° TOWNSHIP PORTAGE
 _____ SECTION 35
 _____ T 7 N R 17 E

TYPE MONUMENT MON.BOX
 ON SURFACE - ~~BELOW~~ ON
~~LEFT~~ - Q PAV'T - RIGHT 11.5'
0' TO RT EDGE PAVEMENT
 S.L.M. 689+26.31
 GRID: NORTHING: 677549.776 EASTING: 1870313.714

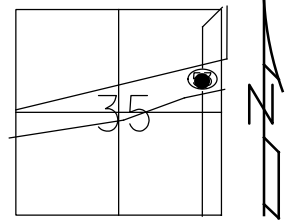

RECORD:
 FD IPIN IN MON.BOX
 GPS, REF40
 5/26/10, DCH

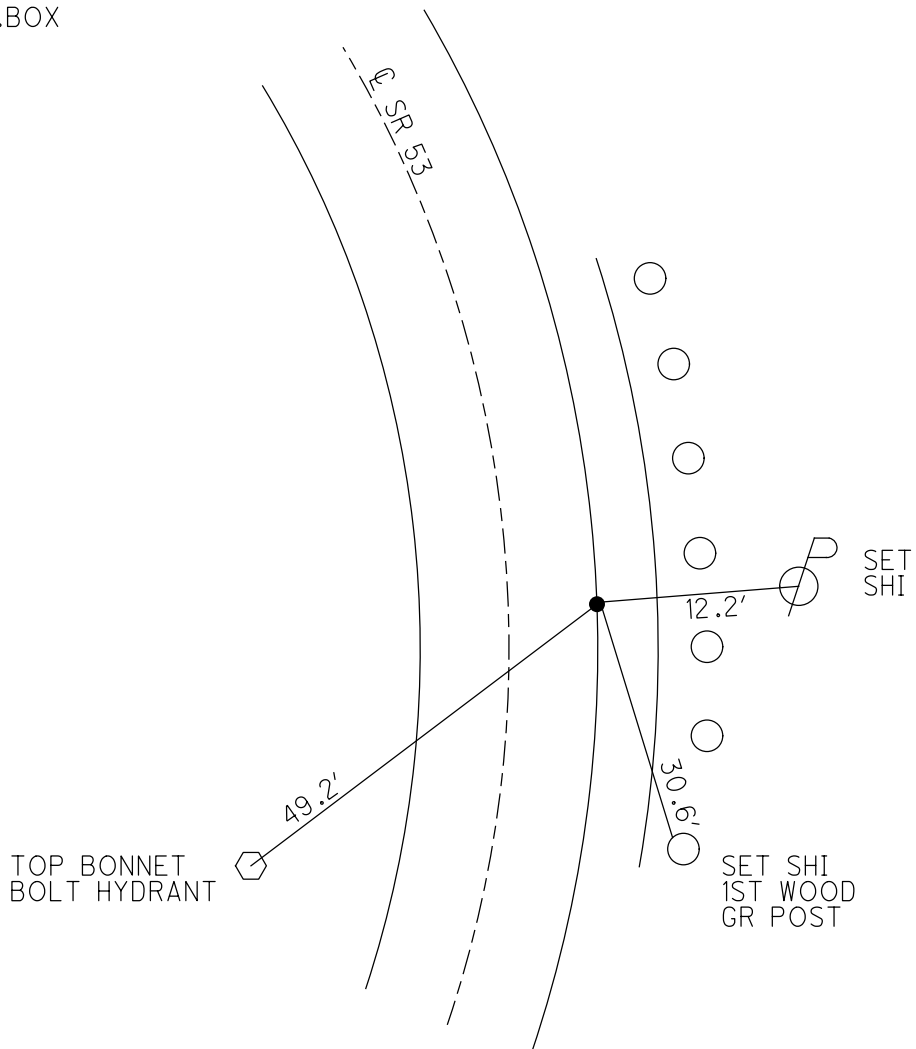

O.D.O.T. DISTRICT 2 SURVEY OFFICE

PERSONNEL _____

REFERENCE NO. _____

SHEET 1 OF 30

NOTES LoENAKE

H.C. CANTERBURY

R.C. ROUSOS

DATE 6-8-95

WEATHER Cloudy

TEMP. +60

ROUTE S.R. 53

COUNTY OTTAWA

TOWNSHIP CATAWBA ISLAND

SECTION _____

T _____ R _____



TYPE MONUMENT Mon Box

ON SURFACE - ~~BELOW~~ Yes

~~LEFT~~ - C PAV'T. - RIGHT 11.5

~~ON~~ Rt EDGE PAVEMENT

S.L.M. 688+76

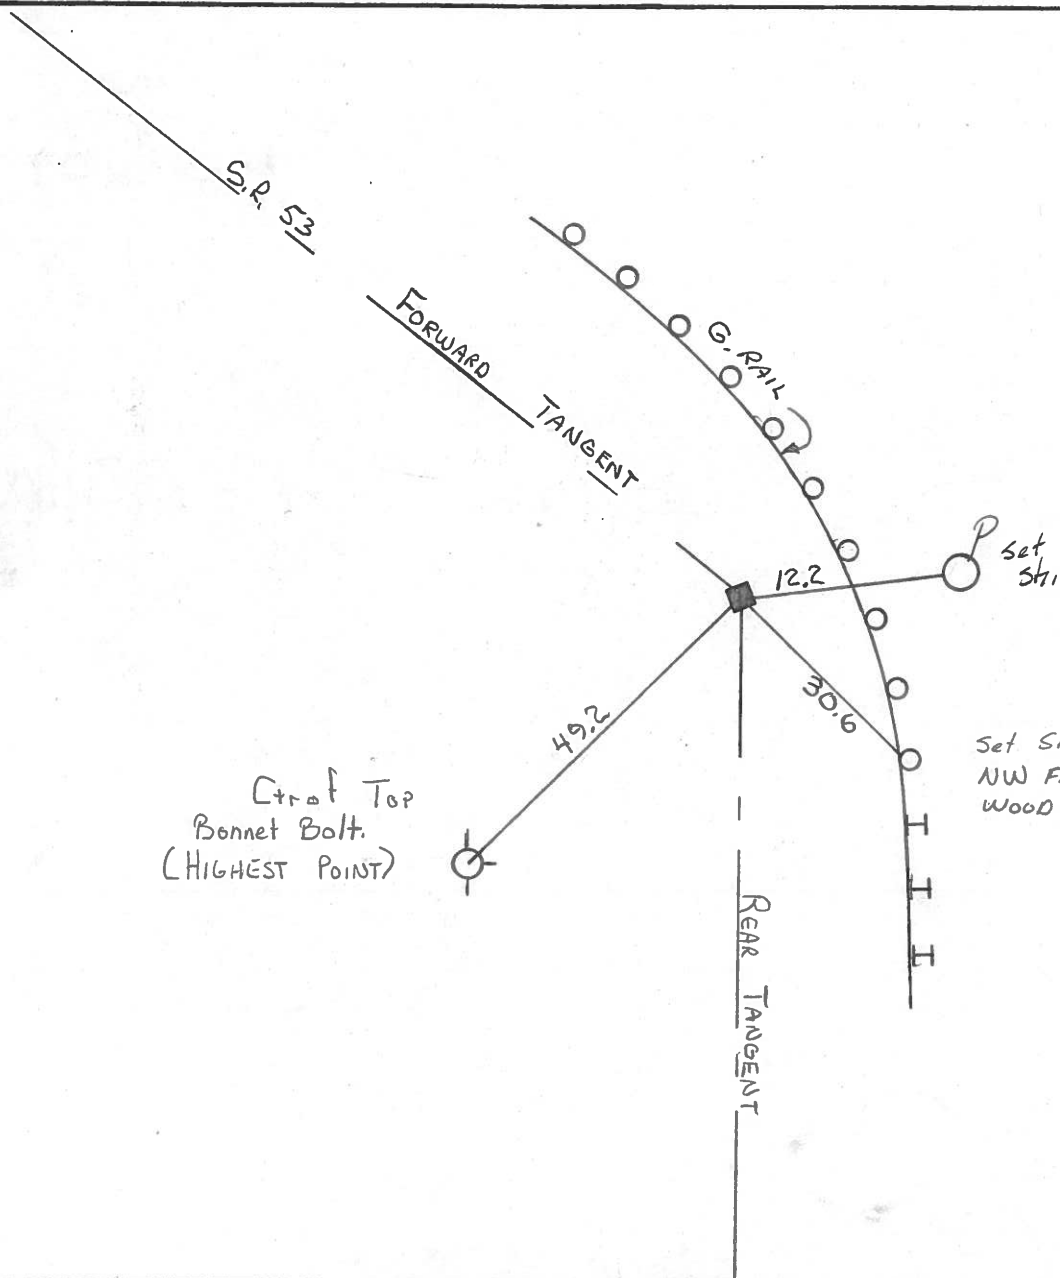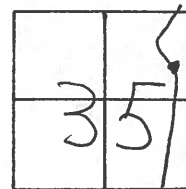

Set shi Near Top
NW FACE of 1st
WOOD G. RAIL Post

PERSONNEL TITLE PERSONNEL TITLE

COUNTY Ottawa DATE 6-19-72


PERSONNEL TITLE PERSONNEL TITLE

S. R. 53 WEATHER Fair

PERSONNEL TITLE PERSONNEL TITLE

SEC. 29.62-29.67 TEMP. 75°

DESCRIPTION Portage Twp. LEFT CENTER LINE RIGHT JOB NO.

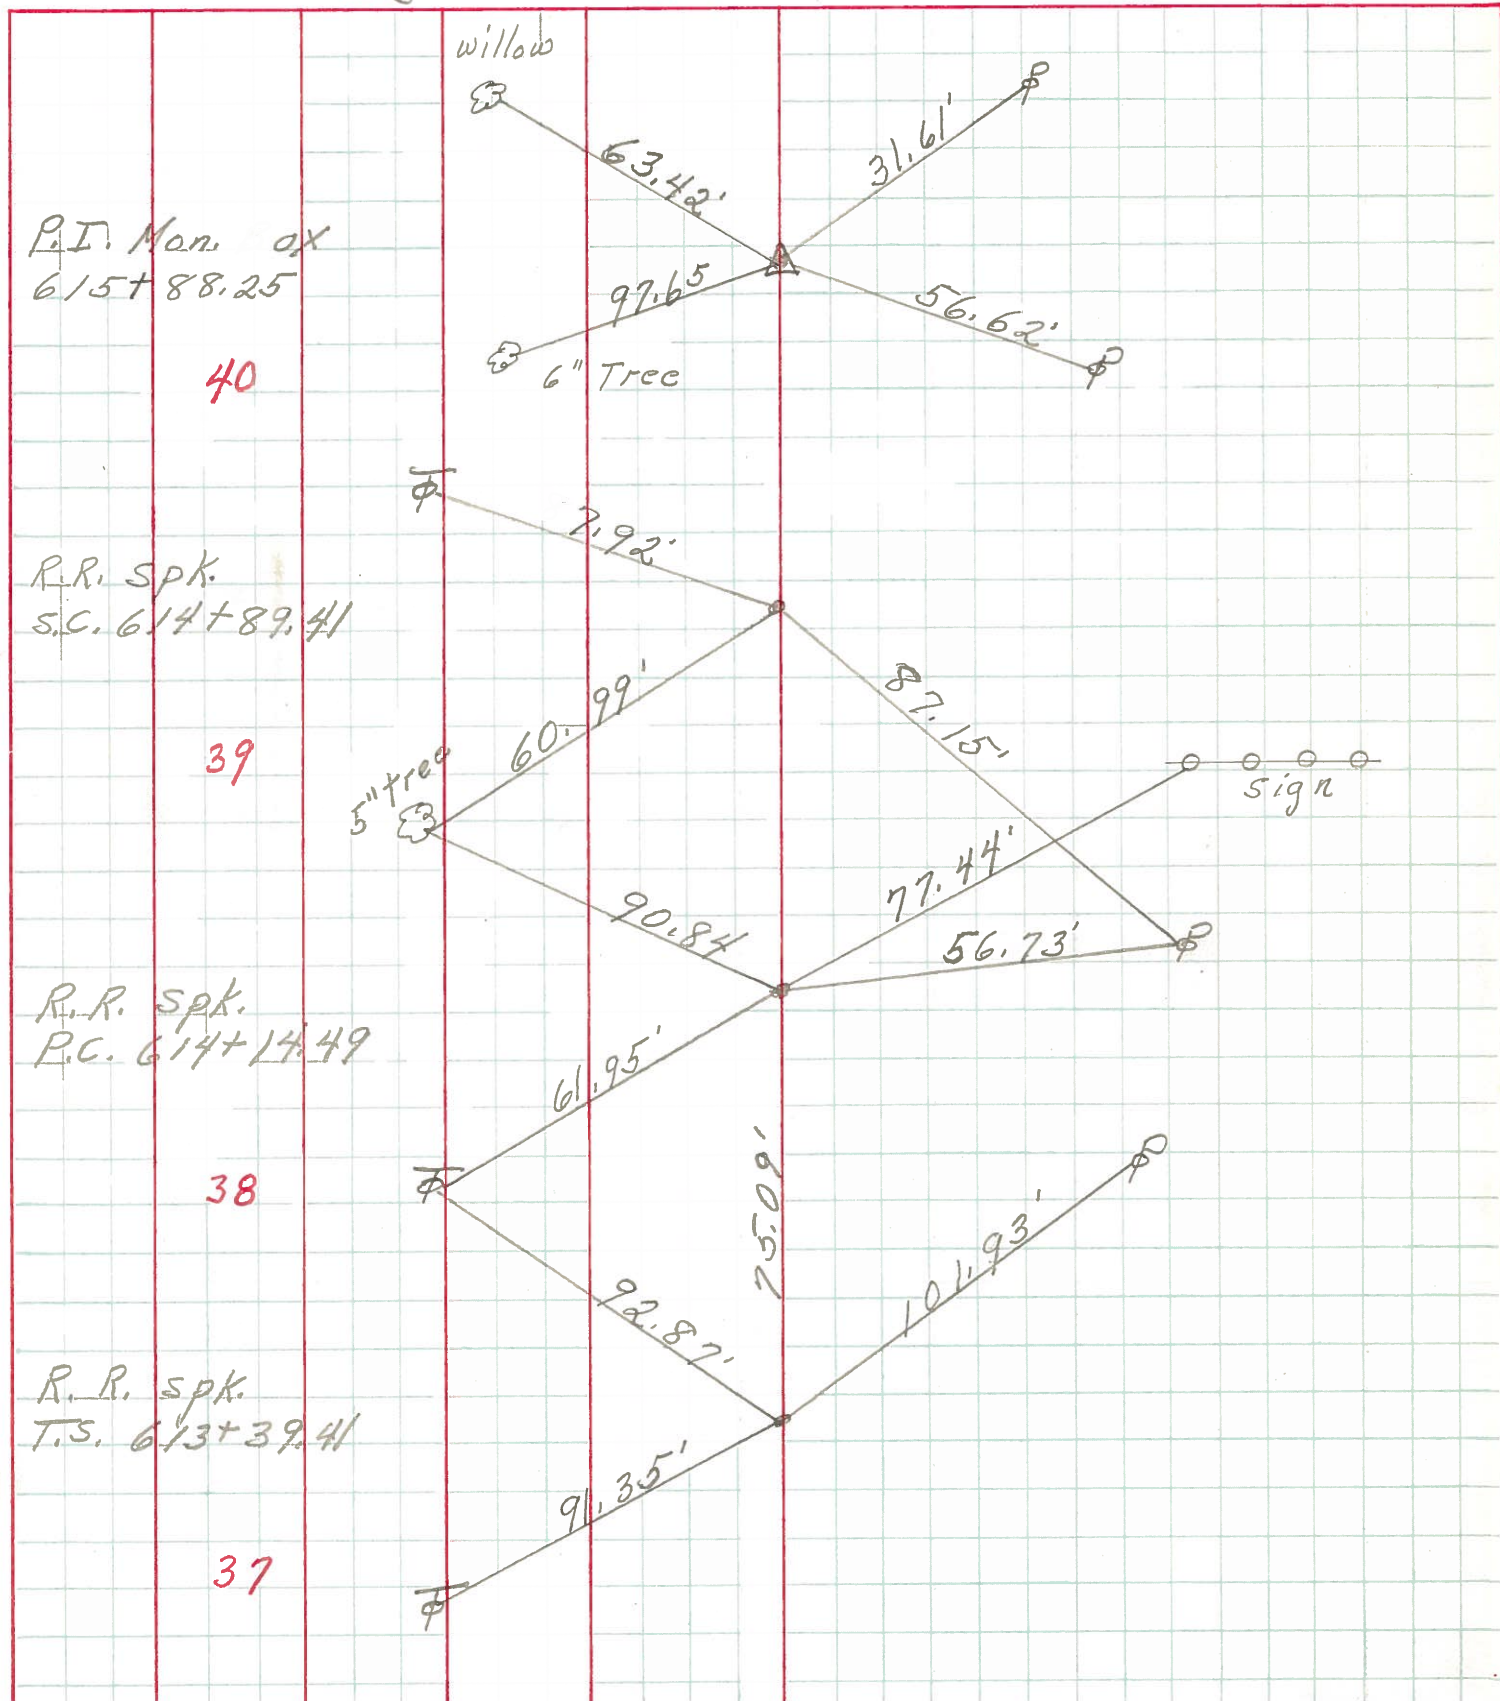

P.I. Man. dx
615+88.25

40

willow

63.42'

31.61'

97.65

56.62'

6" Tree

R.R. Spk.
S.C. 614+89.41

39

5" tree

60.99'

7.92'

87.15'

77.44'

sign

R.R. Spk.
P.C. 614+14.49

38

61.95'

90.84'

56.73'

75.09'

R.R. Spk.
T.S. 613+39.41

37

92.87'

91.35'

101.93'

PERSONNEL TITLE PERSONNEL TITLE

COUNTY OTT. DATE 7/18/69

S. R. Old S.R. # 357 WEATHER

SEC. S.R. # 53 TEMP.

DESCRIPTION LEFT CENTER LINE RIGHT JOB NO.

