

O.D.O.T. DISTRICT 2 SURVEY OFFICE (USE ONLY)

PERSONNEL _____ REFERENCE NO. 41 SHEET 12 OF 12
 NOTES RHOADES DATE 8/22/22 ROUTE SR 53
 H.C. NIESE WEATHER CLOUDY COUNTY OTTAWA
 R.C. AUBLE TEMP. 73° TOWNSHIP CATAWBA
 DWG BY RHOADES PID 102905 SECTION 35
 T 7 N R 17 E

TYPE MONUMENT LR.R.R.SPIKE

~~ON SURFACE~~ - BELOW 2"


OFFSET \odot PAVEMENT 61.8' LT : ~~RT~~

- TO - EDGE PAVEMENT


STATION: 696+41.7

HORZ.DATUM: NAD83 2011 GEOID: NAVD88 2018

GRID: NORTHING: 678287.068 EASTING: 1870166.904

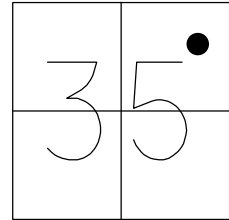

RECORD: P.I.
 R/W
 STA.623+38.69
 FD IPIN
 2" DOWN
 BLACKTOP DRIVE
 6/8/95, TMR
 REF18
 6/14/04, MB
 FD R.R.SPIKE
 REF41
 5/26/10, DCH
 FD LG.R.R.SPIKE
 2" DOWN
 REF41
 3/3/21, JFO

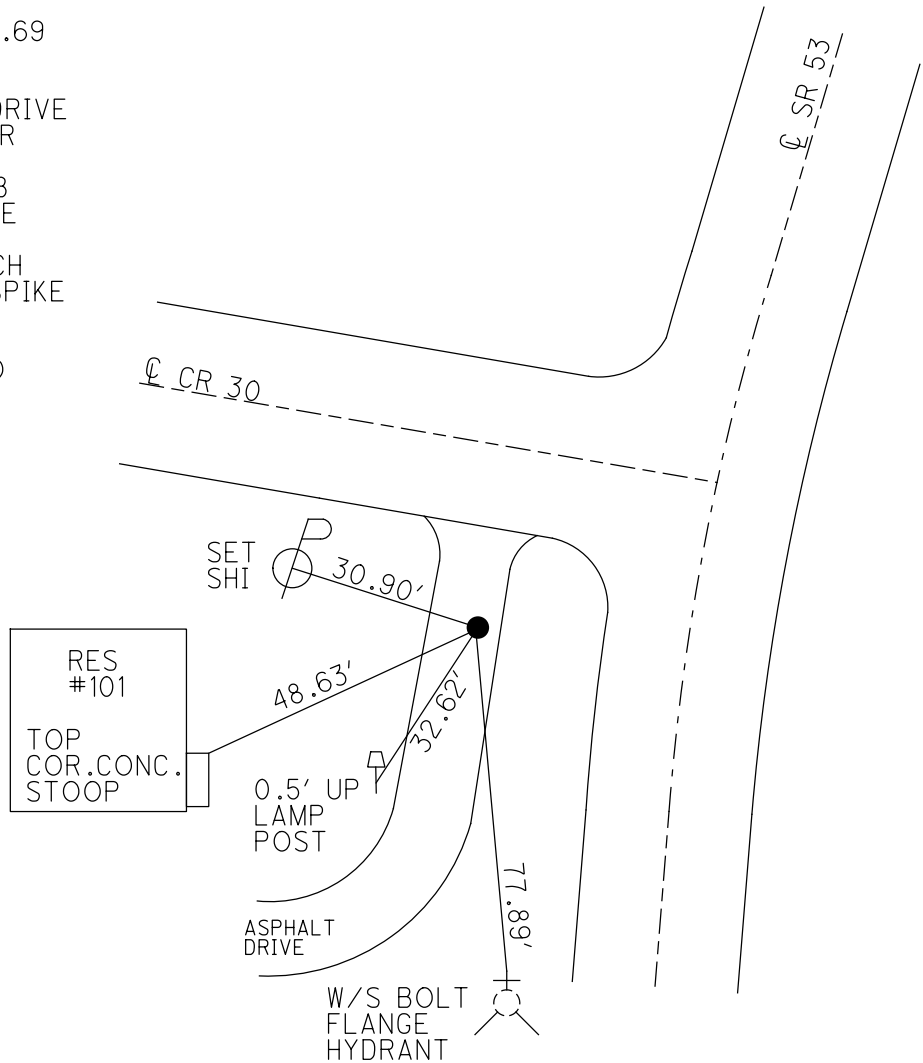

O.D.O.T. DISTRICT 2 SURVEY OFFICE (USE ONLY)

PERSONNEL _____ REFERENCE NO. 41 SHEET 3 OF 36
 NOTES ROUSOS DATE 6/8/95 ROUTE SR 53
 H.C. ROUSOS WEATHER CLOUDY COUNTY OTTAWA
 R.C. CANTERBURY TEMP. 55° TOWNSHIP CATAWBA
 _____ SECTION 35
 _____ T 7 N R 17 E



TYPE MONUMENT IPIN

~~ON SURFACE~~ - BELOW 2"

LEFT - ℄ PAV'T - ~~RIGHT~~ 61.8', ± 37.5' S.℄ CR 30
 - TO - EDGE PAVEMENT

S.L.M. 696+61.75

GRID: NORTHING: 678287.108 EASTING: 1870166.753

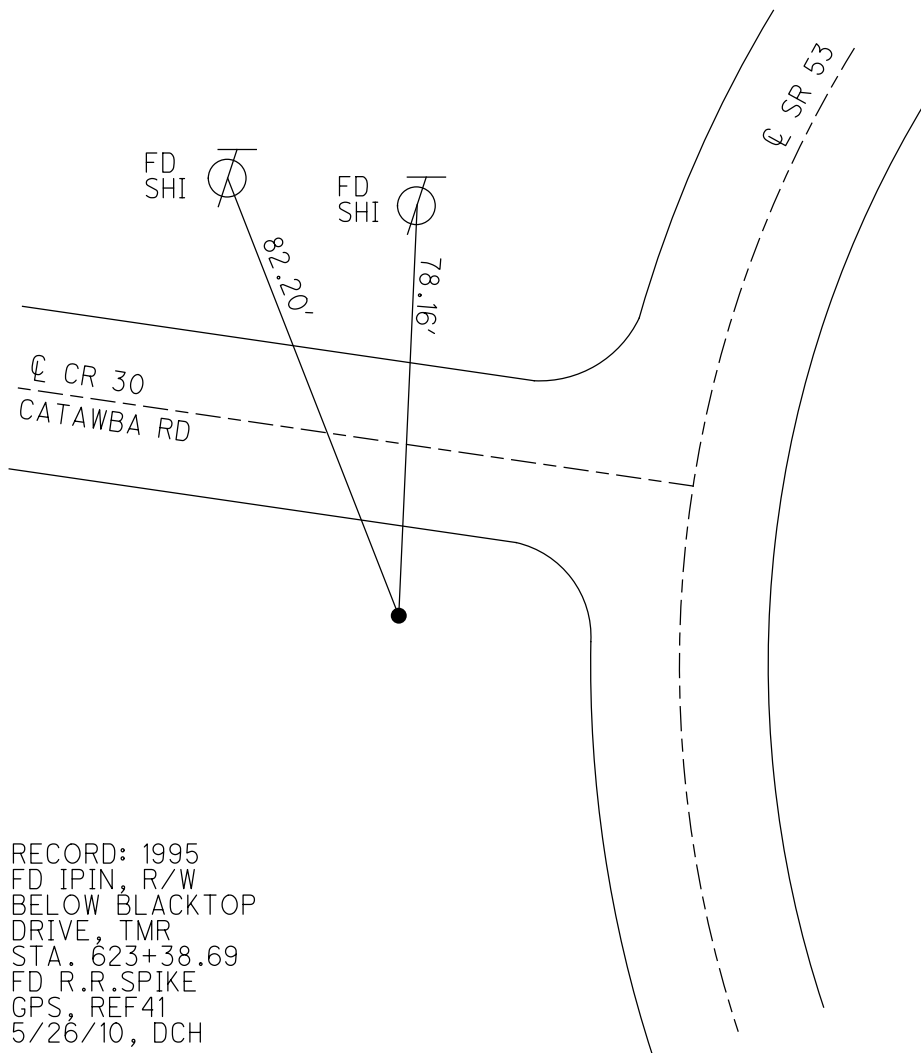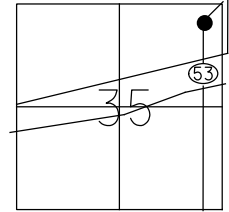

RECORD: 1995
 FD IPIN, R/W
 BELOW BLACKTOP
 DRIVE, TMR
 STA. 623+38.69
 FD R.R. SPIKE
 GPS, REF41
 5/26/10, DCH

O.D.O.T. DISTRICT 2 SURVEY OFFICE

PERSONNEL

REFERENCE NO. 41

SHEET 2 OF 30

NOTES Rousas

H.C. Rousas

R.C. CANTERBURY

DATE 6-8-95

WEATHER CLOUDY

TEMP. 55°

ROUTE SR 53

COUNTY OTTAWA

TOWNSHIP CATAWBA

SECTION _____

T _____ R _____


TYPE MONUMENT IRON PIN

ON SURFACE - BELOW 2"

LEFT - CL PAV'T. - ~~RIGHT~~ 61.8' LT. CL SR 53

TO _____ EDGE PAVEMENT

S.L.M. 696.20

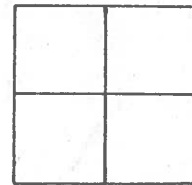


RECORD

P.I. RAW

623+3869

IRON PINS BELOW

BLACKTOP DRIVE

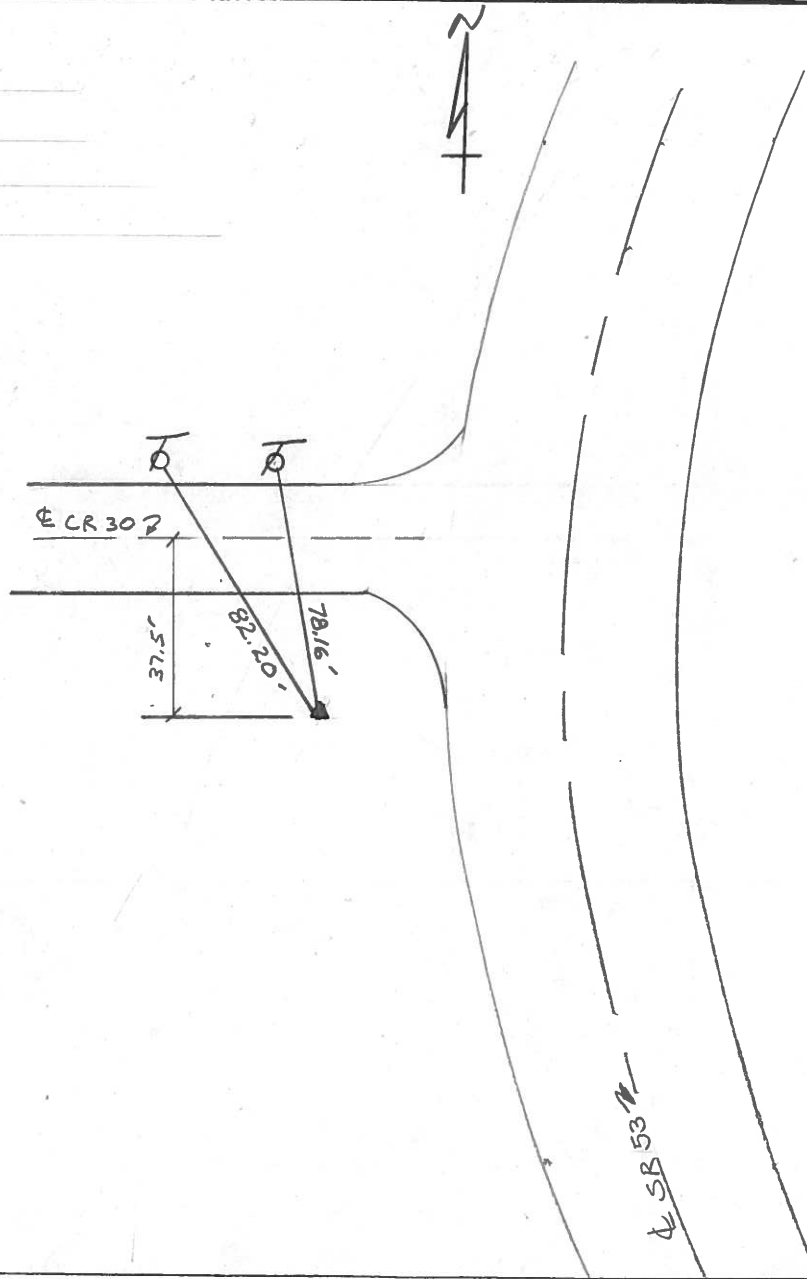

OD.O.T. DISTRICT 2 SURVEY OFFICE

SHEET _____ OF _____

County Ottawa S.R. #53

Date 8/28/84

Township Catawba

Weather overcast

Section _____

Temp. 68°

T N, R E



Personnel Cronin

Ripple

Geyman

Barbour

41

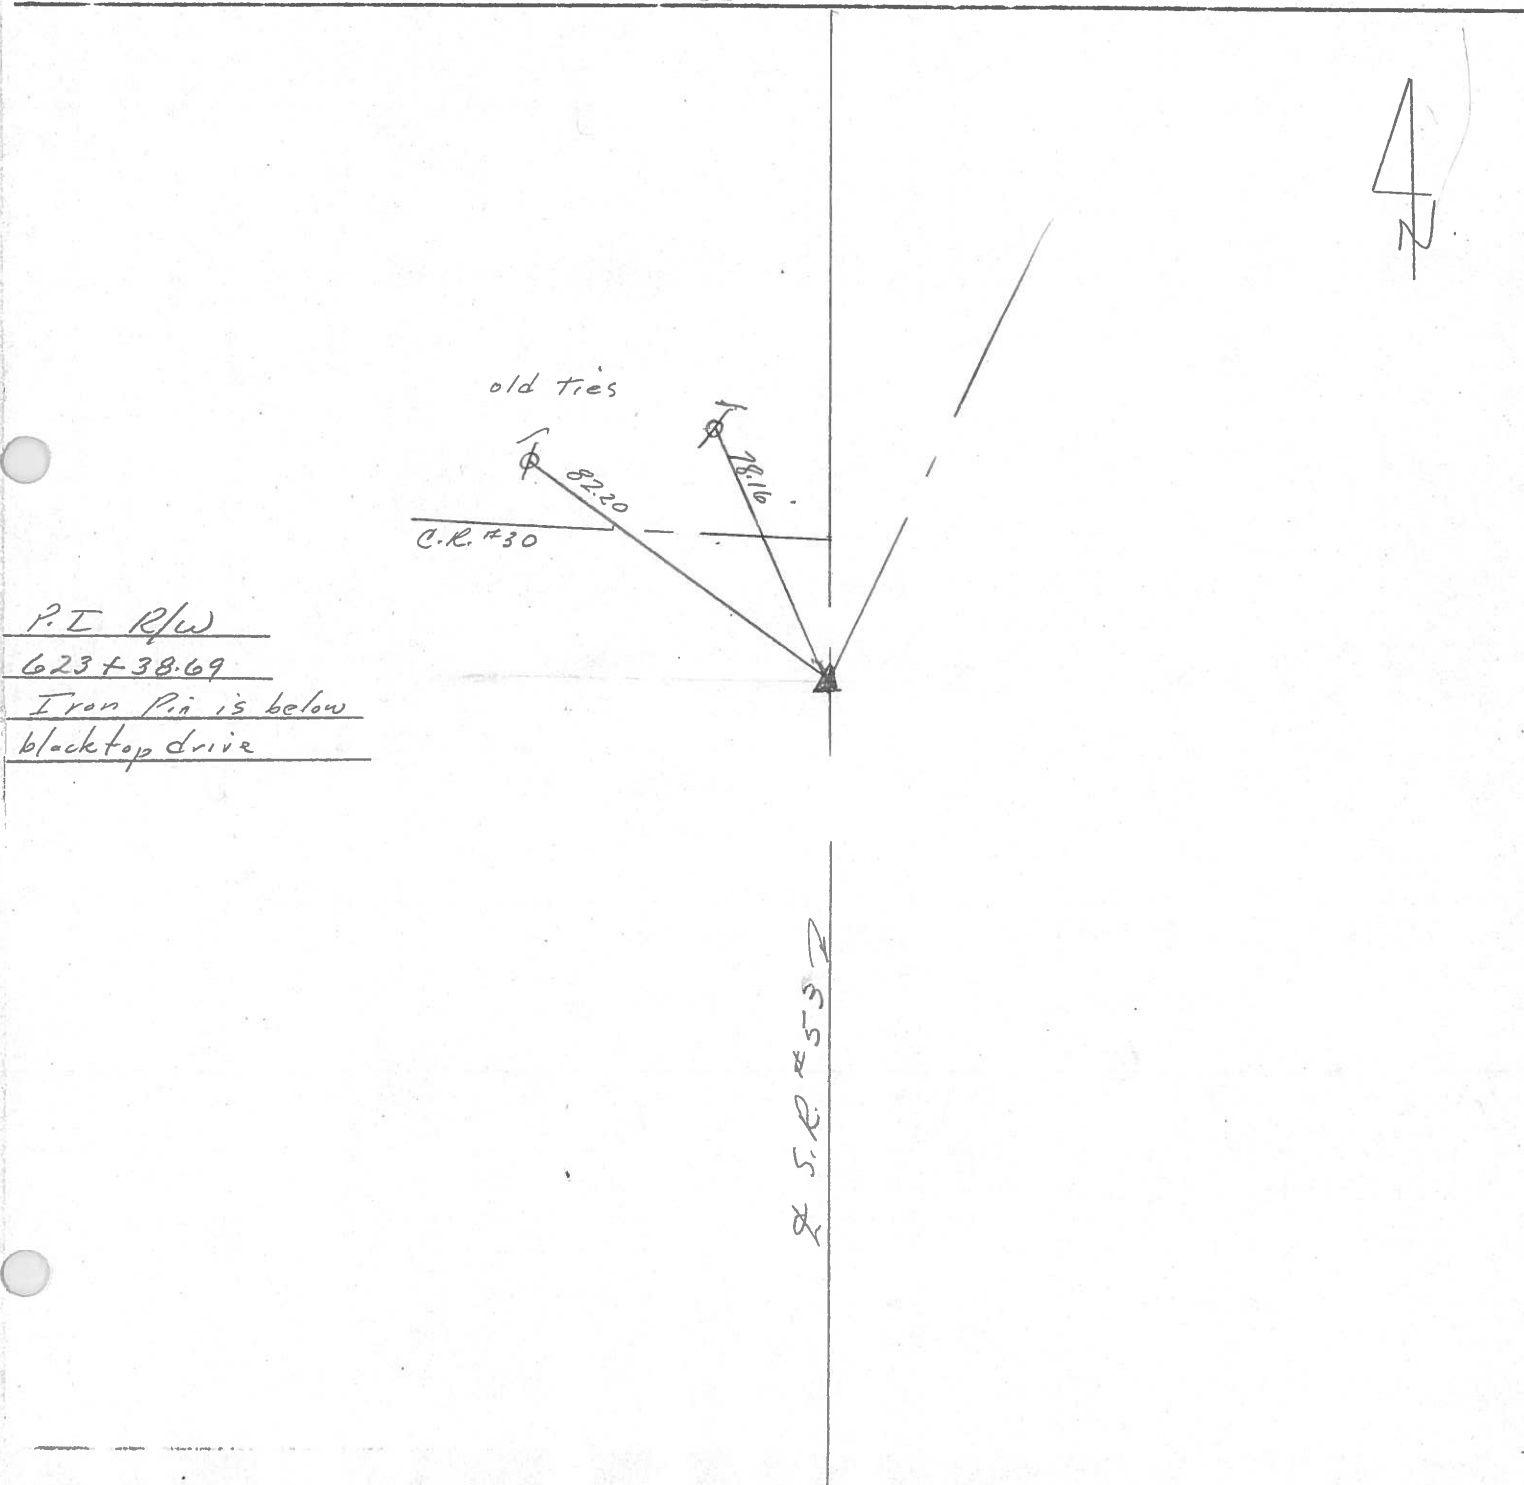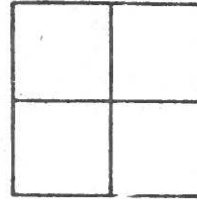

P.I. R/W

623 + 38.69




Iron Pin is below

blacktop drive

S.R. #53





PERSONNEL	TITLE	PERSONNEL	TITLE	COUNTY	DATE	S. R.	WEATHER	TEMP.	JOB NO.
Schneider				Ottawa	5-17-71	53	Fair	76°	
Mosser									
Barbour									
Geyman									

DESCRIPTION From S.R. #163 - North

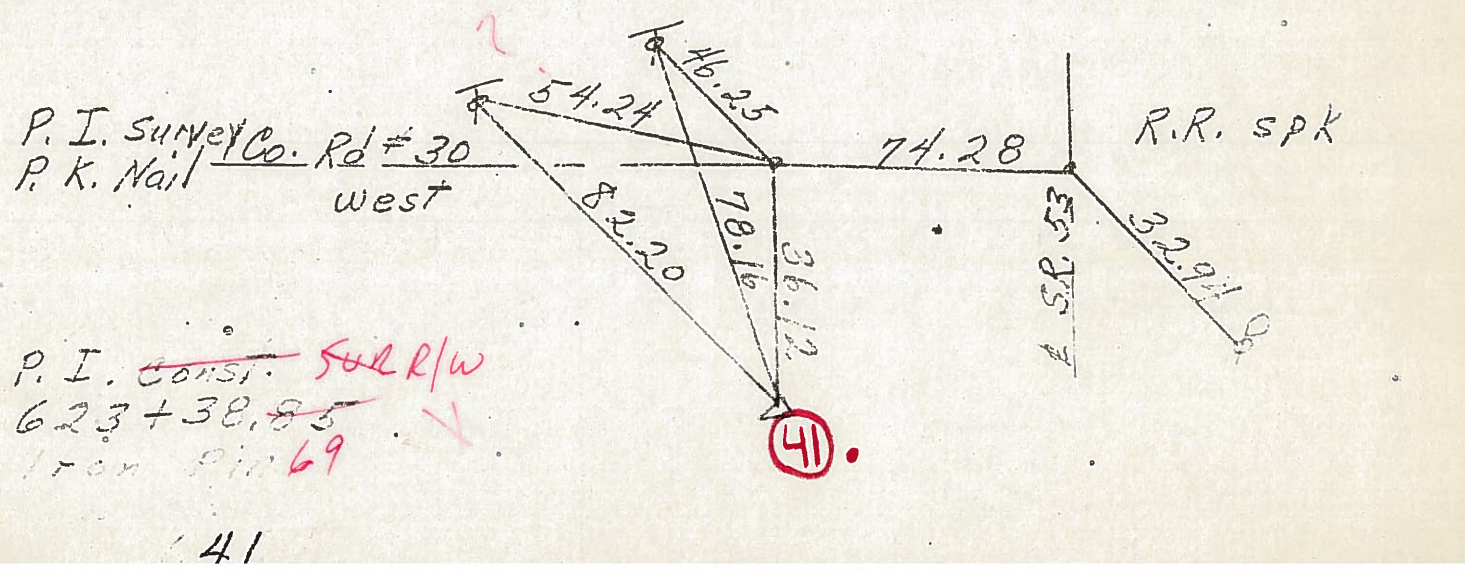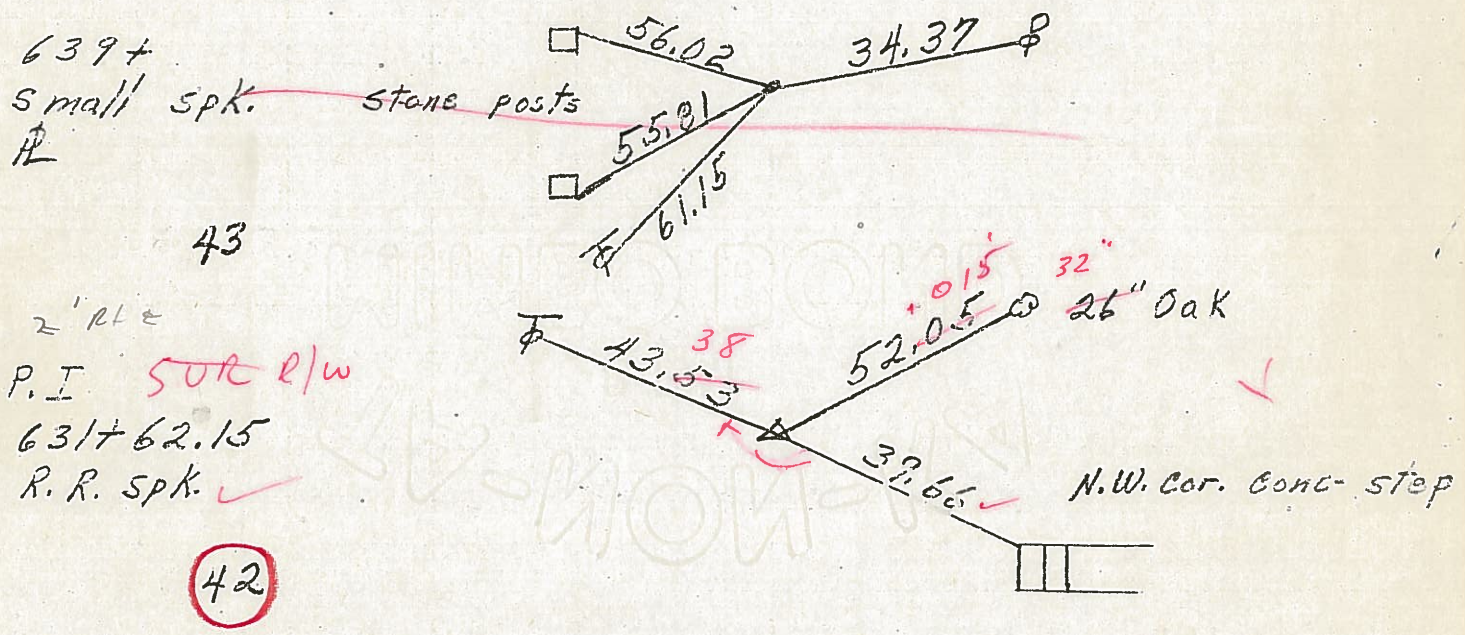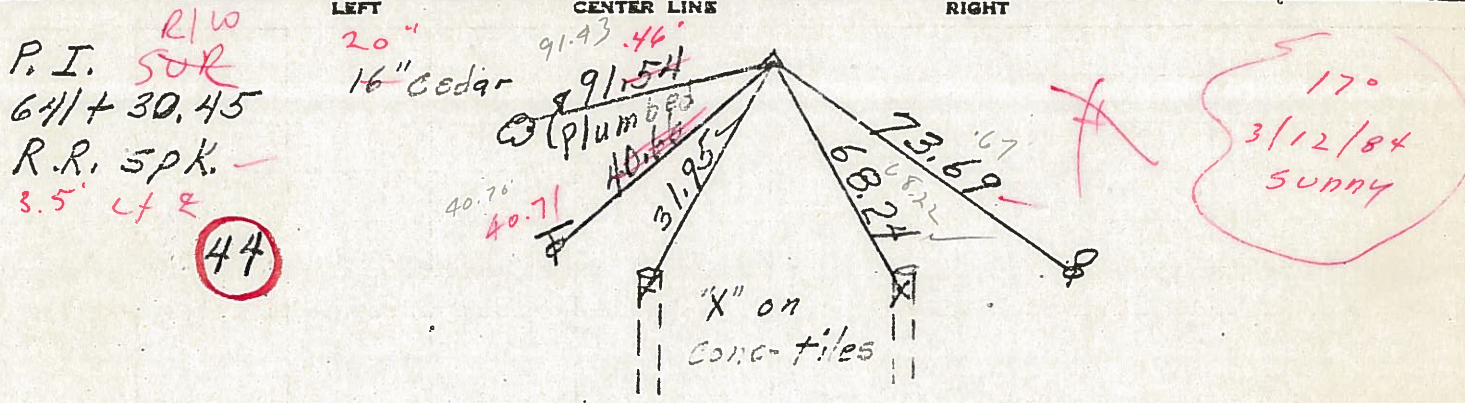


PERSONNEL	TITLE	PERSONNEL	TITLE	COUNTY	DATE
Schneider				Ottawa	5-17-71
Mosser				S. R. 53	WEATHER Fair
Barbour				SEC.	TEMP. 76°
Geyman					

DESCRIPTION From S.R. #163 - North

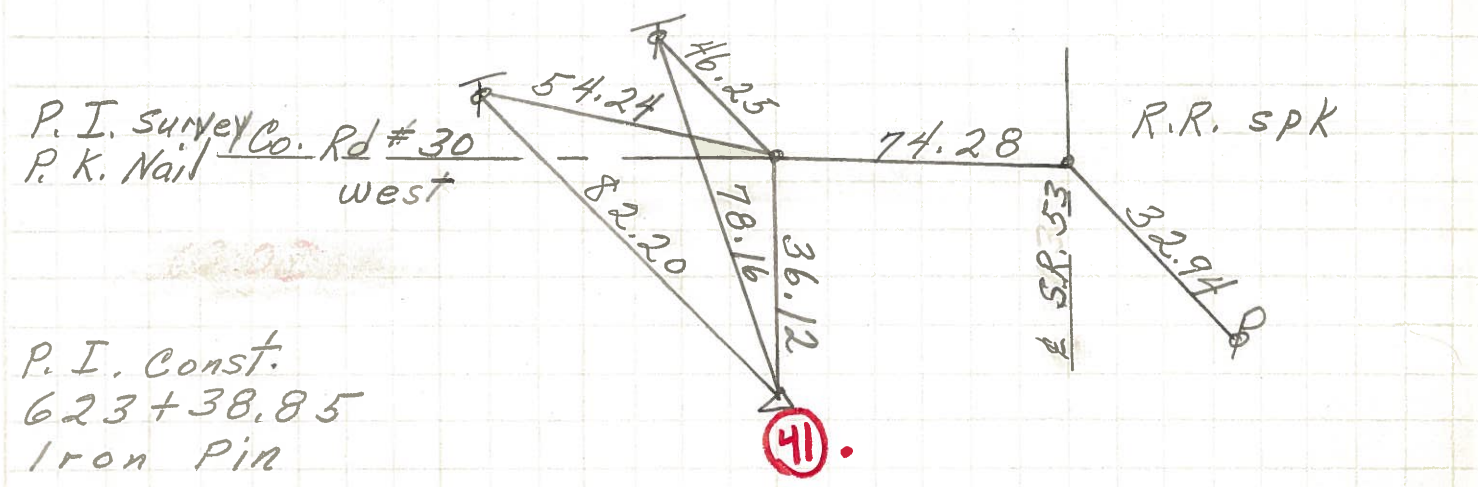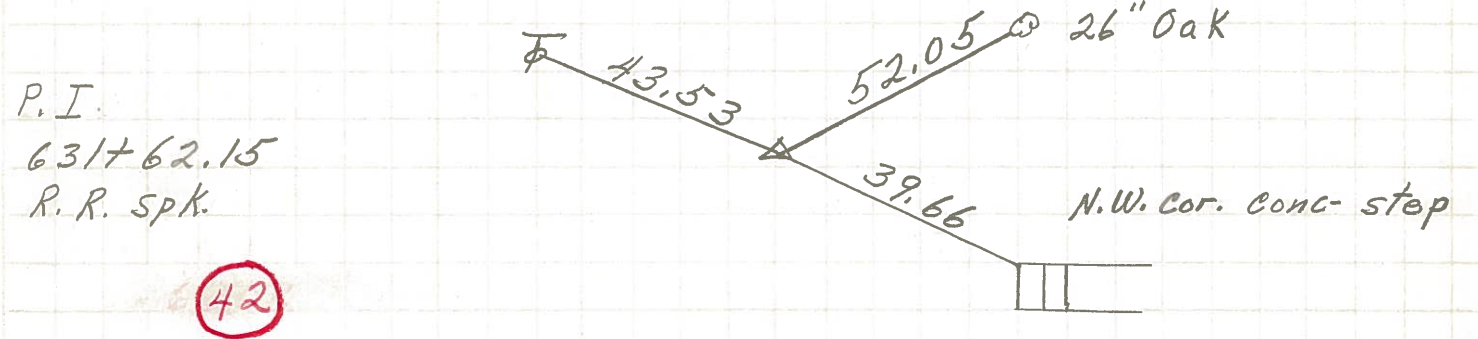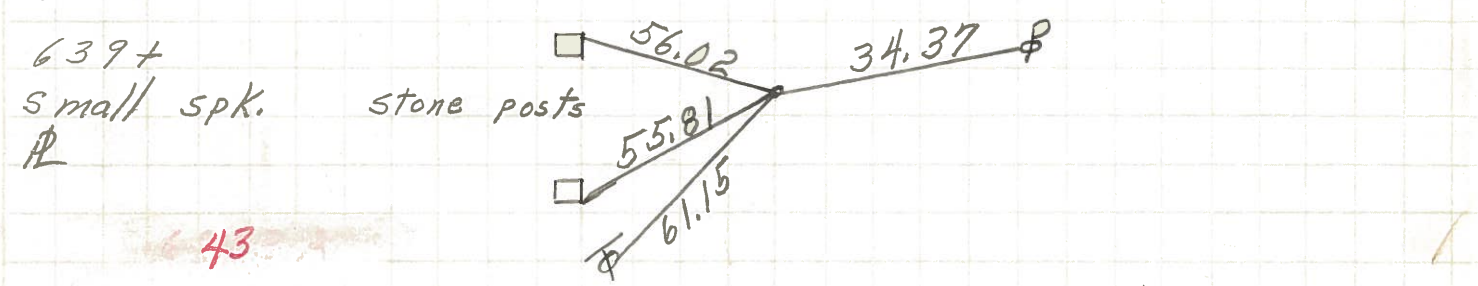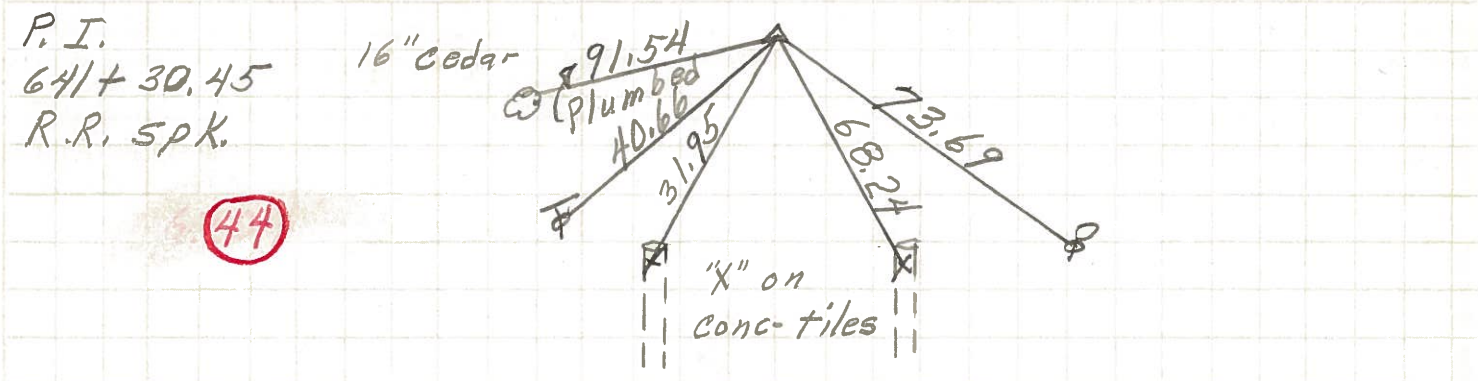

PERSONNEL	TITLE	PERSONNEL	TITLE	COUNTY	DATE
Schneider		Potts		Ottawa	8-1-68
Mosser				S. R. 53	WEATHER Partly cloudy
Barbour				SEC. S.R. #163 North	TEMP. 75°
Redding					

DESCRIPTION Ties for Central Points JOB NO. _____

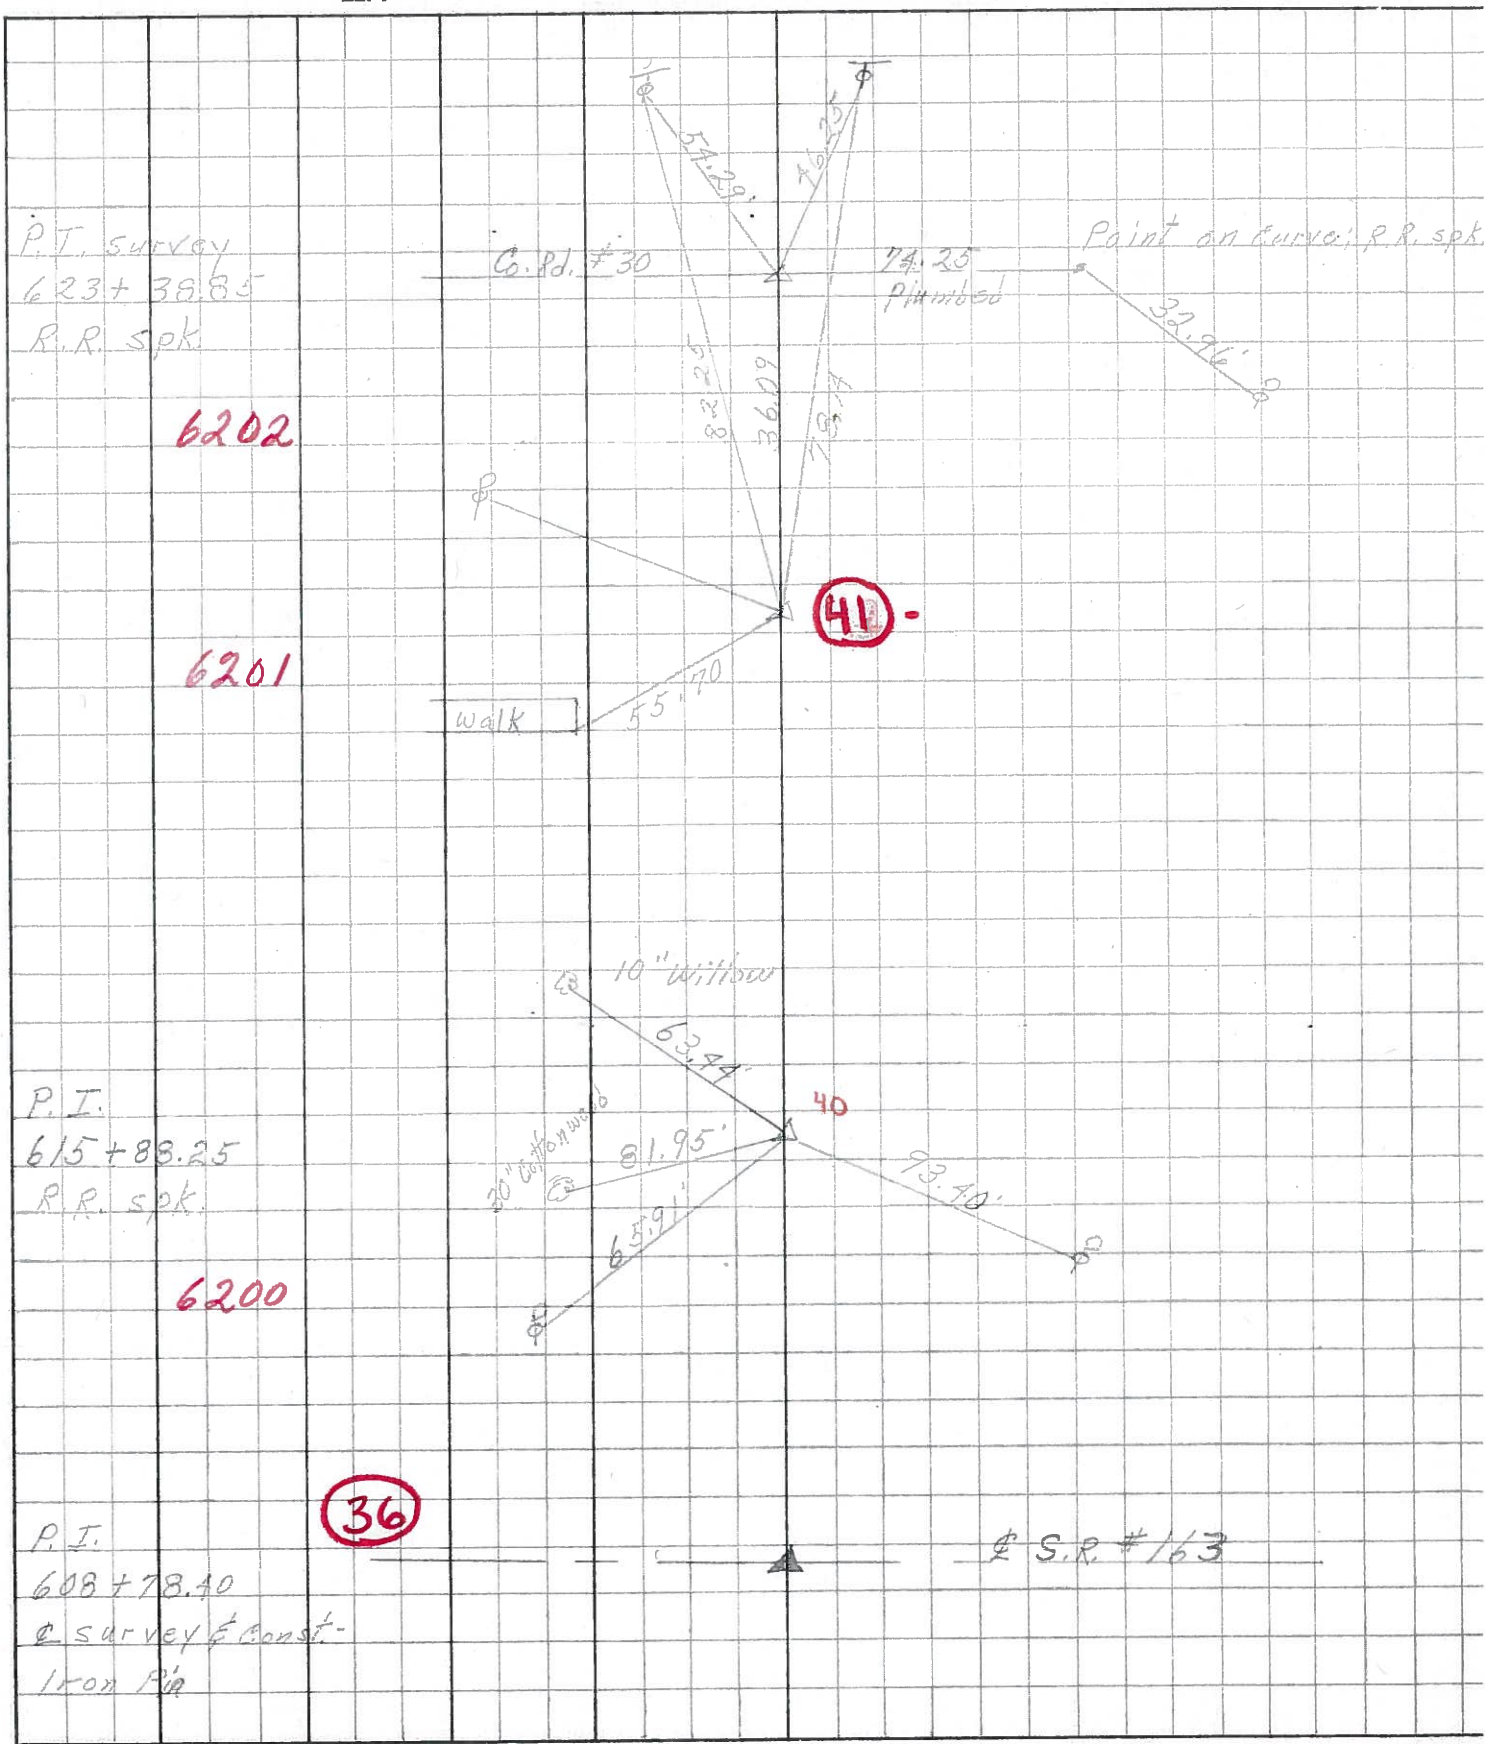

PERSONNEL TITLE PERSONNEL TITLE

SWORDEN
Holcombe
SAGE
AULT

COUNTY OTTAWA

DATE JAN. 17, 1958

S. R. #53

WEATHER CLEAR

SEC. _____

TEMP. +30°

DESCRIPTION Ties for Survey Pins

LEFT

CENTER LINE

RIGHT

JOB NO. _____

