


O.D.O.T. DISTRICT 2 SURVEY OFFICE (USE ONLY)

PERSONNEL _____ REFERENCE NO. 50 SHEET 8 OF 34
 NOTES RHOADES DATE 8/24/23 ROUTE SR 53
 H.C. NIESE WEATHER SUNNY COUNTY OTTAWA
 R.C. AUBLE TEMP. 78° TOWNSHIP CATAWBA
 DWG BY RHOADES PID 102905 SECTION 4-29
 CONNECTICUT WESTERN RESERVE


TYPE MONUMENT MAG/WASHER
 ON SURFACE - ~~BELOW~~ ON
 OFFSET Q PAVEMENT 0.3' LT : ~~RT~~
11.4' TO LT EDGE PAVEMENT
 STATION: 765+91.65

HORZ. DATUM: NAD83 2011 GEOID: NAVD88 2018
 GRID: NORTHING: 684398.499 EASTING: 1873508.944

NOTE: THIS MAP IS FOR ODOT PURPOSES ONLY TO INDEX REFERENCE TIES, AND DOES NOT REPRESENT TRUE LAND SUBDIVISION.

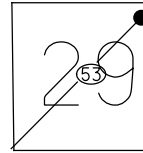

RECORD: P.I.
 STA. 692+76.53
 FD P.K./WASHER
 6/12/95
 SET P.K./WASHER
 5/30/96, CL
 FD P.K./WASHER
 REF50
 8/25/11, DCH
 SET MAG/WASHER
 NEWREF50
 7/30/12, DCH
 FD MAG/WASHER
 REF50
 3/3/21, JFO
 SET MAG/WASHER
 5/15/23, TDN


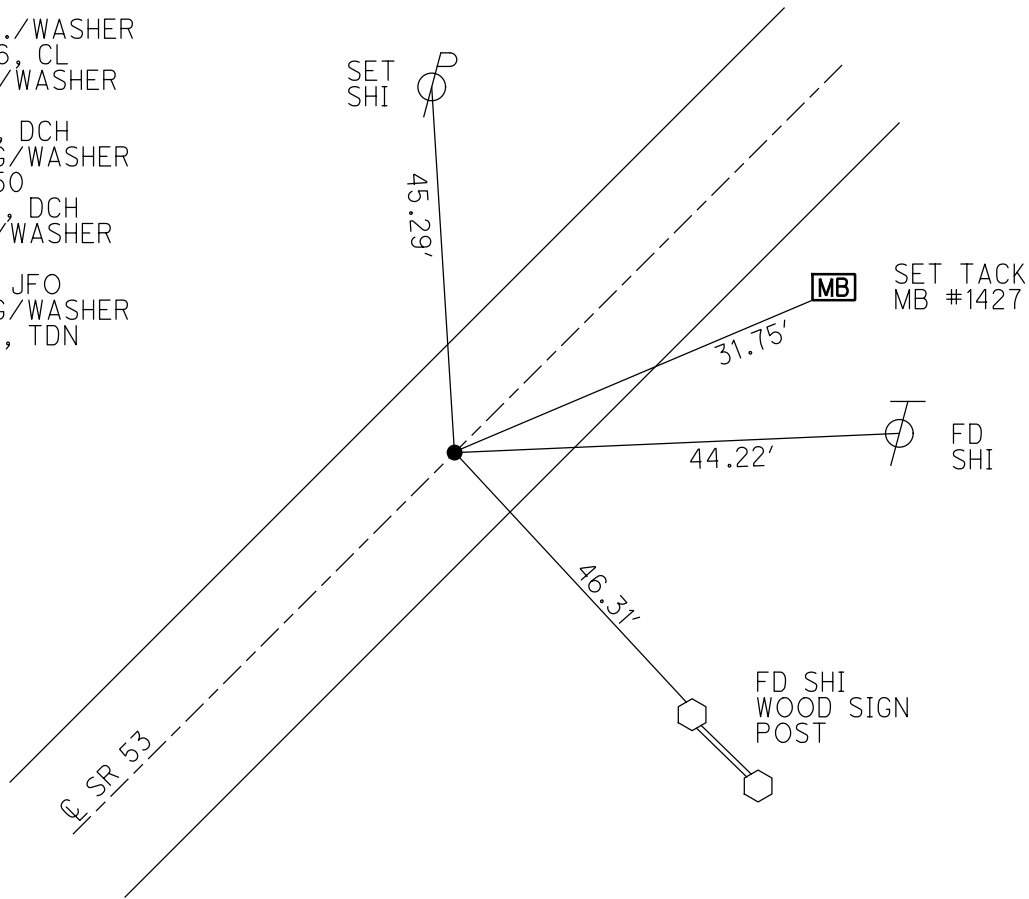


O.D.O.T. DISTRICT 2 SURVEY OFFICE (USE ONLY)


PERSONNEL	REFERENCE NO.	50	SHEET	11	OF	36
NOTES	HOMAN	DATE	8/25/11	ROUTE	SR	53
H.C.	HOMAN	WEATHER	SUNNY	COUNTY	OTTAWA	
R.C.	HARBAUGH	TEMP.	75°	TOWNSHIP	CATAWBA ISL	
				SECTION	4-29	

TYPE MONUMENT P.K./WASHER
 ON SURFACE - ~~BELOW~~ ON
 LEFT - PAV'T - ~~RIGHT~~ 0.3'
11.4' TO LT EDGE PAVEMENT
 S.L.M. 766+13.23
 GRID: NORTHING: 684398.559 EASTING: 1873508.815

NOTE:
THIS MAP IS FOR ODOT PURPOSES ONLY
TO INDEX REFERENCE TIES, AND DOES NOT
REPRESENT TRUE LAND SUBDIVISION.

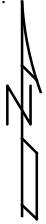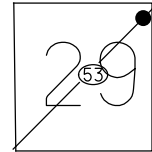

RECORD: P.I.
 STA. 692+76.53
 FD P.K./WASHER
 6/12/95
 SET P.K./WASHER
 5/30/96, CL
 FD P.K./WASHER
 GPS, REF50
 SET MAG/WASHER
 NEWREF50
 7/30/12, DCH

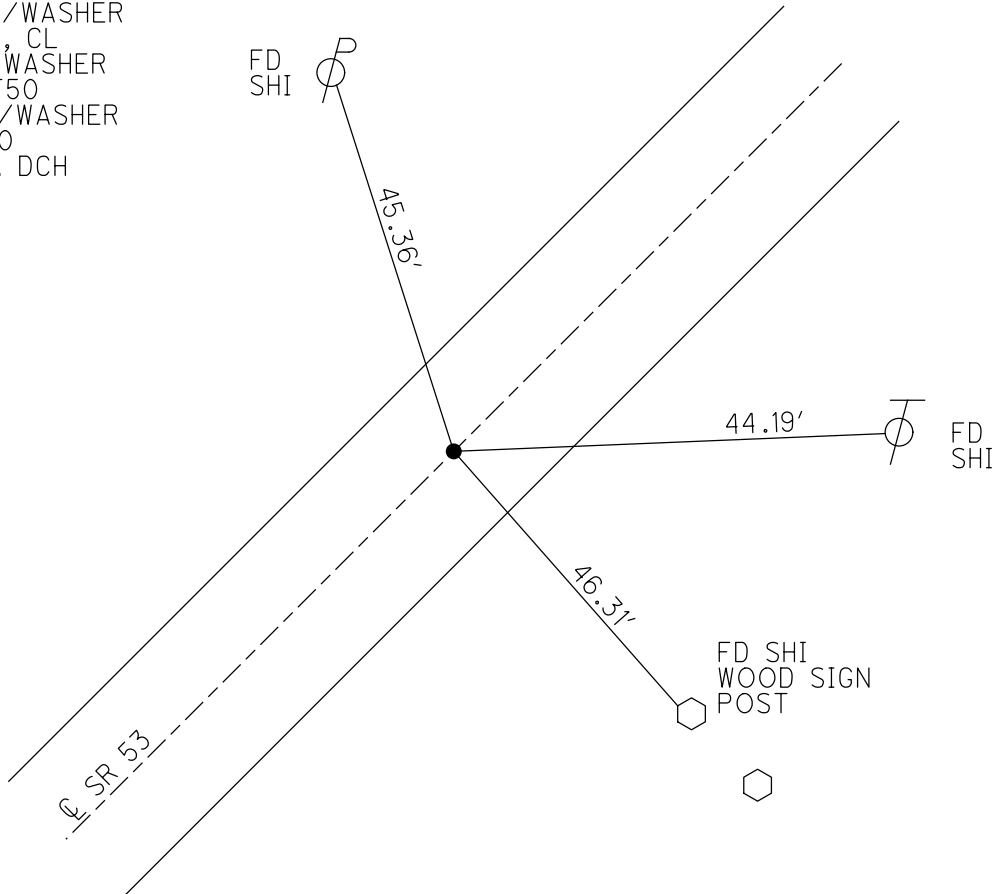

O.D.O.T. DISTRICT 2 SURVEY OFFICE

PERSONNEL _____

REFERENCE NO. 50

SHEET 8 OF 30

NOTES LOHRKE

H.C. ROUSOS

DATE 6-12-95

ROUTE S.R 53

R.C. CANTERBURY

WEATHER FAIR

COUNTY OTTAWA

TEMP. +60

TOWNSHIP CATAWBA Island

SECTION _____

Reset 5-30-96
C.L.

T _____ R _____


TYPE MONUMENT P.K./WASHER

ON SURFACE - BELOW Yes


LEFT - C PAV'T. - RIGHT 0.3

11.4 TO Lt EDGE PAVEMENT

S.L.M. 765+98

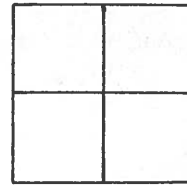

Record P.I.
Sta 692+76.53

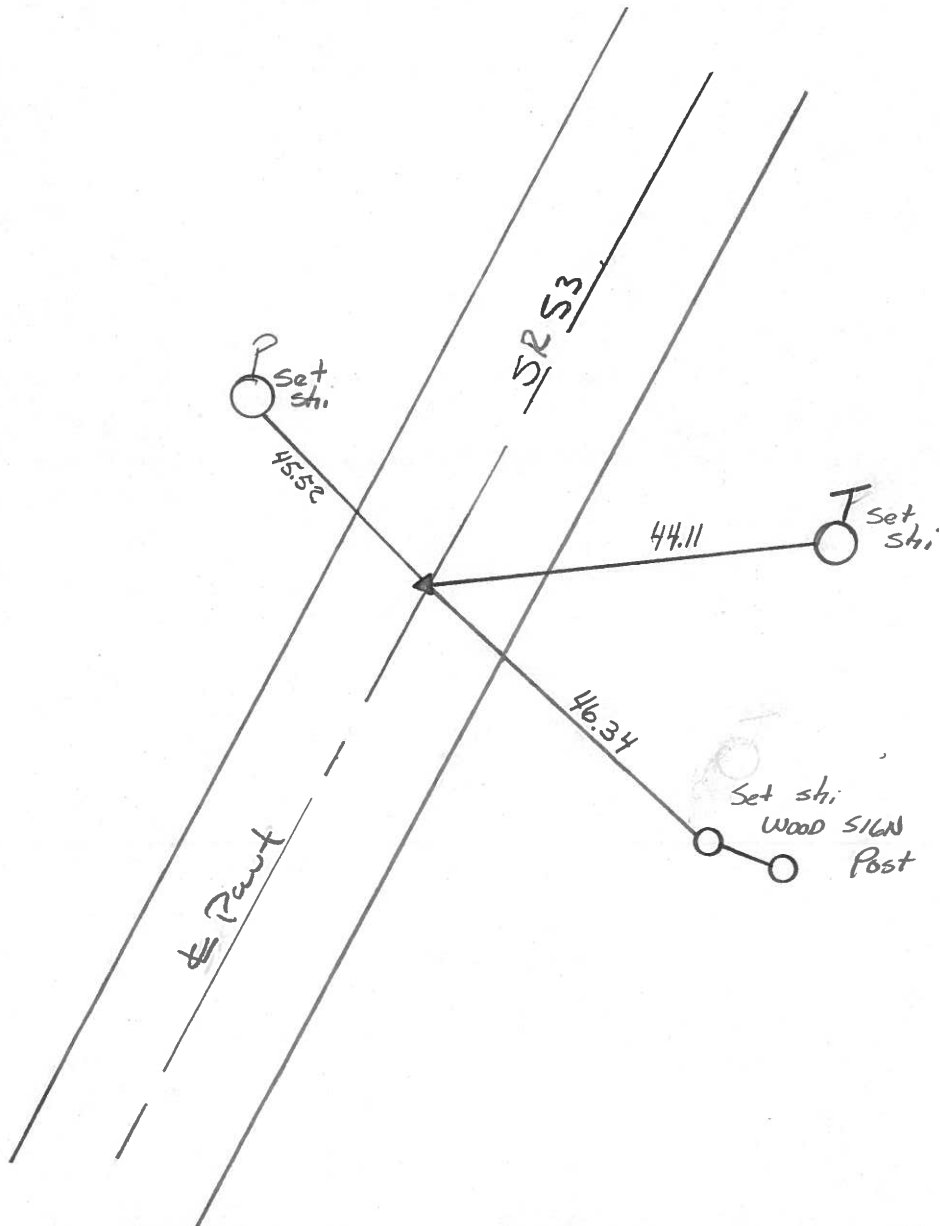

Res
#1427

ODOT. DISTRICT 2 SURVEY OFFICE

SHEET _____ OF _____

County Ottawa S.R. #53

Date 8/28/84

Township Catawba


Weather sunny

Section _____

Temp. 68°

T N, R E

Personnel Cronin

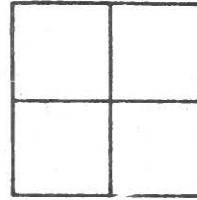


PT 50

Ripple

Geyman


Barbour

P.I. R/W
692+76.53
set P.K. & washer atop
R.R. spike

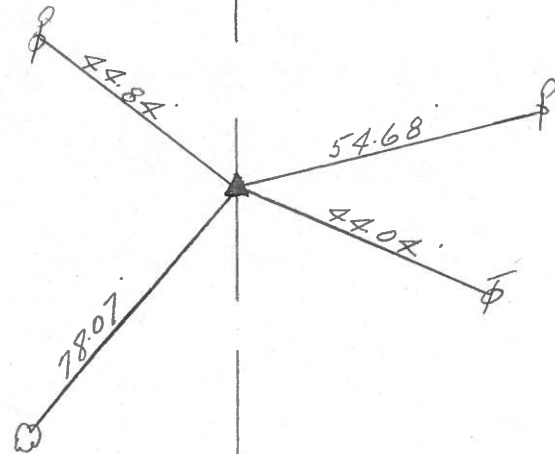

R/W S.R. #53

PERSONNEL	TITLE	PERSONNEL	TITLE	COUNTY	DATE
Schneider				Ottawa	5-18-71
Mosser				S. R. 53	WEATHER Fair
Barbour				SEC.	TEMP. 75°
Geyman				DESCRIPTION	JOB NO.

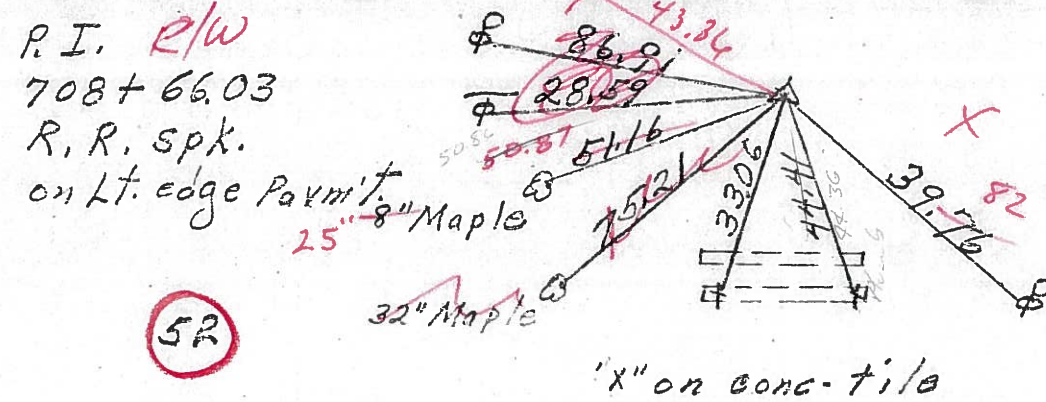


3/12/84
12°
Sunny
708+66.03
71+70
780+36.03

52

"x" on conc. tile


T.S. 706+12.47
R.R. spk.

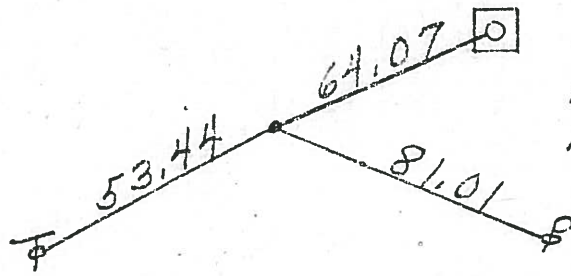

Parcel Post
Mobile Home sign
1.6' up from conc. base

51


P.I. R/W
692+76.53
R.R. spk.

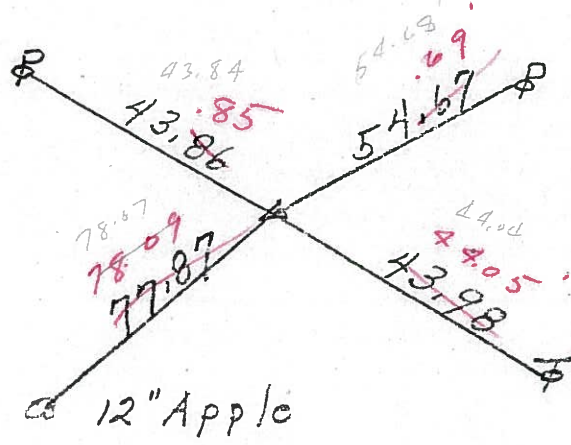

692+76.53
71+70
764+46.53

50

665+66
Small R.R. spk.

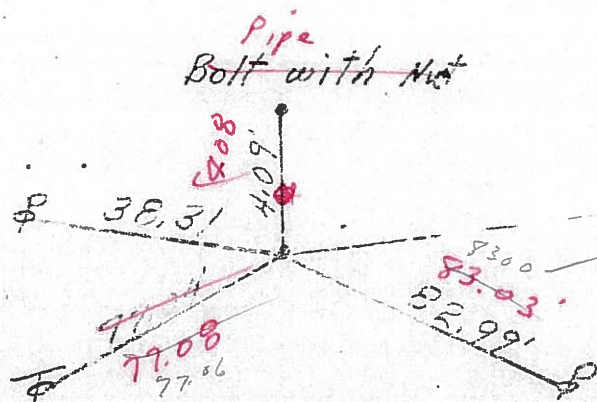


665+66
71+70
737+36
Temp. 80° East

49

PERSONNEL	TITLE	PERSONNEL	TITLE	COUNTY	DATE
Schneider				Ottawa	5-18-71
Mosser				S. R. 53	WEATHER Fair
Barbour				SEC.	TEMP. 75°
Geyman					
DESCRIPTION	S.R. #163 North			JOB NO.	
	LEFT	CENTER LINE	RIGHT		


P.I.
708+66.03
R.R. spk.
on Lt. edge Parmit's

(52)

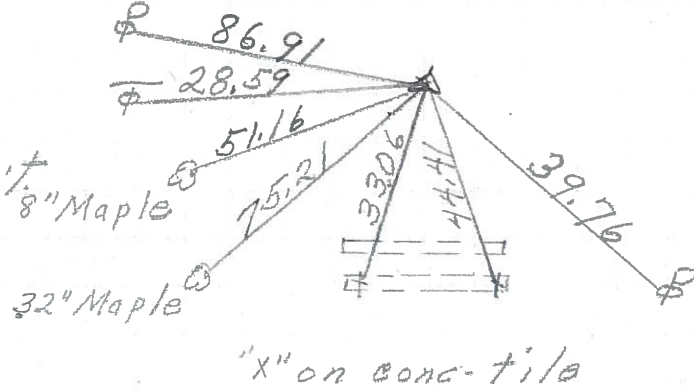

T.S. 706+12.47
R.R. spk.


(51)

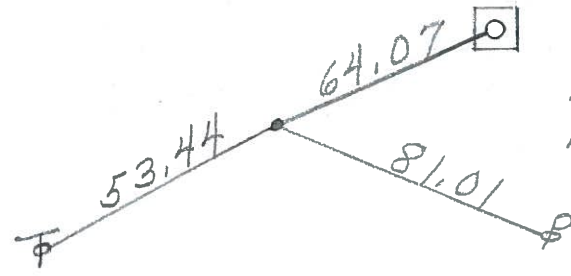

Parcel Post
Mobile Home sign
1.6' up from conc base


P.I.
692+76.53
R.R. spk.

(50)

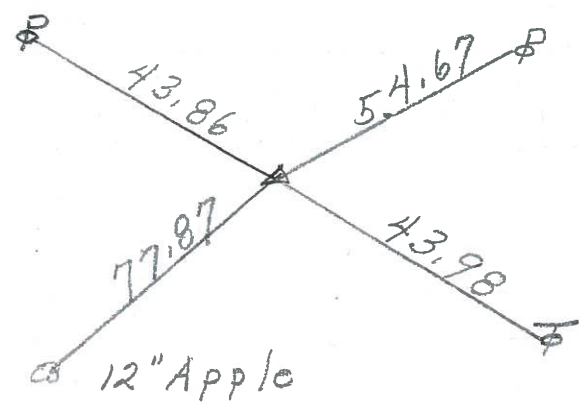

665+66
Small R.R. spk.

(49)

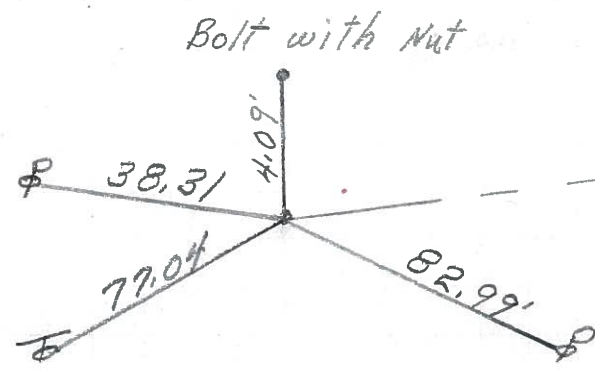

Twp. Rd. #143
East

PERSONNEL	TITLE	PERSONNEL	TITLE	COUNTY	DATE
<u>Schneider</u>		<u>Potts</u>		<u>Ottawa</u>	<u>8-2-68</u>
<u>Masser</u>				S. R.	WEATHER
<u>Barbour</u>				<u>53</u>	<u>Fair</u>
<u>Redding</u>				SEC.	TEMP.
				<u>S.R. #163 North</u>	<u>75°</u>
DESCRIPTION	<u>Ties for Control Points</u>			JOB NO.	

