

O.D.O.T. DISTRICT 2 SURVEY OFFICE (USE ONLY)

PERSONNEL

REFERENCE NO. 57

SHEET 15 OF 34

NOTES RHOADES

DATE 8/24/22

ROUTE SR 53

H.C. NIESE

WEATHER SUNNY

COUNTY OTTAWA

R.C. AUBLE

TEMP. 78°

TOWNSHIP CATAWBA

SECTION 4-28

DWG BY RHOADES

PID 102905

CONNECTICUT WESTERN RESERVE

TYPE MONUMENT MAG/WASHER

NOTE:
THIS MAP IS FOR ODOT PURPOSES ONLY.
TO INDEX REFERENCE TIES, AND DOES NOT
REPRESENT TRUE LAND SUBDIVISION.

ON SURFACE - ~~BELOW~~ ON

OFFSET CL PAVEMENT ON LT : RT

11.7' TO LT EDGE PAVEMENT



STATION: 805+30.0

HORZ.DATUM: NAD83 2011


GEOID: NAVD88 2018

GRID: NORTHING: 687424.820

EASTING: 1875977.677

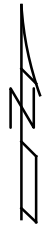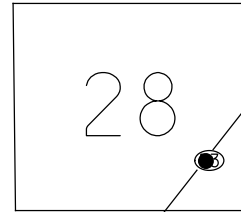

RECORD:
 FD BOLT SPIKE
 1 1/2" DOWN, 6/12/95
 SET P.K./WASHER
 5/23/96, CL
 FD P.K.NAIL
 REF57
 8/26/11, DCH
 SET MAG/WASHER
 NEWREF57
 7/30/12, DCH
 FD MAG/WASHER
 REF57
 3/4/21, JFO
 SET MAG/WASHER
 5/16/23, TDN

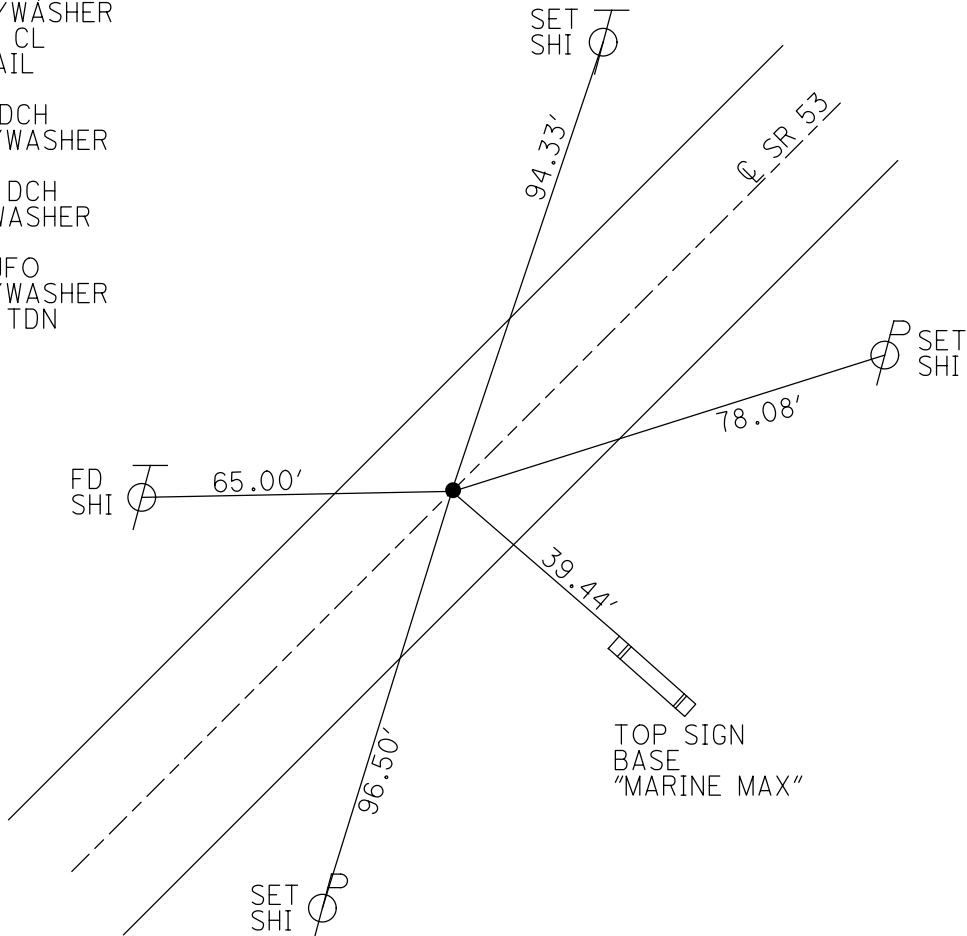


O.D.O.T. DISTRICT 2 SURVEY OFFICE (USE ONLY)


PERSONNEL _____ REFERENCE NO. 57 SHEET 18 OF 36
 NOTES HOMAN DATE 8/26/11 ROUTE SR 53
 H.C. ROUSOS WEATHER SUNNY COUNTY OTTAWA
 R.C. HARBAUGH TEMP. 75° TOWNSHIP CATAWBA ISL
 _____ SECTION 4-28

TYPE MONUMENT P.K.NAIL
 ON SURFACE - ~~BELOW~~ _____ ON _____
 LEFT - ☉ PAV'T - RIGHT ON _____
11.7' TOLT EDGE PAVEMENT
 S.L.M. 805+60.32
 GRID: NORTHING: 687424.828 EASTING: 1875977.592

NOTE:
THIS MAP IS FOR ODOT PURPOSES ONLY.
TO INDEX REFERENCE TIES, AND DOES NOT
REPRESENT TRUE LAND SUBDIVISION.

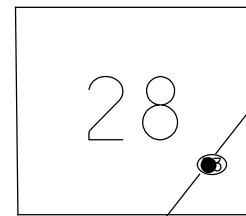

RECORD:
 FD BOLT SPIKE
 1 1/2" DOWN, 6/12/95
 SET P.K./WASHER
 5/23/96, CL
 FD P.K.NAIL
 GPS, REF57
 SET MAG/WASHER
 NEWREF57
 7/30/12, DCH

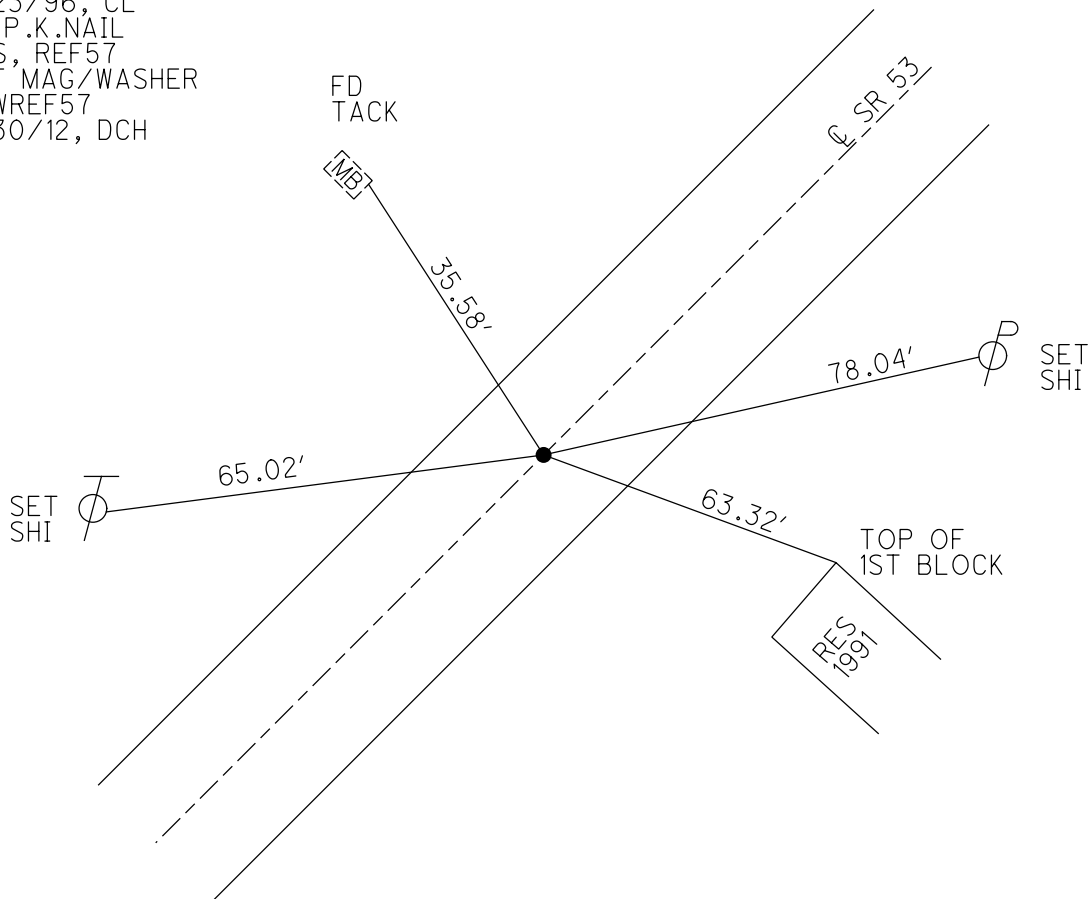

O.D.O.T. DISTRICT 2 SURVEY OFFICE

PERSONNEL

REFERENCE NO. 57

SHEET 13 OF 30

NOTES Loehrke

H.C. Canterbury

R.C. Rausas

DATE 6-12-95

WEATHER Fair

TEMP. +68°F

ROUTE SR 53

COUNTY OTTAWA

TOWNSHIP CATAWBA

SECTION _____

T _____ R _____

Set P.K./WASHER

TYPE MONUMENT BoH SPICE



5-23-96

~~ON SURFACE~~ - BELOW 1 1/2"

LEFT- & PAV'T. - RIGHT ON &

11.7 TO L+ EDGE PAVEMENT

S.L.M. 805+51

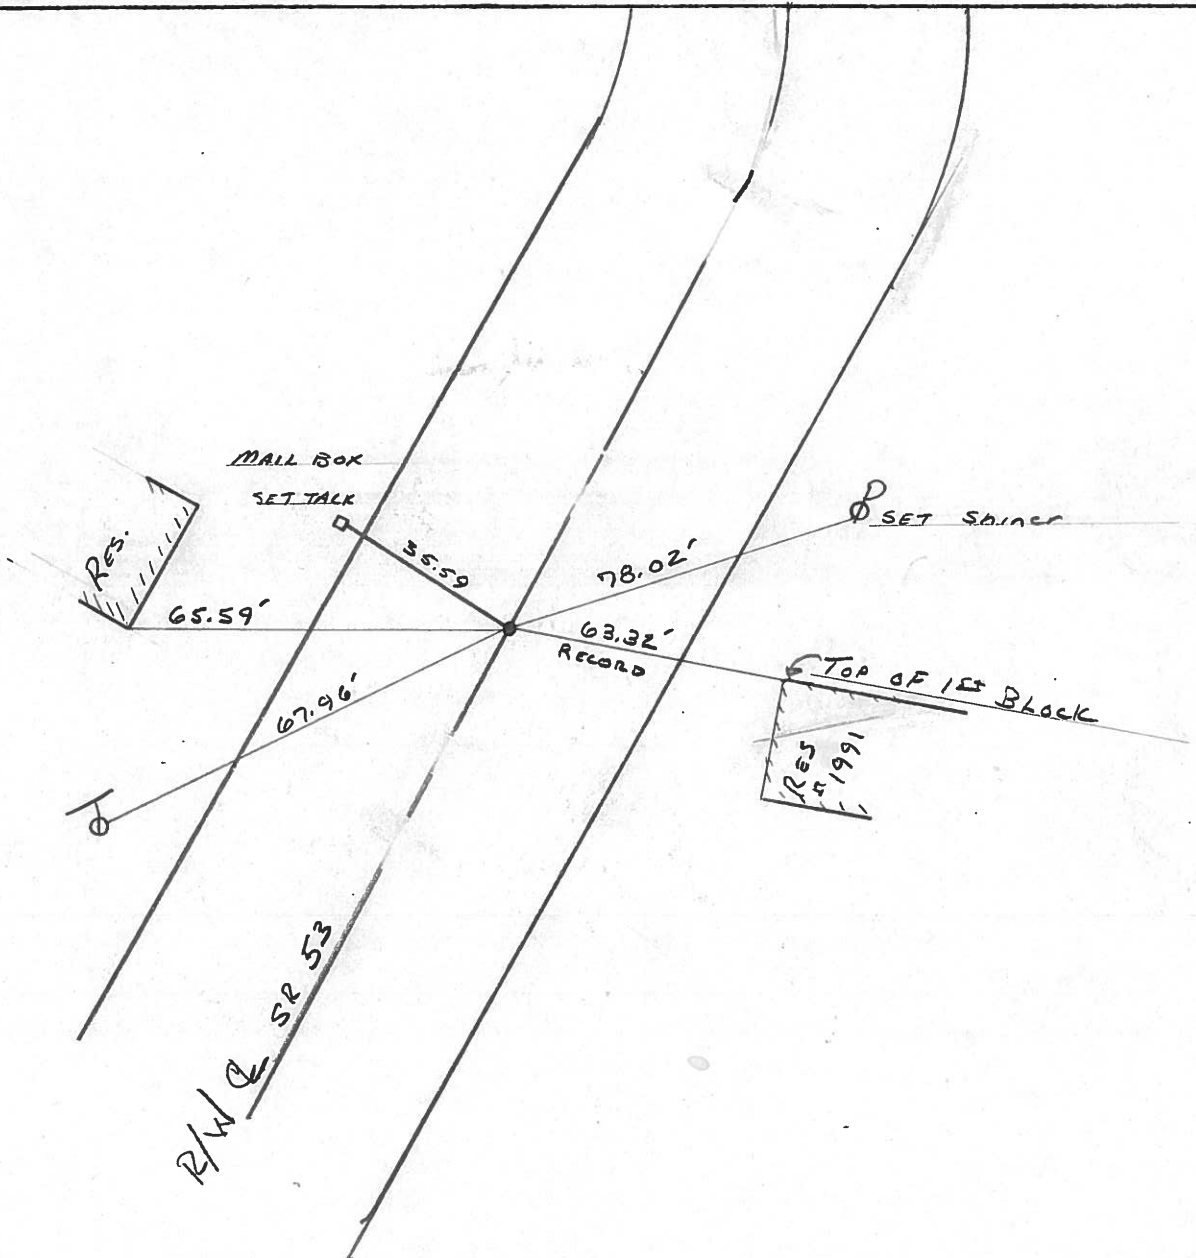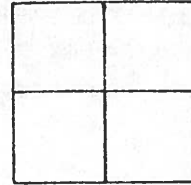

ODOT. DISTRICT 2 SURVEY OFFICE

SHEET _____ OF _____

County Ottawa S.R. #53

Date 8/28/84

Township Catawba

Weather sunny

Section _____

Temp. 80°

T N, R E


Personnel Cronin

Ripple


Geyman

Barbour

PT 57

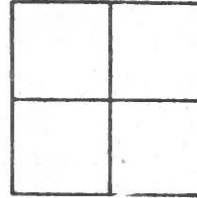

P.I. R/W
734+73.52
set P.K. Washer atop
I. pin 1/2 Rt. Rt. E.P.

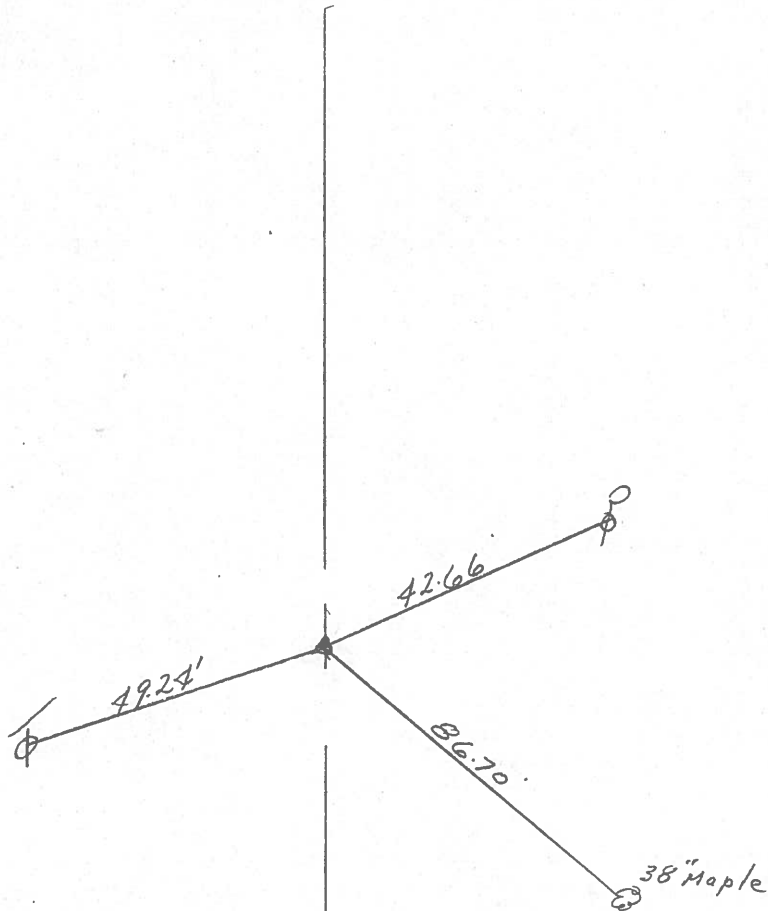

R/W S.R. #53


PERSONNEL	TITLE	PERSONNEL	TITLE	COUNTY	DATE
Schneider				Ottawa	5-18-71
Messer				S. R. 53	WEATHER Windy
Barbour				SEC.	TEMP 80°
Geyman					
DESCRIPTION SR. 163 North					JOB NO.
	LEFT	CENTER LINE	RIGHT		

34°
windy sunny
3/23/84

741+02.13
71+70
812+72.13


3/12/84
overcast
20°
windy

P.I.
741+02.13
R.R. spk.

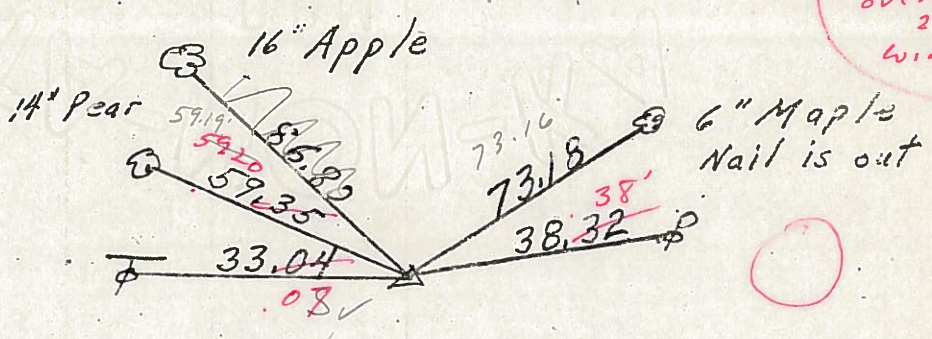


60

S.T. 737+30.15
R.R. spk.

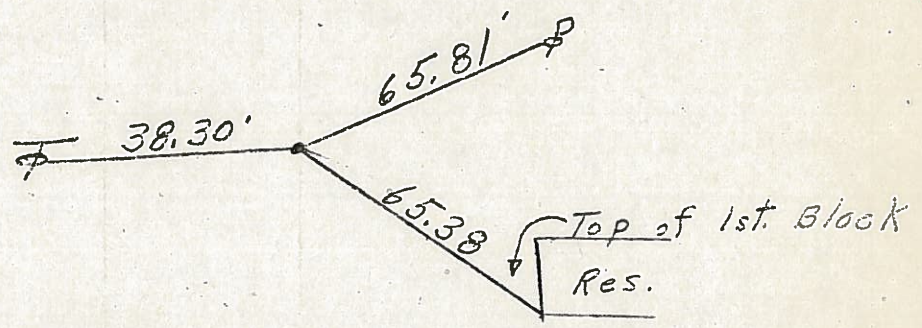


59

P.I. R/W
734+73.52
Iron pin
2" Rt. of Rt. edge
of Pavmt.

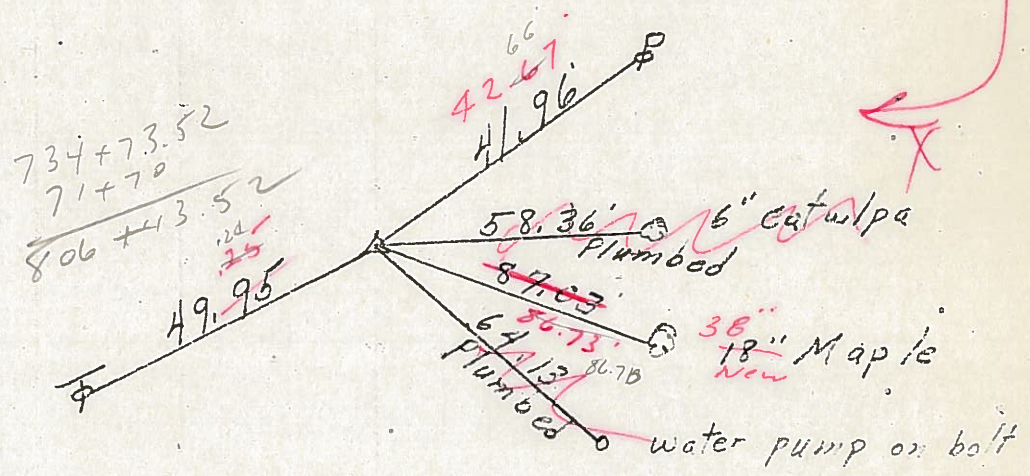

58

T.S. 734+73.52
R.R. Spk.

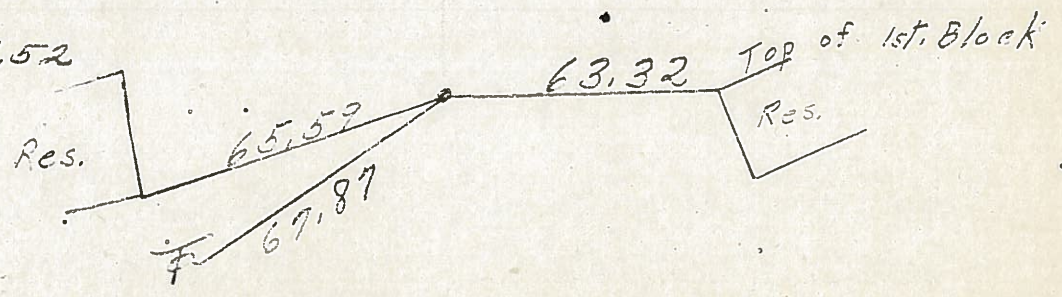


57

PERSONNEL	TITLE	PERSONNEL	TITLE	COUNTY	DATE
Schneider				Ottawa	5-18-71
Mosser				S. R. 53	WEATHER Windy
Barbour				SEC.	TEMP. 80°
Geyman					

DESCRIPTION SR. 163 North


P.I.
741+02.13
R.R. Spk.

60 2

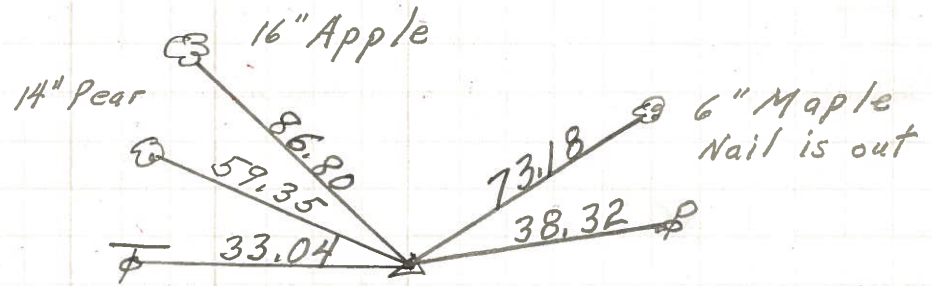


S.T. 737+30.15
R.R. Spk.

59 1-A

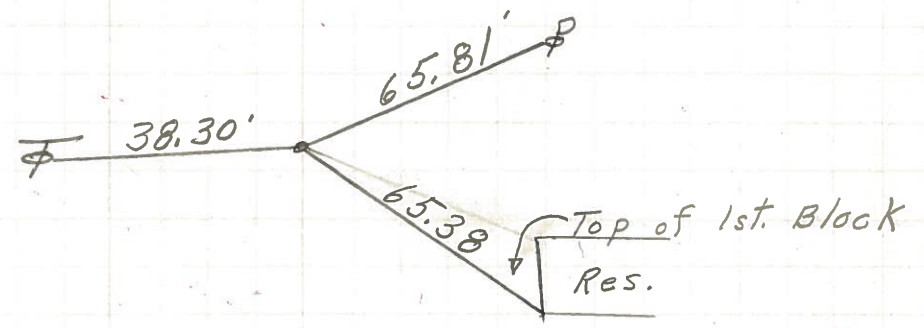

P.I.
734+73.52
Iron pin
2" Rt. of Rt. edge
of Pavmt.

58 1

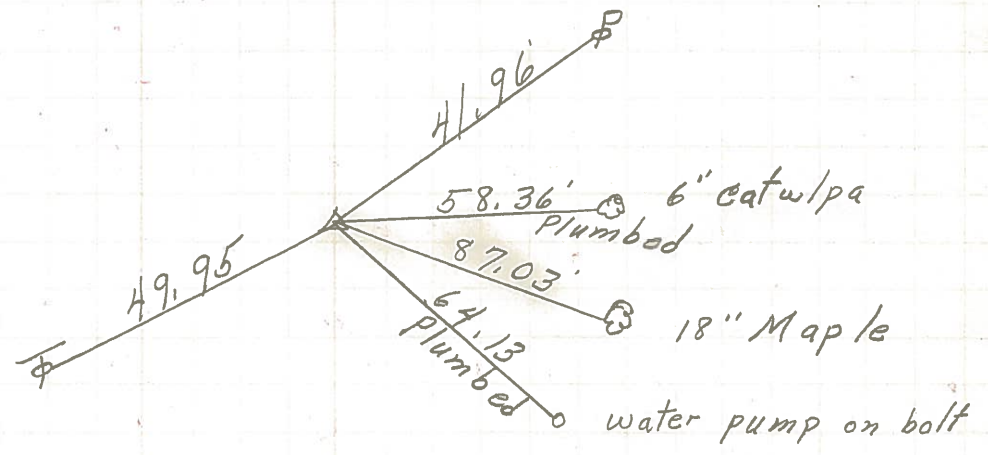

T.S. 734+73.52
R.R. Spk.

57 2

