

O.D.O.T. DISTRICT 2 SURVEY OFFICE (USE ONLY)

PERSONNEL _____ REFERENCE NO. 60 SHEET 18 OF 34
 NOTES RHOADES DATE 8/24/22 ROUTE SR 53
 H.C. NIESE WEATHER SUNNY COUNTY OTTAWA
 R.C. AUBLE TEMP. 80° TOWNSHIP CATAWBA
 SECTION 4-28

DWG BY RHOADES PID 102905

CONNECTICUT WESTERN RESERVE

TYPE MONUMENT MAG/WASHER

NOTE:
THIS MAP IS FOR ODOT PURPOSES ONLY
TO INDEX REFERENCE TIES, AND DOES NOT
REPRESENT TRUE LAND SUBDIVISION.

ON SURFACE - ~~BELOW~~ ON

OFFSET ℄ PAVEMENT ON LT : RT

12.8' TO RT EDGE PAVEMENT


STATION: 814+16.89

HORIZ.DATUM: NAD83 2011


GEOID: NAVD88 2018

GRID: NORTHING: 688152.472

EASTING: 1876476.802

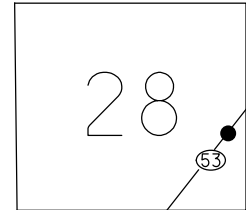

RECORD: P.I.
 STA. 741+02.13
 FD P.K./WASHER
 6/12/95
 SET P.K./WASHER
 5/23/96, CL
 FD P.K.NAIL
 REF60
 8/26/11, DCH
 SET MAG/WASHER
 NEWREF60
 8/6/12, DCH
 FD MAG/WASHER
 REF60
 3/4/21, JFO
 SET MAG/WASHER
 5/16/23, TDN

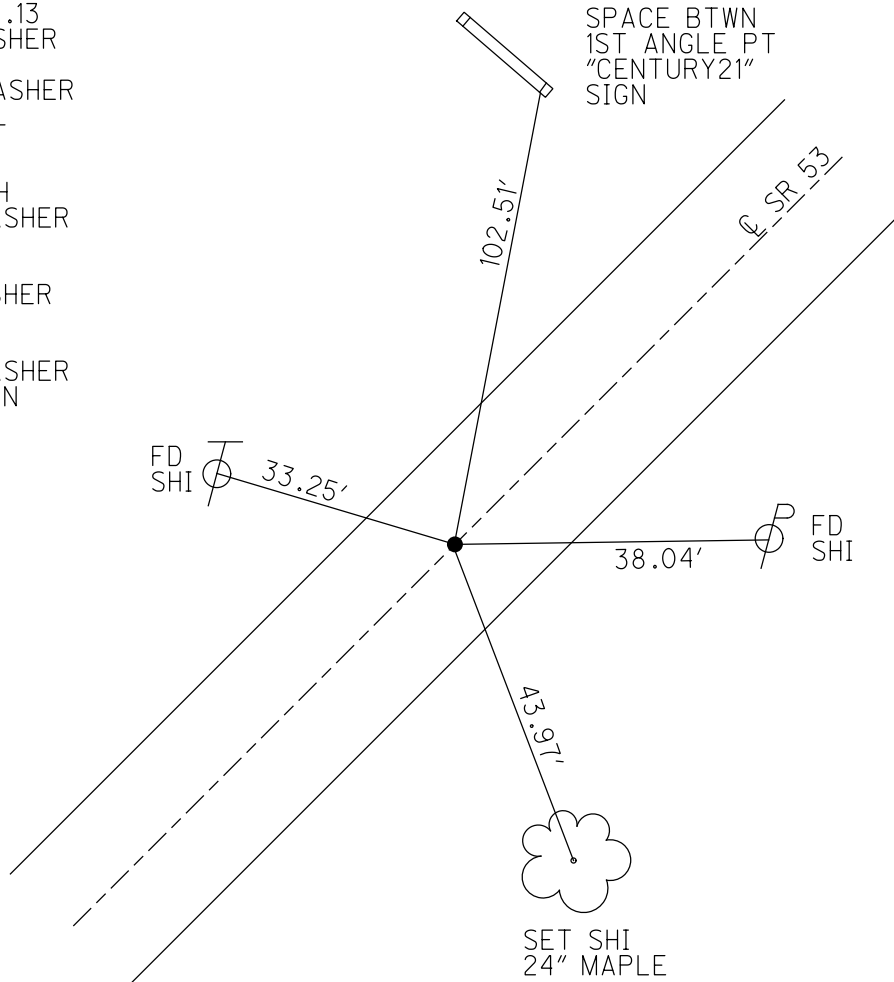


O.D.O.T. DISTRICT 2 SURVEY OFFICE (USE ONLY)

PERSONNEL _____ REFERENCE NO. 60 SHEET 21 OF 36
 NOTES HOMAN DATE 8/26/11 ROUTE SR 53
 H.C. ROUSOS WEATHER CLOUDY COUNTY OTTAWA
 R.C. HARBAUGH TEMP. 75° TOWNSHIP CATAWBA ISL
 _____ SECTION 4-28


TYPE MONUMENT P.K.NAIL
 ON SURFACE - ~~BELOW~~ _____ ON _____
 LEFT - ☉ PAV'T - RIGHT ON _____
12.8' TORT EDGE PAVEMENT
 S.L.M. 814+38.46

GRID: NORTHING: 688152.413 EASTING: 1876476.623

NOTE:
THIS MAP IS FOR ODOT PURPOSES ONLY
TO INDEX REFERENCE TIES, AND DOES NOT
REPRESENT TRUE LAND SUBDIVISION.

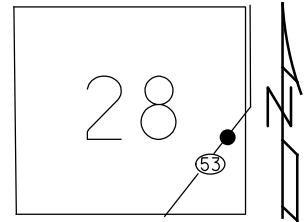

RECORD: P.I.
 STA. 741+02.13
 FD P.K./WASHER
 6/12/95
 SET P.K./WASHER
 5/23/96, CL
 FD P.K.NAIL
 GPS, REF60
 SET MAG/WASHER
 NEWREF60
 8/6/12, DCH

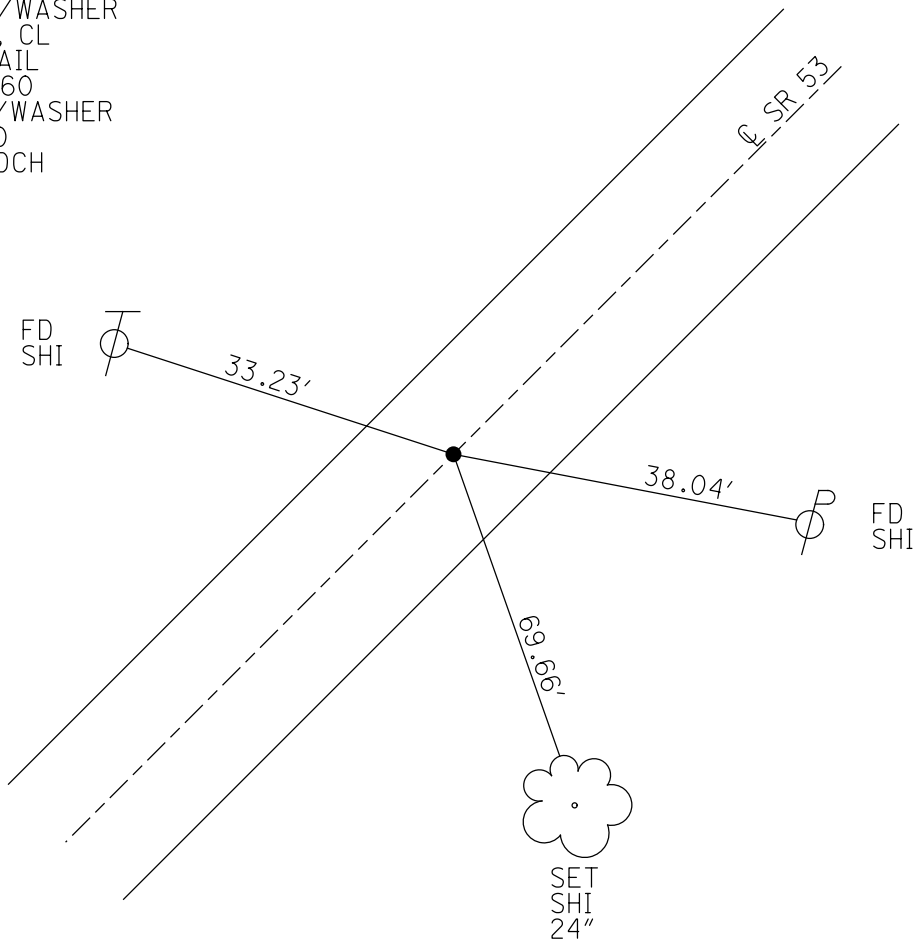

O.D.O.T. DISTRICT 2 SURVEY OFFICE

PERSONNEL _____

REFERENCE NO. 60

SHEET 16 OF 30

NOTES LOEHRKE

H.C. T Rousos

DATE 6-12-95

ROUTE S.R. 53

R.C. CANTERBURY

WEATHER FAIR

COUNTY OTTAWA

TEMP. +70

TOWNSHIP CATAWBA

SECTION _____

T _____ R _____

Reset

5-23-96


TYPE MONUMENT P.K./WASHER

ON SURFACE - BELOW Yes


~~LEFT~~ - ~~C~~ PAV'T. - ~~RIGHT~~ Yes

12.8 TO RT EDGE PAVEMENT

S.L.M. 814 + 37

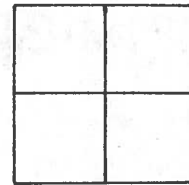

Record P.I. R/W
Sta 741 + 02.13

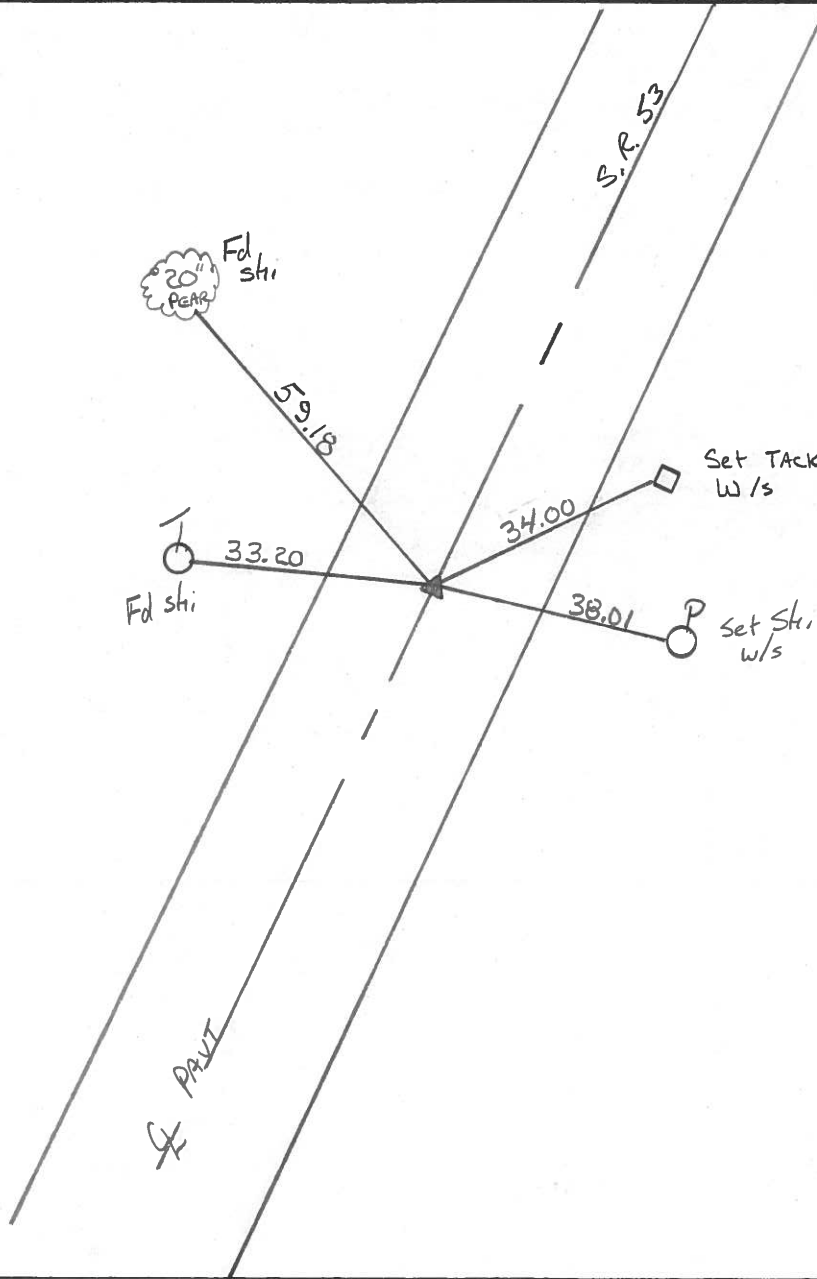

OD.OT. DISTRICT 2 SURVEY OFFICE

SHEET _____ OF _____

County Ottawa S.R. # 53

Date 8/28/84

Township Catawba


Weather sunny

Section _____

Temp. 80°

T N, R E

Personnel Cronin

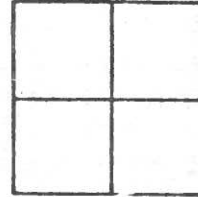


PT 60

Ripple

Geyman

Barbour

P.T. R/W
741+02.13
set P.K.'s washer atop
R.R. spike

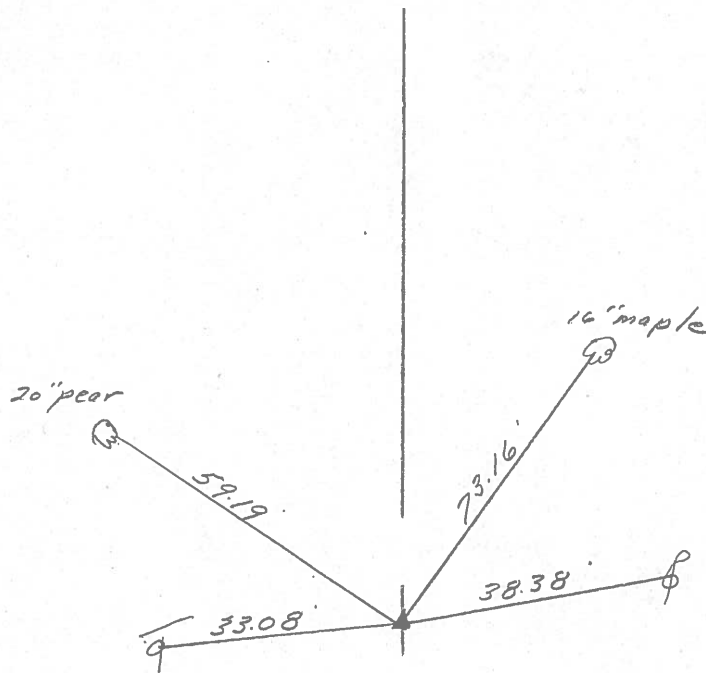


R/W S.R. # 53

PERSONNEL	TITLE	PERSONNEL	TITLE	COUNTY	DATE
Schneider				Ottawa	5-18-71
Messer				S. R. 53	WEATHER Windy
Barbour				SEC.	TEMP 80°
Geyman					
DESCRIPTION S.R. 163 North					JOB NO.
	LEFT	CENTER LINE	RIGHT		

34°
windy sunny
8/23/84

741+02.13
71+70
812+72.13


3/12/84
overcast
20°
windy

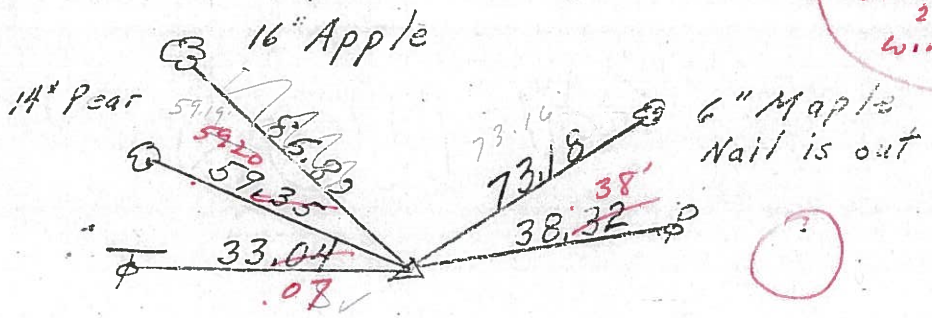

P.I.
741+02.13
R.R. spk.


60

S.T. 737+30.15
R.R. spk.

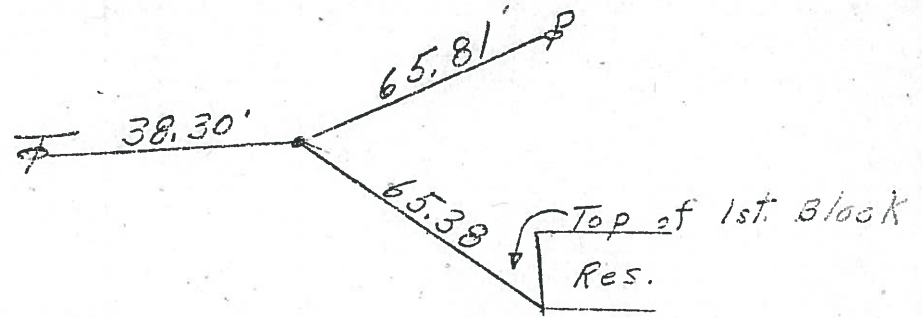


59

P.I. R/W
734+73.52
Iron pin
2" Rt. of Rt. edge
of Pavmt.

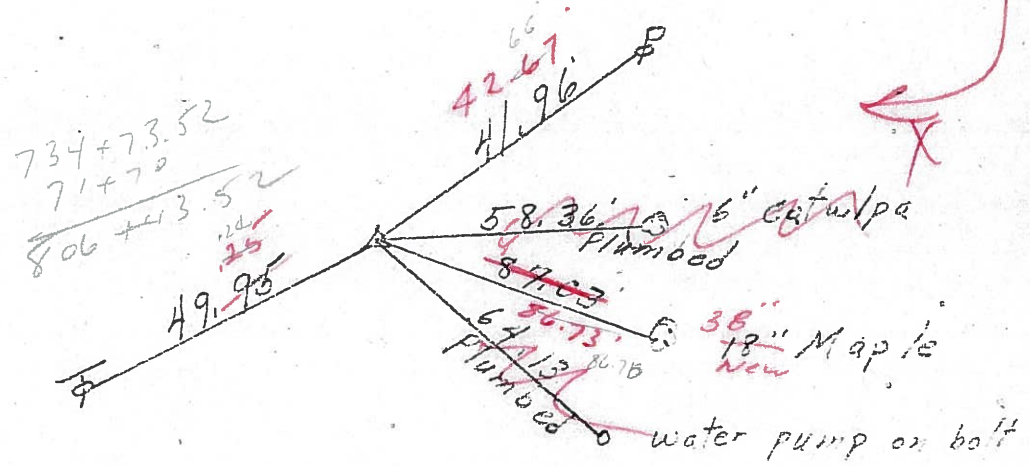

58


T.S. 734+73.52
R.R. Spk.

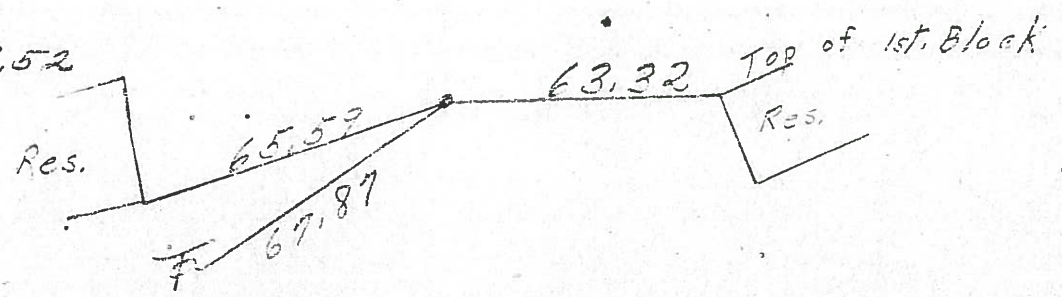

57


PERSONNEL	TITLE	PERSONNEL	TITLE	COUNTY	DATE
Schneider				Ottawa	5-18-71
Mosser				S. R. 53	WEATHER Windy
Barbour				SEC.	TEMP. 80°
Geyman					
DESCRIPTION	S.R. 163 North				JOB NO.
	LEFT	CENTER LINE	RIGHT		

P.I.
741+02.13
R.R. Spk.

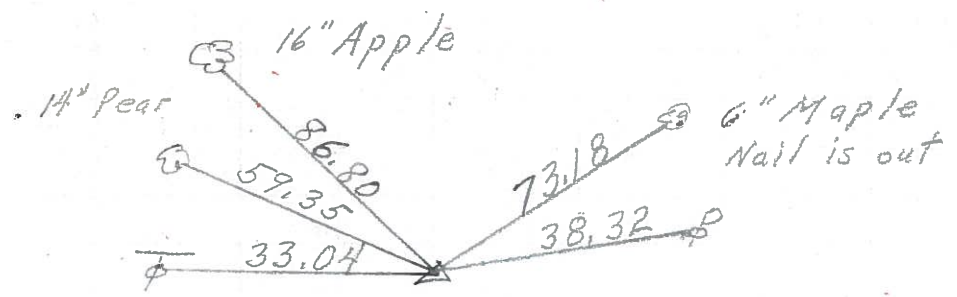


60

S.T. 737+30.15
R.R. Spk.

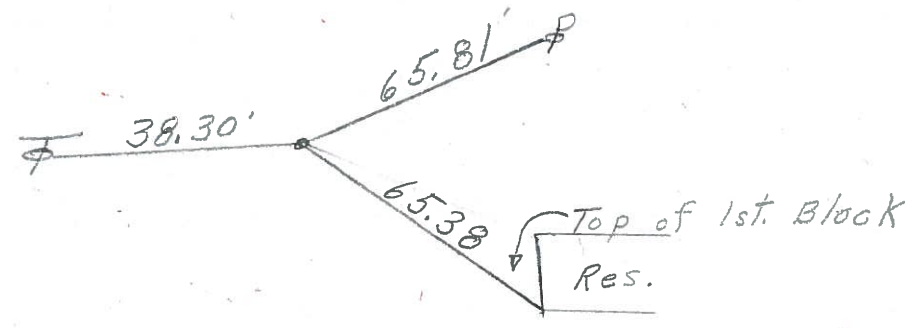


59

P.I.
734+73.52
Iron pin
2" Rt. of Rt. edge
of Pavmt.

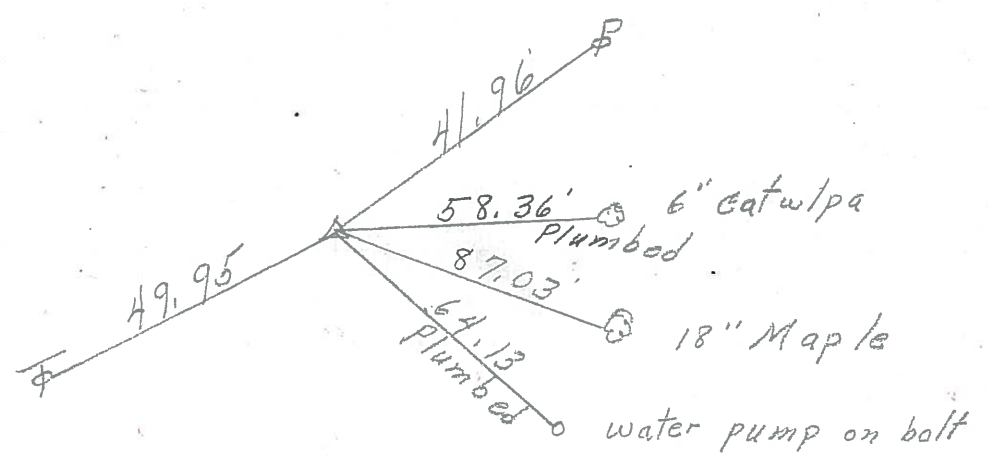

58

T.S. 734+73.52
R.R. Spk.

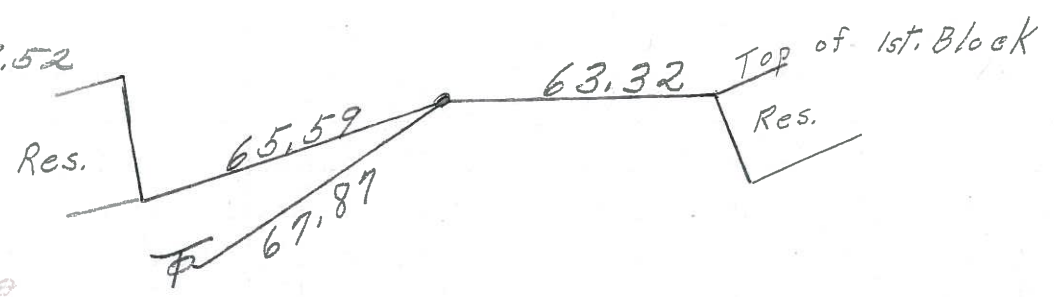

57

PERSONNEL	TITLE	PERSONNEL	TITLE	COUNTY	DATE
Schneider		Potts		O'ahu	8-2-68
Mosser				S. R. 53	WEATHER Fair
Barbour				SEC. S.R. #163 North	TEMP. 80°
Redding					
DESCRIPTION Ties for Control Points				JOB NO.	

