

O.D.O.T. DISTRICT 2 SURVEY OFFICE (USE ONLY)

PERSONNEL _____ REFERENCE NO. 48 SHEET 19 OF 34
 NOTES RHOADES DATE 8/24/22 ROUTE SR 53
 H.C. NIESE WEATHER SUNNY COUNTY OTTAWA
 R.C. AUBLE TEMP. 80° TOWNSHIP CATAWBA
 SECTION 4-28

DWG BY RHOADES PID 102905

TYPE MONUMENT MAG/WASHER

ON SURFACE - ~~BELOW~~ ON

OFFSET CL PAVEMENT ON LT : RT

12.2' TO RT EDGE PAVEMENT

STATION: 916+54.9

HORZ.DATUM: NAD83 2011


GEOID: NAVD88 2018

GRID: NORTHING: 688356.606


EASTING: 1876599.209

CONNECTICUT WESTERN RESERVE

NOTE:
THIS MAP IS FOR ODOT PURPOSES ONLY
TO INDEX REFERENCE TIES, AND DOES NOT
REPRESENT TRUE LAND SUBDIVISION.

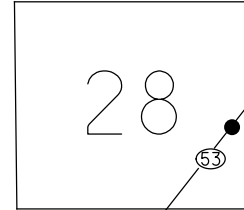

RECORD: P.O.T.
 STA. 743+40.08
 FD P.K./WASHER
 6/12/95
 SET P.K./WASHER
 5/23/96, CL
 FD IPIN
 4" DOWN
 REF61
 8/26/11, DCH
 SET MAG/WASHER
 NEWREF61
 8/6/12, DCH
 FD MAG/WASHER
 REF61
 3/4/21, JFO
 SET MAG/WASHER
 5/16/23, TDN

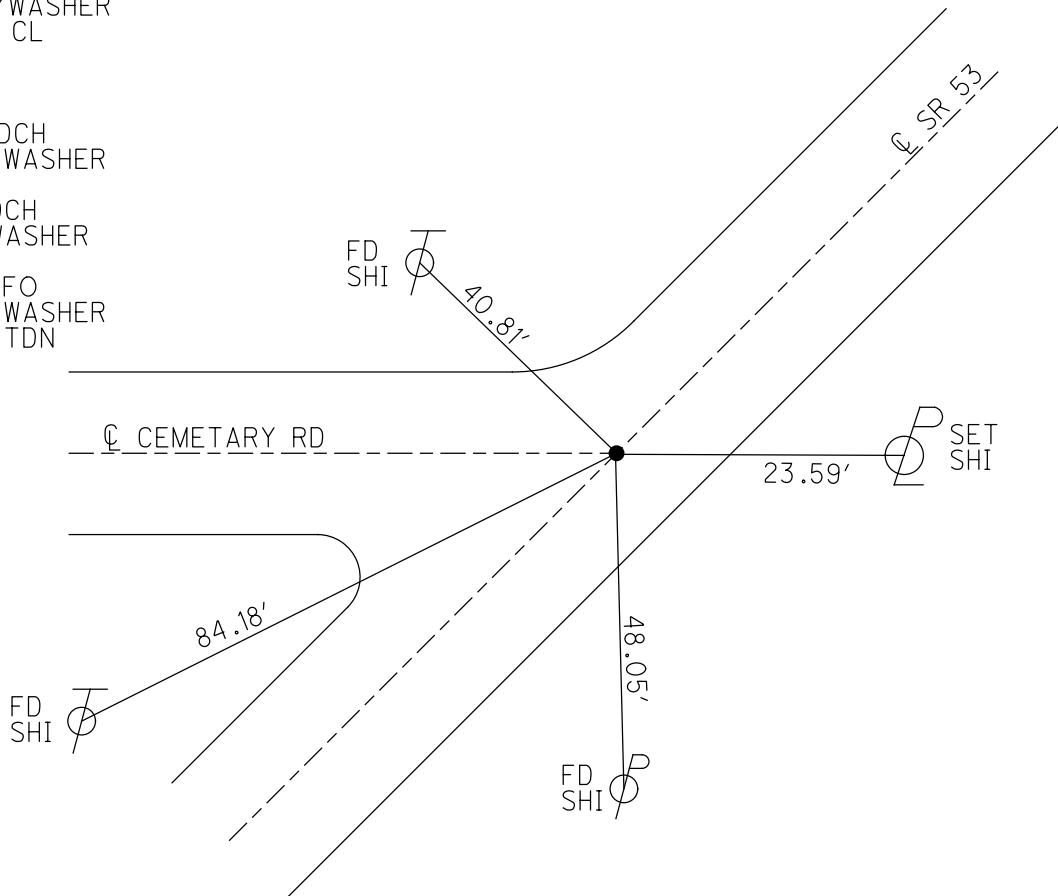

O.D.O.T. DISTRICT 2 SURVEY OFFICE (USE ONLY)

PERSONNEL _____ REFERENCE NO. 61 SHEET 22 OF 36

NOTES HOMAN DATE 8/26/11 ROUTE SR 53

H.C. ROUSOS WEATHER CLOUDY COUNTY OTTAWA

R.C. HARBAUGH TEMP. 75° TOWNSHIP CATAWBA ISL

SECTION 4-28

TYPE MONUMENT IPIN

~~ON SURFACE~~ - BELOW 4"


LEFT - ☉ PAV'T - RIGHT ON

12.2' TO RT EDGE PAVEMENT


S.L.M. 816+76.52

GRID: NORTHING: 688356.564 EASTING: 1876599.062

NOTE:
THIS MAP IS FOR ODOT PURPOSES ONLY
TO INDEX REFERENCE TIES AND DOES NOT
REPRESENT TRUE LAND SUBDIVISION.

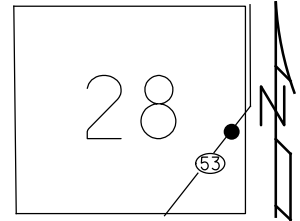

RECORD: P.O.T.
STA. 743+40.08
FD P.K./WASHER
6/12/95
SET P.K./WASHER
5/23/96, CL
FD IPIN, 4" DOWN
GPS, REF61
SET MAG/WASHER
NEWREF61
8/6/12, DCH

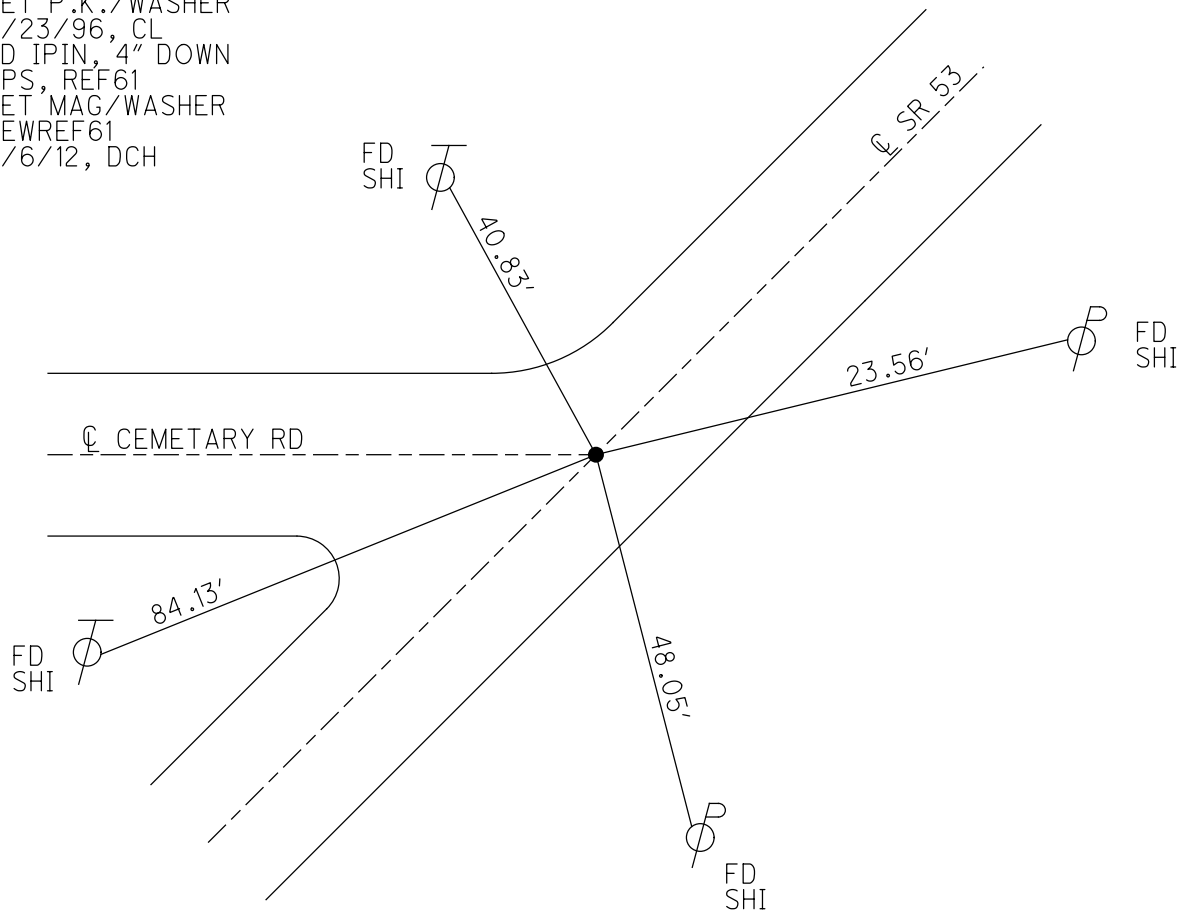

O.D.O.T. DISTRICT 2 SURVEY OFFICE

PERSONNEL _____

REFERENCE NO. 61

SHEET 17 OF 30

NOTES LOEHRKE

H.C. ROUSOS

DATE 6-12-95

ROUTE SR 53

R.C. CANTERBURY

WEATHER FAIR

COUNTY OTTAWA

TEMP. +72

TOWNSHIP CATAWBA

SECTION _____

T. _____ R. _____

TYPE MONUMENT P.K. / WASHER Reset


5-23-96

ON SURFACE - ~~BELOW~~ Yes


LEFT - & PAV'T. - RIGHT Yes

12.2 TO Rt EDGE PAVEMENT

S.L.M. 816 + 74

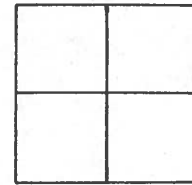

Record P.O.T. R/W
743 + 40.08

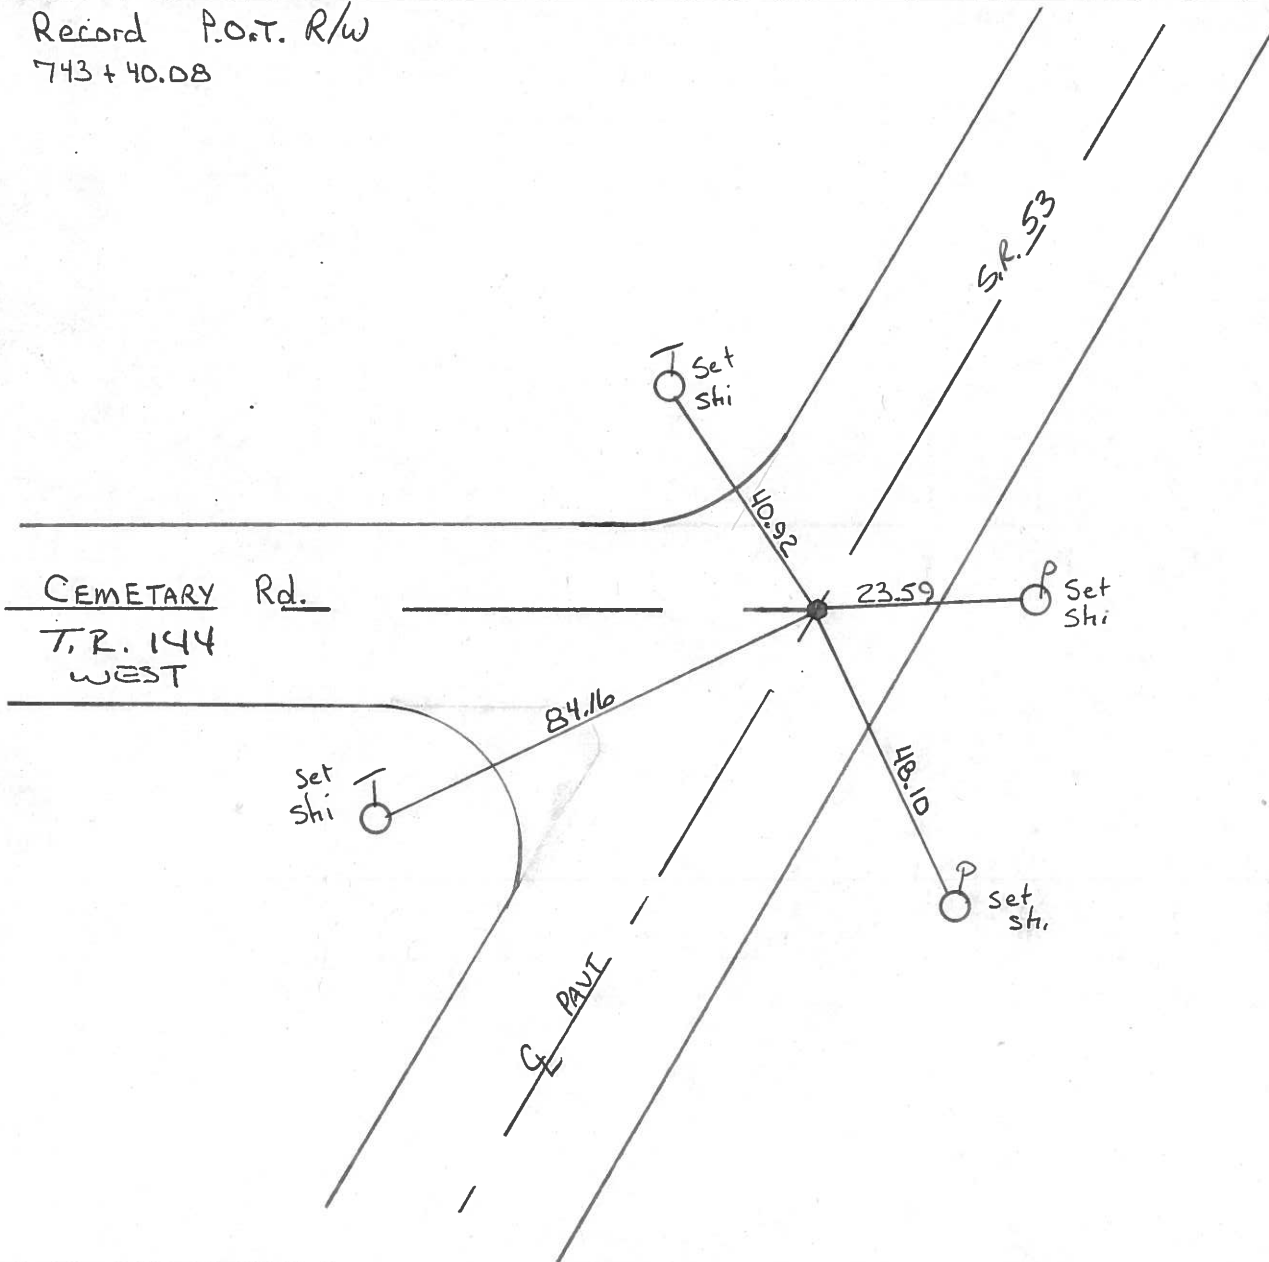

ODOT. DISTRICT 2 SURVEY OFFICE

SHEET _____ OF _____

County Ottawa S.R. # 53

Date 8/28/84

Township Catawba


Weather sunny

Section _____

Temp. 80°

T N, R E

Personnel Cronin

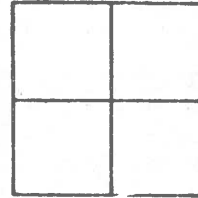


Ripple

Geyman

Barbour


PT 61

P.O.T. R/W
743+40.08
set P.K. & washer at top
R.R. spike

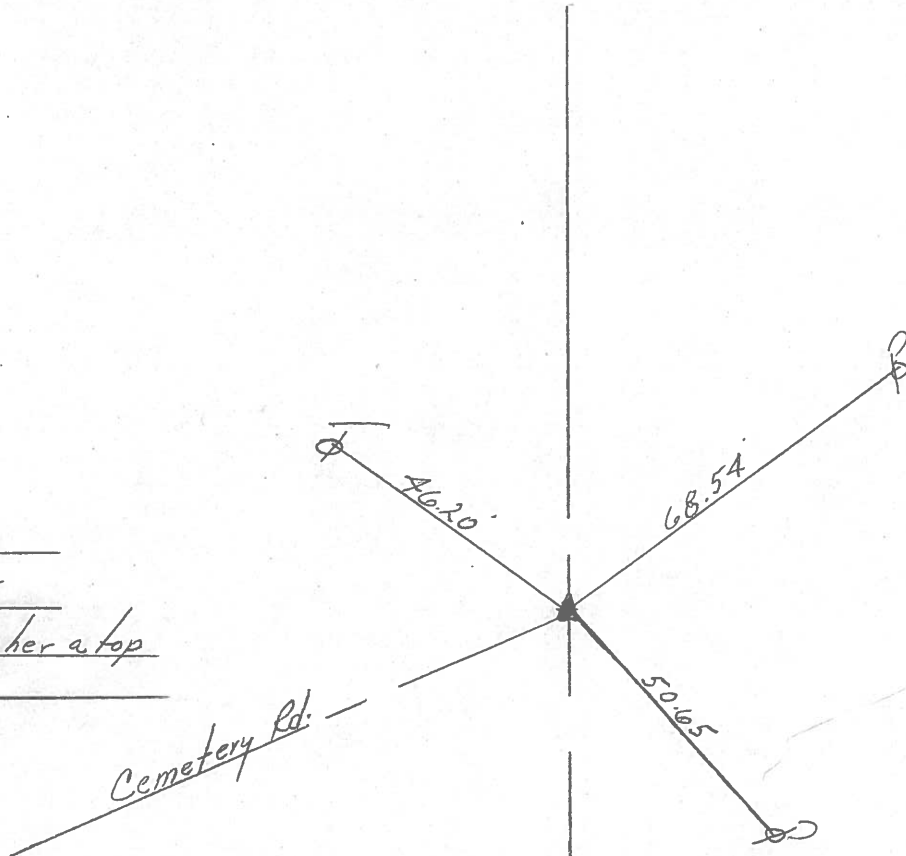


R/W S.R. #537

PERSONNEL	TITLE	PERSONNEL	TITLE	COUNTY	DATE
Schneider				Ottawa	5-18-71
Mosser				S. R. 53	WEATHER Fair
Barbour				SEC.	TEMP 75°
Geyman					
DESCRIPTION	S.R. 163 North				JOB NO.

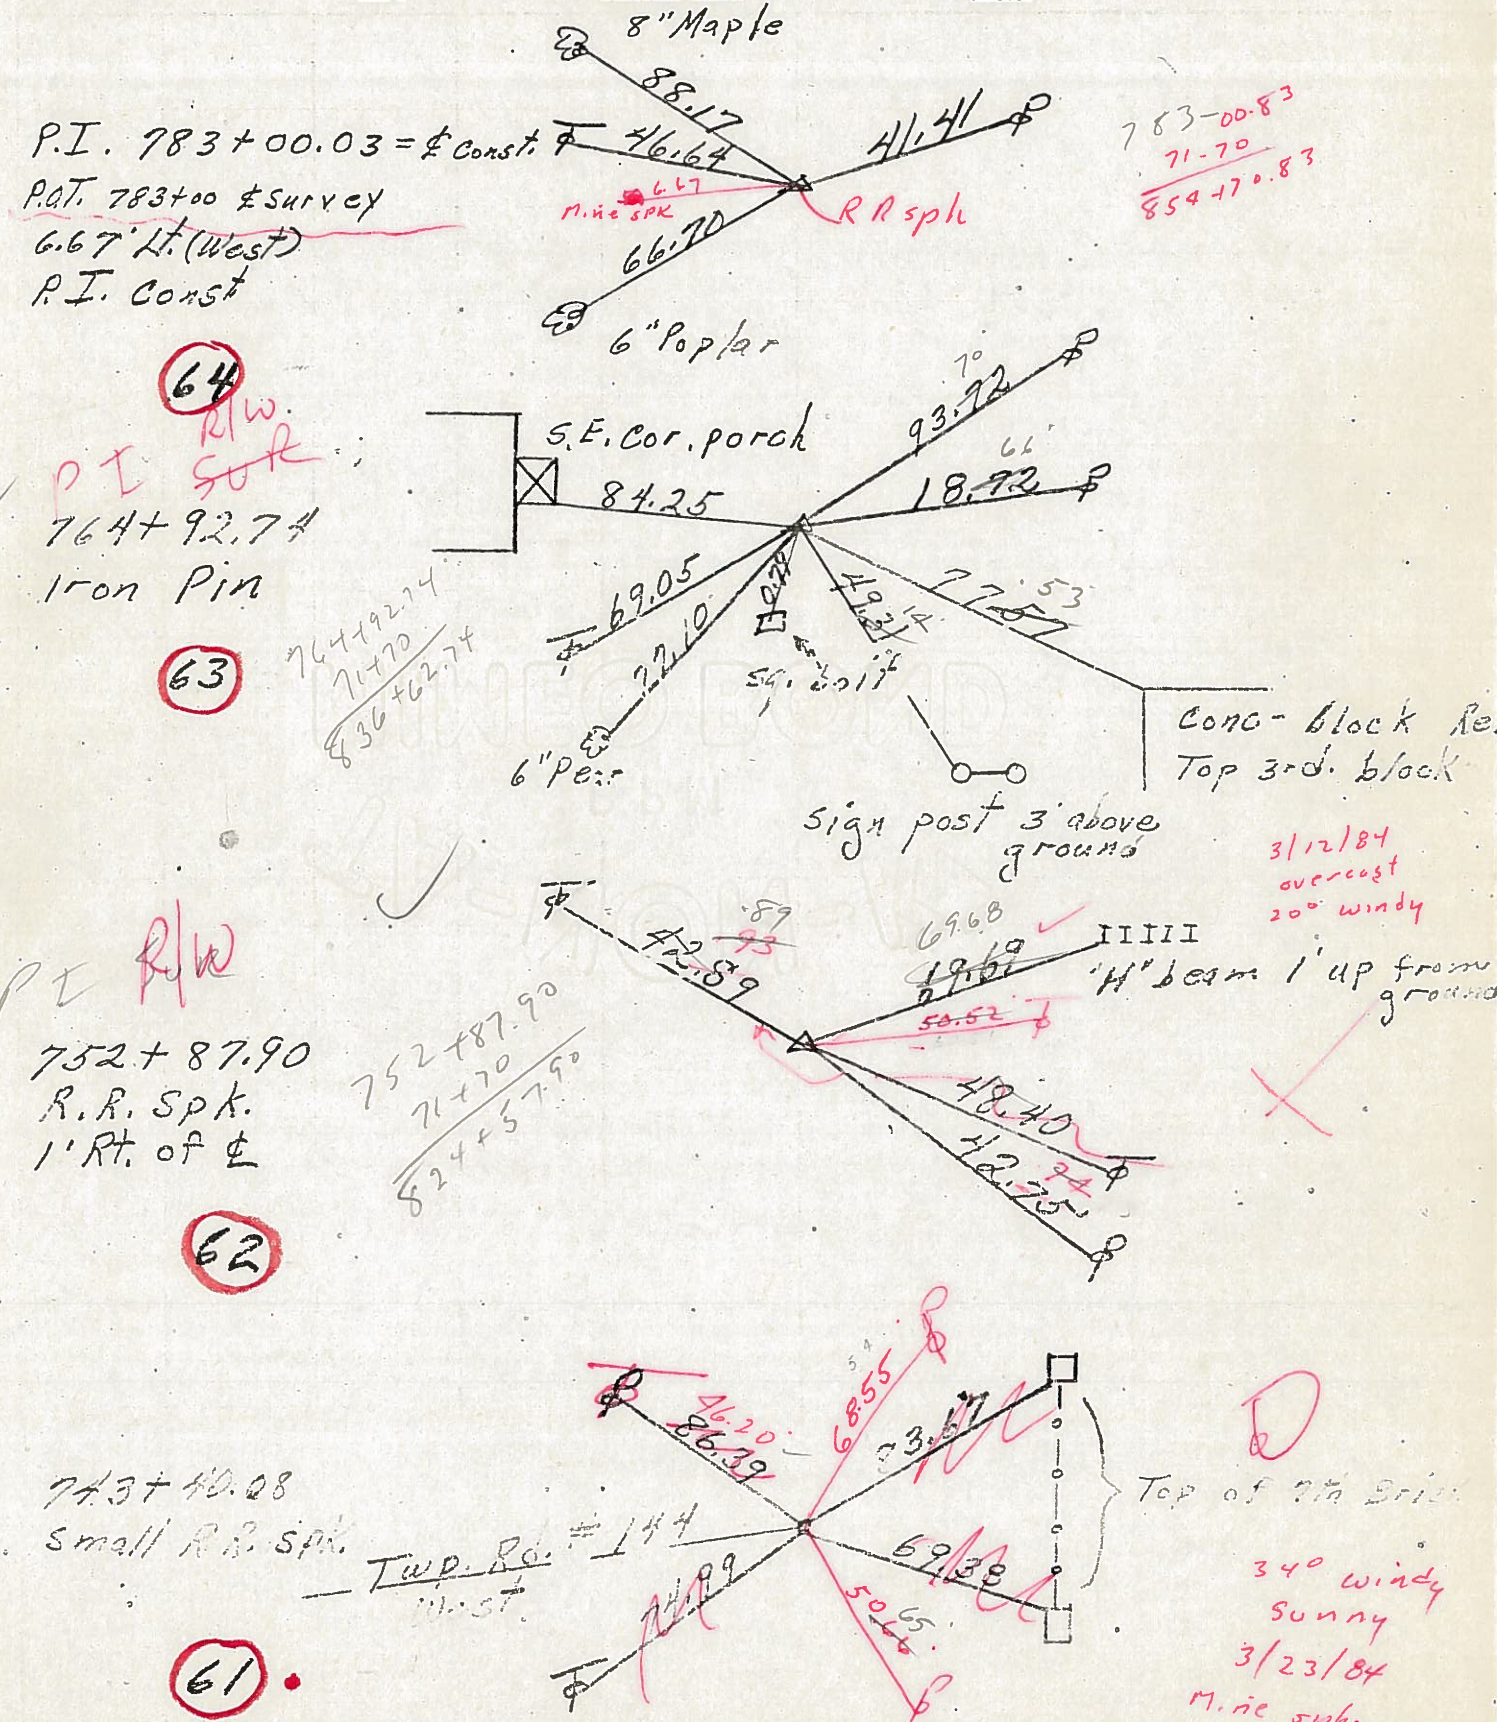

PERSONNEL	TITLE	PERSONNEL	TITLE	COUNTY	DATE
Schneider				Ottawa	5-18-71
Mosser				S. R. 53	WEATHER Fair
Barbour				SEC.	TEMP. 75°
Geyman					

DESCRIPTION S.R. 163 North JOB NO. _____

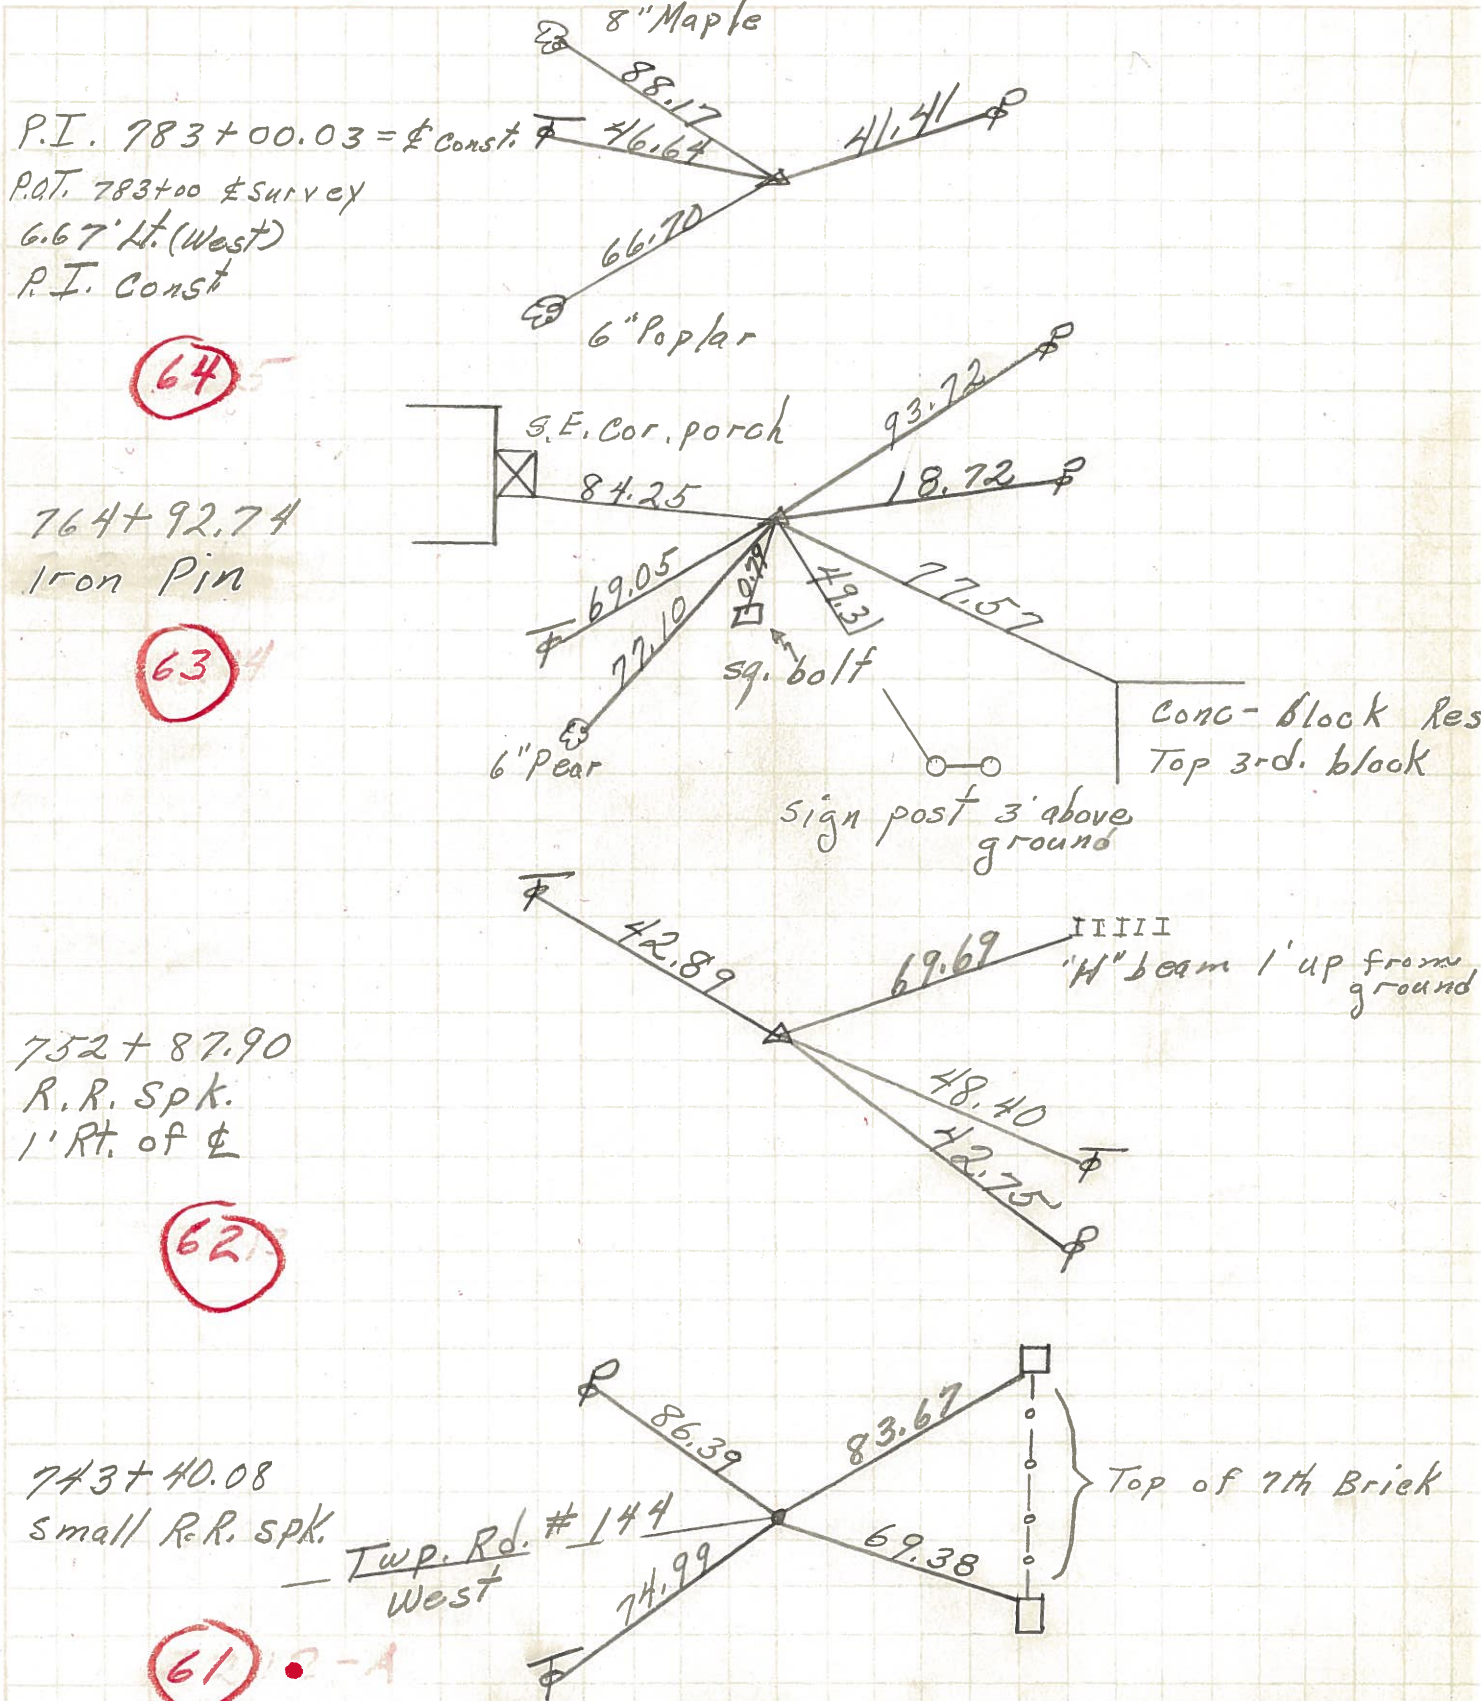

PERSONNEL	TITLE	PERSONNEL	TITLE
SWORDEN			
HOLCOMBE			
SAGE			
AULT			

COUNTY OTTAWA

DATE APRIL 21, 1953

S. R. # 53

WEATHER Cloudy

SEC.

TEMP. +75°

DESCRIPTION π -Plus & Angles @ CEMETERY ROAD NORTH

JOB NO.

LEFT

CENTER LINE

RIGHT

P.I. = 764+92.74

$\Delta = 30^{\circ}-44' LT.$

P.T. 755+35.40

754+41.29

P.I. = 752+87.90


$\Delta = 1^{\circ}-39' LT.$

750+72.42

746+71.62

743+39.89

P.I. = 741+02.13

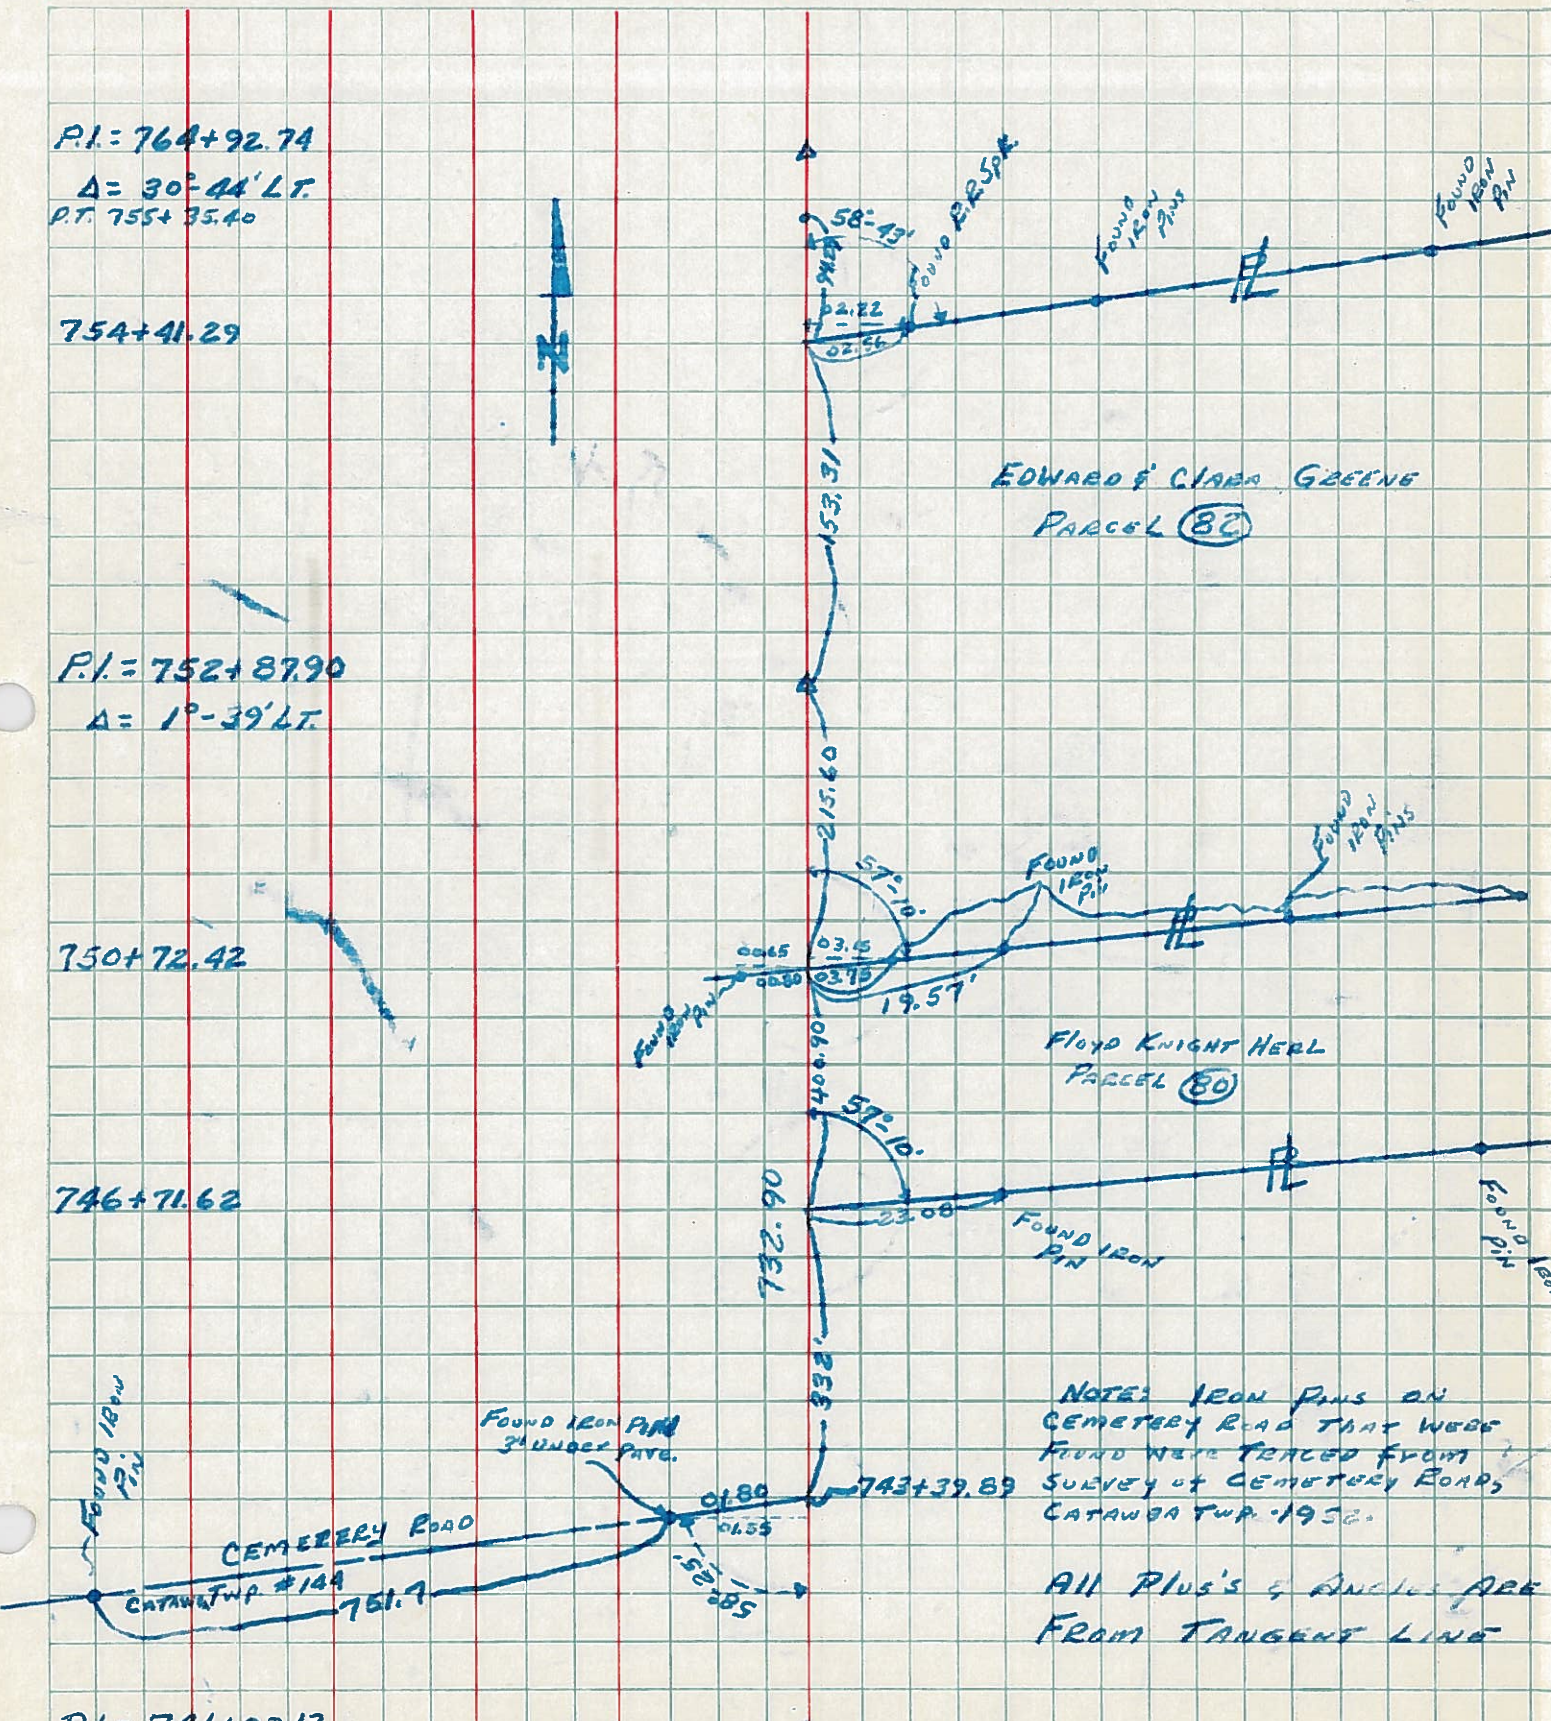

NOTE: IRON PINS ON CEMETERY ROAD THAT WERE FOUND WERE TRACED FROM SURVEY OF CEMETERY ROAD, CATAWGA TWP. 1950.

ALL PLUS'S & ANGLES ARE FROM TANGENT LINE

