

O.D.O.T. DISTRICT 2 SURVEY OFFICE (USE ONLY)

PERSONNEL \_\_\_\_\_ REFERENCE NO. 62 SHEET 20 OF 34  
 NOTES RHOADES DATE 8/24/22 ROUTE SR 53  
 H.C. NIESE WEATHER SUNNY COUNTY OTTAWA  
 R.C. AUBLE TEMP. 80° TOWNSHIP CATAWBA  
 SECTION 4-28

DWG BY RHOADES PID 102905

CONNECTICUT WESTERN RESERVE

TYPE MONUMENT MAG/WASHER

NOTE:  
THIS MAP IS FOR ODOT PURPOSES ONLY.  
TO INDEX REFERENCE TIES, AND DOES NOT  
REPRESENT TRUE LAND SUBDIVISION.

ON SURFACE - ~~BELOW~~ ON

OFFSET CL PAVEMENT 2.6' ~~LT~~ : RT

9.9' TO RT EDGE PAVEMENT


STATION: 826+02.5

HORIZ.DATUM: NAD83 2011


GEOID: NAVD88 2018

GRID: NORTHING: 689169.245

EASTING: 1877086.636

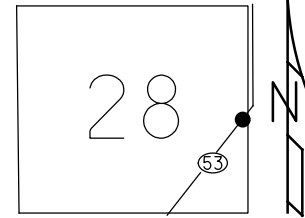

RECORD: P.I.  
 STA. 752+87.9  
 FD P.K./WASHER  
 6/12/95  
 SET P.K./WASHER  
 5/23/96, CL  
 FD P.K.NAIL  
 REF62  
 8/26/11, DCH  
 SET MAG/WASHER  
 NEWREF62  
 8/6/12, DCH  
 FD MAG/WASHER  
 REF62  
 3/4/21, JFO  
 SET MAG/WASHER  
 5/16/23, TDN

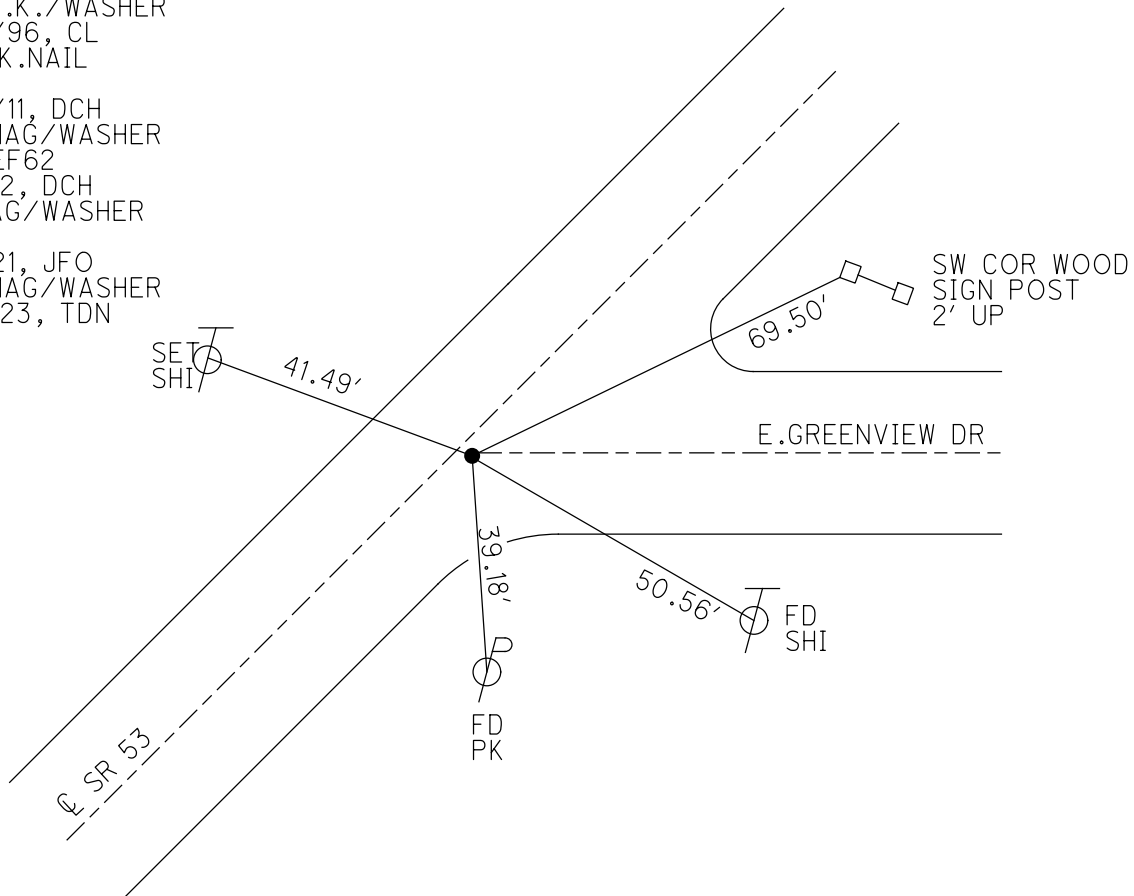


O.D.O.T. DISTRICT 2 SURVEY OFFICE (USE ONLY)


PERSONNEL	REFERENCE NO.	<u>62</u>	SHEET	<u>23</u>	OF	<u>36</u>
NOTES	HOMAN	DATE	<u>8/26/11</u>	ROUTE	<u>SR 53</u>	
H.C.	ROUSOS	WEATHER	<u>CLOUDY</u>	COUNTY	<u>OTTAWA</u>	
R.C.	HARBAUGH	TEMP.	<u>75°</u>	TOWNSHIP	<u>CATAWBA ISL</u>	
				SECTION	<u>4-28</u>	

TYPE MONUMENT P.K.NAIL  
 ON SURFACE - ~~BELOW~~ ON  
~~LEFT~~ - CL PAV'T - RIGHT 2.6'  
9.9' TO RT EDGE PAVEMENT  
 S.L.M. 826+24.34  
 GRID: NORTHING: 689169.437 EASTING: 1877086.520

NOTE:  
THIS MAP IS FOR ODOT PURPOSES ONLY  
TO INDEX REFERENCE TIES, AND DOES NOT  
REPRESENT TRUE LAND SUBDIVISION.

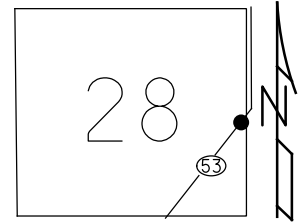

RECORD: P.I.  
 STA. 752+87.9  
 FD P.K./WASHER  
 6/12/95  
 SET P.K./WASHER  
 5/23/96, CL  
 FD P.K.NAIL  
 GPS, REF62  
 SET MAG/WASHER  
 NEWREF62  
 8/6/12, DCH

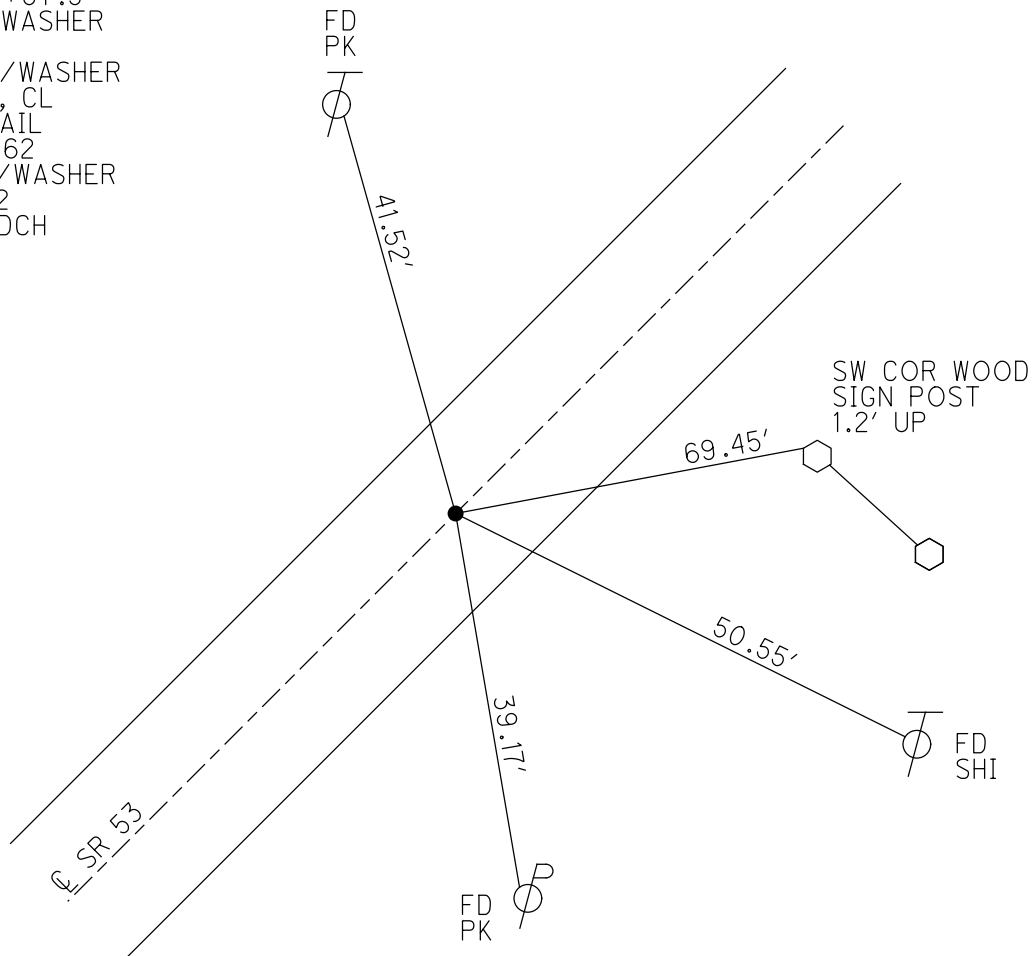

# O.D.O.T. DISTRICT 2 SURVEY OFFICE

PERSONNEL \_\_\_\_\_

REFERENCE NO. 62

SHEET 18 OF 30

NOTES LOHRKE

H.C. Rausos

R.C. CANTERBURY

DATE 6-12-95

WEATHER FAIR

TEMP. +72

ROUTE S.R. 53

COUNTY OTTAWA

TOWNSHIP CATAWBA

SECTION \_\_\_\_\_

T \_\_\_\_\_ R \_\_\_\_\_

Reset


TYPE MONUMENT P.K. / WASHER 5-23-96

ON SURFACE - BELOW Yes C.L.


~~LEFT~~ - Q PAV'T. - RIGHT 2.6' Rt

9.9 TO Rt EDGE PAVEMENT

S.L.M. 826 + 26

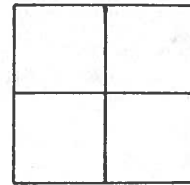

RECORD P.I. R/W  
Sta 752+87.90

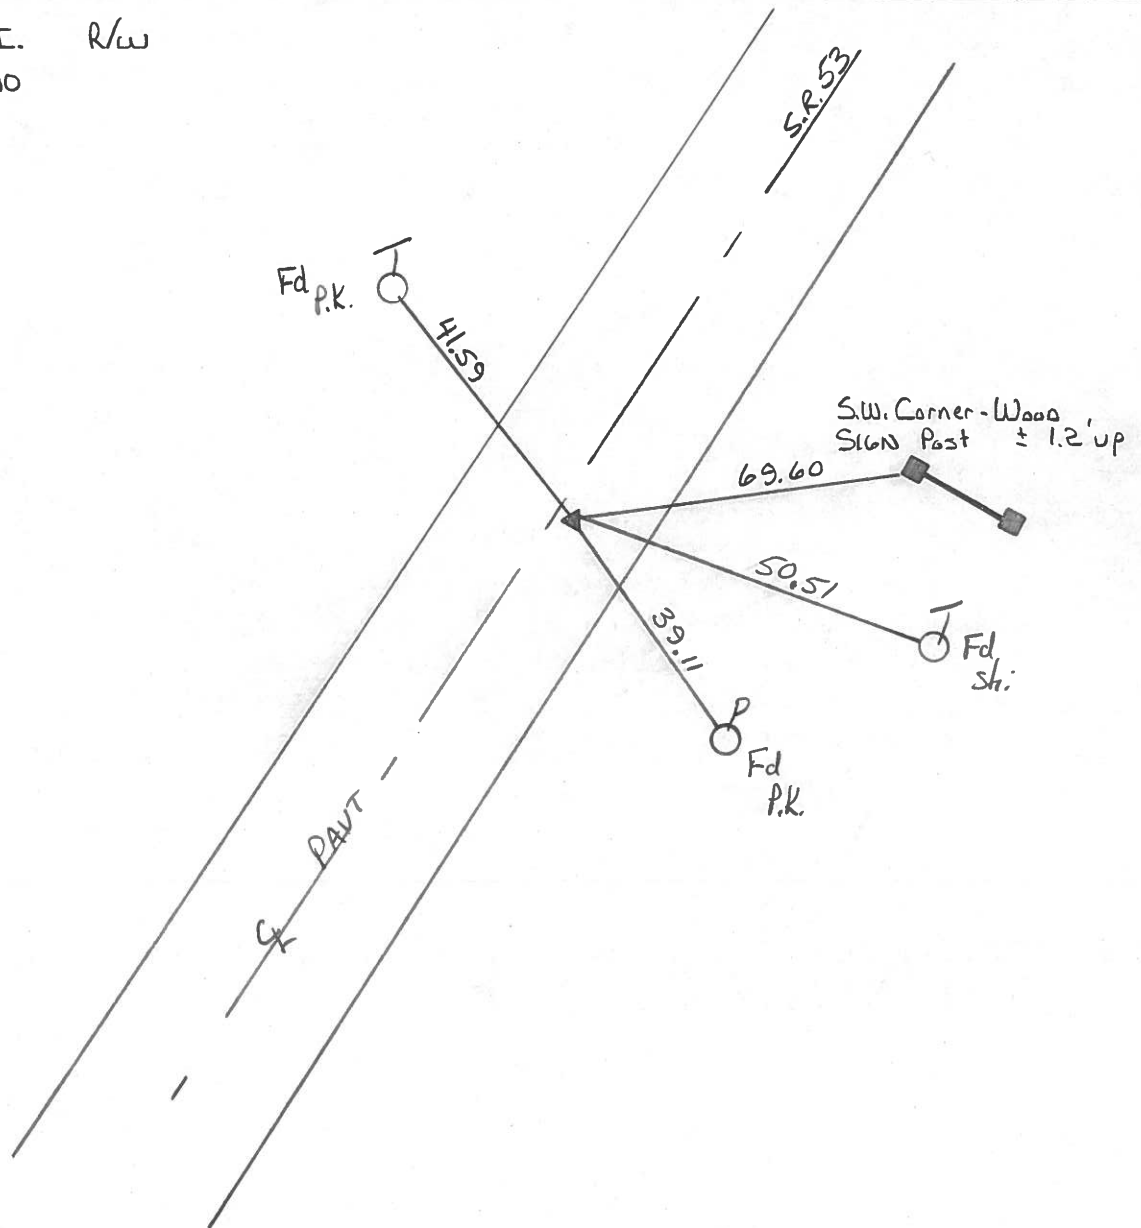

ODOT. DISTRICT 2 SURVEY OFFICE

SHEET \_\_\_\_\_ OF \_\_\_\_\_

County Ottawa S.R. # 53

Date 8/28/84

Township Catawba


Weather sunny

Section \_\_\_\_\_

Temp. 80°

T N, R E

Personnel Cronin

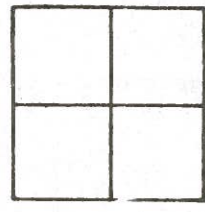

Ripple



Geyman

Barbour


PT 62

P.I. R/w  
752+87.90

set P.K. & washer atop  
R.R. spike - 2.0 ft. & Point

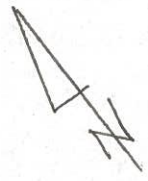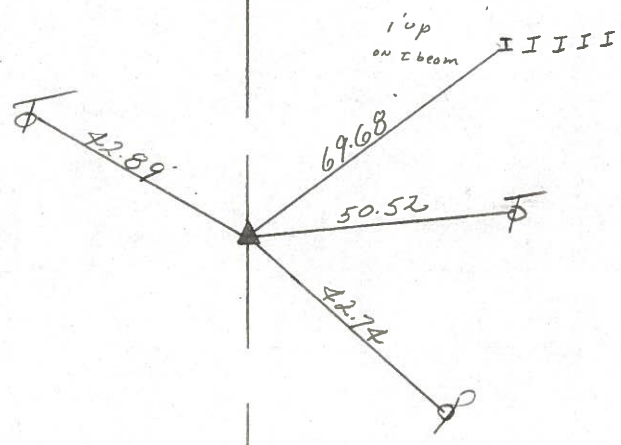

PERSONNEL	TITLE	PERSONNEL	TITLE	COUNTY	DATE
Schneider				Ottawa	5-18-71
Mosser				S. R. 53	WEATHER Fair
Barbour				SEC.	TEMP. 75°
Geyman					
DESCRIPTION	S.R. 163 North				JOB NO.

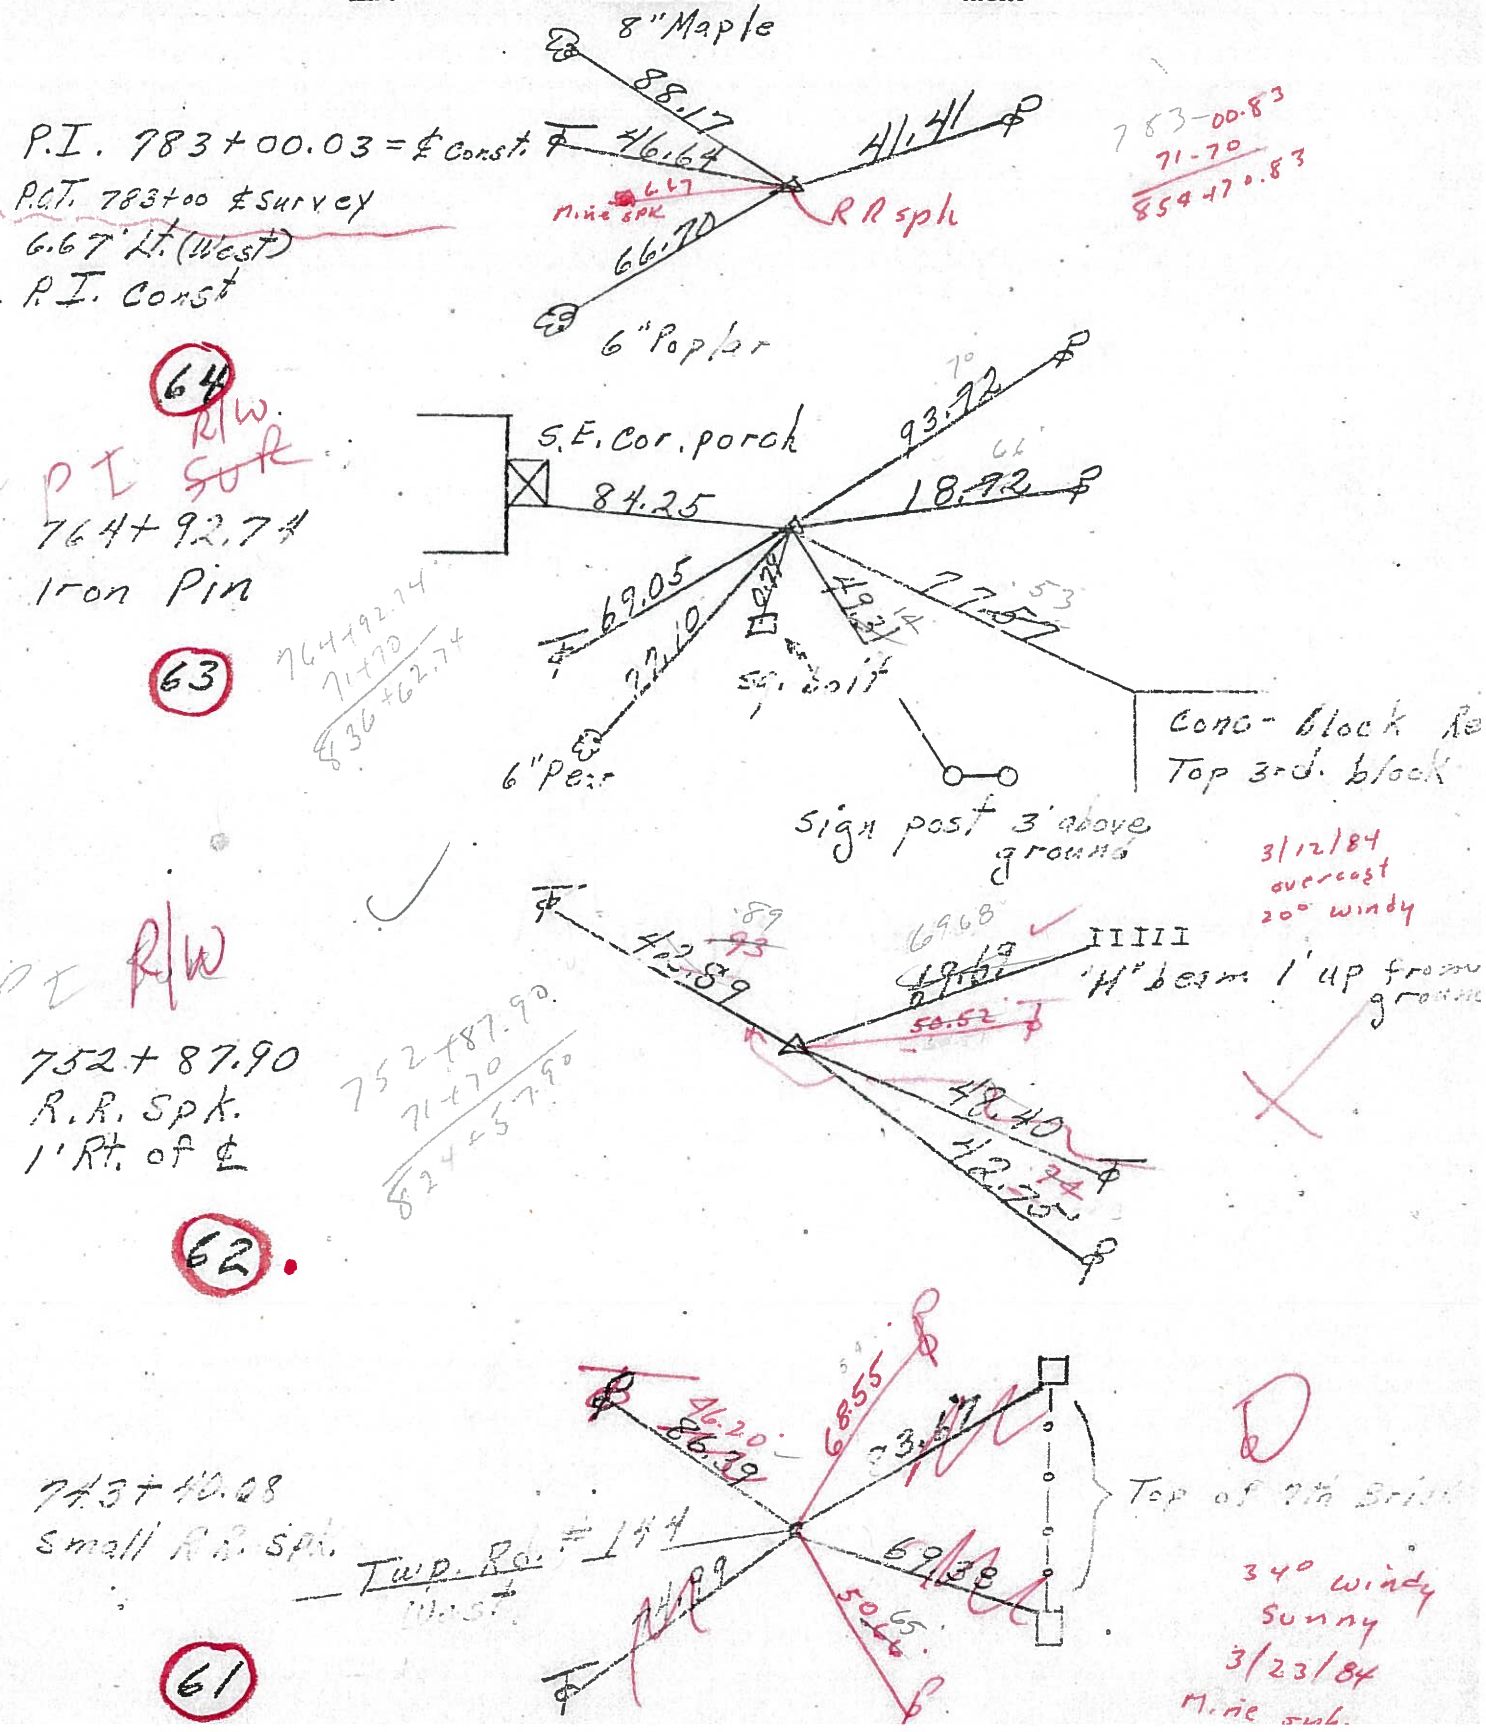

P.I. 783+00.03 = Const. F  
 P.C.T. 783+00 Survey  
 6.67 Lt. (West)  
 P.I. Const

783-00.83  
 71-70  
 854-70.83

64  
 R/W.  
 P.I. S.P.K.  
 764+92.74  
 Iron Pin

764+92.74  
 71+70  
 836+62.74

63

P.I. R/W  
 752+87.90  
 R.R. Spk.  
 1' Rt. of C

752+87.90  
 71+70  
 824+57.90

62

743+40.08  
 Small R.R. Spk.

Twp. Rd. = 144  
 West

61

Top of 7th Brick  
 340 Windy  
 Sunny  
 3/23/84  
 Mine sub.

PERSONNEL TITLE PERSONNEL TITLE

Schneider  
Mosser  
Barbour  
Geyman


COUNTY Ottawa  
S. R. 53  
SEC. \_\_\_\_\_

DATE 5-18-71  
WEATHER Fair  
TEMP. 75°

DESCRIPTION S.R. 163 North

JOB NO. \_\_\_\_\_


LEFT CENTER LINE RIGHT

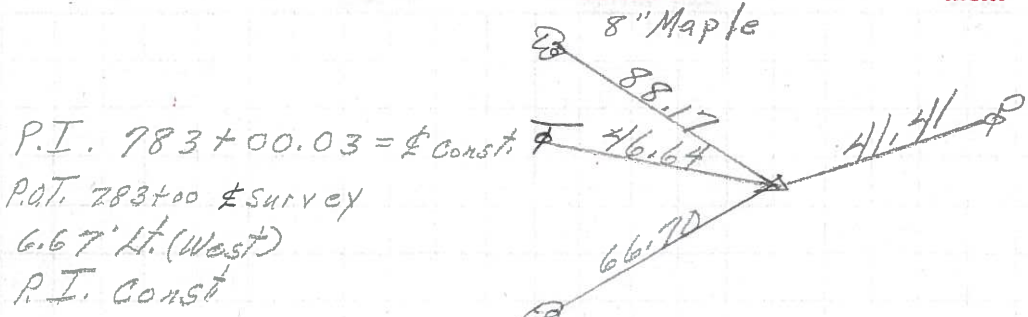

64


764+92.74  
Iron Pin

63

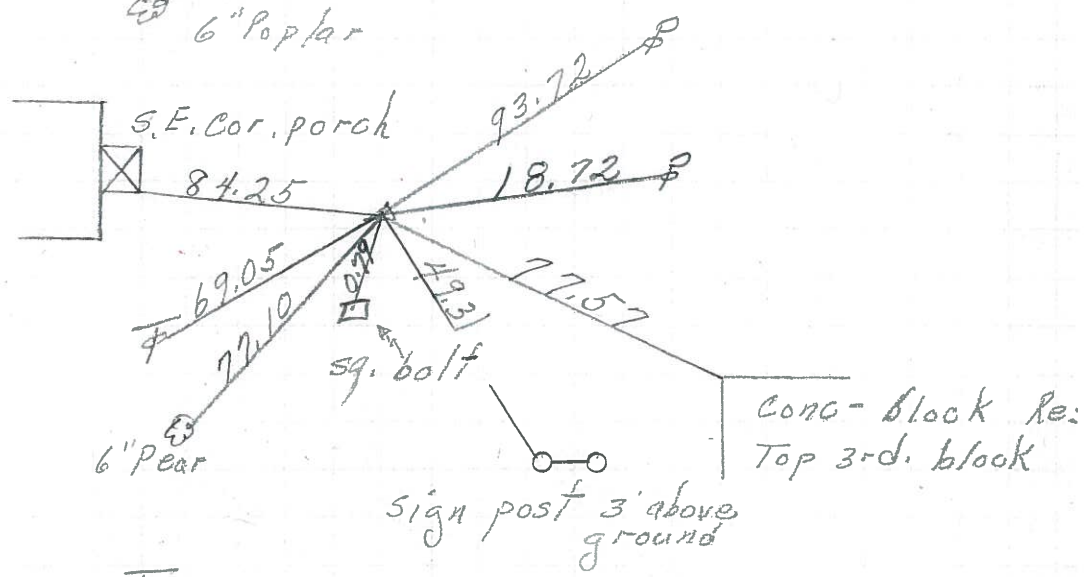

752+87.90  
R.R. Spk.  
1' Rt. of  $\pm$


62

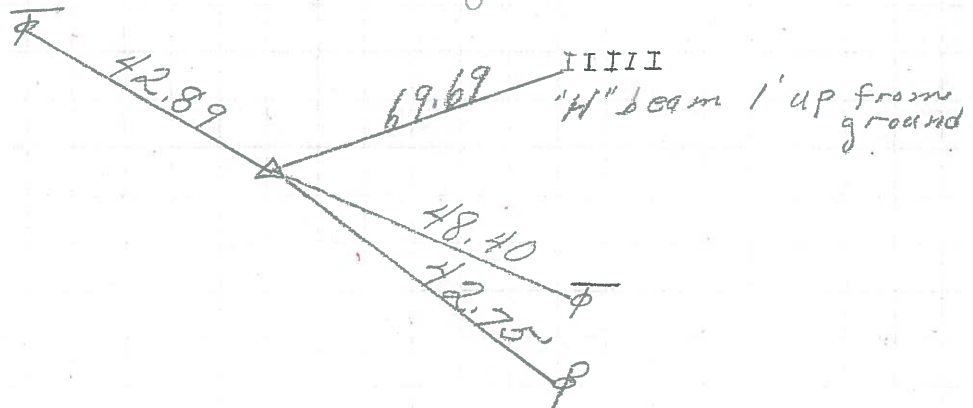


743+40.08  
Small R.R. Spk.

Twp. Rd. # 144  
West

61

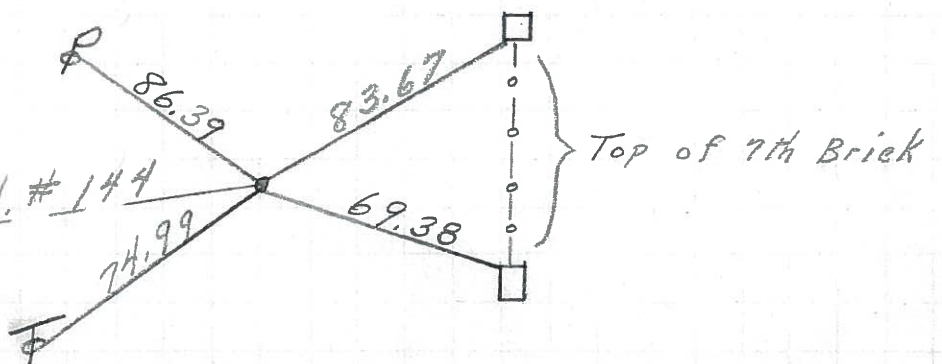

PERSONNEL	TITLE	PERSONNEL	TITLE	COUNTY	DATE
Schneider		Potts		O hawa	8-2-68
Mosser				S. R.	53
Barbour				WEATHER	Fair
Redding				SEC.	S.R. #163 North
DESCRIPTION	Ties for Control Points			TEMP.	80°
	LEFT	CENTER LINE	RIGHT	JOB NO.	

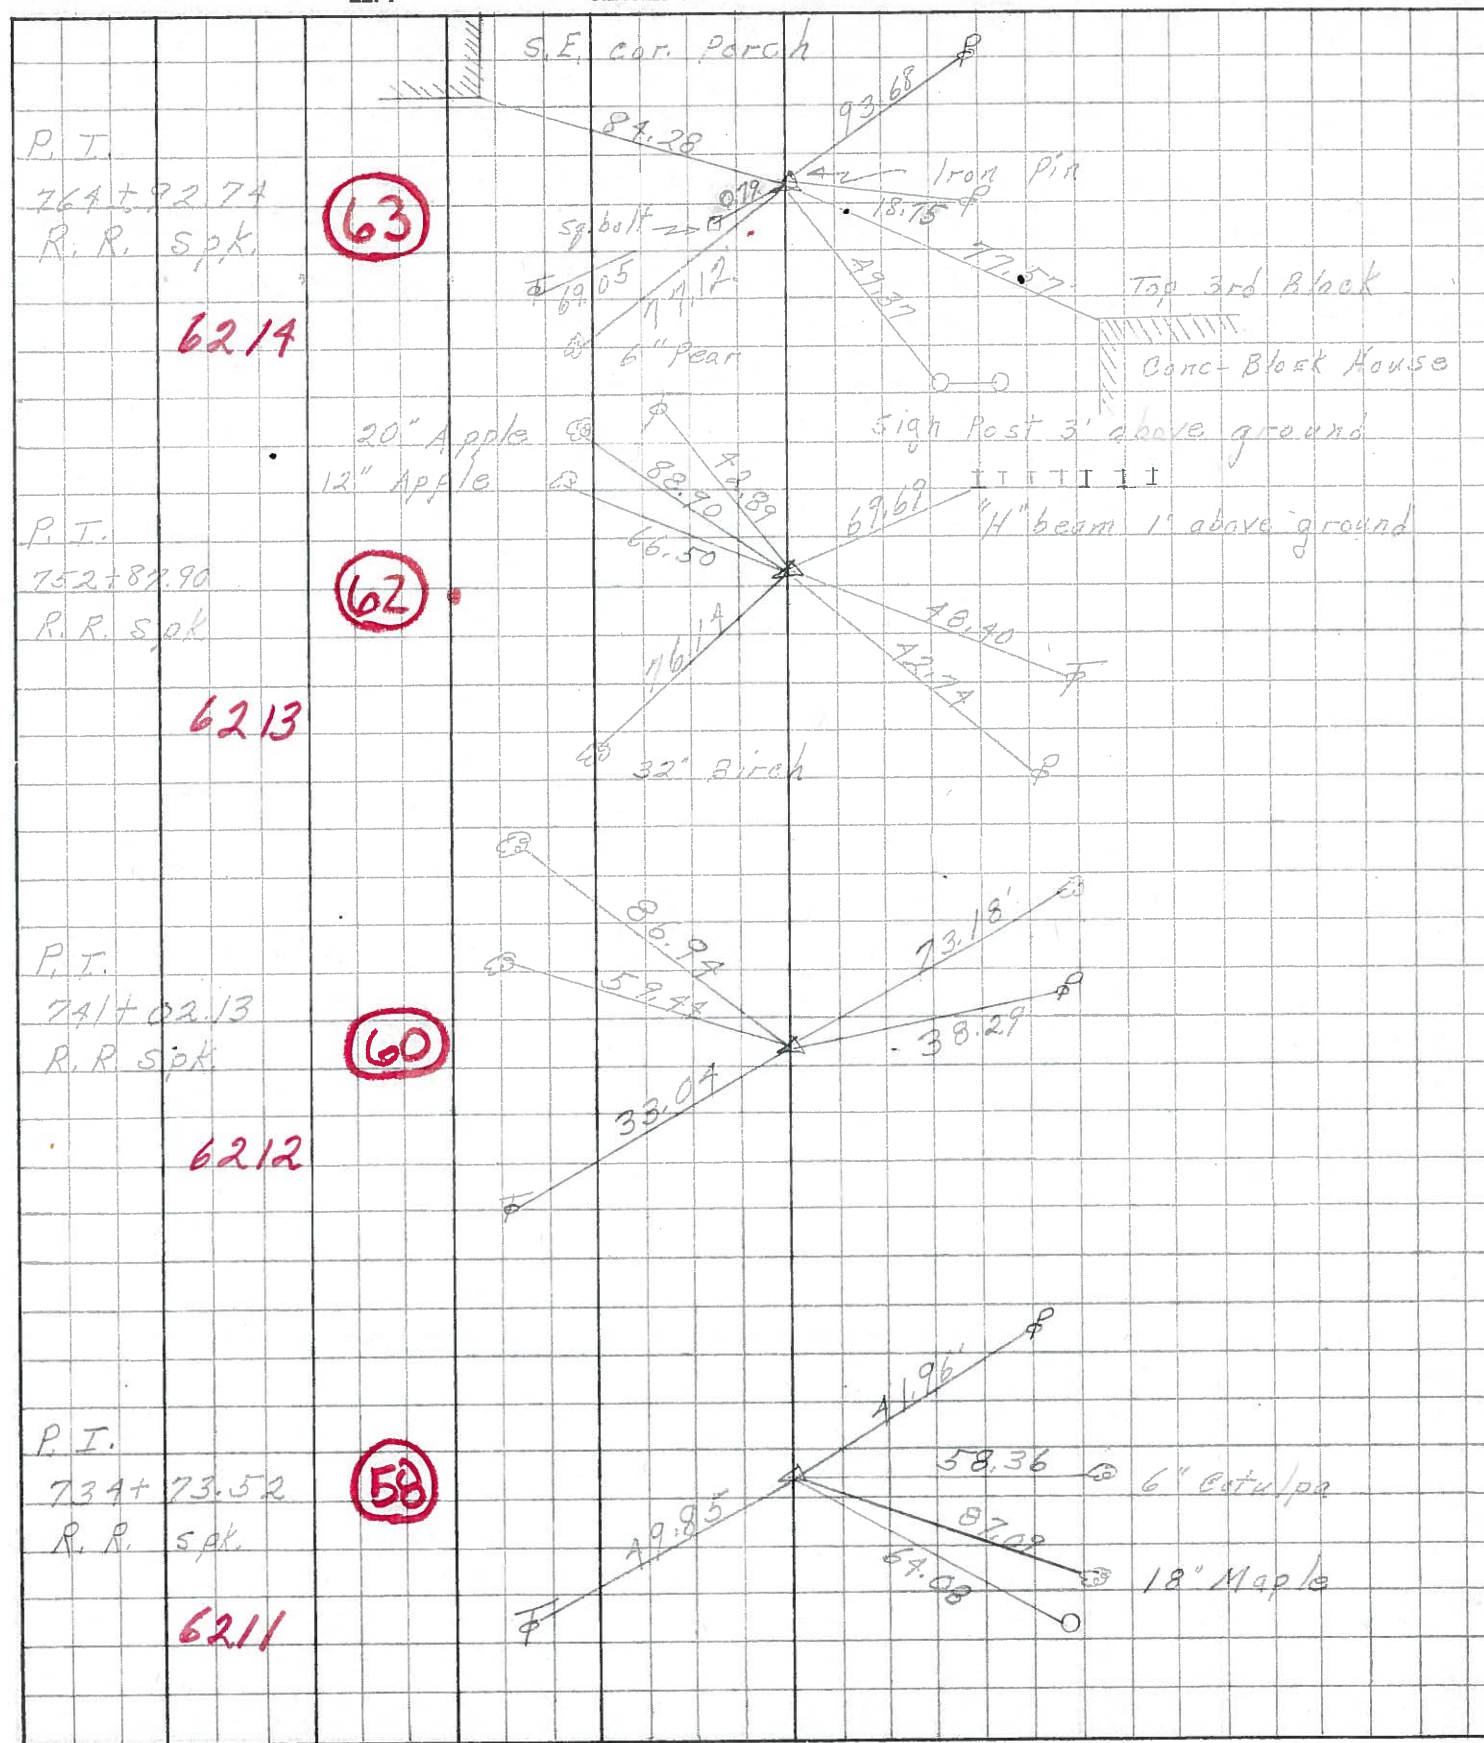

PERSONNEL	TITLE	PERSONNEL	TITLE
SWORDEN			
HOLCOMBE			
SAGE			
AULT			

COUNTY OTTAWA

DATE MAR. 4, 1958

S. R. # 53

WEATHER Cloudy & SNOW

SEC. \_\_\_\_\_

TEMP. +34°


DESCRIPTION TR PINS

JOB NO. \_\_\_\_\_

LEFT

CENTER LINE

RIGHT

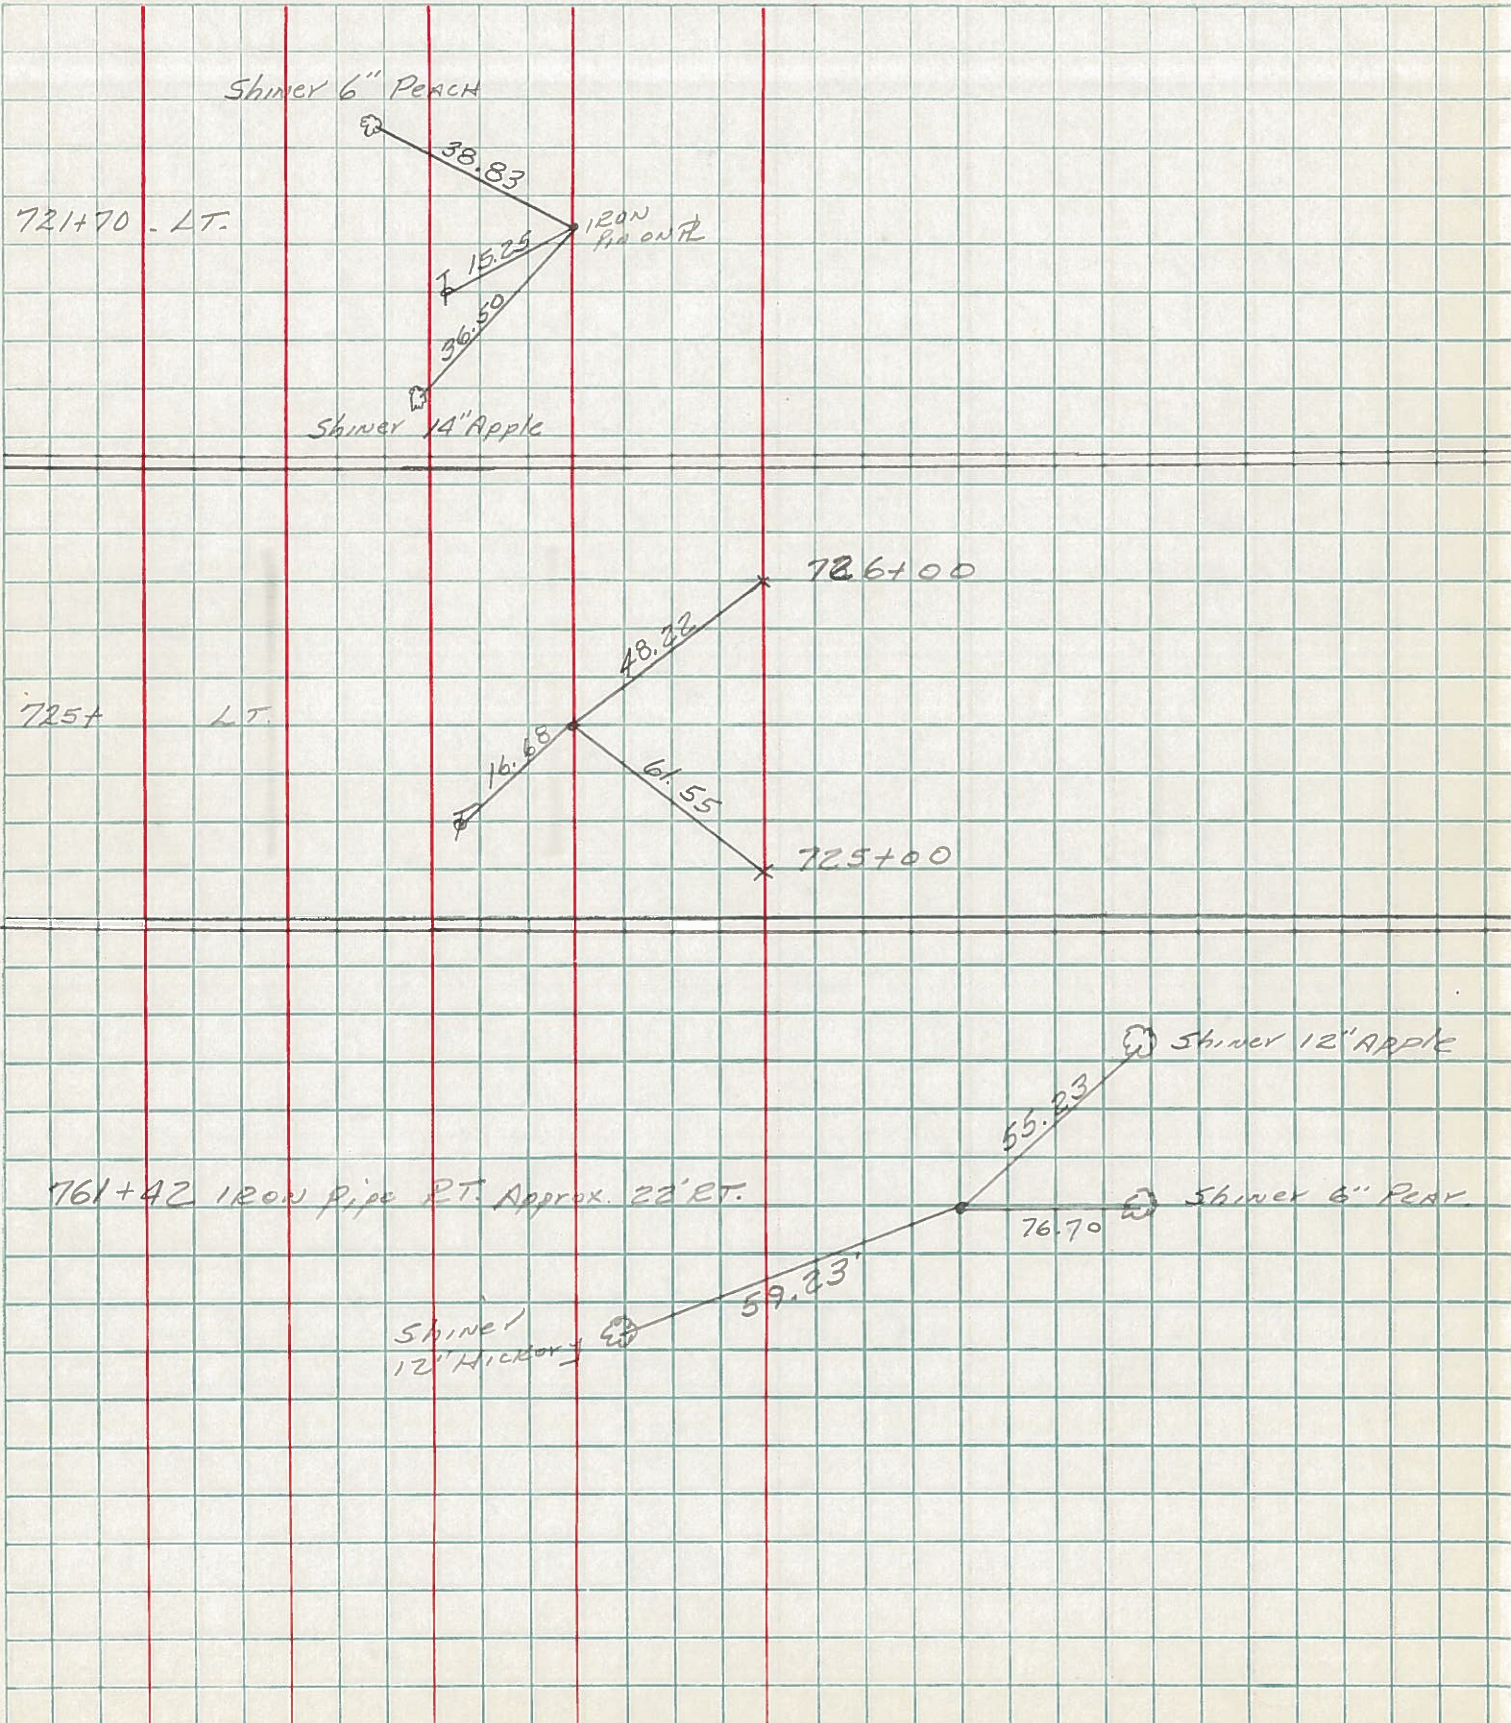



PERSONNEL	TITLE	PERSONNEL	TITLE
SWORDEN			
HOLCOMBE			
SMEE			
AULT			

COUNTY OTTAWA DATE 1-23-58  
 S. R. #53 WEATHER CLOUDY  
 SEC. \_\_\_\_\_ TEMP. +30°

DESCRIPTION RT Ties Part #2

JOB NO. \_\_\_\_\_

