

O.D.O.T. DISTRICT 2 SURVEY OFFICE (USE ONLY)

PERSONNEL

REFERENCE NO. 66

SHEET 24 OF 34

NOTES RHOADES

DATE 8/24/22

ROUTE SR 53

H.C. NIESE

WEATHER SUNNY

COUNTY OTTAWA

R.C. AUBLE

TEMP. 80°

TOWNSHIP CATAWBA

SECTION 4-28

DWG BY RHOADES

PID 102905

CONNECTICUT WESTERN RESERVE

TYPE MONUMENT MAG/WASHER

ON SURFACE - ~~BELOW~~ ON

OFFSET  $\varnothing$  PAVEMENT ON LT : RT

- TO - EDGE PAVEMENT

STATION: 879+22.27



HORZ.DATUM: NAD83 2011

GEOID: NAVD88 2018

GRID: NORTHING: 694350.447

EASTING: 1877579.628

NOTE:  
THIS MAP IS FOR ODOT PURPOSES ONLY  
TO INDEX REFERENCE TIES, AND DOES NOT  
REPRESENT TRUE LAND SUBDIVISION.

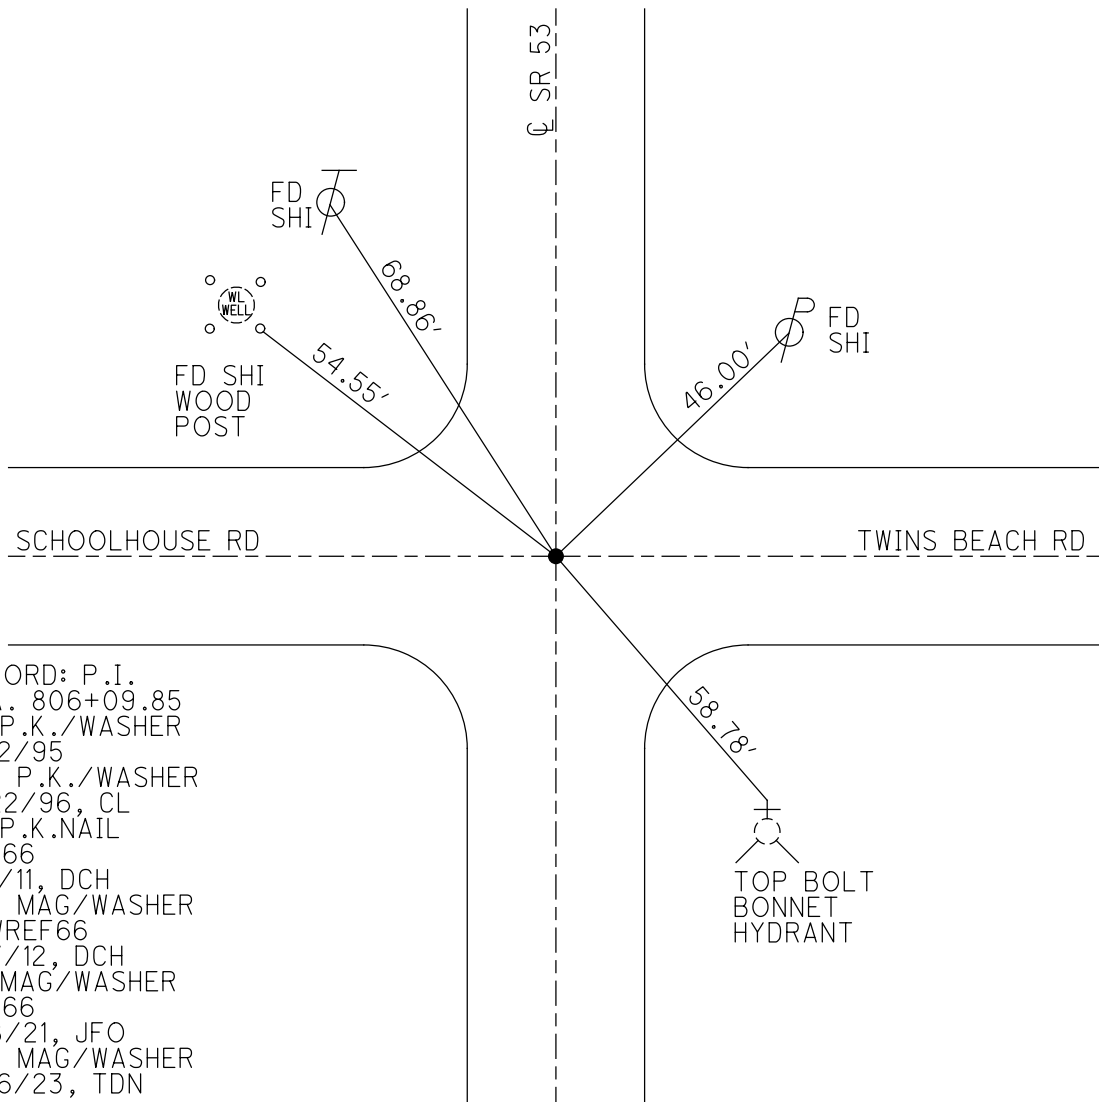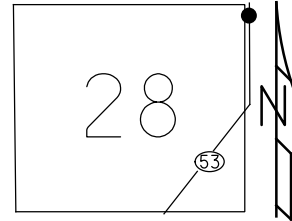



RECORD: P.I.  
 STA. 806+09.85  
 FD P.K./WASHER  
 6/12/95  
 SET P.K./WASHER  
 5/22/96, CL  
 FD P.K.NAIL  
 REF66  
 9/1/11, DCH  
 SET MAG/WASHER  
 NEWREF66  
 8/7/12, DCH  
 FD MAG/WASHER  
 REF66  
 3/8/21, JFO  
 SET MAG/WASHER  
 5/16/23, TDN

O.D.O.T. DISTRICT 2 SURVEY OFFICE (USE ONLY)

PERSONNEL \_\_\_\_\_ REFERENCE NO. 66 SHEET 27 OF 36  
 NOTES HOMAN DATE 9/1/11 ROUTE SR 53  
 H.C. ROUSOS WEATHER SUNNY COUNTY OTTAWA  
 R.C. HARBAUGH TEMP. 75° TOWNSHIP CATAWBA ISL  
 \_\_\_\_\_ SECTION 4-28  
 \_\_\_\_\_

TYPE MONUMENT P.K.NAIL  
 ON SURFACE - ~~BELOW~~ ON  
 LEFT - CL PAV'T - RIGHT ON, 2' S. CL WEST  
- TO - EDGE PAVEMENT  
 S.L.M. 879+46.59  
 GRID: NORTHING: 694350.434 EASTING: 1877579.541

NOTE:  
THIS MAP IS FOR ODOT PURPOSES ONLY.  
TO INDEX REFERENCE TIES, AND DOES NOT  
REPRESENT TRUE LAND SUBDIVISION.

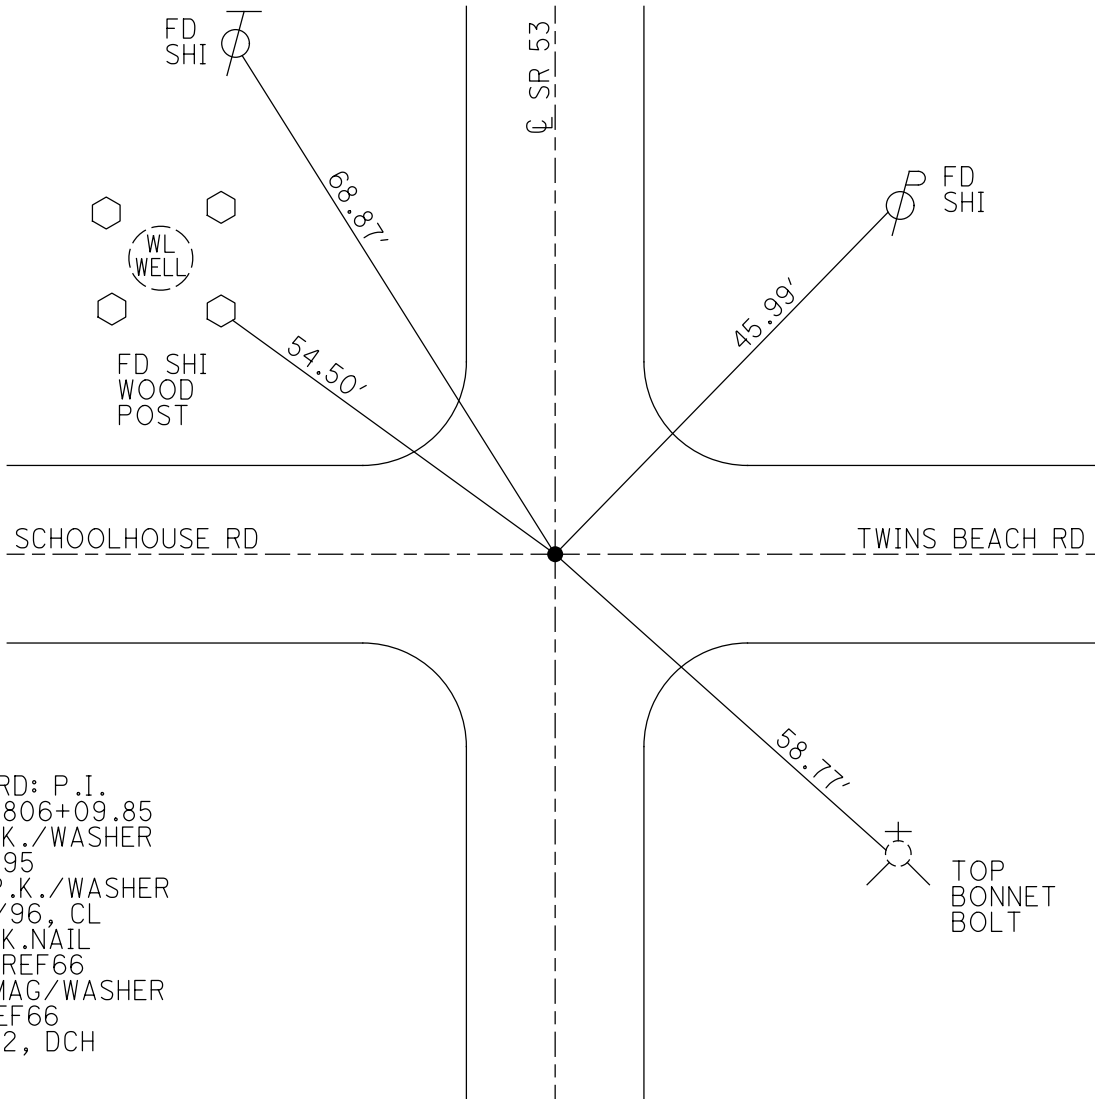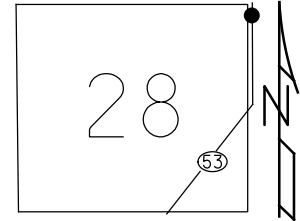

RECORD: P.I.  
 STA. 806+09.85  
 FD P.K./WASHER  
 6/12/95  
 SET P.K./WASHER  
 5/22/96, CL  
 FD P.K.NAIL  
 GPS, REF66  
 SET MAG/WASHER  
 NEWREF66  
 8/7/12, DCH

# O.D.O.T. DISTRICT 2 SURVEY OFFICE

PERSONNEL \_\_\_\_\_

REFERENCE NO. 66

SHEET 22 OF 30

NOTES LOEHRKE

H.C. ROUSOS

DATE 6-12-95

ROUTE S.R. 53

R.C. CANTERBURY

WEATHER FAIR

COUNTY OTTAWA

TEMP. +75

TOWNSHIP CATAWBA

SECTION \_\_\_\_\_

T \_\_\_\_\_ R \_\_\_\_\_


TYPE MONUMENT P.K. / WASHER <sup>Reset</sup> 5-22-96

ON SURFACE - BELOW Yes

~~LEFT - C~~ PAV'T. - RIGHT Yes - ON C PAVT East ALSO


TO EDGE PAVEMENT

S.L.M. 879 + 63

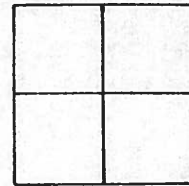

RECORD P.I. - R/W

Sta 806 + 09.85

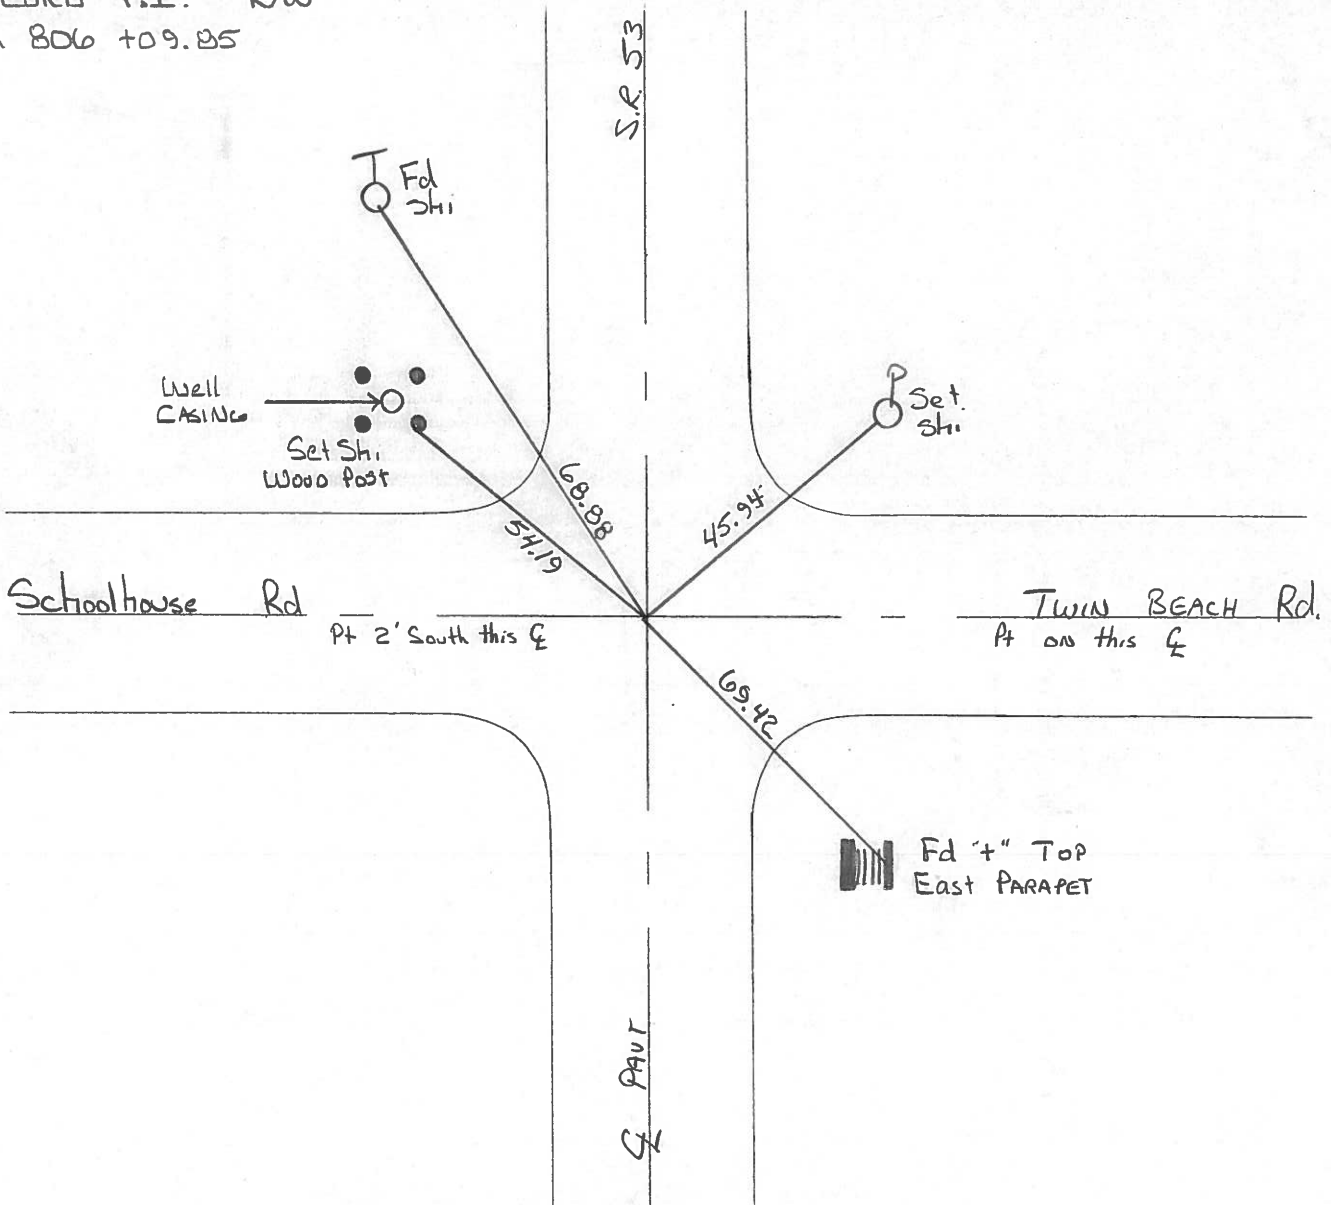

Q.D.O.T. DISTRICT 2 SURVEY OFFICE

SHEET \_\_\_\_\_ OF \_\_\_\_\_

County Ottawa S.R. #53

Date 8/29/84

Township Catawba


Weather overcast - windy

Section \_\_\_\_\_

Temp. 66°

T N, R E

Personnel Cronin

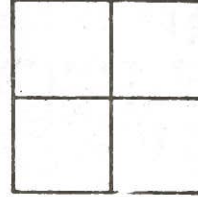


Ripple

Geyman

PT 66

Barbour

P.I. G.W.  
8064 0985  
Set P.K. washer atop  
R.R. spike

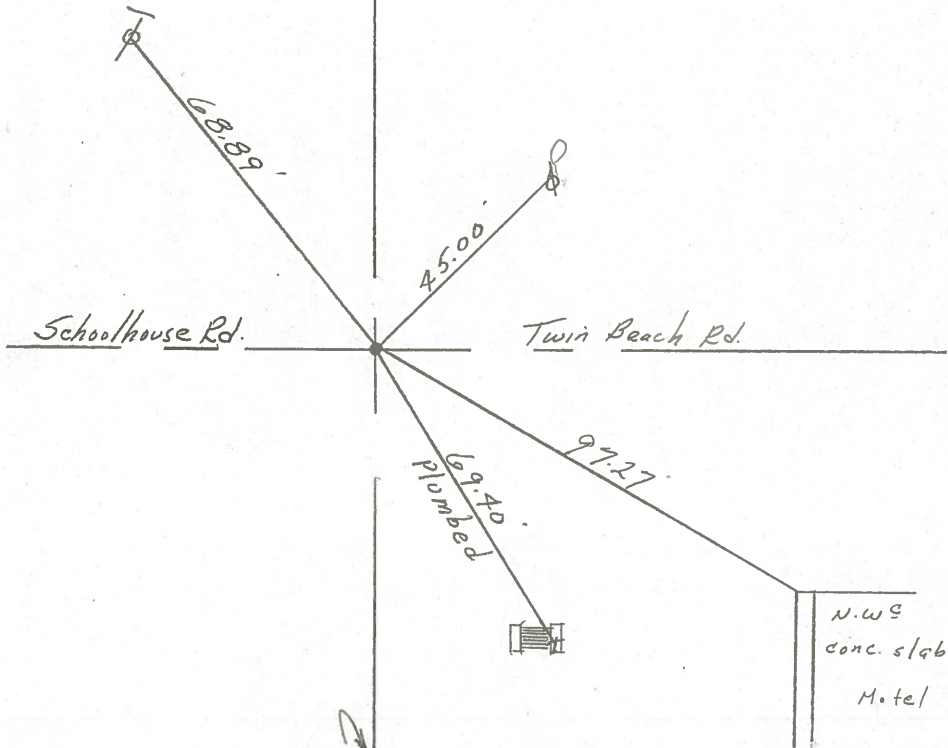

EXPW S.R. #53

PERSONNEL	TITLE	PERSONNEL	TITLE	COUNTY	DATE
				Ottawa	6-4-71
				S. R. 53	WEATHER Hot
				SEC. S.R. 163 North	TEMP. 80°


DESCRIPTION	LEFT	CENTER LINE	RIGHT	JOB NO.
-------------	------	-------------	-------	---------

PT R/W SUR  
831+21.35  
R.R. spk

67


831+21.35  
71+20.  
902+91.33

3/12/84  
overcast,  
20° windy

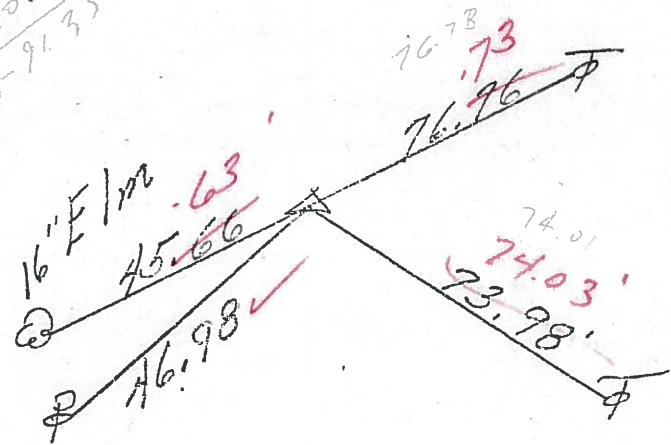


PT R/W SUR  
806+09.85  
R.R. spk

66

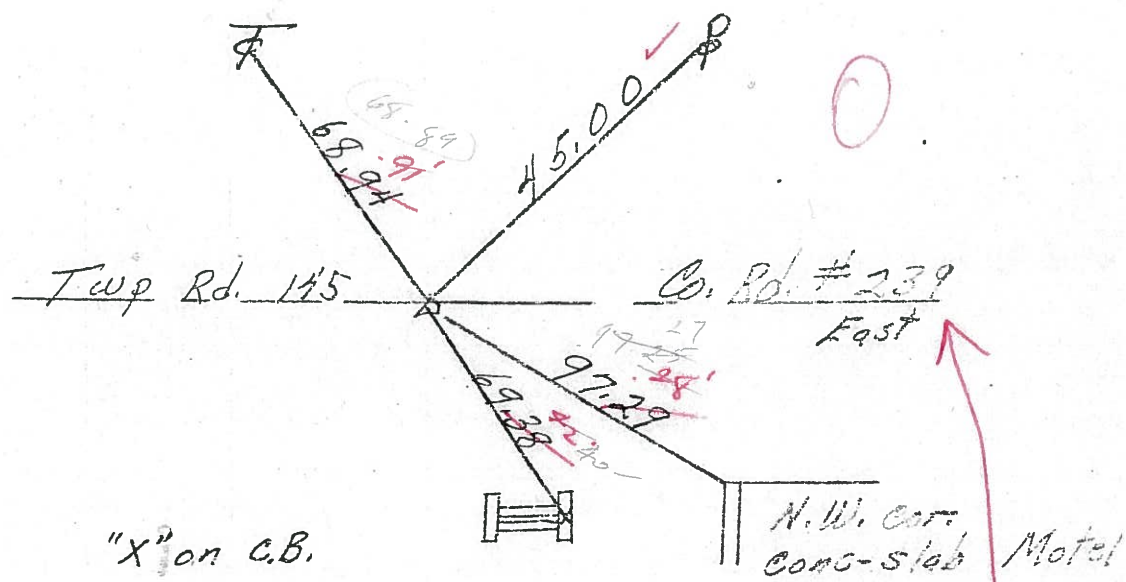

791+33.93 = Const. &  
PT. 791+33.55 Survey  
R.R. spk.  
1' L + PVT

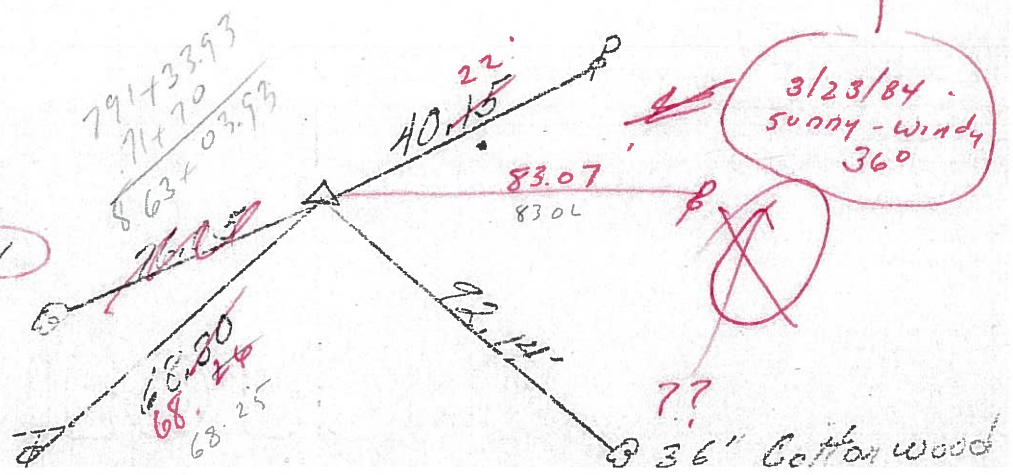


PERSONNEL	TITLE	PERSONNEL	TITLE

COUNTY Ottawa DATE 6-4-71  
 S. R. 53 WEATHER Hot  
 SEC. S.R. 163 North TEMP. 80°

DESCRIPTION	LEFT	CENTER LINE	RIGHT	JOB NO.


831+21.35  
R.R. spk

67

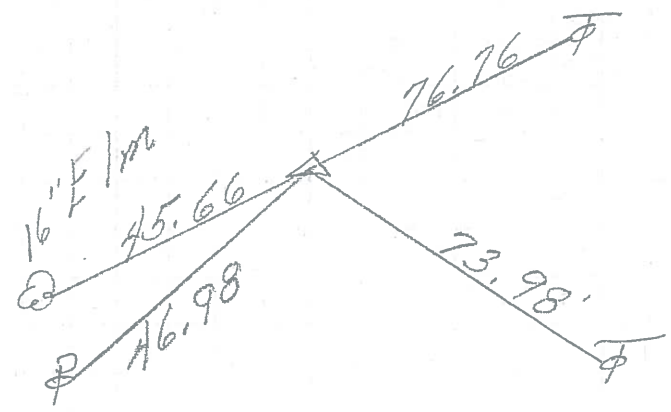


806+09.85  
R.R. spk

66

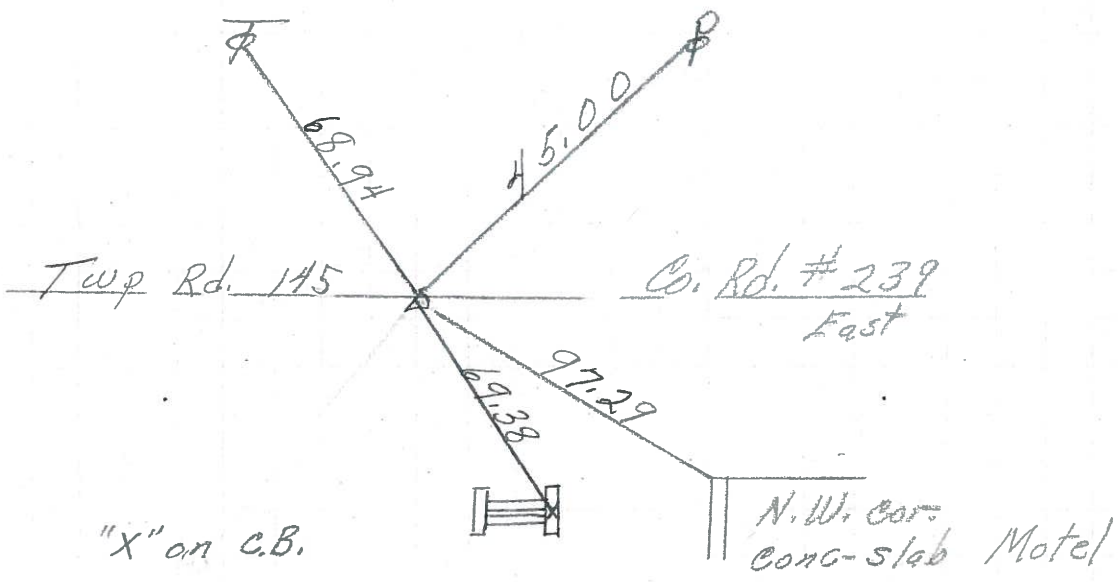

791+33.93 = const. &  
P.I. 791+33.55 & survey  
R. R. spk.

65

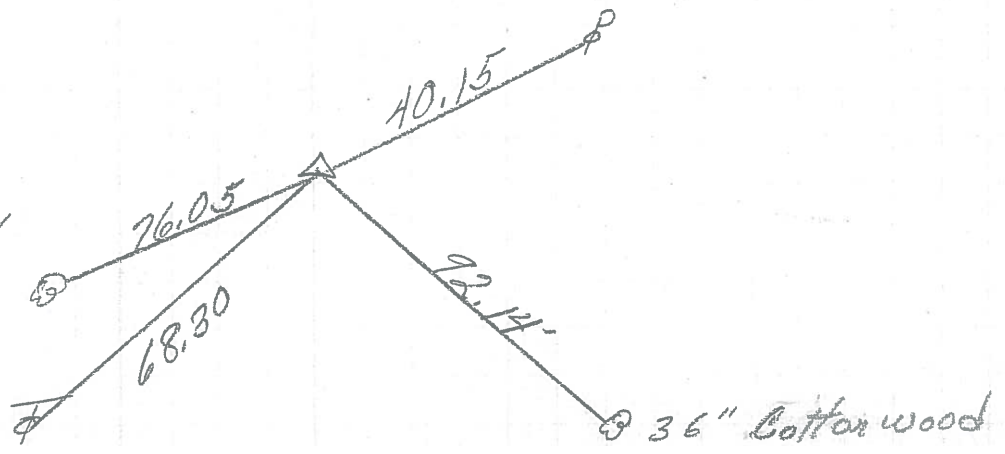

PERSONNEL TITLE PERSONNEL TITLE

Schneider

Potts

COUNTY Ottawa

DATE 8-2-68

Mosser

S. R. 53

WEATHER Fair

Barbour

SEC. S.R. #163 North

TEMP. 80°

Redding


DESCRIPTION Ties for Control Points

JOB NO.

LEFT

CENTER LINE

RIGHT

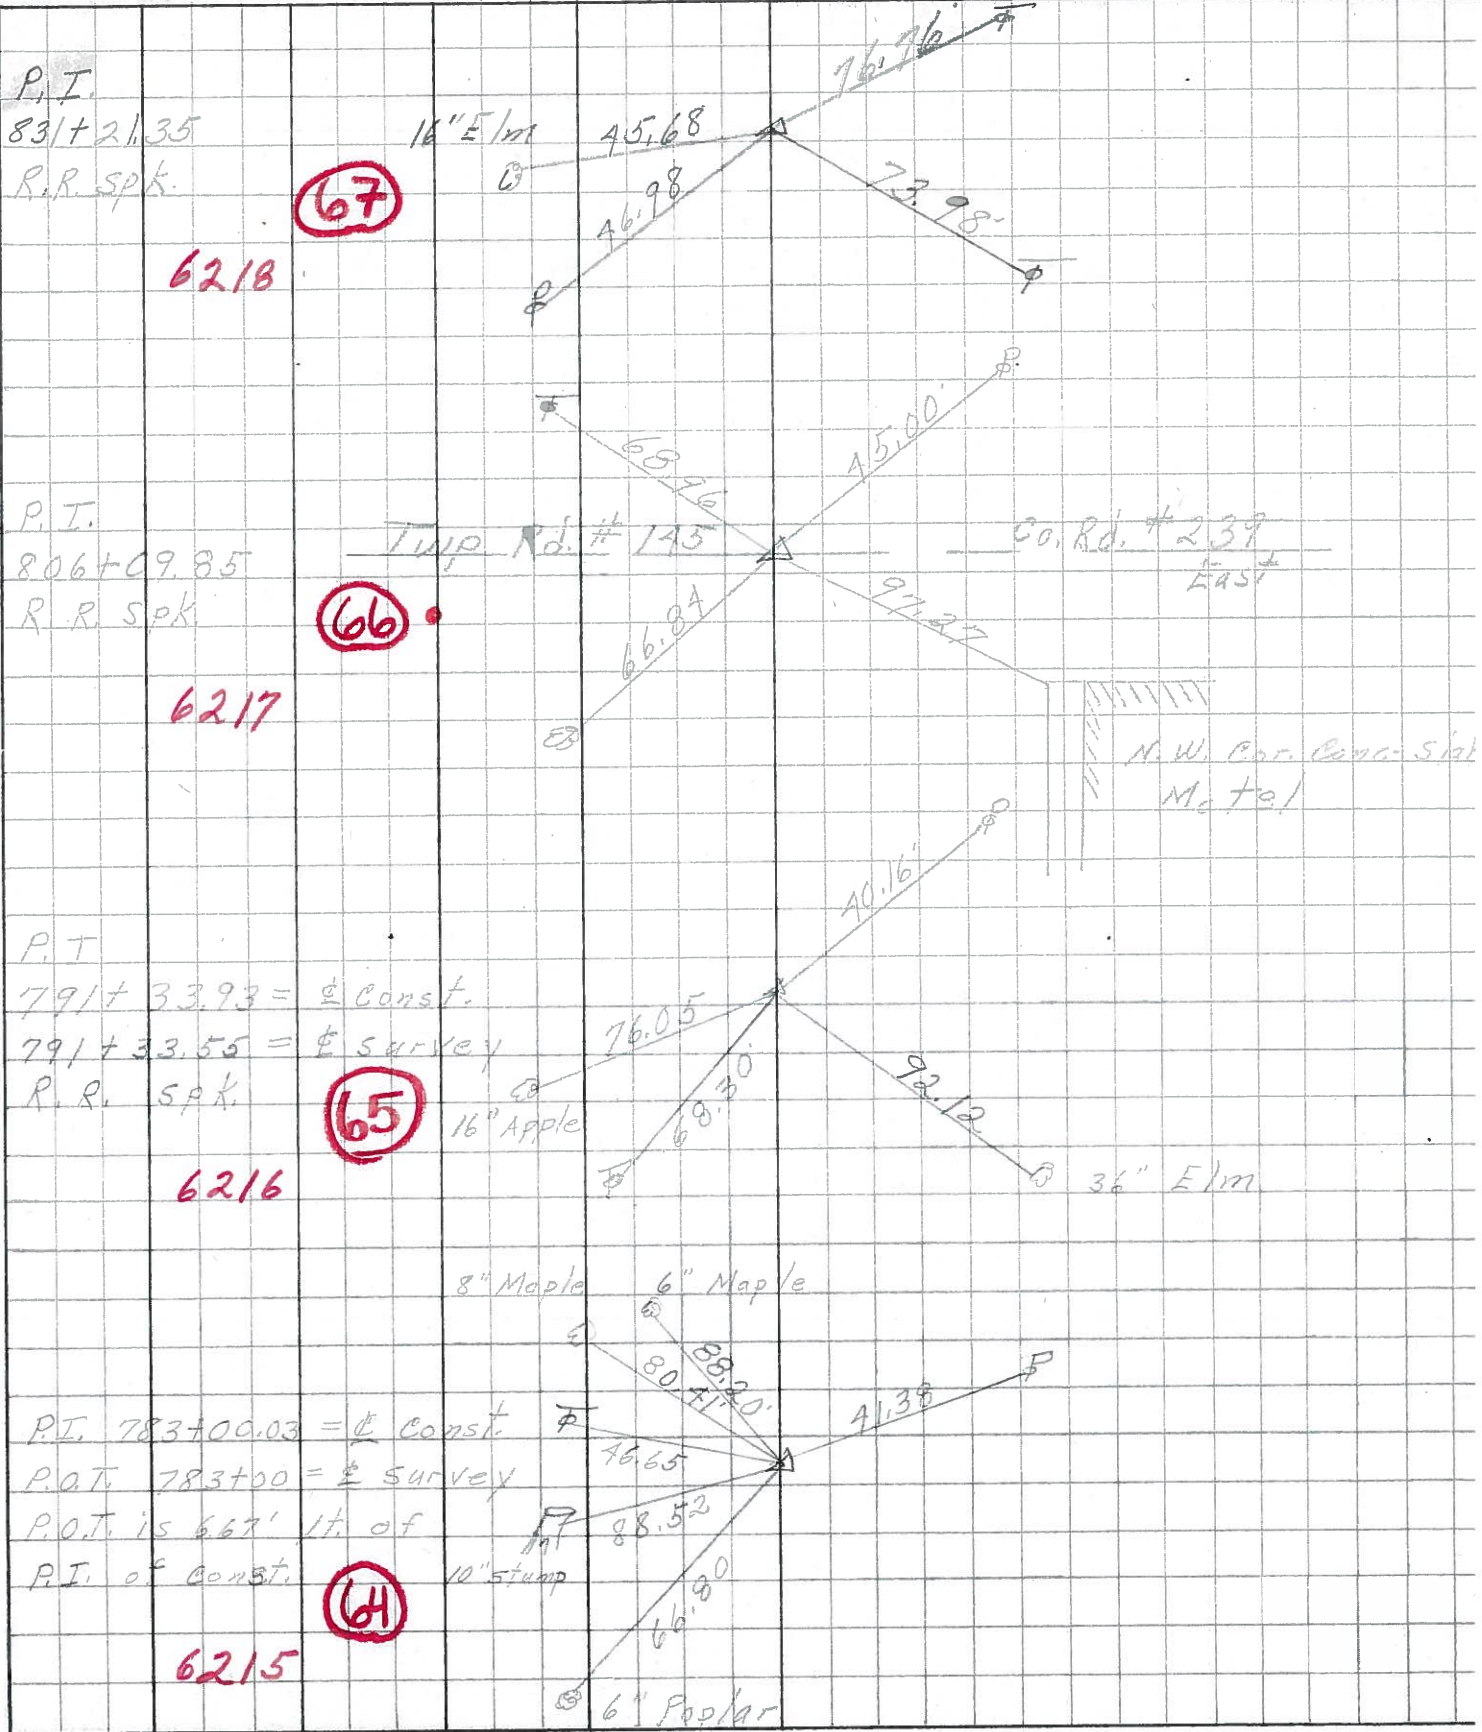







PERSONNEL TITLE PERSONNEL TITLE COUNTY OTTAWA DATE 2-11-58  
SWORDEN \_\_\_\_\_  
Helcombe \_\_\_\_\_ S. R. #53 WEATHER Cloudy  
SAGE \_\_\_\_\_  
MULT \_\_\_\_\_ SEC. \_\_\_\_\_ TEMP. +12°

DESCRIPTION FE PINS LEFT CENTER LINE RIGHT JOB NO.

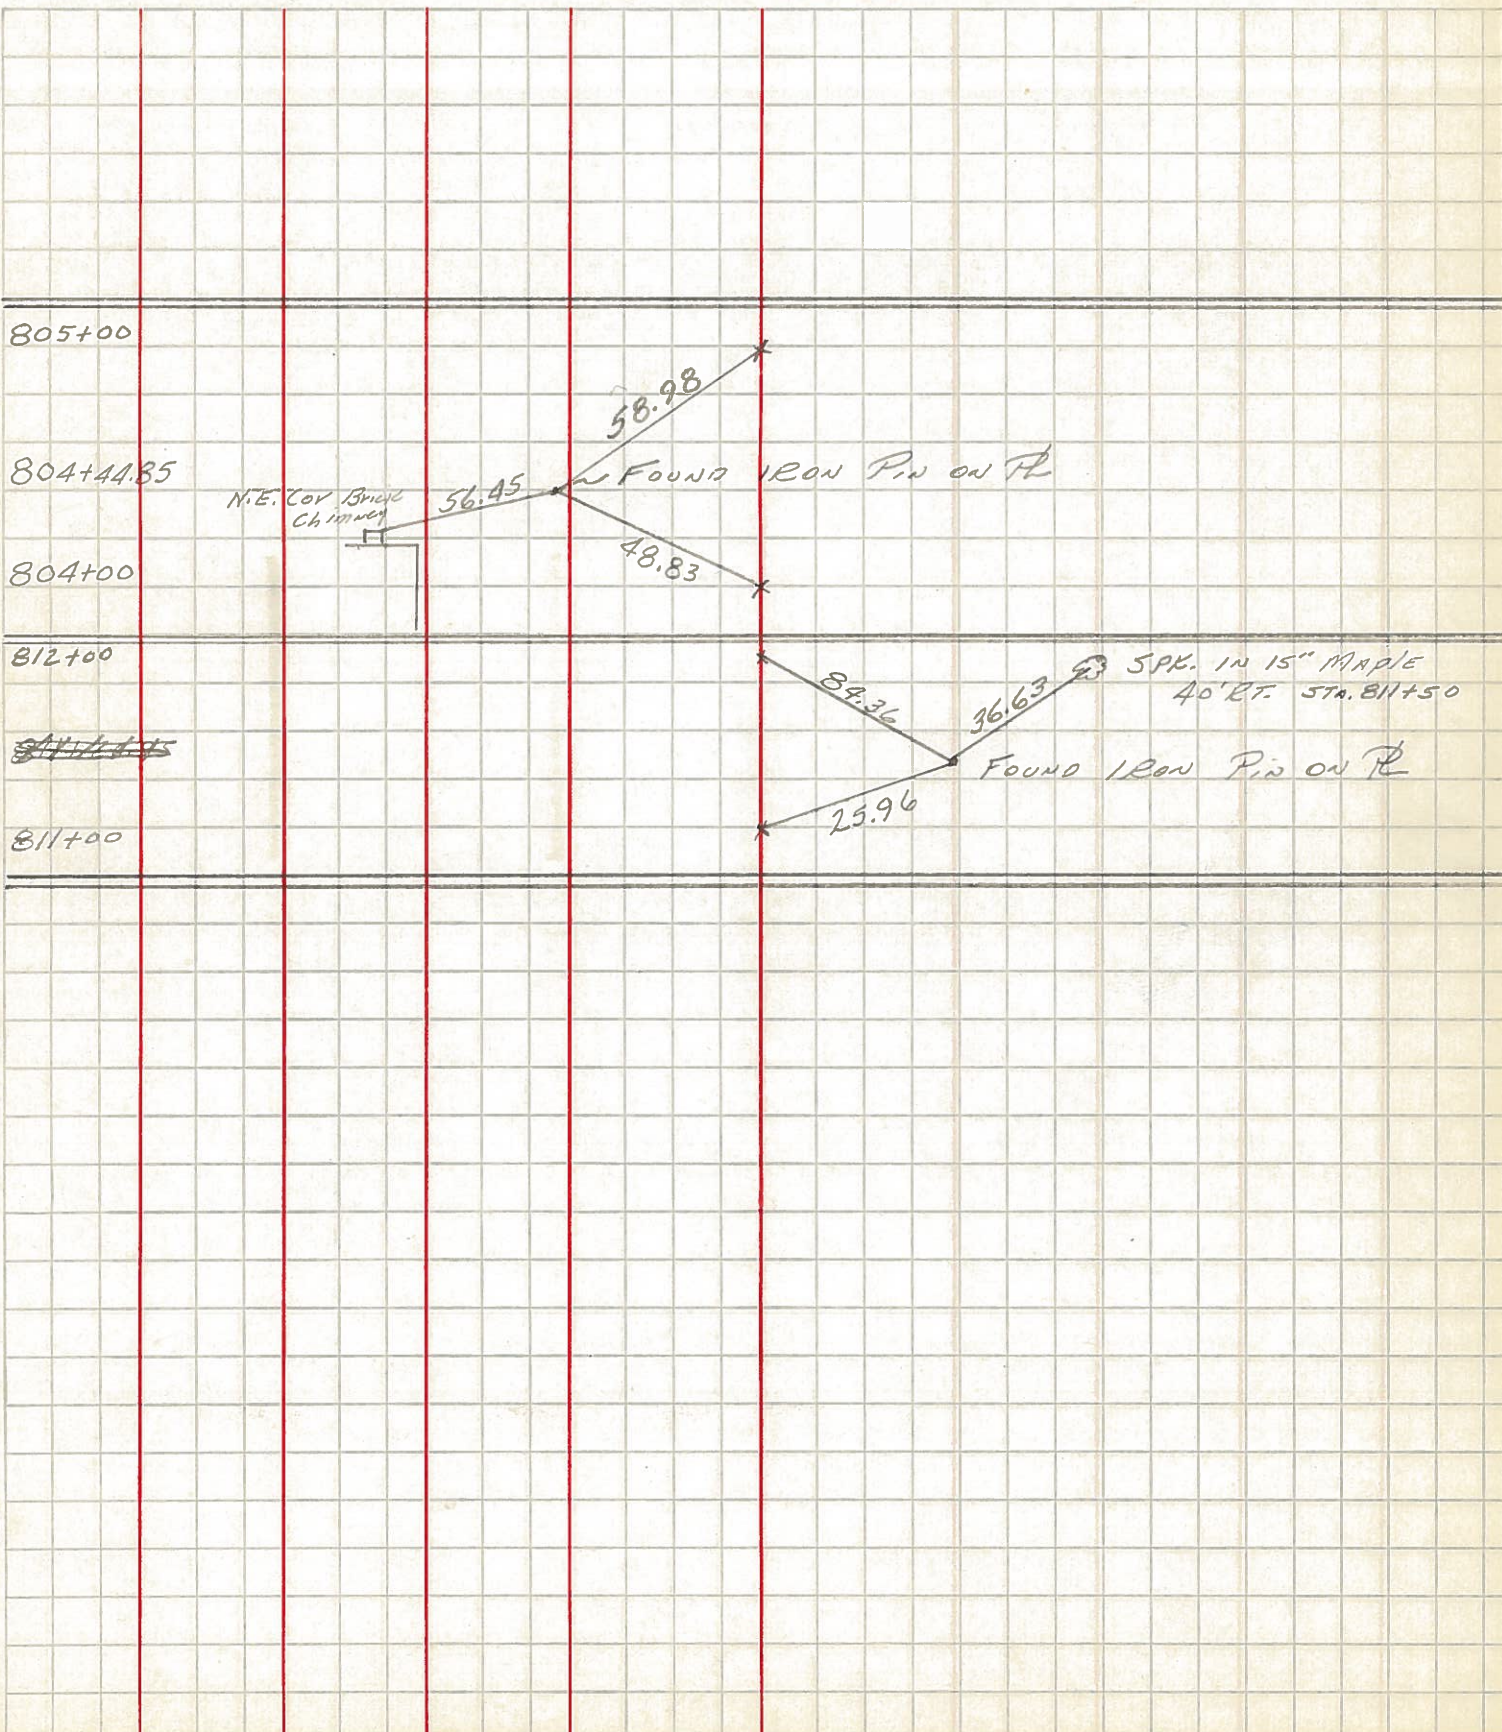

PERSONNEL TITLE PERSONNEL TITLE COUNTY OTTAWA DATE 2-11-58  
SWORDEN \_\_\_\_\_  
Helcombe \_\_\_\_\_ S. R. #53 WEATHER Cloudy  
SAGE \_\_\_\_\_  
MULT \_\_\_\_\_ SEC. \_\_\_\_\_ TEMP. +12°

DESCRIPTION FE Pins LEFT CENTER LINE RIGHT JOB NO.

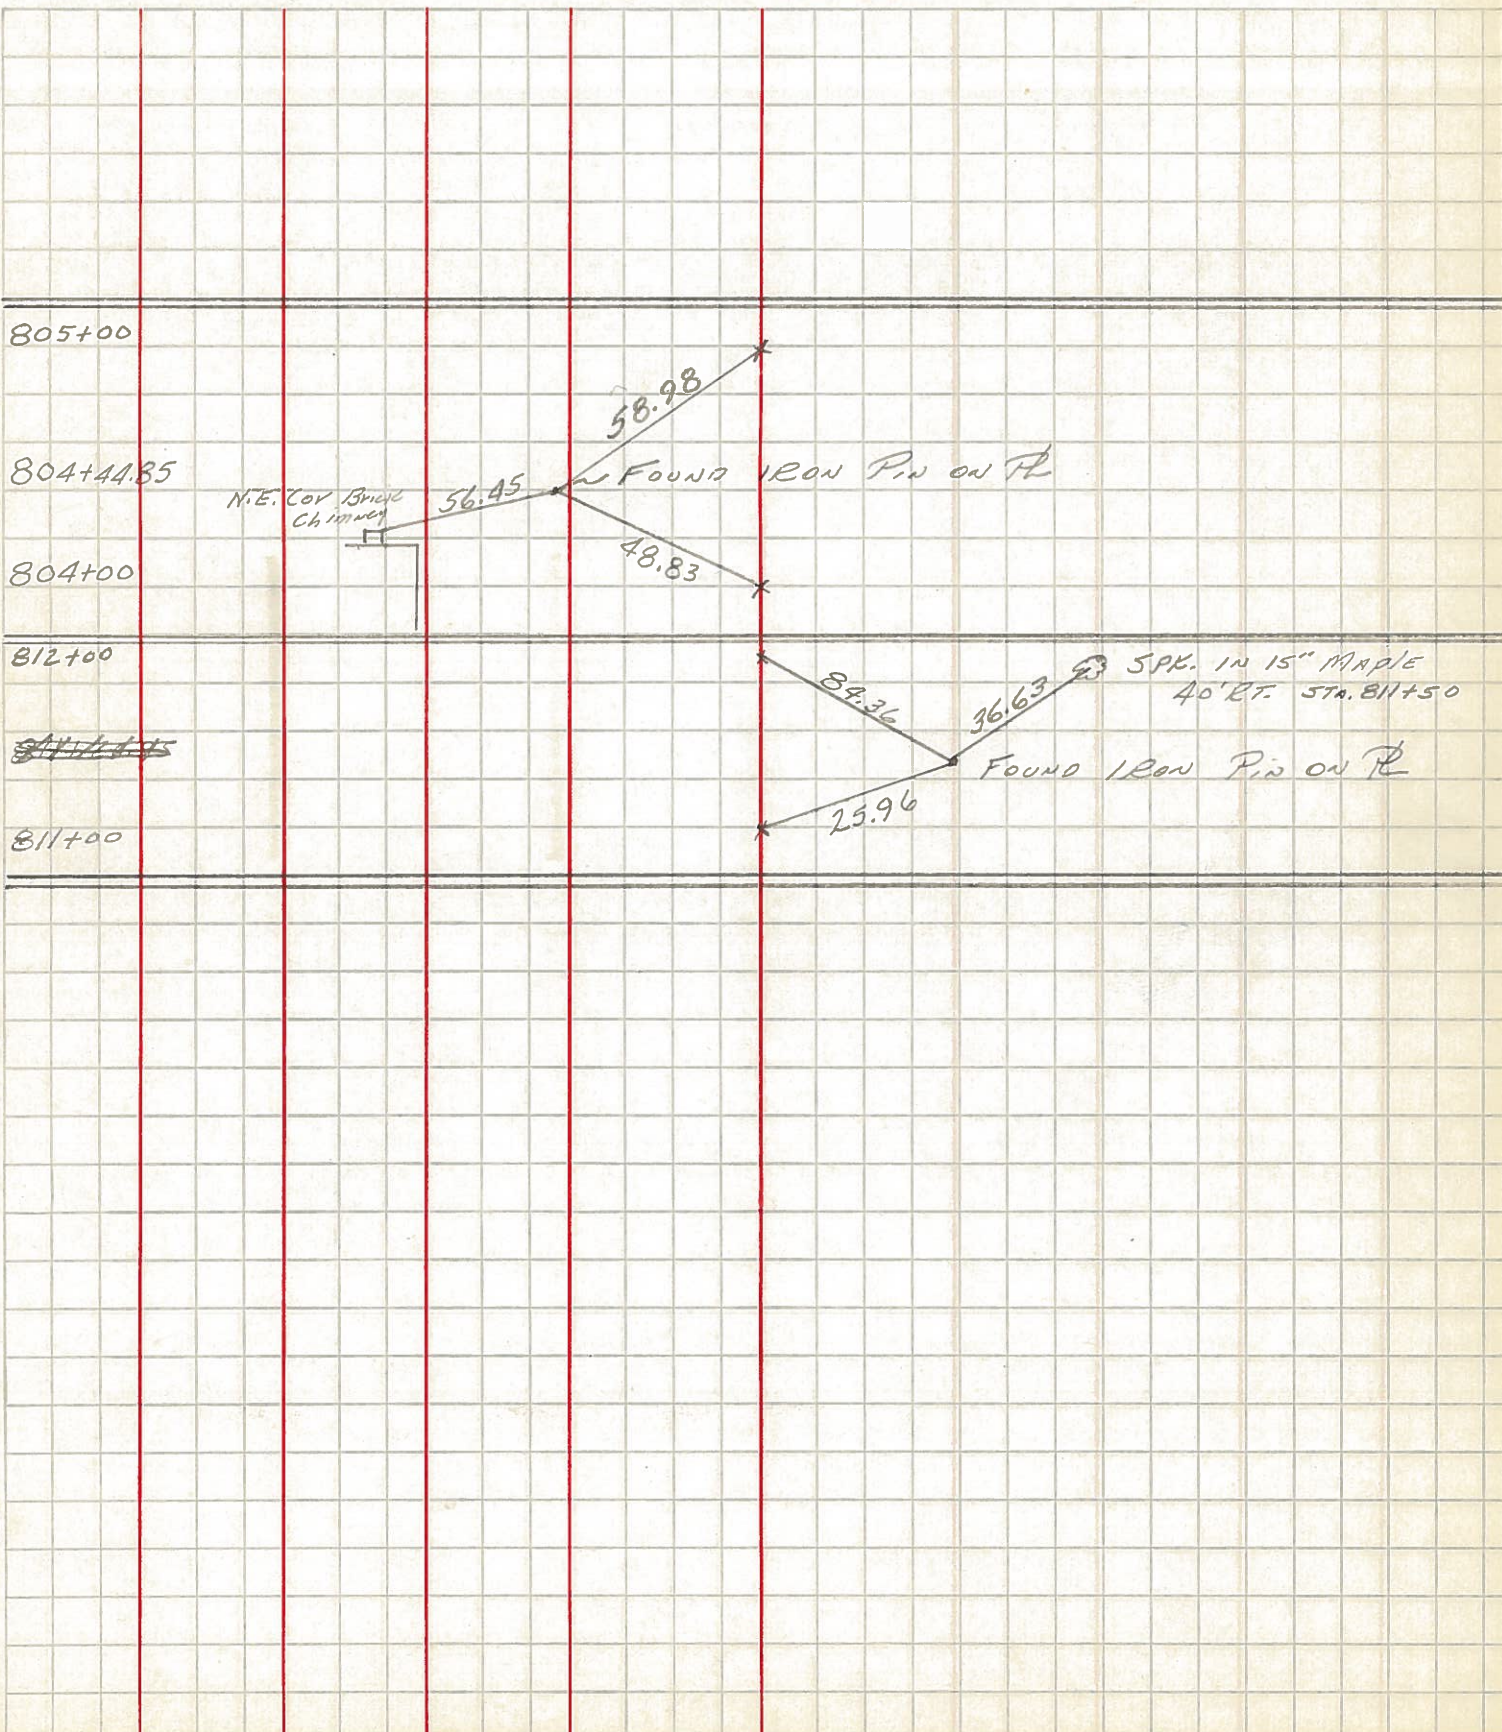

PERSONNEL	TITLE	PERSONNEL	TITLE	COUNTY	DATE
<u>SWORDEN</u>	_____	_____	_____	<u>OTTAWA</u>	<u>1-23-58</u>
<u>Holcombe</u>	_____	_____	_____	S. R. <u>#53</u>	WEATHER <u>Cloudy</u>
<u>SAGE</u>	_____	_____	_____	SEC. _____	TEMP. <u>+30°</u>
<u>BULT</u>	_____	_____	_____	_____	_____

DESCRIPTION R.R. TIES PART # 2 LEFT CENTER LINE RIGHT JOB NO. \_\_\_\_\_

