


O.D.O.T. DISTRICT 2 SURVEY OFFICE (USE ONLY)

PERSONNEL _____ REFERENCE NO. 67 SHEET 25 OF 34
 NOTES AUBLE DATE 8/26/22 ROUTE SR 53
 H.C. NIESE WEATHER CLOUDY COUNTY OTTAWA
 R.C. RHOADES TEMP. 72° TOWNSHIP CATAWBA
 DWG BY RHOADES PID 102905 SECTION 4-27
 CONNECTICUT WESTERN RESERVE


TYPE MONUMENT MAG/WASHER
 ON SURFACE - ~~BELOW~~ ON
 OFFSET CL PAVEMENT ON LT : RT
12.1' TO RT EDGE PAVEMENT
 STATION: 904+32.68

NOTE:
 THIS MAP IS FOR ODOT PURPOSES ONLY.
 TO INDEX REFERENCE TIES, AND DOES NOT
 REPRESENT TRUE LAND SUBDIVISION.

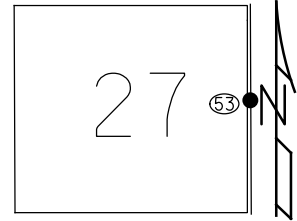

HORZ. DATUM: NAD83 2011 GEOID: NAVD88 2018
 GRID: NORTHING: 696860.366 EASTING: 1877529.866

RECORD: P.I.
 STA. 831+21.35
 FD P.K./WASHER
 6/14/95
 SET P.K./WASHER
 5/22/96, CL
 FD P.K.NAIL
 REF67
 8/26/11, DCH
 SET MAG/WASHER
 NEWREF67
 8/7/12, DCH
 FD MAG/WASHER
 REF67
 3/8/21, JFO
 SET MAG/WASHER
 5/16/23, TDN

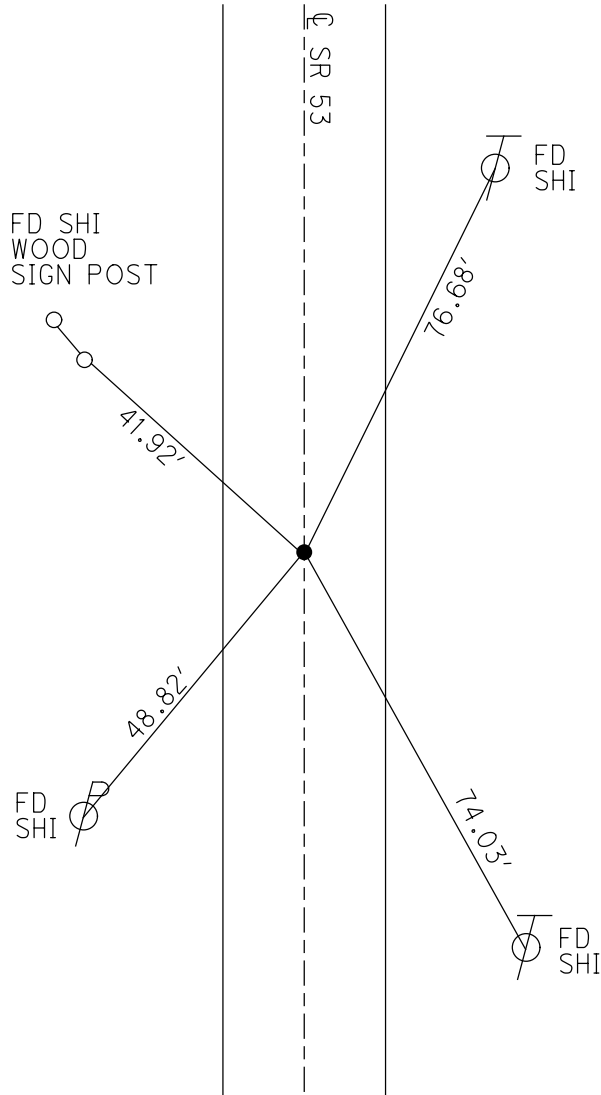


O.D.O.T. DISTRICT 2 SURVEY OFFICE (USE ONLY)

PERSONNEL _____ REFERENCE NO. 67 SHEET 28 OF 36
 NOTES HOMAN DATE 8/26/11 ROUTE SR 53
 H.C. ROUSOS WEATHER SUNNY COUNTY OTTAWA
 R.C. HARBAUGH TEMP. 80° TOWNSHIP CATAWBA ISL
 _____ SECTION 4-27


TYPE MONUMENT P.K.NAIL
 ON SURFACE - ~~BELOW~~ ON
 LEFT - Q PAV'T - RIGHT ON
12.1' TO RT EDGE PAVEMENT
 S.L.M. 904+56.91

NOTE:
THIS MAP IS FOR ODOT PURPOSES ONLY
TO INDEX REFERENCE TIES, AND DOES NOT
REPRESENT TRUE LAND SUBDIVISION.

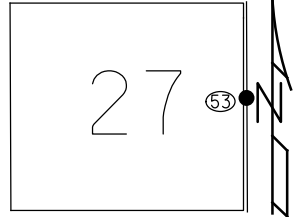

GRID: NORTHING: 696860.259 EASTING: 1877529.690

RECORD: P.I.
 STA. 831+21.35
 FD P.K./WASHER
 6/14/95
 SET P.K./WASHER
 5/22/96, CL
 FD P.K.NAIL
 GPS, REF67
 SET MAG/WASHER
 NEWREF67
 8/7/12, DCH

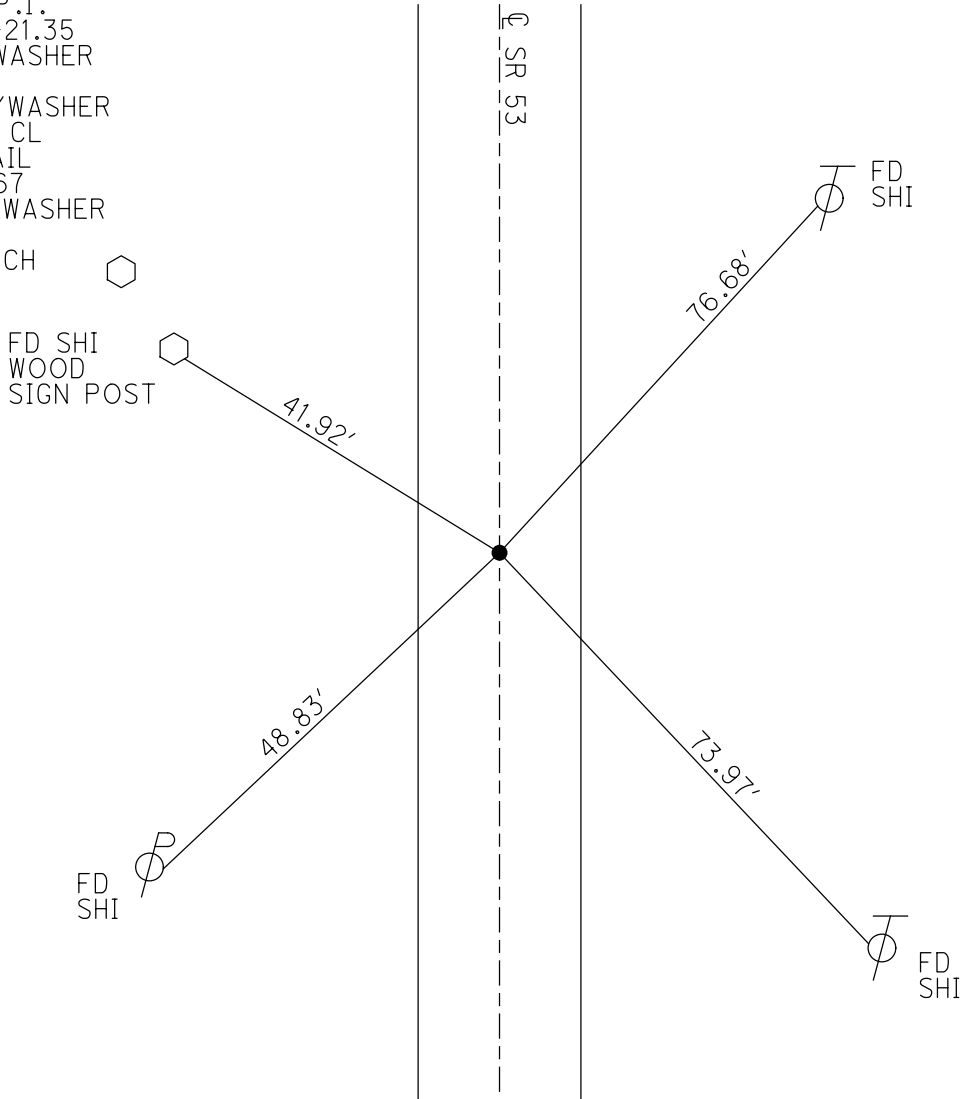

O.D.O.T. DISTRICT 2 SURVEY OFFICE

PERSONNEL _____

REFERENCE NO. 67

SHEET 23 OF 30

NOTES LOEHRYE

H.C. Rousos

DATE 6-14-95

ROUTE S.R. 53

R.C. Huss

WEATHER FAIR

COUNTY OTTAWA

TEMP. +75

TOWNSHIP CATAWBA

SECTION _____

T _____ R _____


TYPE MONUMENT P.K. / WASHER ^{Reset} 5-22-96

ON SURFACE - BELOW Yes _{C.L.}

LEFT - & PAV'T. - RIGHT Yes


12.1 TO R+ EDGE PAVEMENT

S.L.M. 904+79

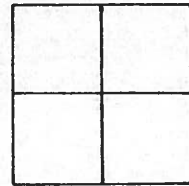

RECORD P.I. R/W

Sta 831+21.35

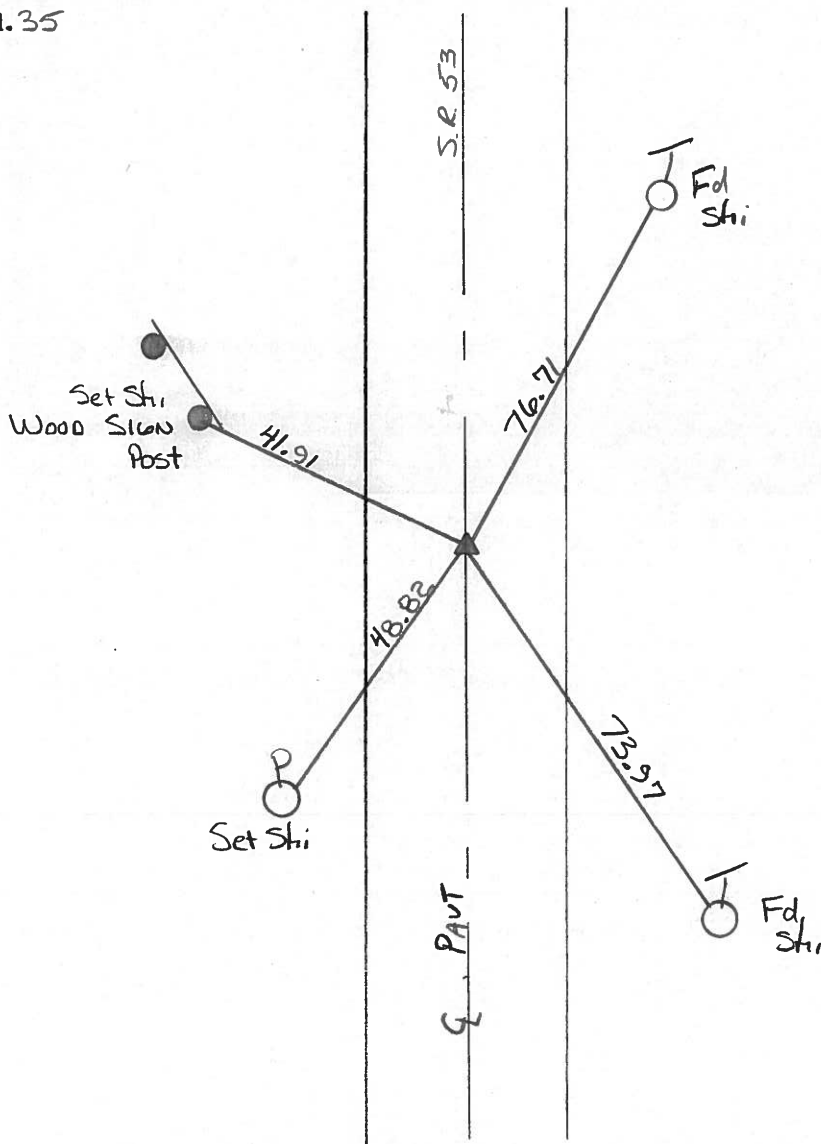

16
O.D.O.T. DISTRICT 2 SURVEY OFFICE

SHEET _____ OF _____

County Ottawa S.R. #53

Date 8/29/84

Township Catawba

Weather overcast - windy

Section _____

Temp. 66°

T N, R E


Personnel Cronin

Ripple


Geyman

Barbour

PT 67

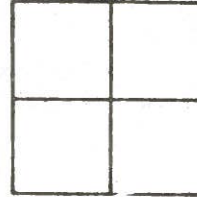

P.I. R/W
831 +21.35
Set P.K. E washer atop
R.P. spike

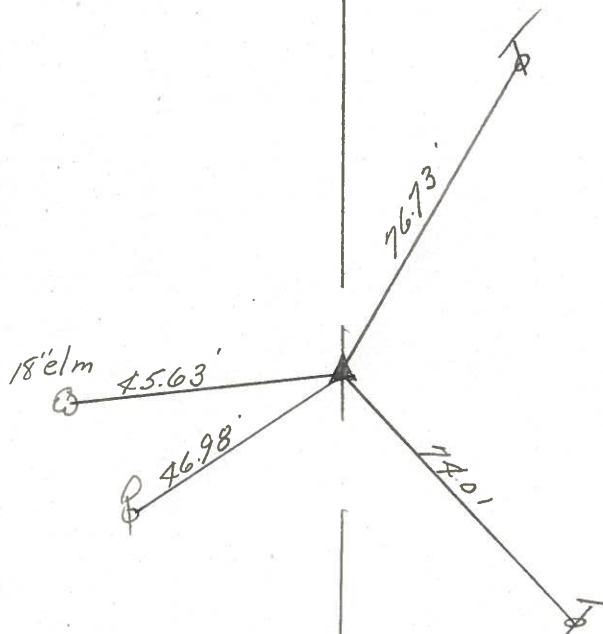

R/W S.R. #53


PERSONNEL	TITLE	PERSONNEL	TITLE	COUNTY	DATE
				Ottawa	6-4-71
				S. R. 53	WEATHER Hot
				SEC. S.R. 163 North	TEMP. 80°

DESCRIPTION	L.F.T	CENTER LINE	RIGHT	JOB NO.
-------------	-------	-------------	-------	---------

P.L. R/W SUR
 831+21.35
 R.R. spk

67


831+21.35
 71+70
 902T. 91.35

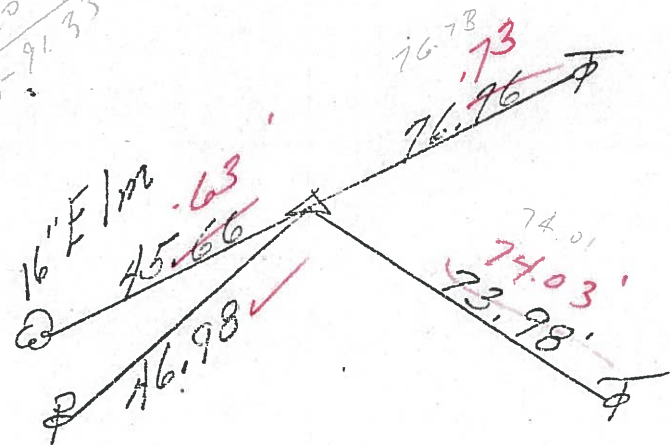

3/12/84
 overcast,
 20° windy

P.L. R/W SUR
 806+09.85
 R.R. spk

66

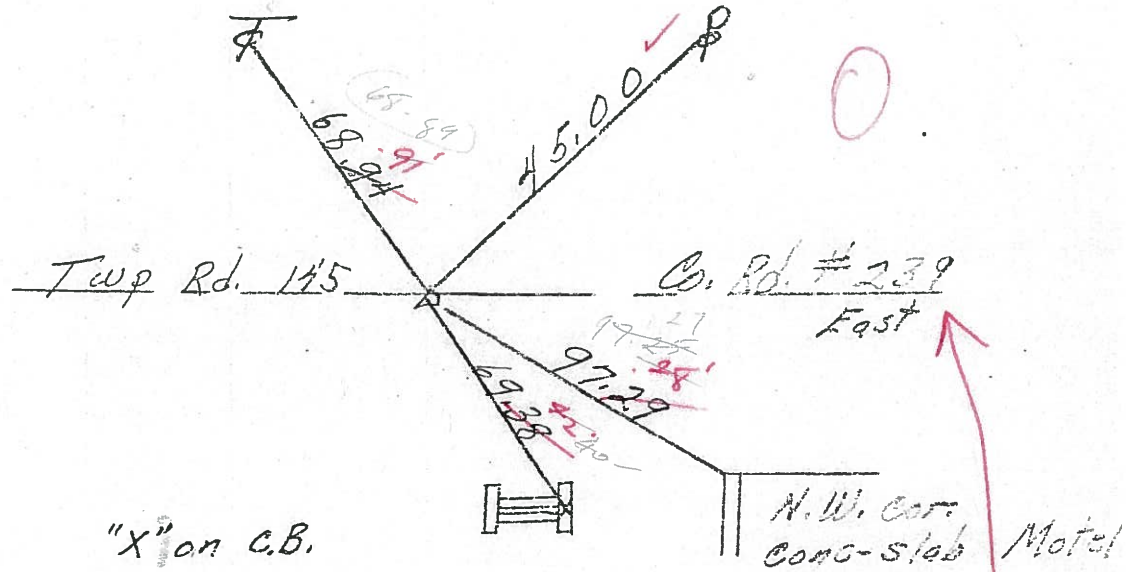


"X" on C.B.

0

791+33.93 = Const. &
 P.L. 791+33.55 Survey
 R.R. spk.
 1' L + PVT

791+33.93
 71+70
 863+03.93

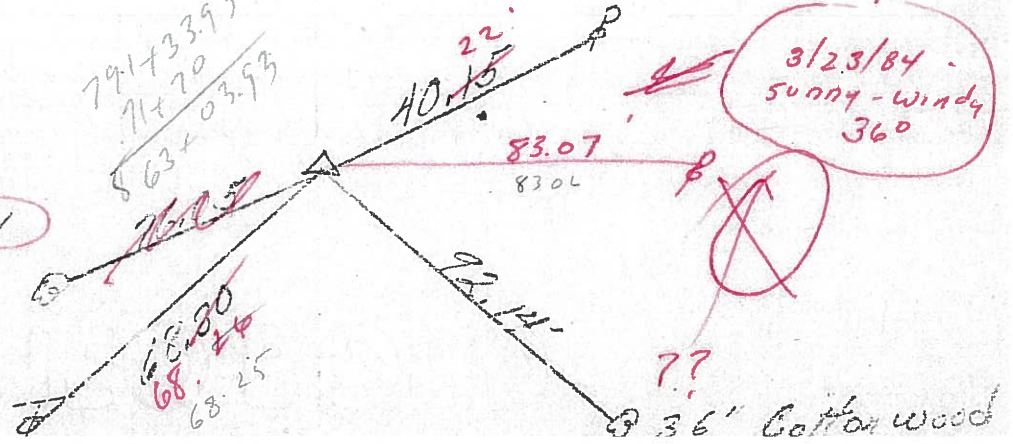

3/23/84 -
 sunny - windy
 36°

??


36" Cottonwood

PERSONNEL	TITLE	PERSONNEL	TITLE	COUNTY	DATE
				<u>Ottawa</u>	<u>6-4-71</u>
				S. R. <u>53</u>	WEATHER <u>Hot</u>
				SEC. <u>S.R. 163 North</u>	TEMP. <u>80°</u>

DESCRIPTION	LEFT	CENTER LINE	RIGHT	JOB NO.
-------------	------	-------------	-------	---------


831+21.35
R.R. spk

67.

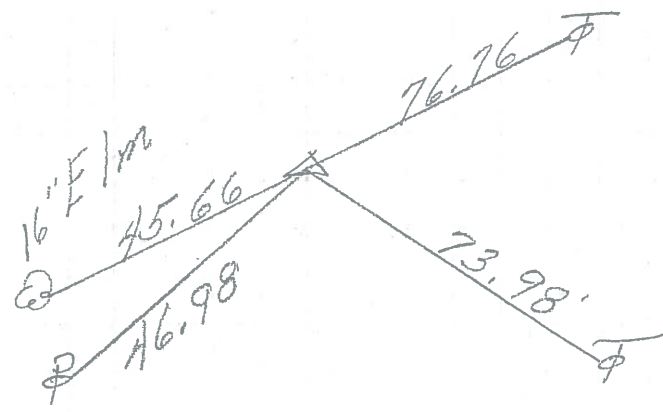


806+09.85
R.R. spk.

66.

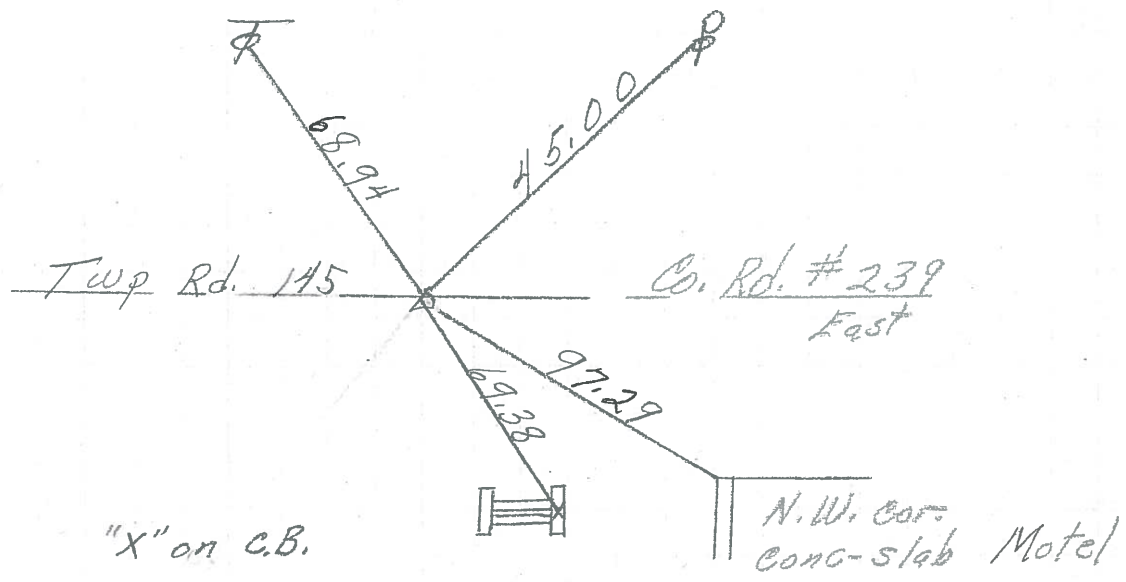

791+33.93 = const. $\frac{1}{2}$
P.I. 791+33.55 $\frac{1}{2}$ survey
R. R. spk.

65.

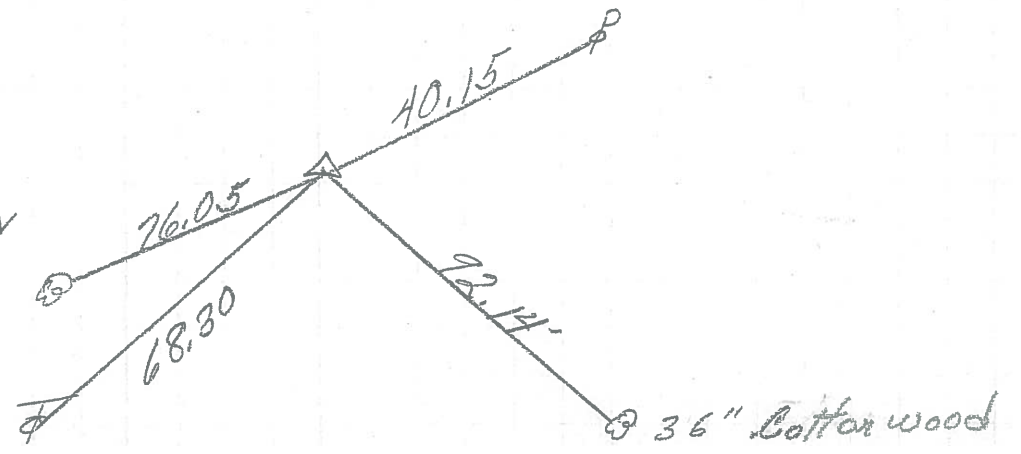

PERSONNEL	TITLE	PERSONNEL	TITLE	COUNTY	Ottawa	DATE	8-2-68
Schneider		Potts		S. R.	53	WEATHER	Fair
Mosser				SEC.	S.R.#163 North	TEMP.	80°
Barbour				DESCRIPTION Ties for Control Points			
Redding				JOB NO.			

