


O.D.O.T. DISTRICT 2 SURVEY OFFICE (USE ONLY)

PERSONNEL _____ REFERENCE NO. 69 SHEET 27 OF 34
 NOTES AUBLE DATE 8/26/22 ROUTE SR 53
 H.C. NIESE WEATHER CLOUDY COUNTY OTTAWA
 R.C. RHOADES TEMP. 72° TOWNSHIP CATAWBA
 DWG BY RHOADES PID 102905 SECTION 4-26
 CONNECTICUT WESTERN RESERVE


TYPE MONUMENT R.R.SPIKE
 ON SURFACE - ~~BELOW~~ ON
 OFFSET 0.5' LT : RT
11.5' TO RT EDGE PAVEMENT
 STATION: 925+71.65

HORIZ.DATUM: NAD83 2011 GEOID: NAVD88 2018
 GRID: NORTHING: 698999.140 EASTING: 1877486.775

NOTE:
 THIS MAP IS FOR ODOT PURPOSES ONLY
 TO INDEX REFERENCE TIES, AND DOES NOT
 REPRESENT TRUE LAND SUBDIVISION.

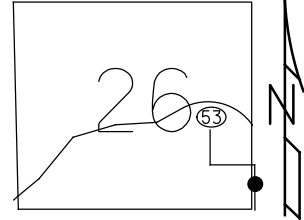

RECORD: P.C.
 STA. 852+61.25
 FD P.K./WASHER
 6/14/95
 SET P.K./WASHER
 5/22/96, CL
 FD P.K.NAIL
 REF69
 9/1/11, DCH
 SET MAG/WASHER
 NEWREF69
 8/7/12, DCH
 FD MAG/WASHER
 REF69
 3/8/21, JFO
 SET R.R.SPIKE FD
 ABOVE MAG SHASIKI
 5/16/23, TDN

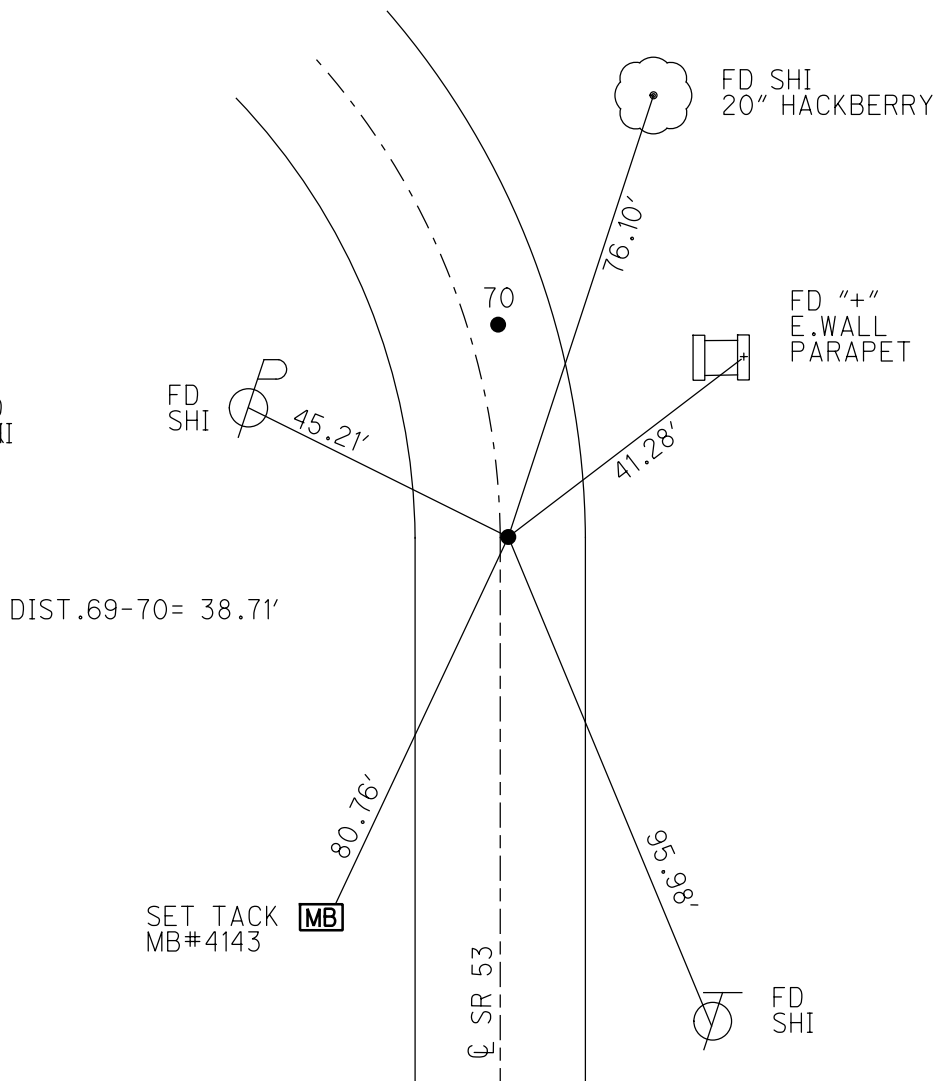


O.D.O.T. DISTRICT 2 SURVEY OFFICE (USE ONLY)


PERSONNEL _____ REFERENCE NO. 69 SHEET 30 OF 36
 NOTES HOMAN DATE 9/1/11 ROUTE SR 53
 H.C. ROUSOS WEATHER SUNNY COUNTY OTTAWA
 R.C. HARBAUGH TEMP. 85° TOWNSHIP CATAWBA ISL
 _____ SECTION 4-26

TYPE MONUMENT P.K.NAIL
 ON SURFACE - ~~BELOW~~ ON _____
~~LEFT~~ - CL PAV'T - RIGHT 1.1'
12.0' TO RT EDGE PAVEMENT
 S.L.M. 925+96.17
 GRID: NORTHING: 698999.101 EASTING: 1877486.728

NOTE:
THIS MAP IS FOR ODOT PURPOSES ONLY
TO INDEX REFERENCE TIES, AND DOES NOT
REPRESENT TRUE LAND SUBDIVISION.

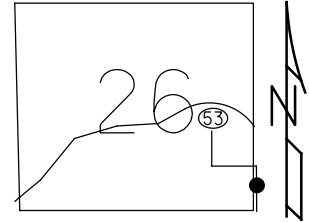

RECORD: P.C.
 STA. 852+61.25
 FD P.K./WASHER
 6/14/95
 SET P.K./WASHER
 5/22/96, CL
 FD P.K.NAIL
 GPS, REF69
 SET MAG/WASHER
 GPS, NEWREF69
 8/7/12, DCH

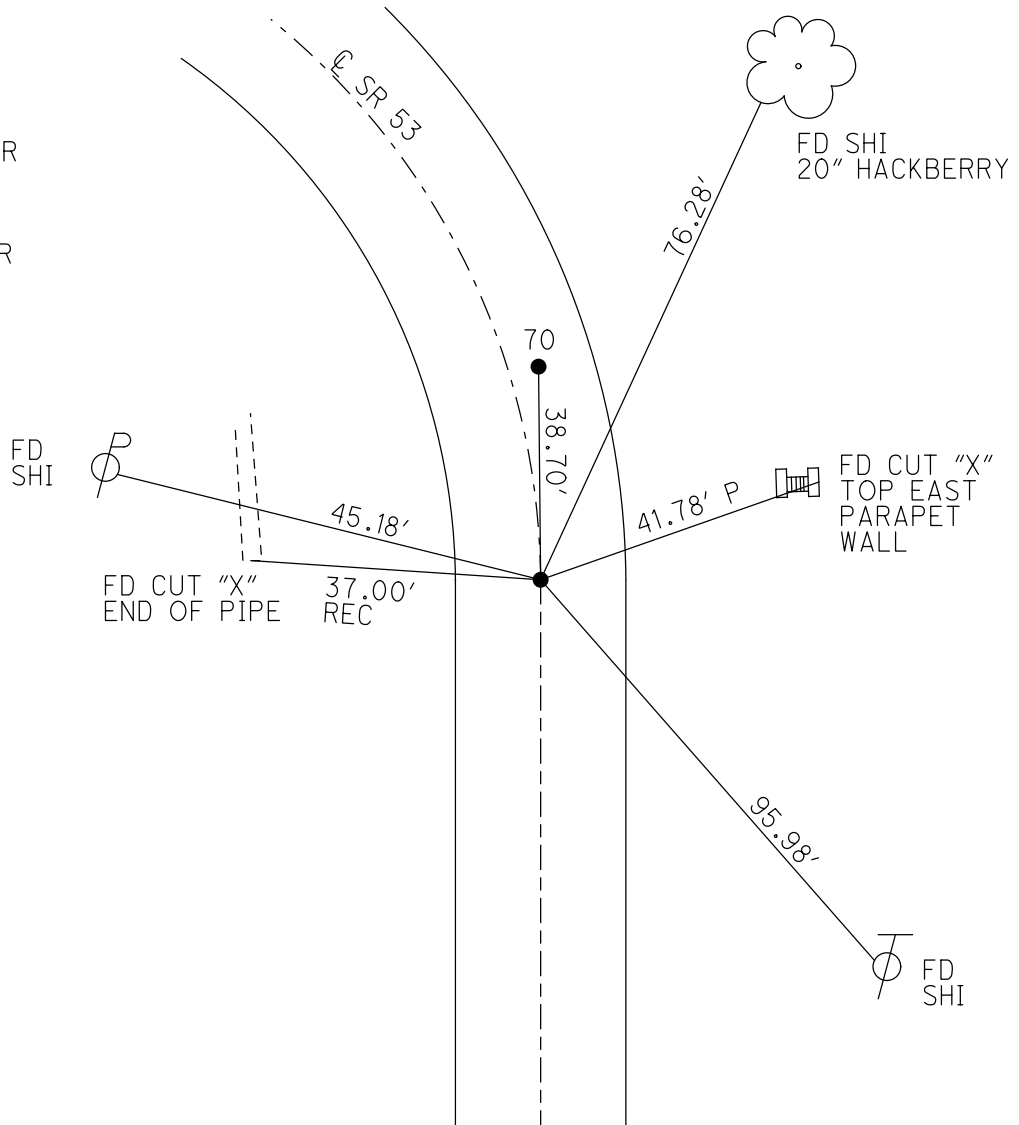

O.D.O.T. DISTRICT 2 SURVEY OFFICE

PERSONNEL

REFERENCE NO. 69 & 70

SHEET 25 OF 30

NOTES VAN DUSEN

H.C. Huss

R.C. Rousos

DATE 6-14-95

WEATHER FAIR

TEMP. +72

ROUTE S.R. 53

COUNTY OTTAWA

TOWNSHIP CATAWBA

SECTION _____

T _____ R _____

Ref # 70 - P.I.

Reset Both

5-22-96



TYPE MONUMENT P.K. & WASHER

ON SURFACE - BELOW Yes

~~LEFT~~ - PAV'T. - RIGHT 5.2' Rt

7.7 TO Rt EDGE PAVEMENT

S.L.M. 926+63

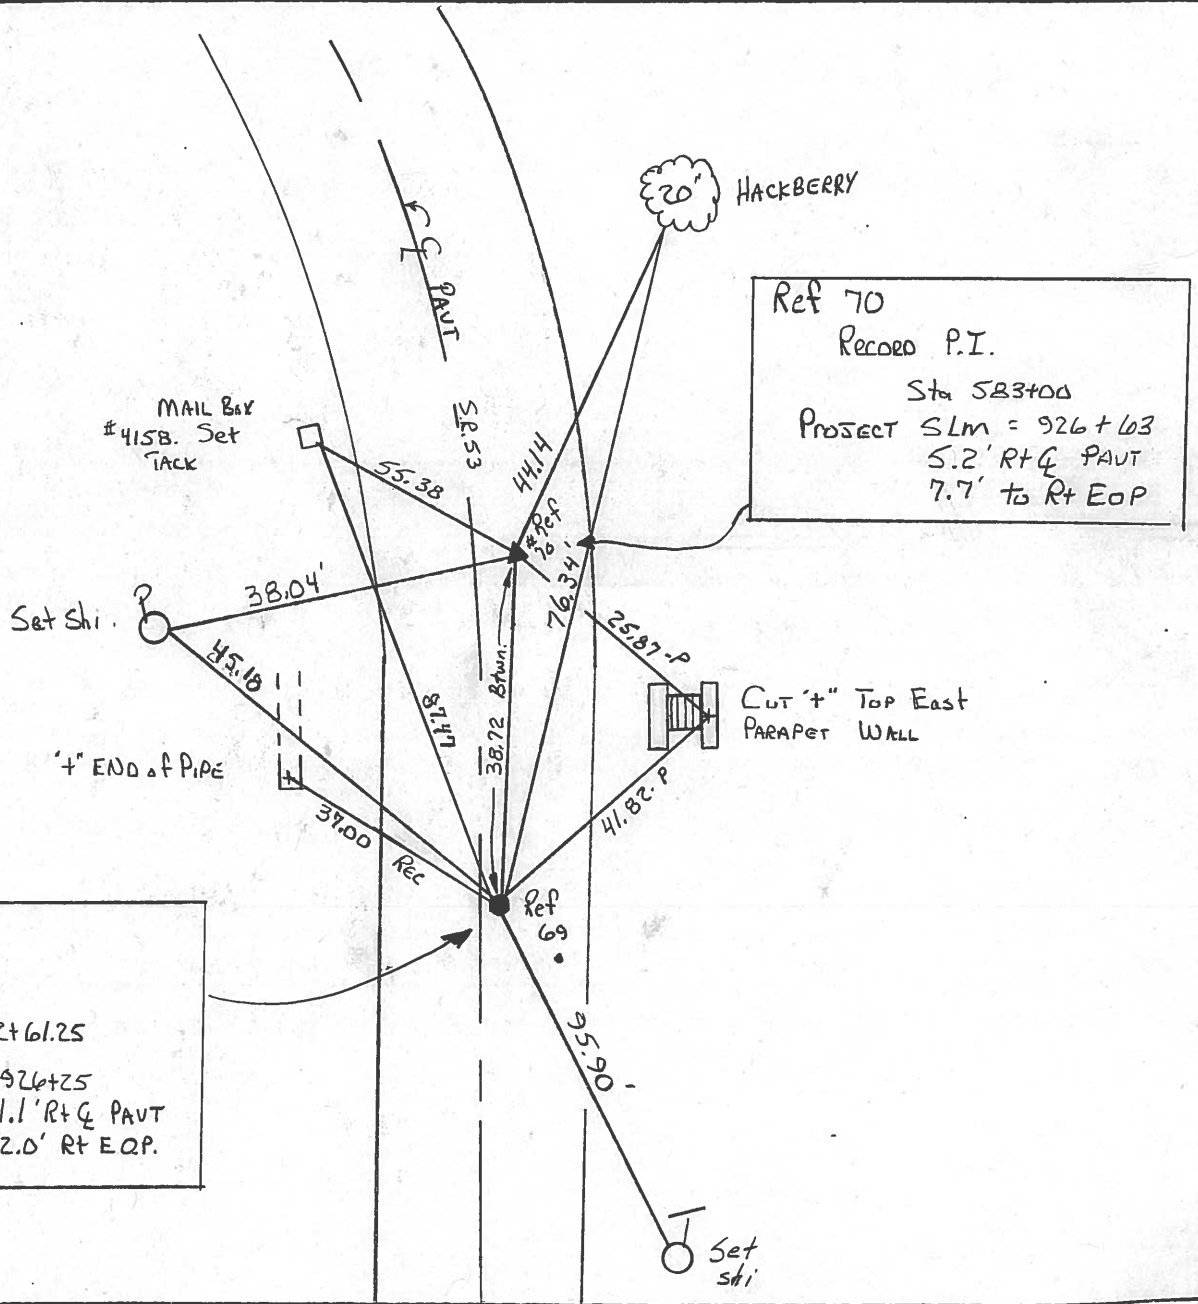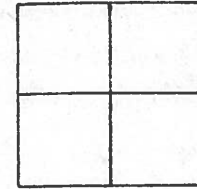

Ref 70
 Record P.I.
 Sta 523400
 Project SLM = 926+63
 5.2' RT & PAVT
 7.7' to Rt EOP

Ref 69.
 Record P.C.
 Sta 852+61.25
 Project SLM = 926+25
 1.1' RT & PAVT
 12.0' RT EOP.


PERSONNEL	TITLE	PERSONNEL	TITLE
DESCRIPTION		S.R. # 163 North	
	LEFT	CENTER LINE	RIGHT

COUNTY Ottawa DATE 6-4-71
 S. R. 53 WEATHER Hot
 SEC. _____ TEMP. 80°
 JOB NO. _____

P.I. SUR
 853+00
 R.R. spk


70

3/12/84
 Overcast
 3.0° Windy

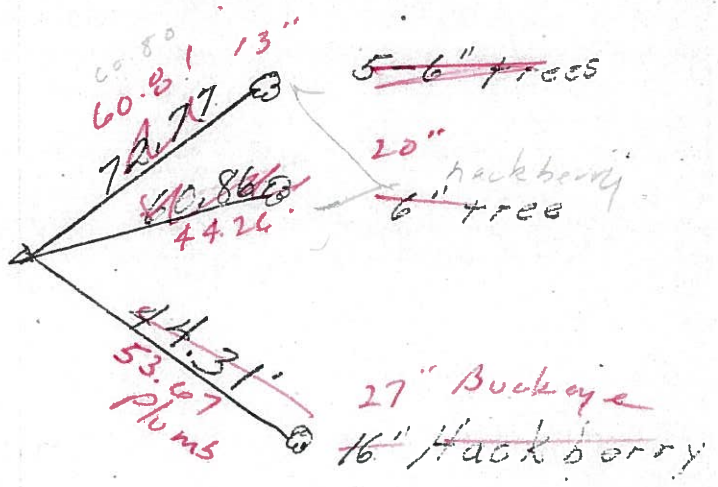

P.C.
 852+61.25
 R.R. spk


69

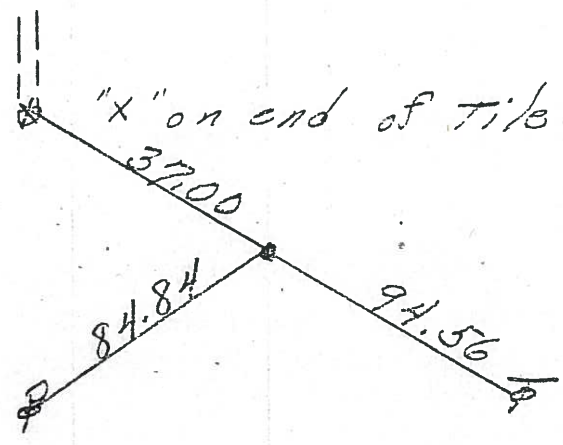

P.I. SUR
 Tang RW
 845+46.35
 R.R. spk.

1' RT. & PV

68

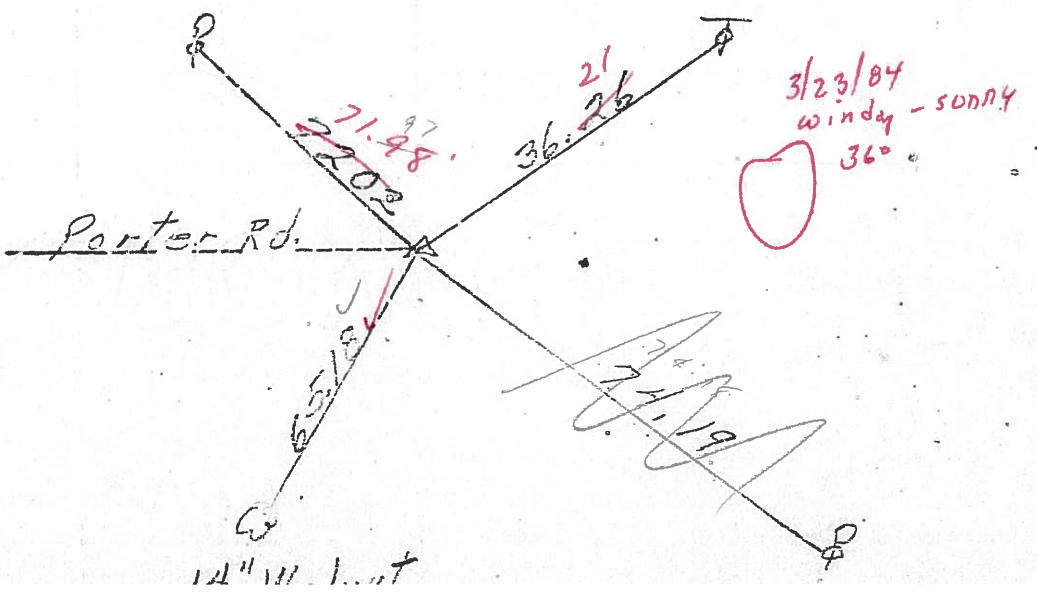

3/23/84
 Windy - sunny
 36°

[Handwritten signature]
 7-1-19

PERSONNEL TITLE PERSONNEL TITLE

COUNTY Ottawa DATE 6-4-71

S. R. 53 WEATHER Hot


SEC. _____ TEMP. 80°

DESCRIPTION S.R. # 163 North JOB NO. _____

LEFT CENTER LINE RIGHT


P.I.
853+00

70

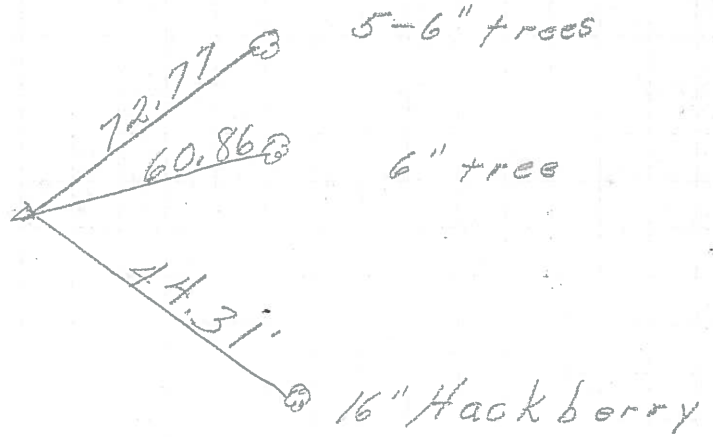


P.C.
852+61.25
R.R. spk.

69

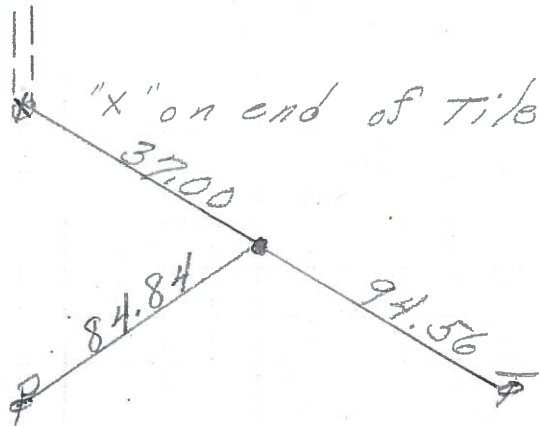

845+46.35
R.R. spk.


68

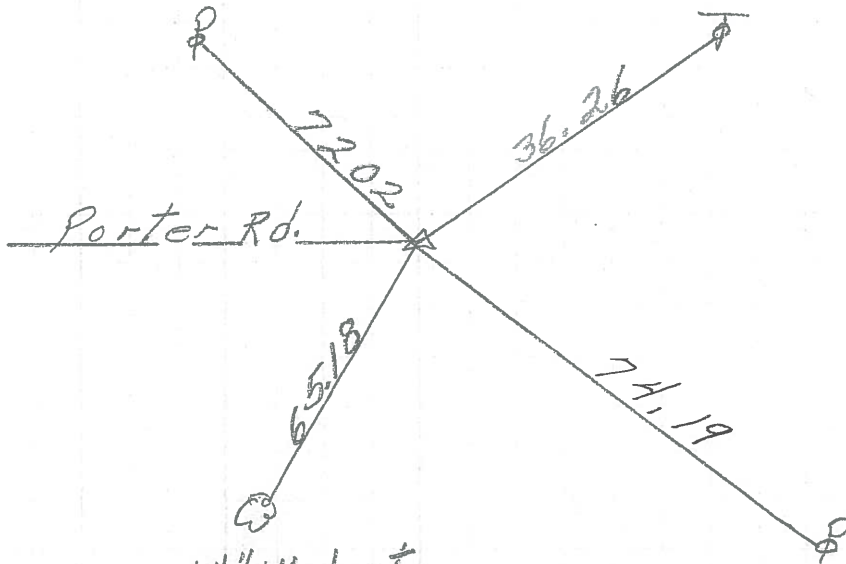

PERSONNEL	TITLE	PERSONNEL	TITLE
Sworden			
Helcombs			
SAGE			
MULT			

COUNTY OTTAWA DATE 1-24-58
 S. R. #53 WEATHER Cloudy
 SEC. _____ TEMP. +29°

DESCRIPTION TR Ties JOB NO. _____

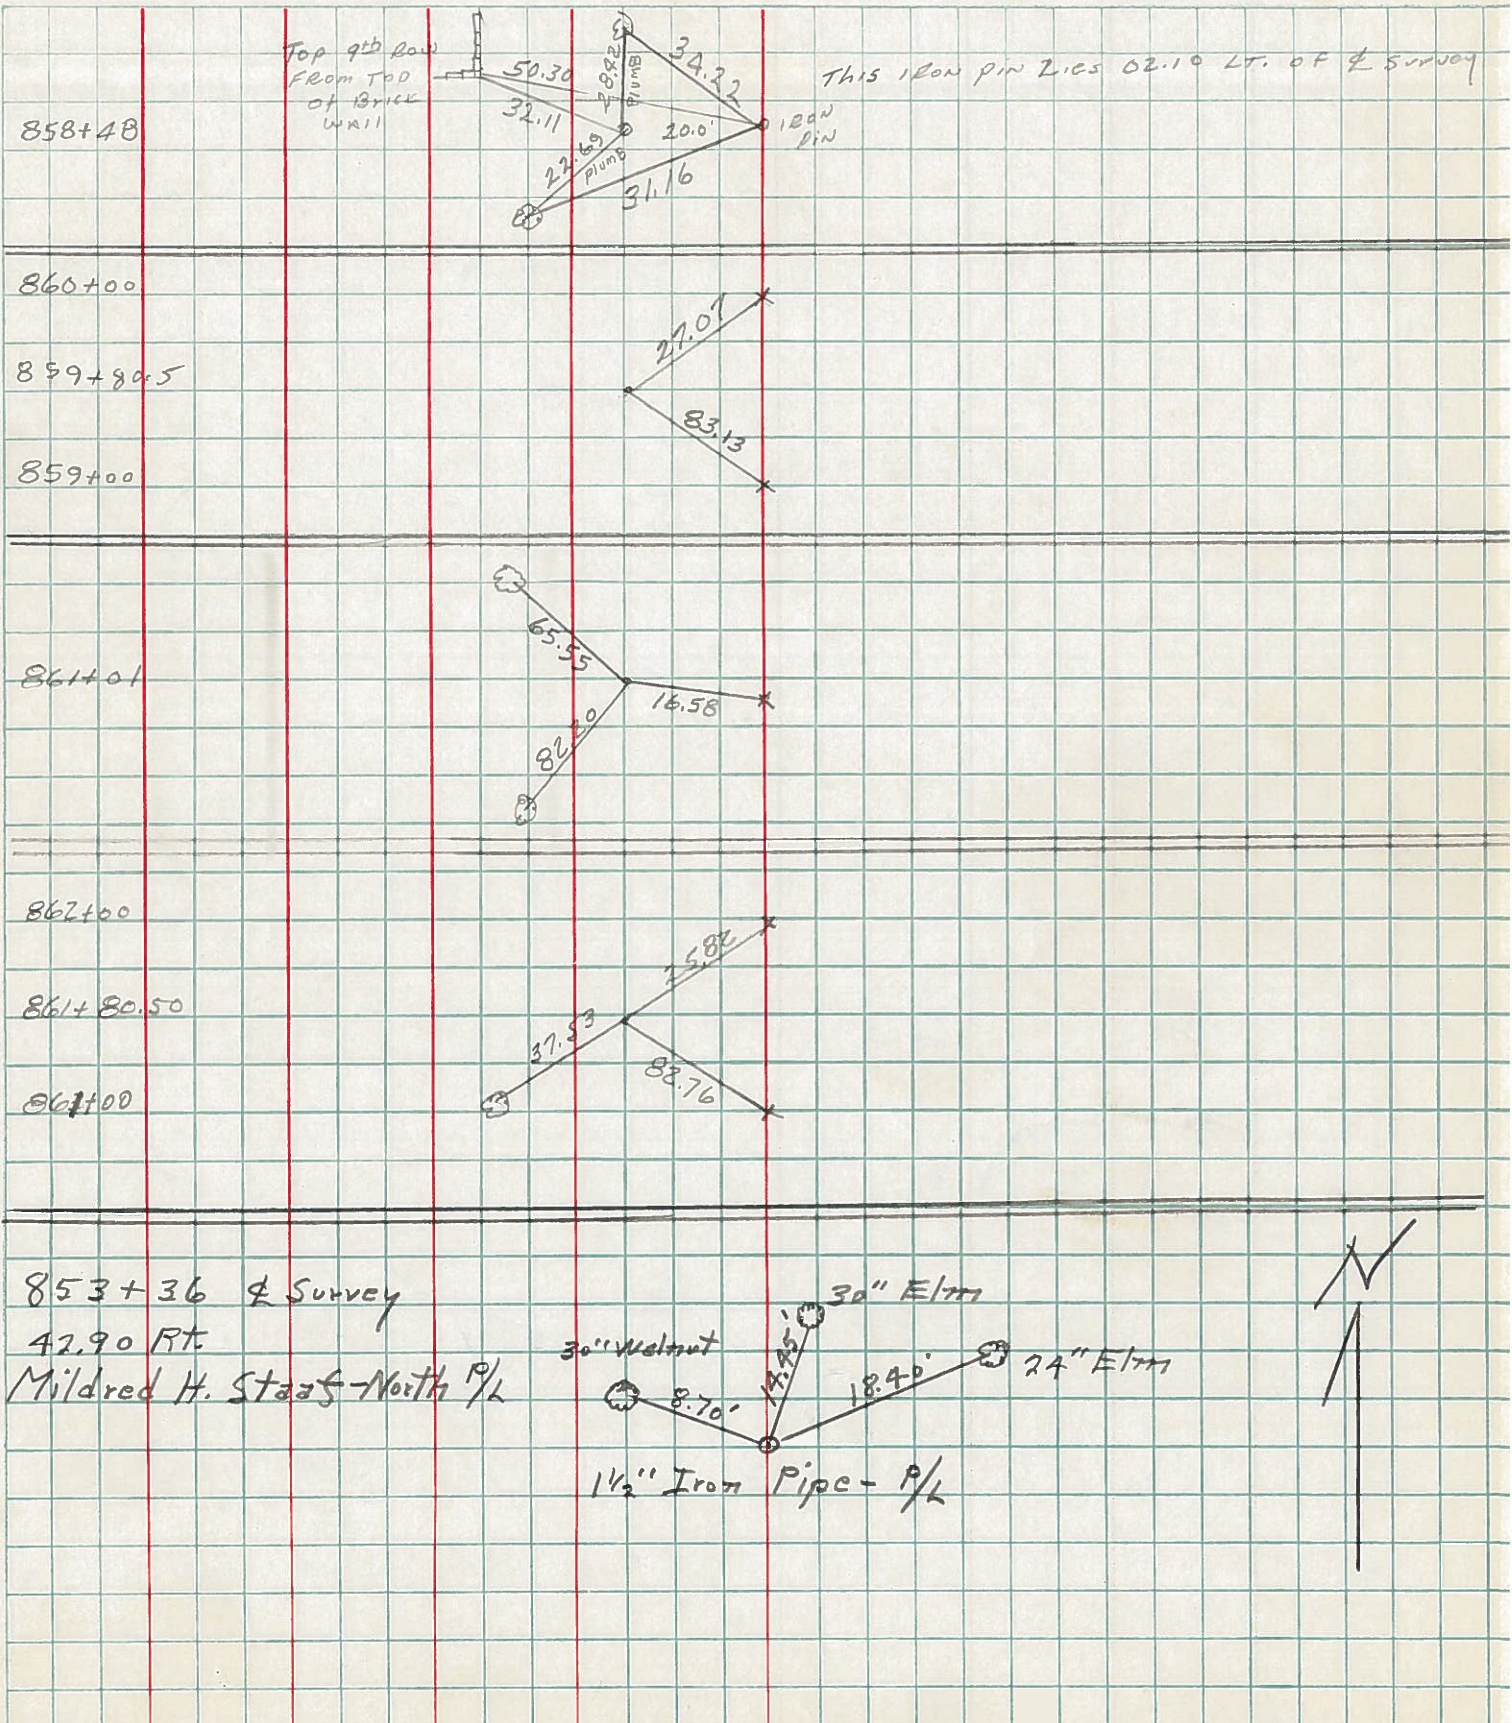

PERSONNEL TITLE PERSONNEL TITLE

COUNTY OTTAWA

DATE FEB. 21, 1958

SWORNEN

HOLCOMBE

SAGE

AULT

S. R. # 53

WEATHER Cloudy & Windy

SEC. _____

TEMP. +34°

DESCRIPTION

LEFT

CENTER LINE

RIGHT

JOB NO. _____

