


O.D.O.T. DISTRICT 2 SURVEY OFFICE (USE ONLY)

PERSONNEL \_\_\_\_\_ REFERENCE NO. 70 SHEET 28 OF 34  
 NOTES AUBLE DATE 8/26/22 ROUTE SR 53  
 H.C. NIESE WEATHER CLOUDY COUNTY OTTAWA  
 R.C. RHOADES TEMP. 72° TOWNSHIP CATAWBA  
 DWG BY RHOADES PID 102905 SECTION 4-26  
 CONNECTICUT WESTERN RESERVE


TYPE MONUMENT MAG/WASHER  
 ON SURFACE - ~~BELOW~~ ON  
 OFFSET Q PAVEMENT 5.2' ~~LF~~ : RT  
7.7' TO RT EDGE PAVEMENT  
 STATION: 926+10.78

NOTE:  
THIS MAP IS FOR ODOT PURPOSES ONLY.  
TO INDEX REFERENCE TIES, AND DOES NOT  
REPRESENT TRUE LAND SUBDIVISION.

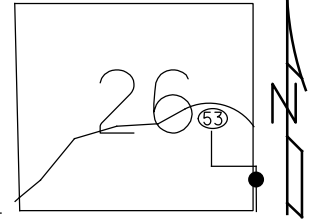

HORZ. DATUM: NAD83 2011 GEOID: NAVD88 2018  
 GRID: NORTHING: 699037.815 EASTING: 1877485.828

RECORD: P.I.  
 STA. 583+00.00  
 FD P.K./WASHER  
 6/14/95  
 SET P.K./WASHER  
 5/22/96, CL  
 FD P.K.NAIL  
 REF70  
 9/1/11, DCH  
 SET MAG/WASHER  
 NEWREF70  
 8/7/12, DCH  
 FD MAG/WASHER  
 REF70  
 3/8/21, JFO  
 SET MAG/WASHER  
 5/16/23, TDN

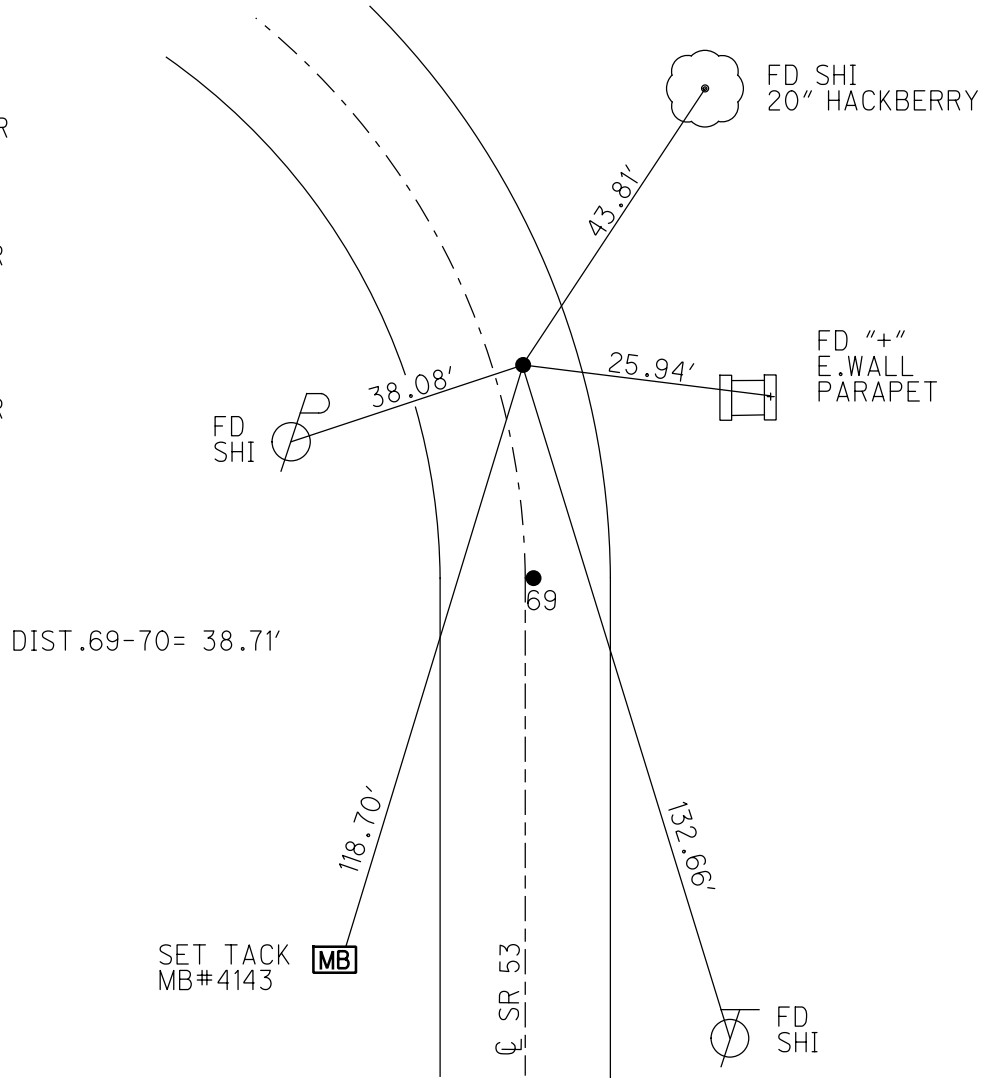


O.D.O.T. DISTRICT 2 SURVEY OFFICE (USE ONLY)


PERSONNEL	REFERENCE NO.	<u>70</u>	SHEET	<u>31</u>	OF	<u>36</u>
NOTES	HOMAN	DATE	<u>9/1/11</u>	ROUTE	<u>SR 53</u>	
H.C.	ROUSOS	WEATHER	<u>SUNNY</u>	COUNTY	<u>OTTAWA</u>	
R.C.	HARBAUGH	TEMP.	<u>85°</u>	TOWNSHIP	<u>CATAWBA ISL</u>	
				SECTION	<u>4-26</u>	

TYPE MONUMENT P.K.NAIL  
 ON SURFACE - ~~BELOW~~ ON  
~~LEFT~~ - CL PAV'T - RIGHT 5.2'  
7.7' TO RT EDGE PAVEMENT  
 S.L.M. 926+34.98  
 GRID: NORTHING: 699037.877 EASTING: 1877485.731

NOTE:  
THIS MAP IS FOR ODOT PURPOSES ONLY  
TO INDEX REFERENCE TIES, AND DOES NOT  
REPRESENT TRUE LAND SUBDIVISION.

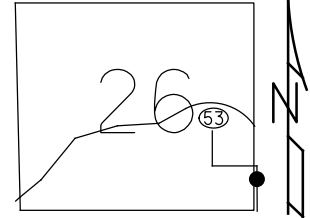

RECORD: P.I.  
 STA. 583+00.00  
 FD P.K./WASHER  
 6/14/95  
 SET P.K./WASHER  
 5/22/96, CL  
 FD P.K.NAIL  
 GPS, REF70  
 SET MAG/WASHER  
 GPS, NEWREF70  
 8/7/12, DCH

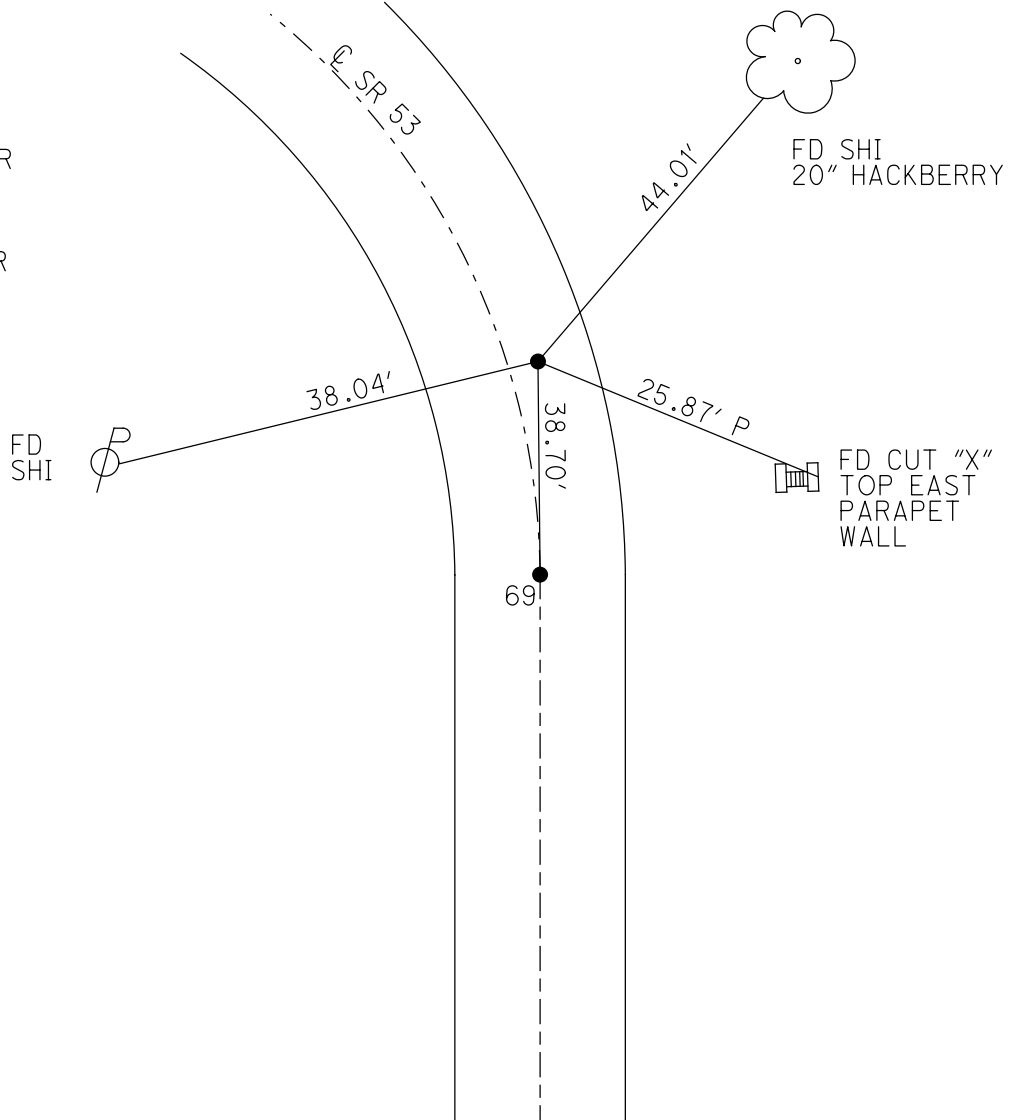

# O.D.O.T. DISTRICT 2 SURVEY OFFICE

PERSONNEL

REFERENCE NO. 69 & 70

SHEET 25 OF 30

NOTES VAN DUSEN

H.C. Huss

R.C. Rousos

DATE 6-14-95

WEATHER FAIR

TEMP. +72

ROUTE S.R. 53

COUNTY OTTAWA

TOWNSHIP CATAWBA

SECTION \_\_\_\_\_

T \_\_\_\_\_ R \_\_\_\_\_

Ref # 70 - P.I.

Reset Both.  
5-22-96



TYPE MONUMENT P.K. & WASHER

ON SURFACE - BELOW Yes

~~LEFT~~ - Q PAV'T. - RIGHT 5.2' Rt

7.7 TO Rt EDGE PAVEMENT

S.L.M. 926+63

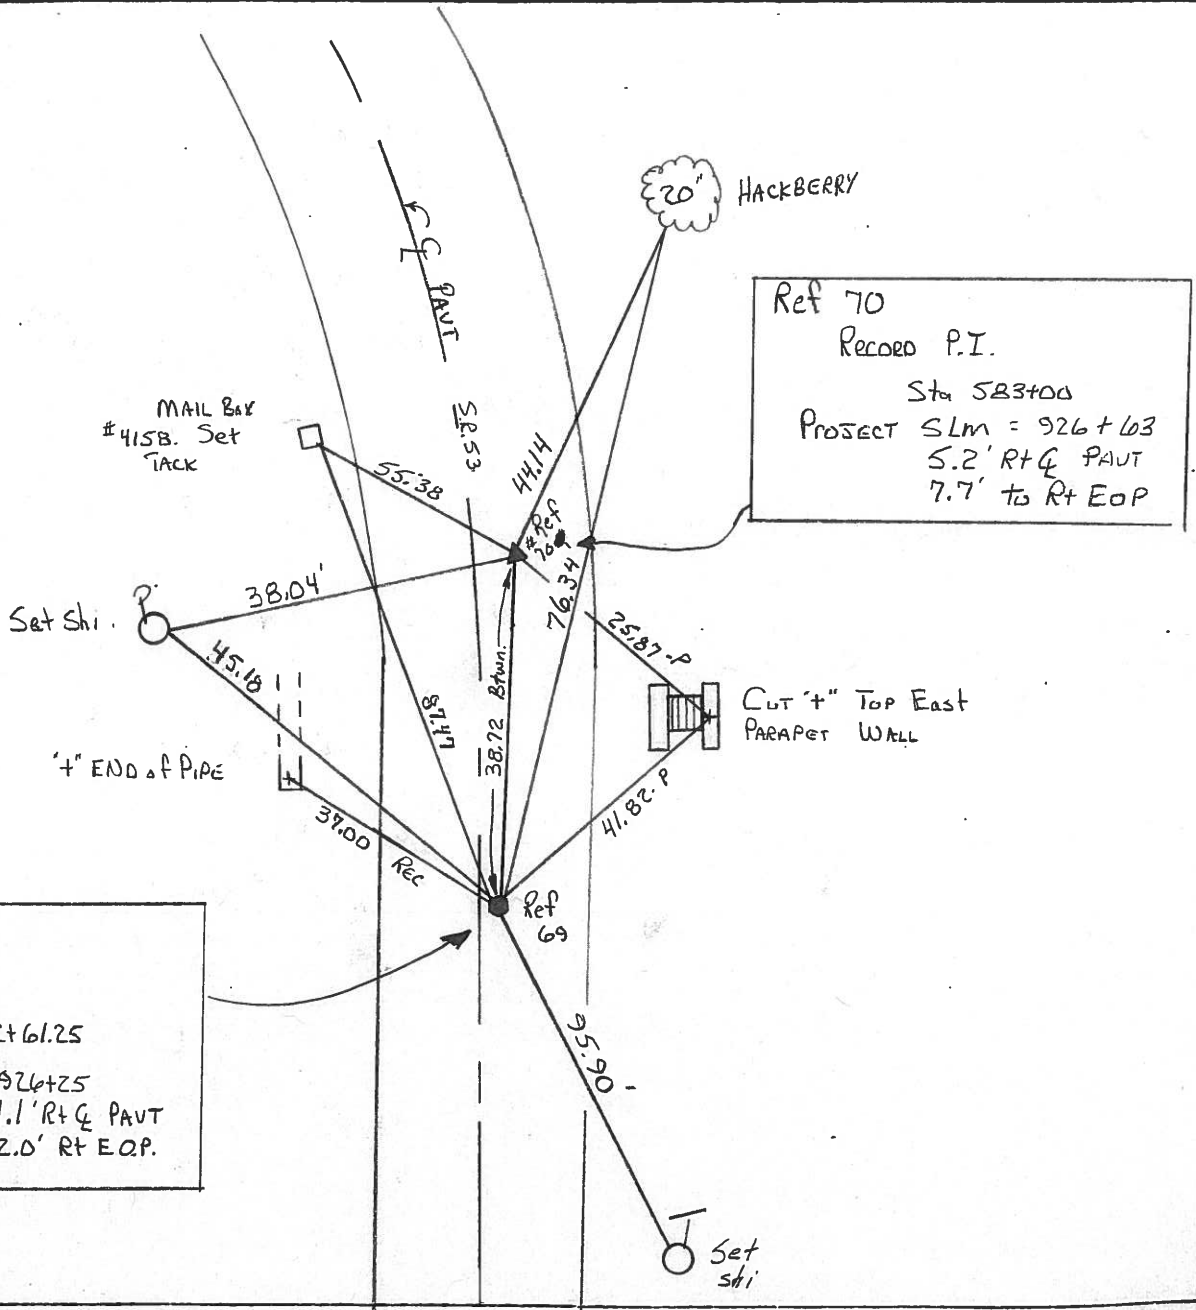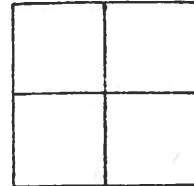

Ref 70  
Record P.I.  
Sta 523+00  
Project SLM = 926+63  
5.2' RT & PAVT  
7.7' to Rt EOP

Ref 69.  
Record P.C.  
Sta 852+61.25  
Project SLM = 926+25  
1.1' RT & PAVT  
12.0' RT EOP.

Q.D.O.T. DISTRICT 2 SURVEY OFFICE

SHEET \_\_\_\_\_ OF \_\_\_\_\_

County Ottawa S.R. #53

Date 8/29/84

Township Catawba


Weather overcast - windy

Section \_\_\_\_\_

Temp. 66°

T N, R E

Personnel Cronin

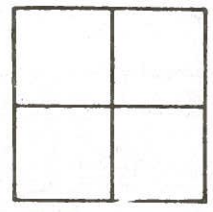

Ripple


PT 70

Geyman

Barbour



P. I. Sur.  
853+00  
set P.K. & washer atop  
R.R. spike - 5 ft & Paint

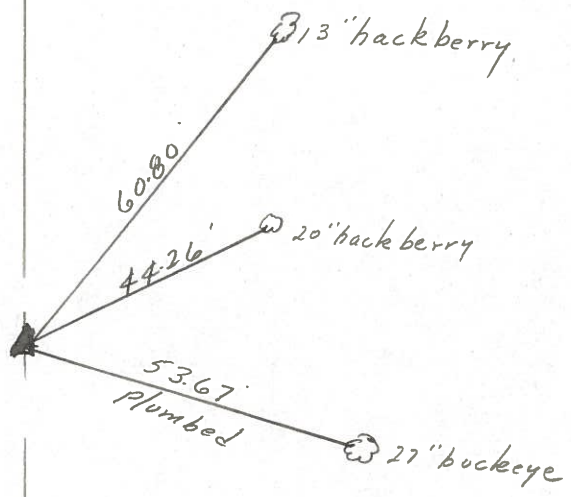


S.R. #53

PERSONNEL	TITLE	PERSONNEL	TITLE
COUNTY <u>Ottawa</u>		DATE <u>6-4-71</u>	
S. R. <u>53</u>		WEATHER <u>Hot</u>	
SEC. _____		TEMP. <u>80°</u>	
DESCRIPTION <u>S.R. # 163 North</u>		JOB NO. _____	
	LEFT	CENTER LINE	RIGHT

3/12/84  
Overcast  
3.0° windy


P.I. SUR  
853+00  
R.R. spk

70

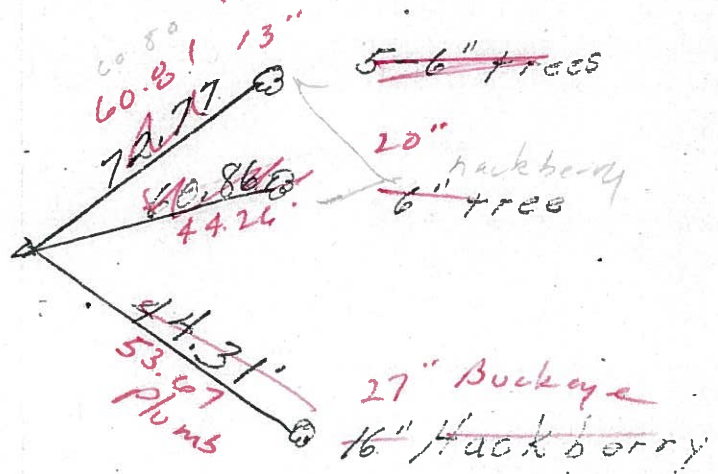

P.C.  
852+61.25  
R.R. spk


69

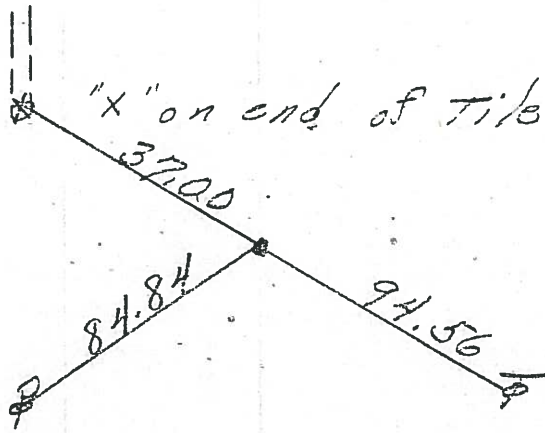

P.I. SUR  
Tang R/W  
845+46.35  
R.R. spk.

1' RT. & PV


68

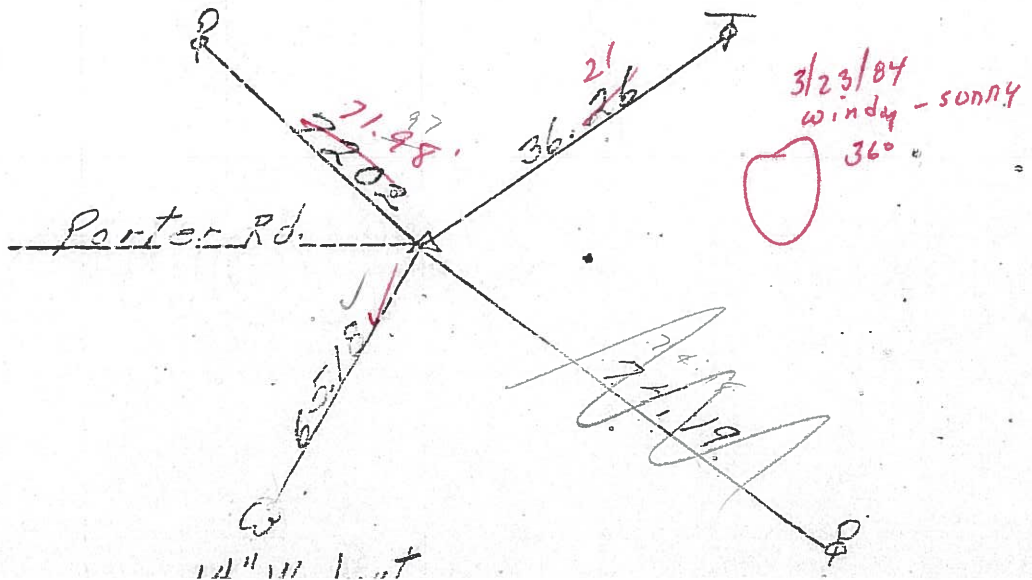

PERSONNEL	TITLE	PERSONNEL	TITLE	COUNTY	DATE
				<u>Ottawa</u>	<u>6-4-71</u>
				S. R. <u>53</u>	WEATHER <u>Hot</u>
				SEC. _____	TEMP. <u>80°</u>
DESCRIPTION	<u>S.R. # 163</u>	<u>North</u>			JOB NO. _____
	LEFT	CENTER LINE	RIGHT		


P.I.  
853+00

70

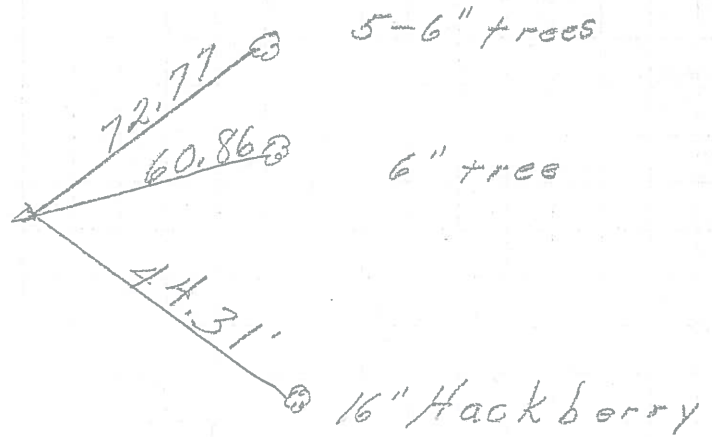


P.C.  
852+61.25  
R.R. spk.

69

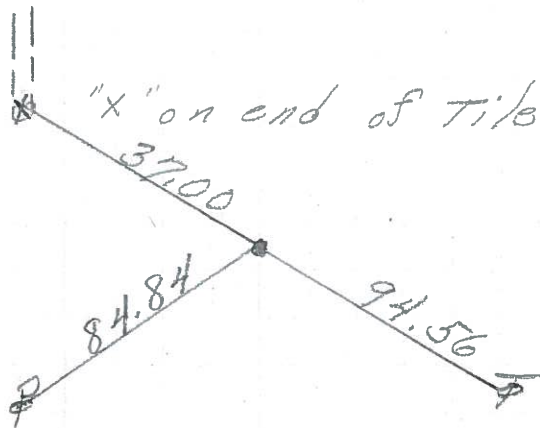

845+46.35  
R.R. spk.

68

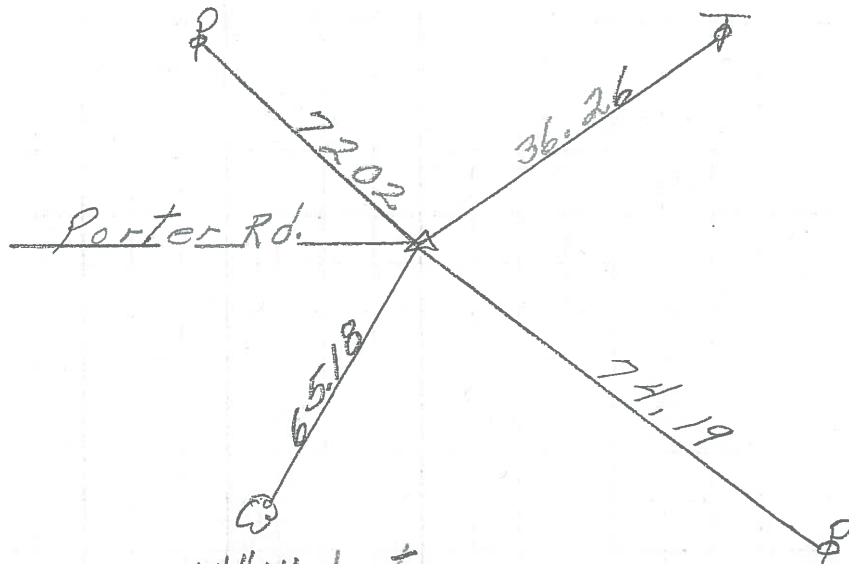

PERSONNEL	TITLE	PERSONNEL	TITLE	COUNTY	DATE
Schneider		Potts		Ottawa	8-17-68
Mosser				S. R.	53
Barbour				WEATHER	Hot
Redding				SEC.	S.R.#163 North
				TEMP.	90°
DESCRIPTION	Ties for Control Points				JOB NO.
	LEFT	CENTER LINE	RIGHT		

