



O.D.O.T. DISTRICT 2 SURVEY OFFICE (USE ONLY)

PERSONNEL _____ REFERENCE NO. 70 A SHEET 29 OF 34
 NOTES AUBLE DATE 8/26/22 ROUTE SR 53
 H.C. NIESE WEATHER CLOUDY COUNTY OTTAWA
 R.C. RHOADES TEMP. 72° TOWNSHIP CATAWBA
 DWG BY RHOADES PID 102905 SECTION 4-26
 CONNECTICUT WESTERN RESERVE

TYPE MONUMENT MAG/WASHER
 ON SURFACE - ~~BELOW~~ ON
 OFFSET Q PAVEMENT 14.6' ~~±~~ : RT
1.5' TO RT EDGE PAVEMENT
 STATION: 927+71.1

HORZ.DATUM: NAD83 2011 GEOID: NAVD88 2018
 GRID: NORTHING: 699186.598 EASTING: 1877417.720

NOTE:
THIS MAP IS FOR ODOT PURPOSES ONLY
TO INDEX REFERENCE TIES, AND DOES NOT
REPRESENT TRUE LAND SUBDIVISION.

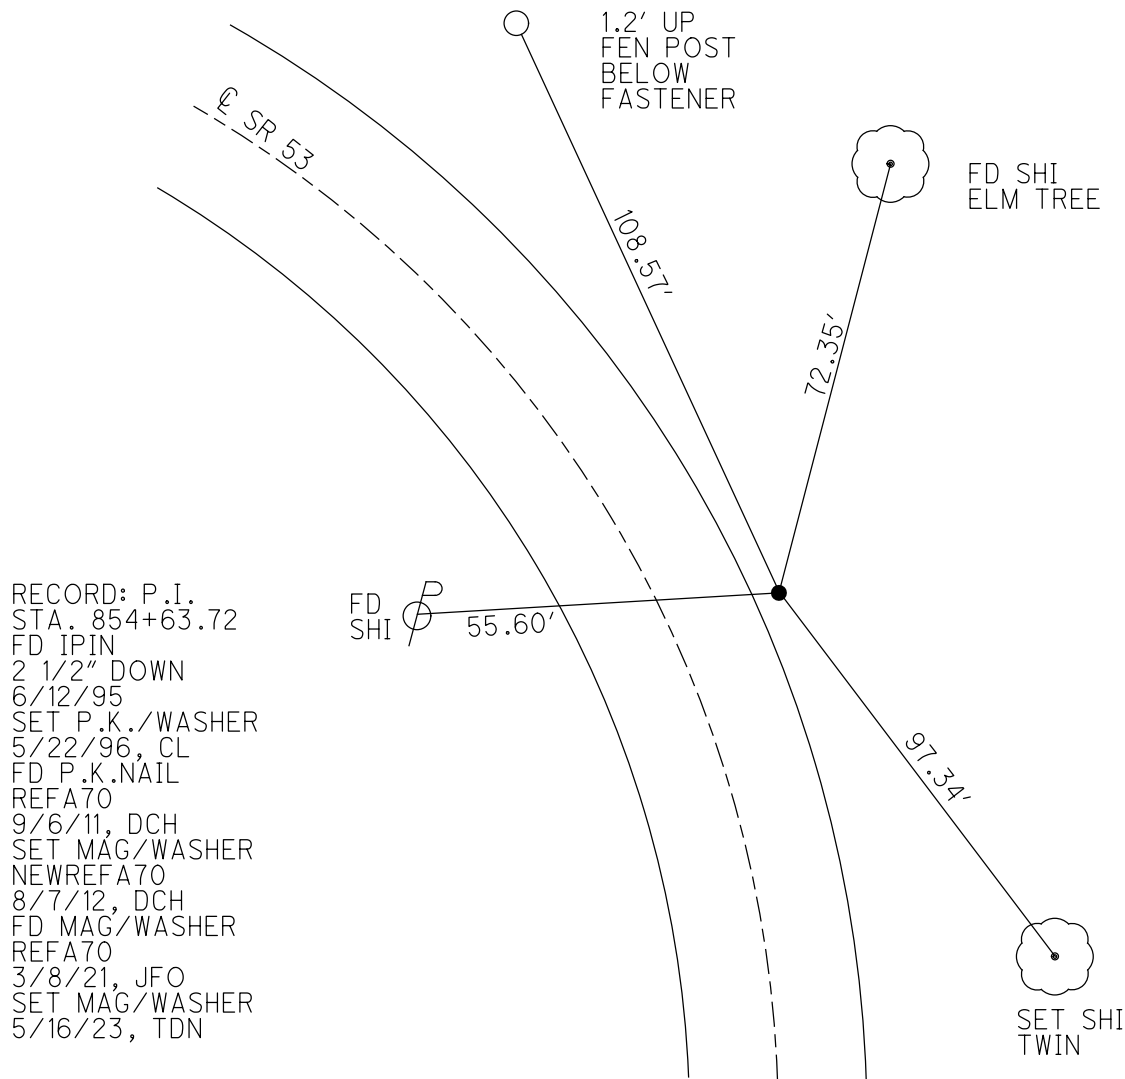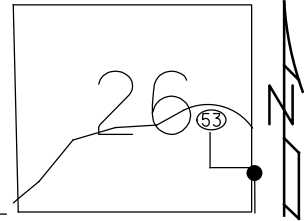



RECORD: P.I.
 STA. 854+63.72
 FD IPIN
 2 1/2" DOWN
 6/12/95
 SET P.K./WASHER
 5/22/96, CL
 FD P.K.NAIL
 REFA70
 9/6/11, DCH
 SET MAG/WASHER
 NEWREFA70
 8/7/12, DCH
 FD MAG/WASHER
 REFA70
 3/8/21, JFO
 SET MAG/WASHER
 5/16/23, TDN

O.D.O.T. DISTRICT 2 SURVEY OFFICE (USE ONLY)

PERSONNEL _____ REFERENCE NO. 70 A SHEET 32 OF 36
 NOTES ROUSOS DATE 9/6/11 ROUTE SR 53
 H.C. ROUSOS WEATHER CLOUDY COUNTY OTTAWA
 R.C. HOMAN TEMP. 65° TOWNSHIP CATAWBA ISL
 _____ SECTION 4-26

TYPE MONUMENT P.K.NAIL
 ON SURFACE - ~~BELOW~~ ON
~~LEFT~~ - CL PAV'T - RIGHT 14.6'
1.5' RT TO RT EDGE PAVEMENT
 S.L.M. 927+98.59
 GRID: NORTHING: 699186.592 EASTING: 1877417.525

NOTE:
 THIS MAP IS FOR ODOT PURPOSES ONLY
 TO INDEX REFERENCE TIES, AND DOES NOT
 REPRESENT TRUE LAND SUBDIVISION.

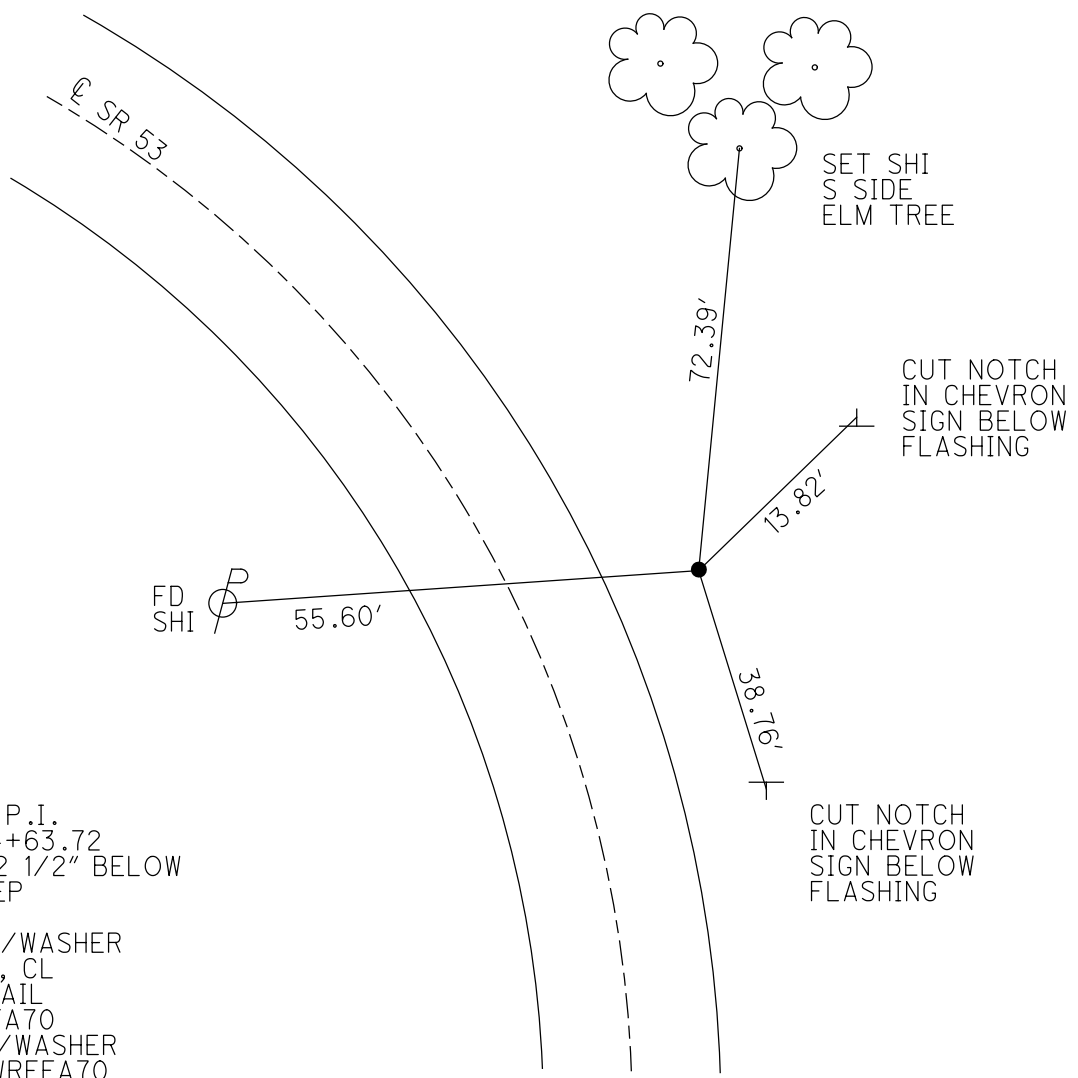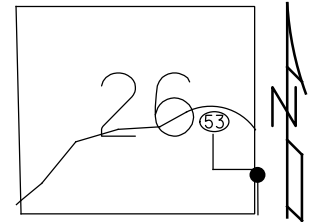

RECORD: P.I.
 STA. 854+63.72
 FD IPIN 2 1/2" BELOW
 1.5' RT/EP
 6/12/95
 SET P.K./WASHER
 5/22/96, CL
 FD P.K.NAIL
 GPS, REFA70
 SET MAG/WASHER
 GPS, NEWREFA70
 8/7/12, DCH

O.D.O.T. DISTRICT 2 SURVEY OFFICE

PERSONNEL _____

REFERENCE NO. 70 A

SHEET 26 OF 30

NOTES Loehrke

H.C. Centerbury

R.C. Rousos

DATE 6-12-95

WEATHER FAIR

TEMP. +62 F

ROUTE SR 53

COUNTY OTTAWA

TOWNSHIP Catawba

SECTION _____

T _____ R _____

Set P.K. / WASHER

5-22-96


TYPE MONUMENT I. Pin

~~ON SURFACE~~ - BELOW ± 2 1/2"

~~LEFT - C. PAV'T.~~ - RIGHT 14.6' RT ±

1.5 TO RT EDGE PAVEMENT

S.L.M. 928+25

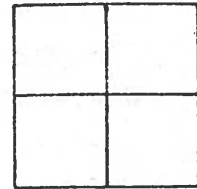


Record

PI SURVEY

854+63.72

I PEN 1.5' RT RT EP

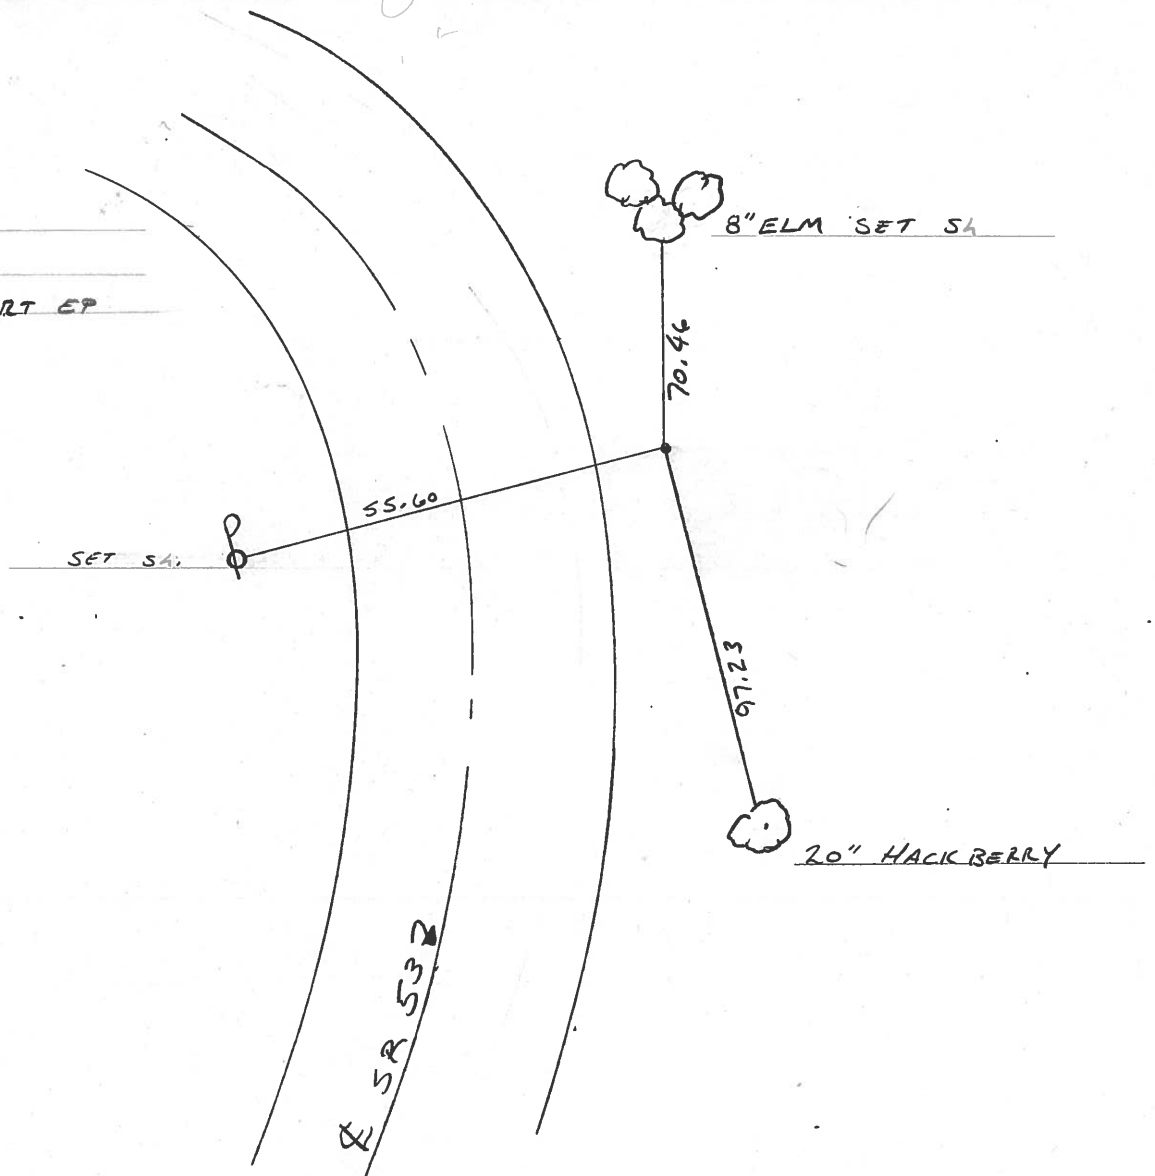

Q.D.O.T. DISTRICT 2 SURVEY OFFICE

SHEET _____ OF _____

County Ottawa S.R. #53

Date 8/29/84

Township Catawba


Weather overcast - windy

Section _____

Temp. 68°

T N, R E

Personnel Cronin

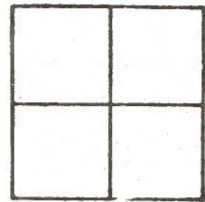


PT 70 A

Ripple

Geyman

Barbour

P.F. SURVEY
854 + 63.72
set P.K. Washer atop
E. Pin - 1.5' Rt. R/E.P.

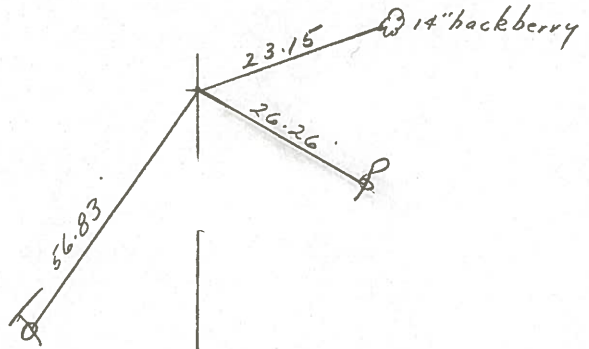

SUR. S.R. #53