


O.D.O.T. DISTRICT 2 SURVEY OFFICE (USE ONLY)


PERSONNEL _____ REFERENCE NO. 71 SHEET 30 OF 34
 NOTES O'DONNELL DATE 3/8/21 ROUTE SR 53
 H.C. O'DONNELL WEATHER WINDY COUNTY OTTAWA
 R.C. NIESE TEMP. 72° TOWNSHIP CATAWBA
 DWG BY RHOADES PID 102905 SECTION 4-26
 CONNECTICUT WESTERN RESERVE

TYPE MONUMENT 1' IPIN
~~ON SURFACE~~ - BELOW 3"
 OFFSET \odot PAVEMENT 26' \pm : RT
13.6' RT TO RT EDGE PAVEMENT
 STATION: 928+66.3

NOTE:
THIS MAP IS FOR ODOT PURPOSES ONLY
TO INDEX REFERENCE TIES, AND DOES NOT
REPRESENT TRUE LAND SUBDIVISION.

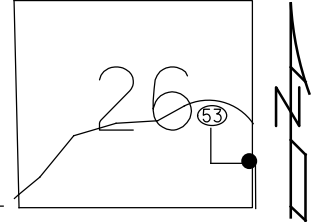

HORIZ. DATUM: NAD83 2011 GEOID: NAVD88 2018
 GRID: NORTHING: 699252.471 EASTING: 1877336.938

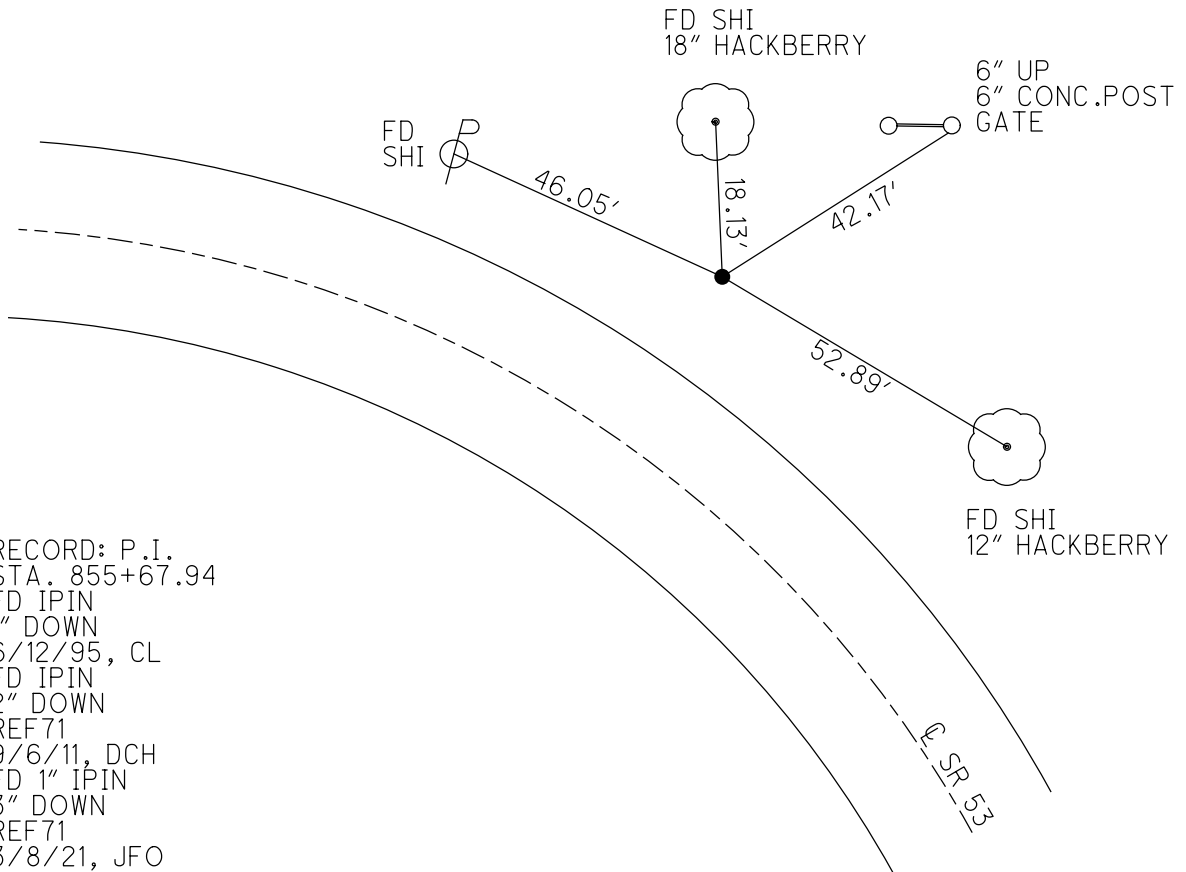



RECORD: P.I.
 STA. 855+67.94
 FD IPIN
 1" DOWN
 6/12/95, CL
 FD IPIN
 2" DOWN
 REF71
 9/6/11, DCH
 FD 1" IPIN
 3" DOWN
 REF71
 3/8/21, JFO

O.D.O.T. DISTRICT 2 SURVEY OFFICE (USE ONLY)

PERSONNEL _____ REFERENCE NO. 71 SHEET 33 OF 36
 NOTES HOMAN DATE 9/6/11 ROUTE SR 53
 H.C. ROUSOS WEATHER CLOUDY COUNTY OTTAWA
 R.C. HOMAN TEMP. 65° TOWNSHIP CATAWBA ISL
 _____ SECTION 4-26

TYPE MONUMENT IPIN
~~ON SURFACE~~ - BELOW 1"
~~LEFT~~ - CL PAV'T - RIGHT 26'
13.6' RT TO RT EDGE PAVEMENT
 S.L.M. 929+02.82
 GRID: NORTHING: 699252.375 EASTING: 1877336.678

NOTE:
THIS MAP IS FOR ODOT PURPOSES ONLY.
TO INDEX REFERENCE TIES, AND DOES NOT
REPRESENT TRUE LAND SUBDIVISION.

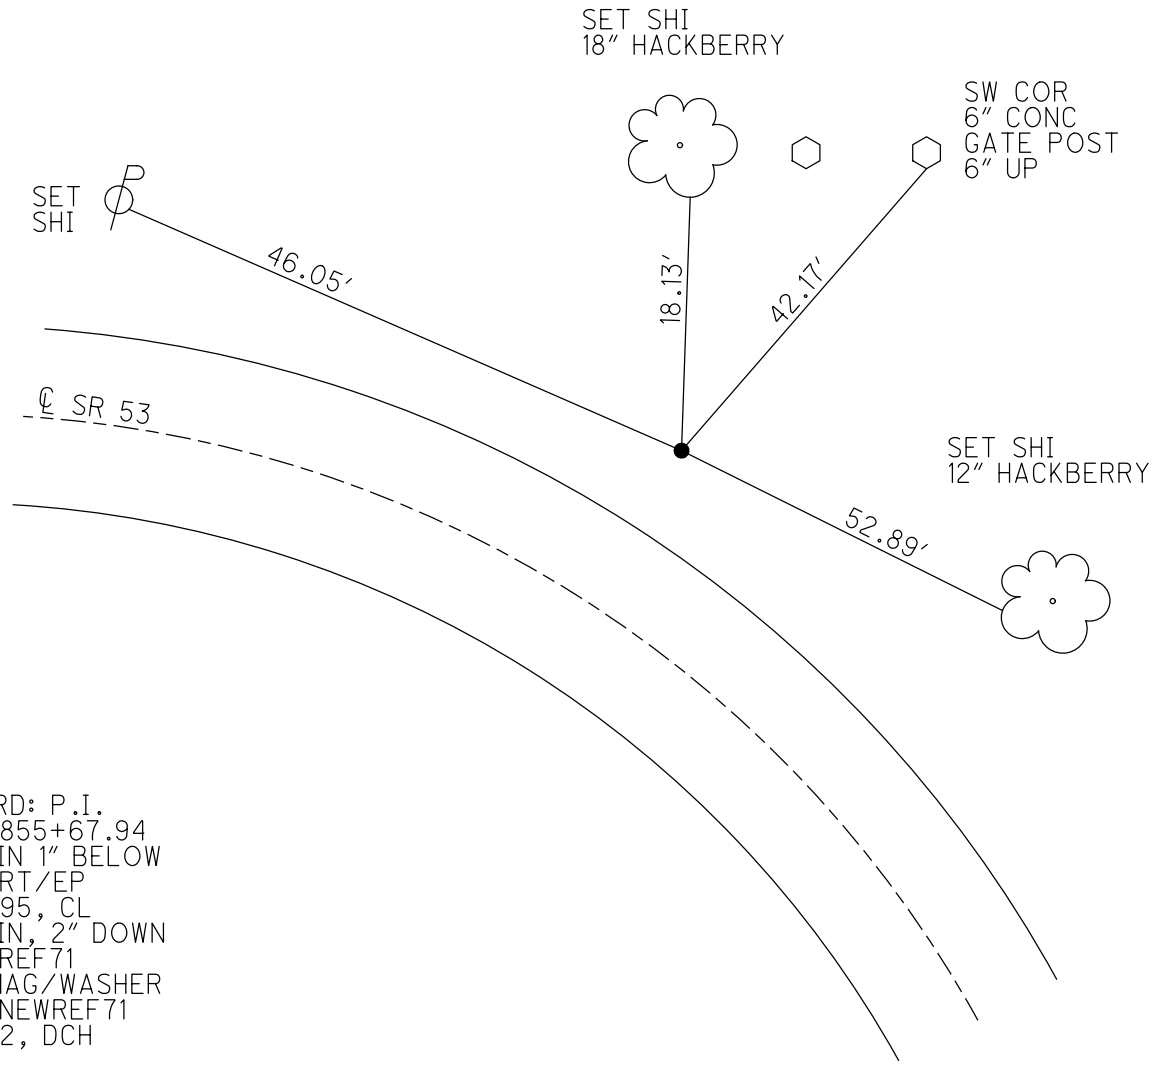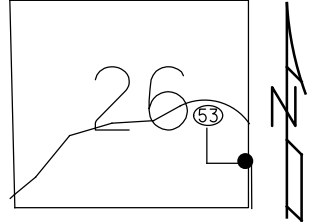

RECORD: P.I.
 STA. 855+67.94
 FD IPIN 1" BELOW
 13.6' RT/EP
 6/12/95, CL
 FD IPIN, 2" DOWN
 GPS, REF71
 SET MAG/WASHER
 GPS, NEWREF71
 8/8/12, DCH

O.D.O.T. DISTRICT 2 SURVEY OFFICE

PERSONNEL _____

REFERENCE NO. 71

SHEET 27 OF 30

NOTES VAN Pused

H.C. Rousos

R.C. Huss

DATE 6-14-95

WEATHER Fair

TEMP. 72° F

ROUTE SR53

COUNTY OTTAWA

TOWNSHIP CATAWBA

SECTION _____

T _____ R _____



TYPE MONUMENT Iron Pin

~~ON SURFACE~~ - BELOW 1" Down

~~LEFT - C. PAVT.~~ - RIGHT 26' Rt.

13.6 TO Rt EDGE PAVEMENT

S.L.M. 929+17

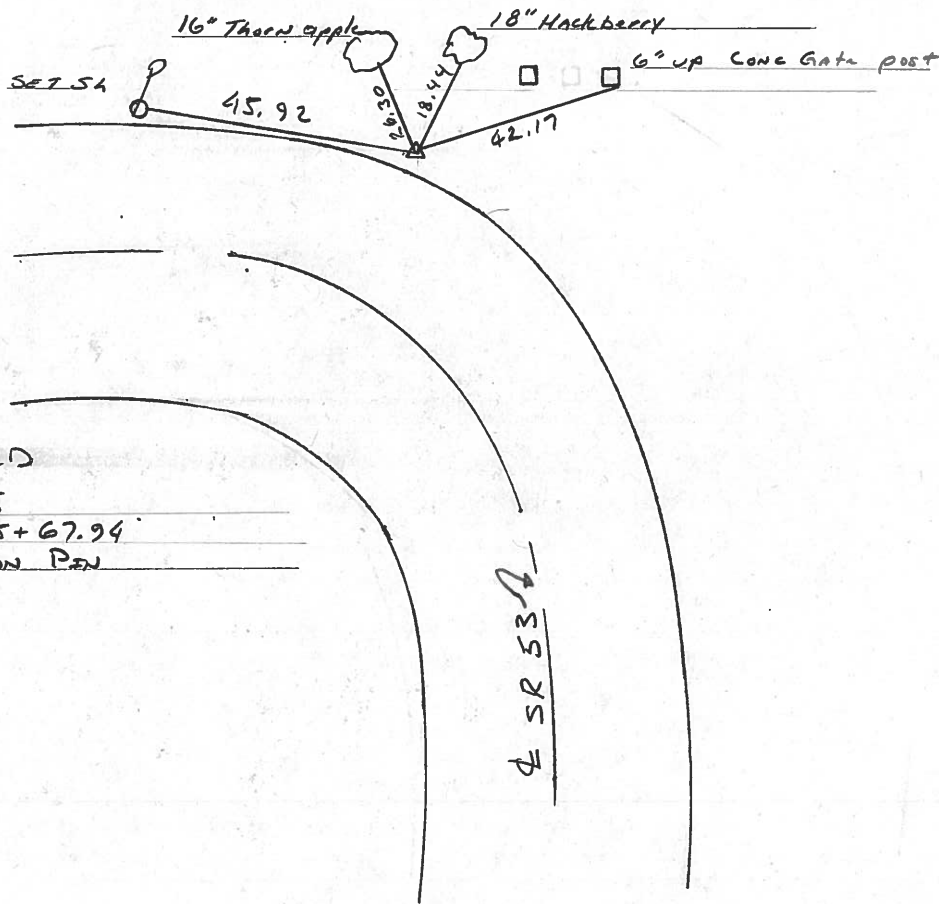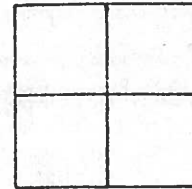

Record

P.I.

855+67.94

IRON PIN

ODOT. DISTRICT 2 SURVEY OFFICE

SHEET _____ OF _____

County Ottawa S.R. # 53

Date 8/29/84

Township Catawba


Weather overcast - windy

Section _____

Temp. 68°

T N, R E

Personnel Cronin

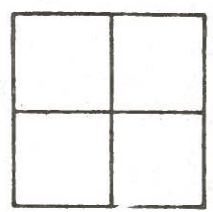

PT 71

Ripple

Geyman


Barbour

P.I. Sur.

855+67.94

Fd. Iron Pin 13.5 ±

Rt.-Rt. E.P.

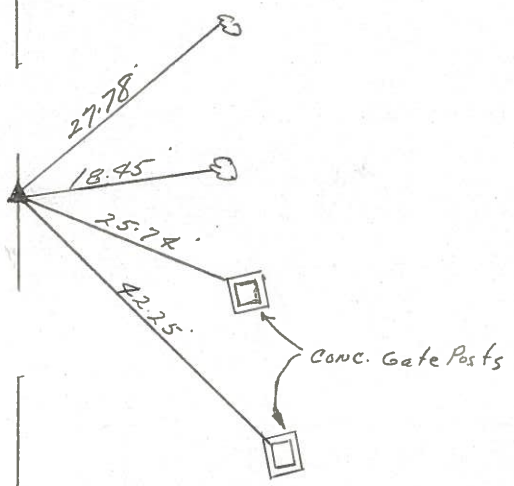


Soc. S.R. #53

PERSONNEL	TITLE	PERSONNEL	TITLE	COUNTY	DATE
				Ottawa	6-7-71
				S. R. 53	WEATHER Hot
				SEC.	TEMP. 85°
DESCRIPTION	S.R. 163 North			JOB NO.	
	LEFT	CENTER LINE	RIGHT		

3/28/84
Sunny - windy
36°

P.I.
864 + 80.83
R. R. spk.

73

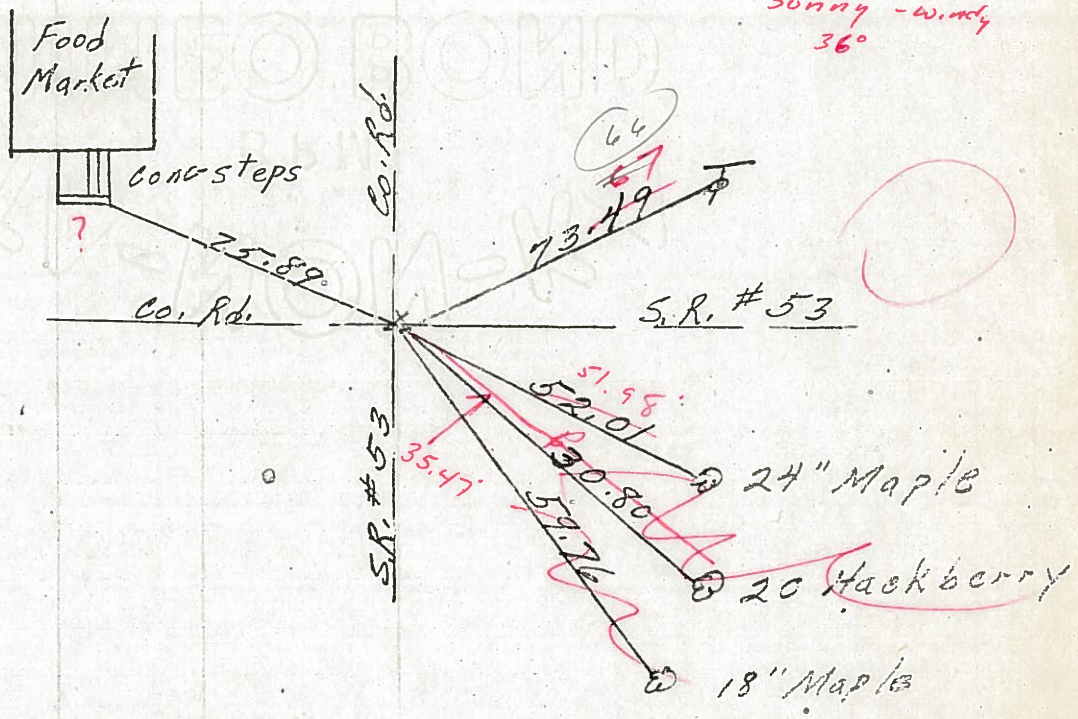


P.I.
8.56 + 66.73 =
856 + 84.53

3/12/84
overcast - windy
20°

1.5' Rt.
Rt. E.P.

72

IPin 53

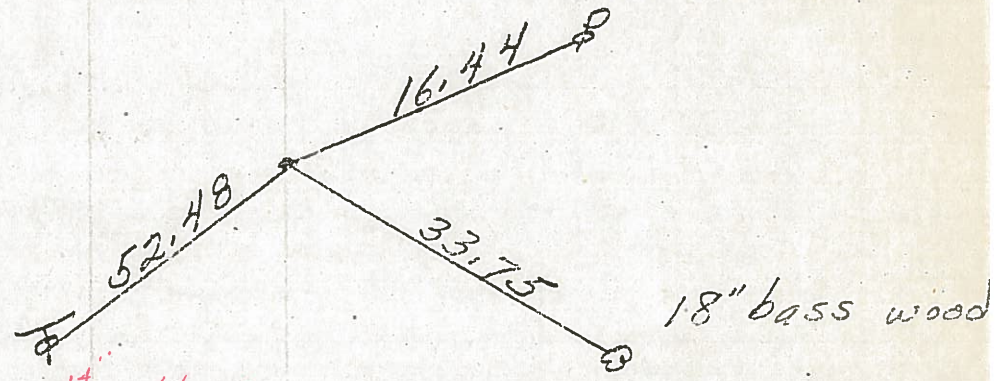


twin
16" thorn apple

P.I. SUR
855 + 67.94
Iron Pin

P.I. SUR
854 + 63.72
71.72
926.3372

IPin

71

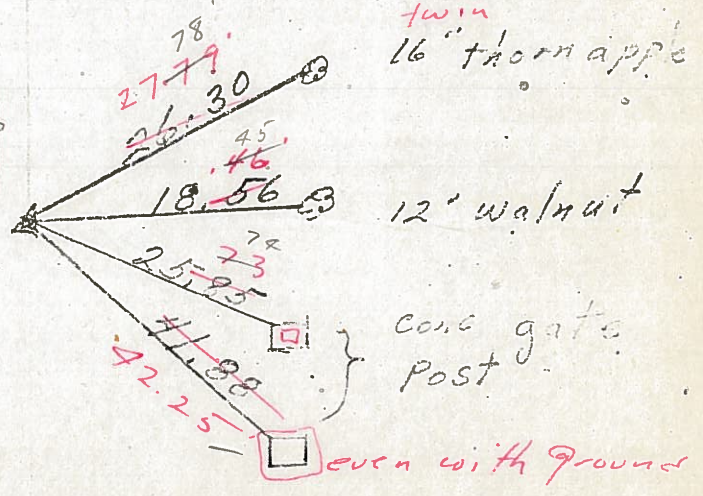

cong gate post

even with ground

PERSONNEL TITLE PERSONNEL TITLE

COUNTY Ottawa DATE 6-7-71

S. R. 53 WEATHER Hot

SEC. _____ TEMP. 80°

DESCRIPTION S.R. 163 North

JOB NO. _____

LEFT

CENTER LINE

RIGHT



conc steps

75.89

Co. Rd.

Co. Rd.

S.R. # 53

73.49

S.R. # 53

52.01

24" Maple

30.80

59.76


20 Hackberry

18" Maple

P.I.
864 + 80.83
R. R. spk.

73

P.I.
856 + 66.73 =
856 + 84.53

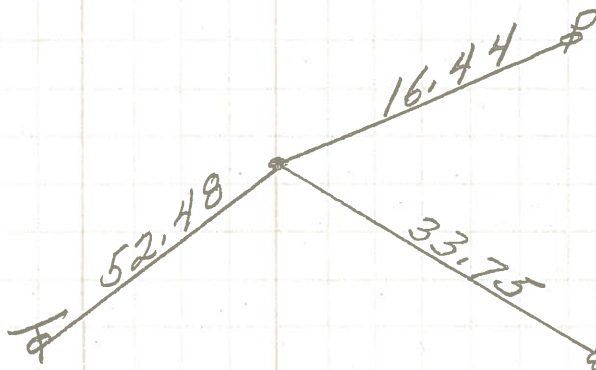

52.48


16.44

33.75

18" bass wood

72

P.I.
855 + 67.94
Iron Pin

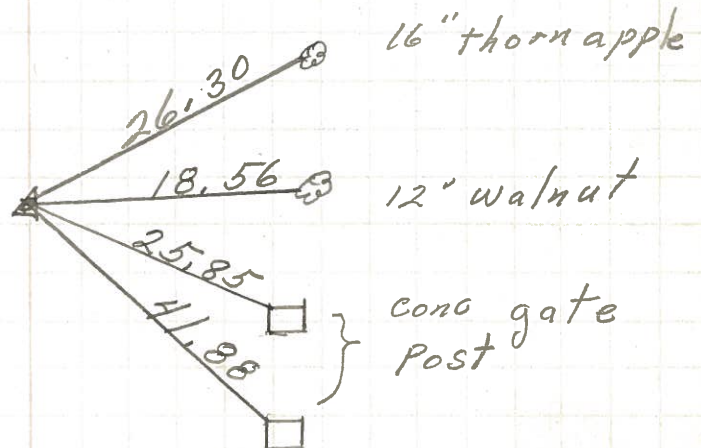

26.30

16" thorn apple

18.56

12" walnut

25.85

41.88

conc gate Post

71