

O.D.O.T. DISTRICT 2 SURVEY OFFICE (USE ONLY)

PERSONNEL

REFERENCE NO. 72

SHEET 31 OF 34

NOTES AUBLE DATE 8/26/22

H.C. NIESE WEATHER CLOUDY

R.C. RHOADES TEMP. 72°

ROUTE SR 53

COUNTY OTTAWA

TOWNSHIP CATAWBA

SECTION 4-26

DWG BY RHOADES PID 102905

CONNECTICUT WESTERN RESERVE

TYPE MONUMENT MAG/WASHER

ON SURFACE - ~~BELOW~~ ON

OFFSET Q PAVEMENT 2.4' ~~±~~ : RT

12.2' TO RT EDGE PAVEMENT

STATION: 929+77.3


HORZ.DATUM: NAD83 2011

GEOID: NAVD88 2018


GRID: NORTHING: 699246.939

EASTING: 1877220.506

NOTE:
THIS MAP IS FOR ODOT PURPOSES ONLY
TO INDEX REFERENCE TIES, AND DOES NOT
REPRESENT TRUE LAND SUBDIVISION.

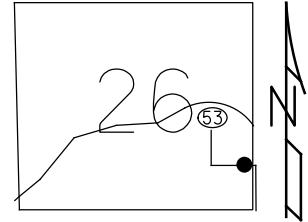

RECORD: P.I.
STA. 856+84.53
FD R.R.SPIKE
1" DOWN
6/12/95
SET P.K./WASHER
5/22/96, TMR
FD P.K.NAIL
REF72
9/6/11, DCH
SET MAG/WASHER
NEWREF72
8/8/12, DCH
FD MAG/WASHER
REF72
3/8/21, JFO
SET MAG/WASHER
5/16/23, TDN

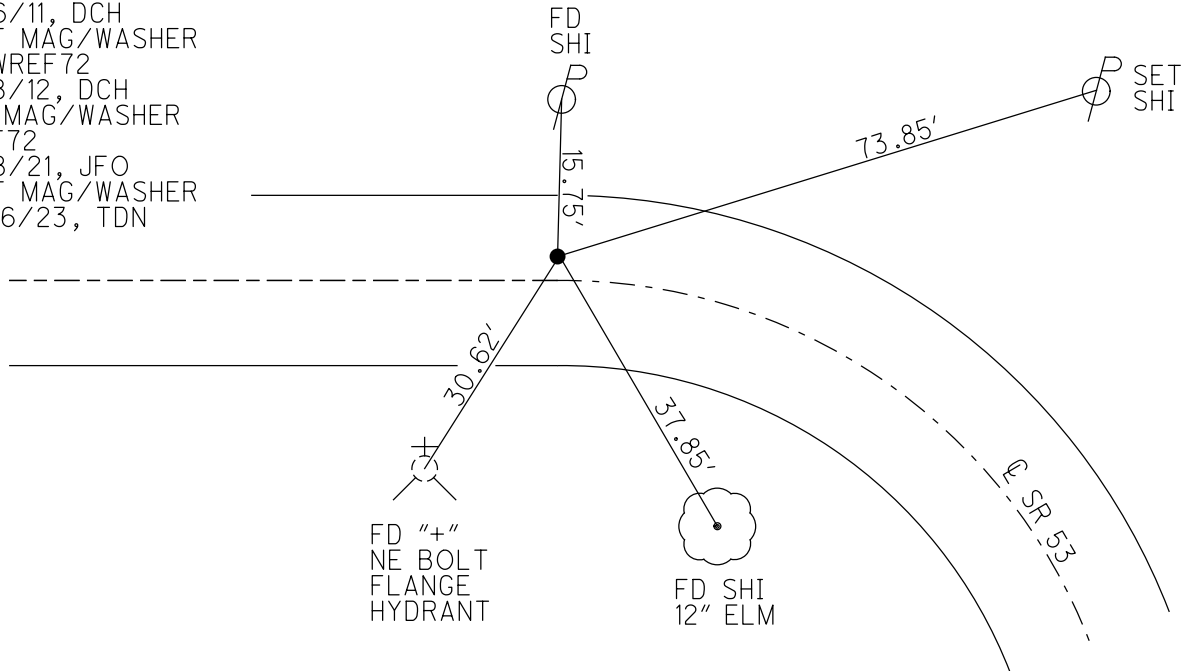


O.D.O.T. DISTRICT 2 SURVEY OFFICE (USE ONLY)


PERSONNEL _____ REFERENCE NO. 72 SHEET 34 OF 36
 NOTES HOMAN DATE 9/6/11 ROUTE SR 53
 H.C. ROUSOS WEATHER CLOUDY COUNTY OTTAWA
 R.C. HOMAN TEMP. 65° TOWNSHIP CATAWBA ISL
 _____ SECTION 4-26

TYPE MONUMENT P.K.NAIL
 ON SURFACE - ~~BELOW~~ ON
~~LEFT~~ - CL PAV'T - RIGHT 1"
12.2' TO RT EDGE PAVEMENT
 S.L.M. 930+19.28
 GRID: NORTHING: 699246.704 EASTING: 1877220.355

NOTE:
THIS MAP IS FOR ODOT PURPOSES ONLY.
TO INDEX REFERENCE TIES, AND DOES NOT
REPRESENT TRUE LAND SUBDIVISION.

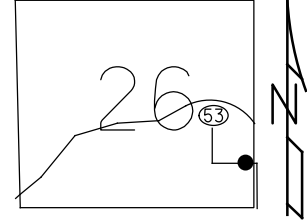

RECORD: P.I.
 STA. 856+84.53
 FD R.R.SPIKE
 1" DOWN
 6/12/95
 SET P.K./WASHER
 5/22/96, TMR
 FD P.K.NAIL
 GPS, REF72
 SET MAG/WASHER
 GPS, NEWREF72
 8/8/12, DCH

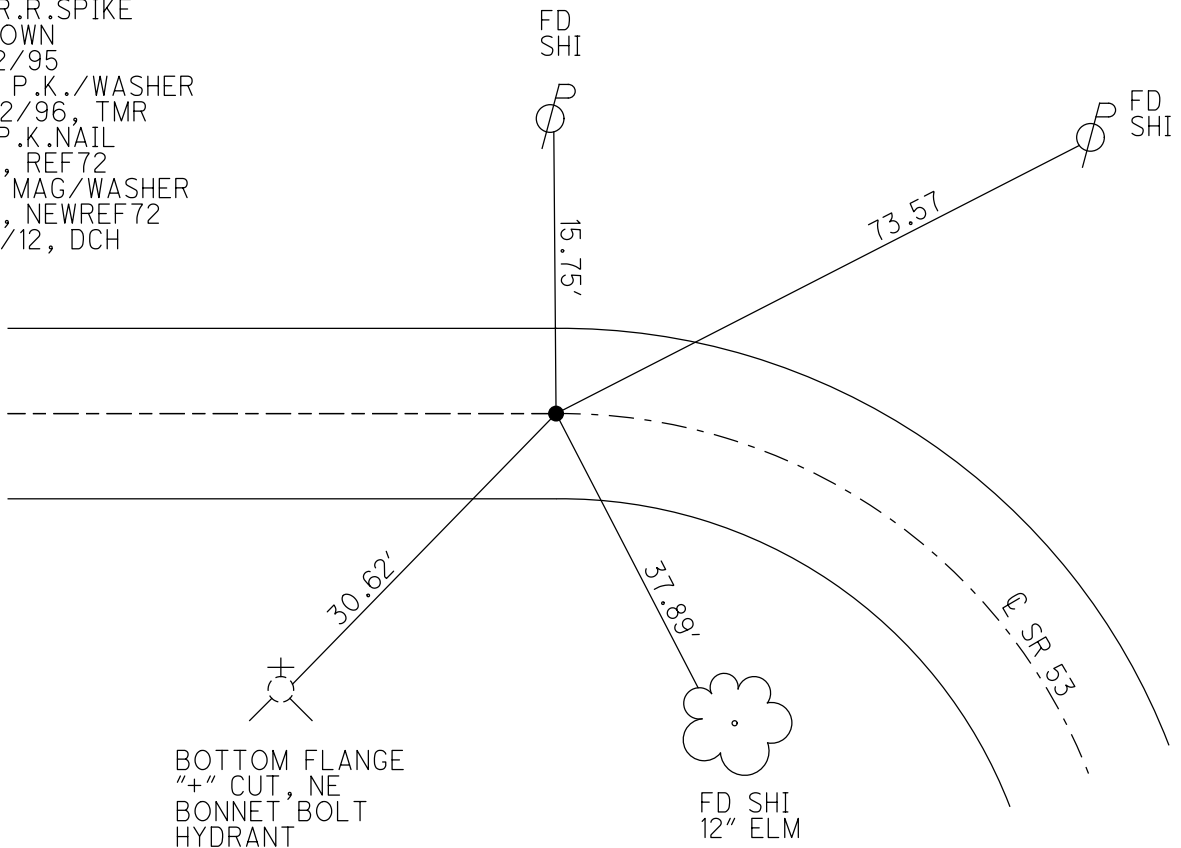

O.D.O.T. DISTRICT 2 SURVEY OFFICE

PERSONNEL _____

REFERENCE NO. 72

SHEET 28 OF 30

NOTES YAN DUSEN

H.C. Rousas

R.C. Huss

DATE 6-12-95

WEATHER Fair

TEMP. 72°

ROUTE SR 53

COUNTY OTTAWA

TOWNSHIP CATAWA

SECTION _____

T _____ R _____

Set PK. / WASHER
5-22-96


TYPE MONUMENT PR SPIKE

ON SURFACE - BELOW 1"

~~LEFT = C. PAV'T.~~ - RIGHT 1' R+

12.2 TO R EDGE PAVEMENT


S.L.M. 930+33

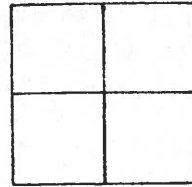

RECORD: PI

856+66.73 =

856+84.53

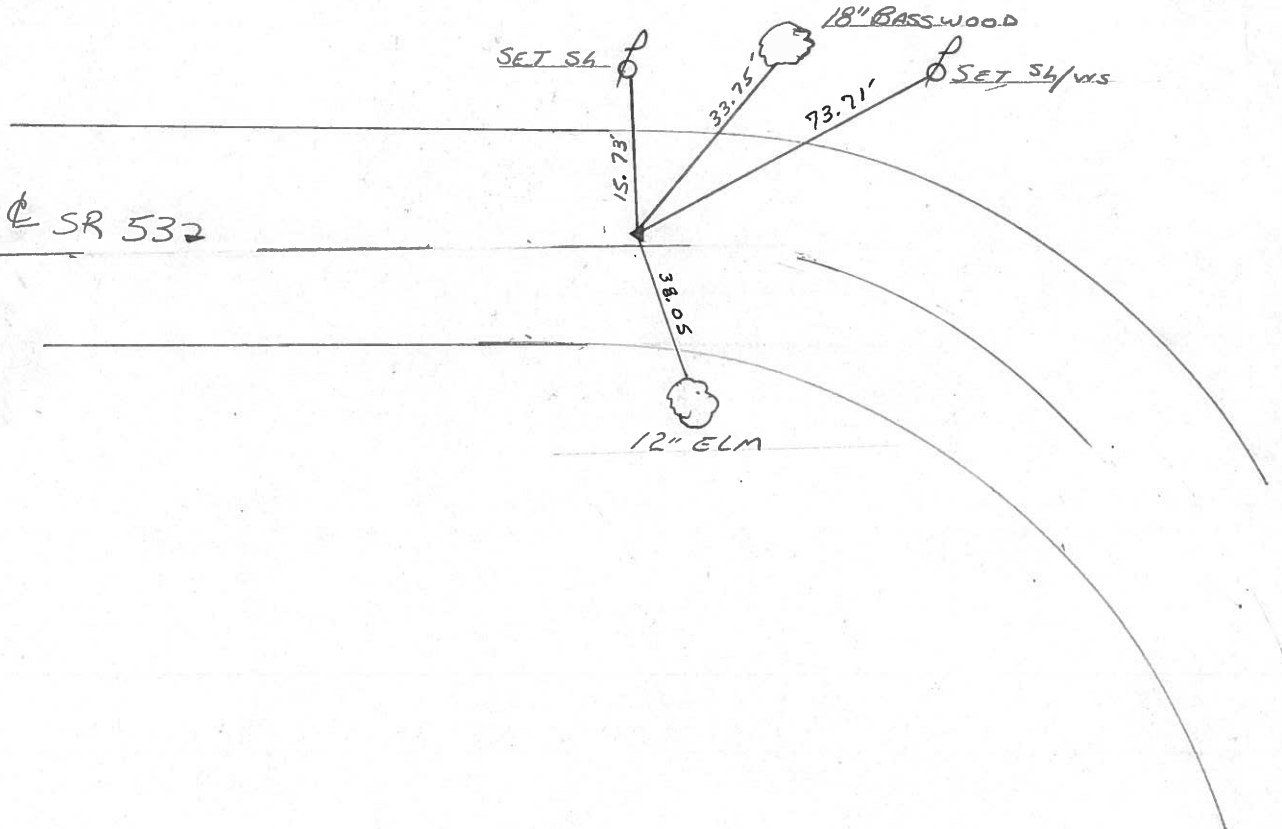


PERSONNEL	TITLE	PERSONNEL	TITLE	COUNTY	DATE
				Ottawa	6-7-71
				S. R. 53	WEATHER Hot
				SEC.	TEMP. 80°
DESCRIPTION	S.R. 163 North			LEFT	CENTER LINE
					RIGHT
					JOB NO.

3/28/84
Sunny - windy
36°

P.I.
864 + 80.83
R. R. spk.

73

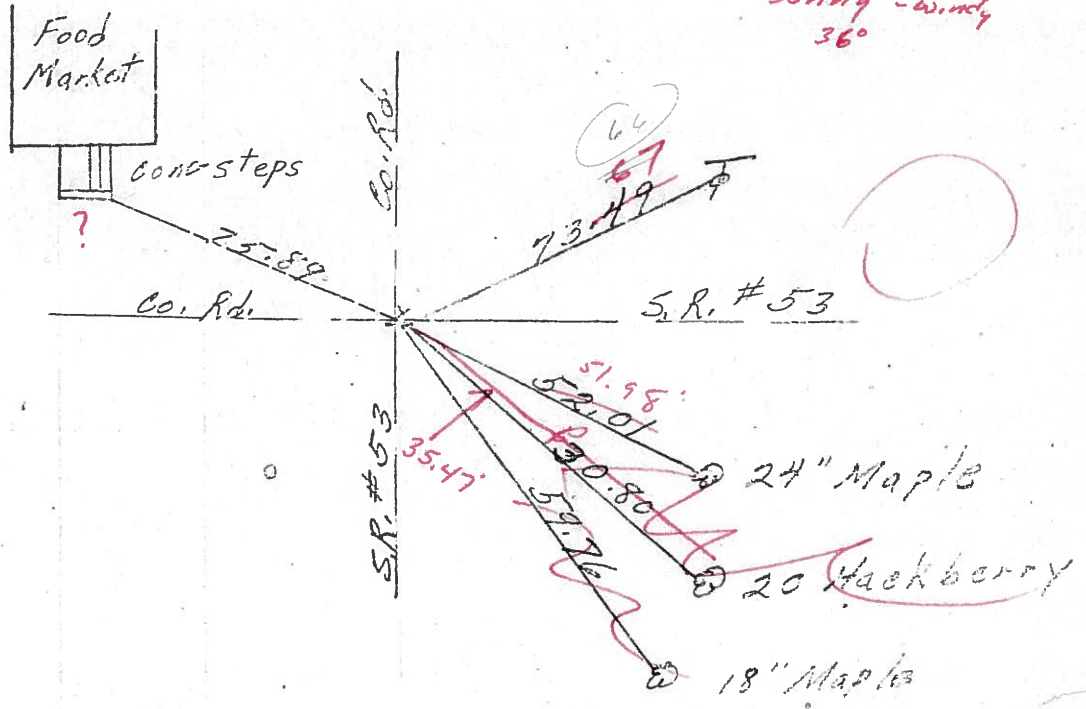

P.I.
856 + 66.73 =
856 + 84.53

3/12/84
overcast - windy
20°

1.5' Rt.
Rt. E.P.


72

IPin

P.I. SUR
855 + 67.94
Iron Pin

71

$$\begin{array}{r} 85446372 \\ 71772 \\ \hline 9263372 \end{array}$$
 IPin

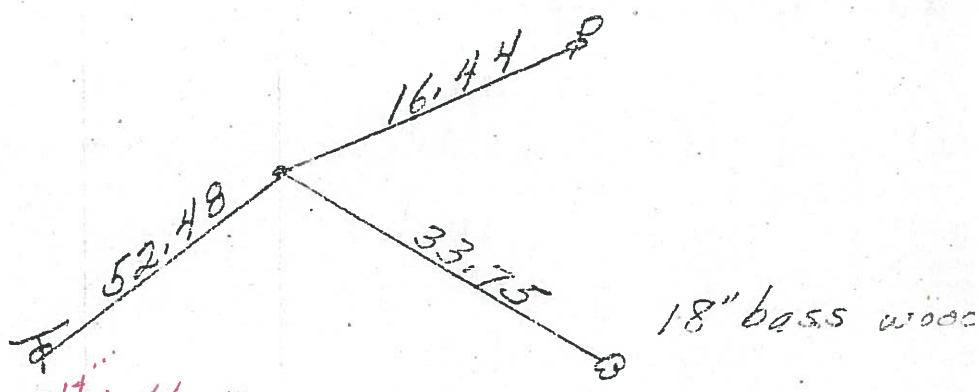


twin
16" thorn apple

12" walnut

conc gates
post

even with ground

PERSONNEL	TITLE	PERSONNEL	TITLE	COUNTY	DATE
				<u>Ottawa</u>	<u>6-7-71</u>
				S. R. <u>53</u>	WEATHER <u>Hot</u>
				SEC.	TEMP. <u>80°</u>
DESCRIPTION	<u>S.R. 163 North</u>			JOB NO.	
	LEFT	CENTER LINE	RIGHT		

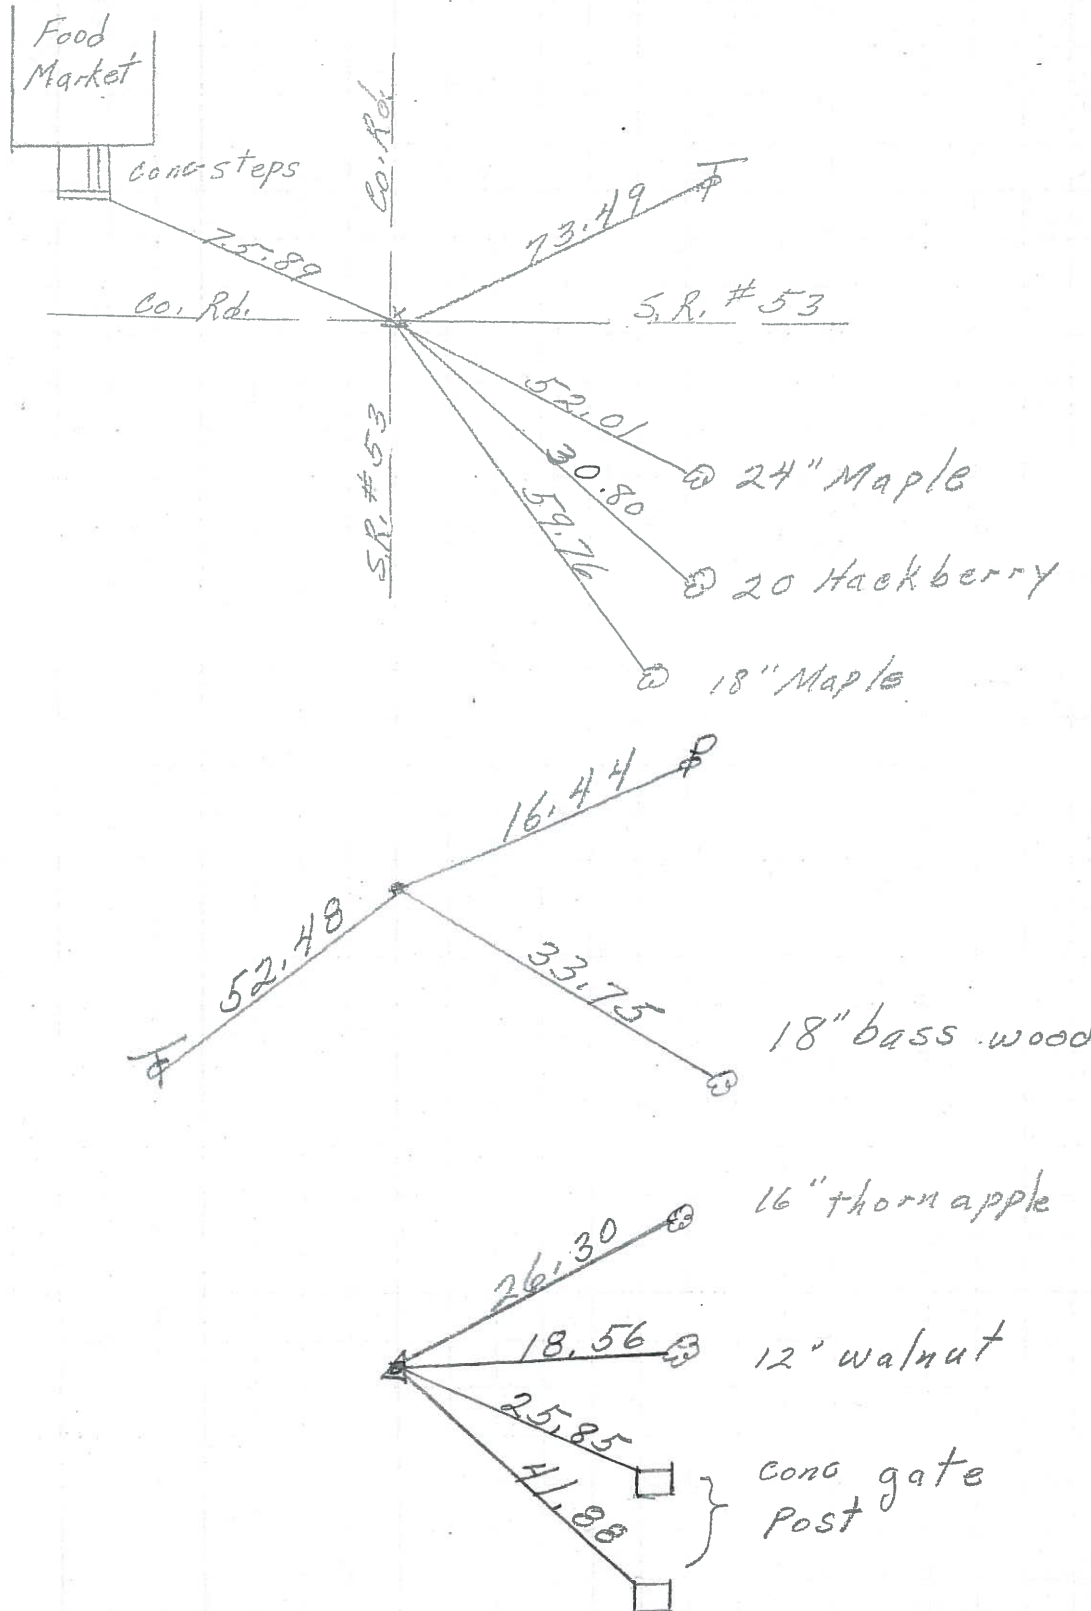

P.I.
 $864 + 80.83$
 R. R. spk.

73

P. I.
 $856 + 66.73 =$
 $856 + 84.53$

72

P. I.
 $855 + 67.94$
 Iron Pin

71