


O.D.O.T. DISTRICT 2 SURVEY OFFICE (USE ONLY)


PERSONNEL _____ REFERENCE NO. 73 SHEET 32 OF 34
 NOTES AUBLE DATE 8/26/22 ROUTE SR 53
 H.C. NIESE WEATHER CLOUDY COUNTY OTTAWA
 R.C. RHOADES TEMP. 72° TOWNSHIP CATAWBA
 SECTION 4-26
 DWG BY RHOADES PID 102905 CONNECTICUT WESTERN RESERVE

TYPE MONUMENT MAG/WASHER
 ON SURFACE - ~~BELOW~~ ON
 OFFSET ☐ PAVEMENT ON LT : ~~RT~~
- TO - EDGE PAVEMENT
 STATION: 735+91.56

NOTE:
THIS MAP IS FOR ODOT PURPOSES ONLY.
TO INDEX REFERENCE TIES, AND DOES NOT
REPRESENT TRUE LAND SUBDIVISION.

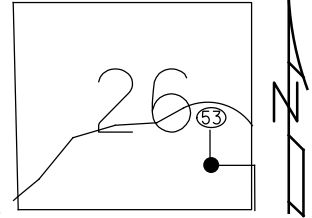

HORZ. DATUM: NAD83 2011 GEOID: NAVD88 2018
 GRID: NORTHING: 699209.761 EASTING: 1876425.460

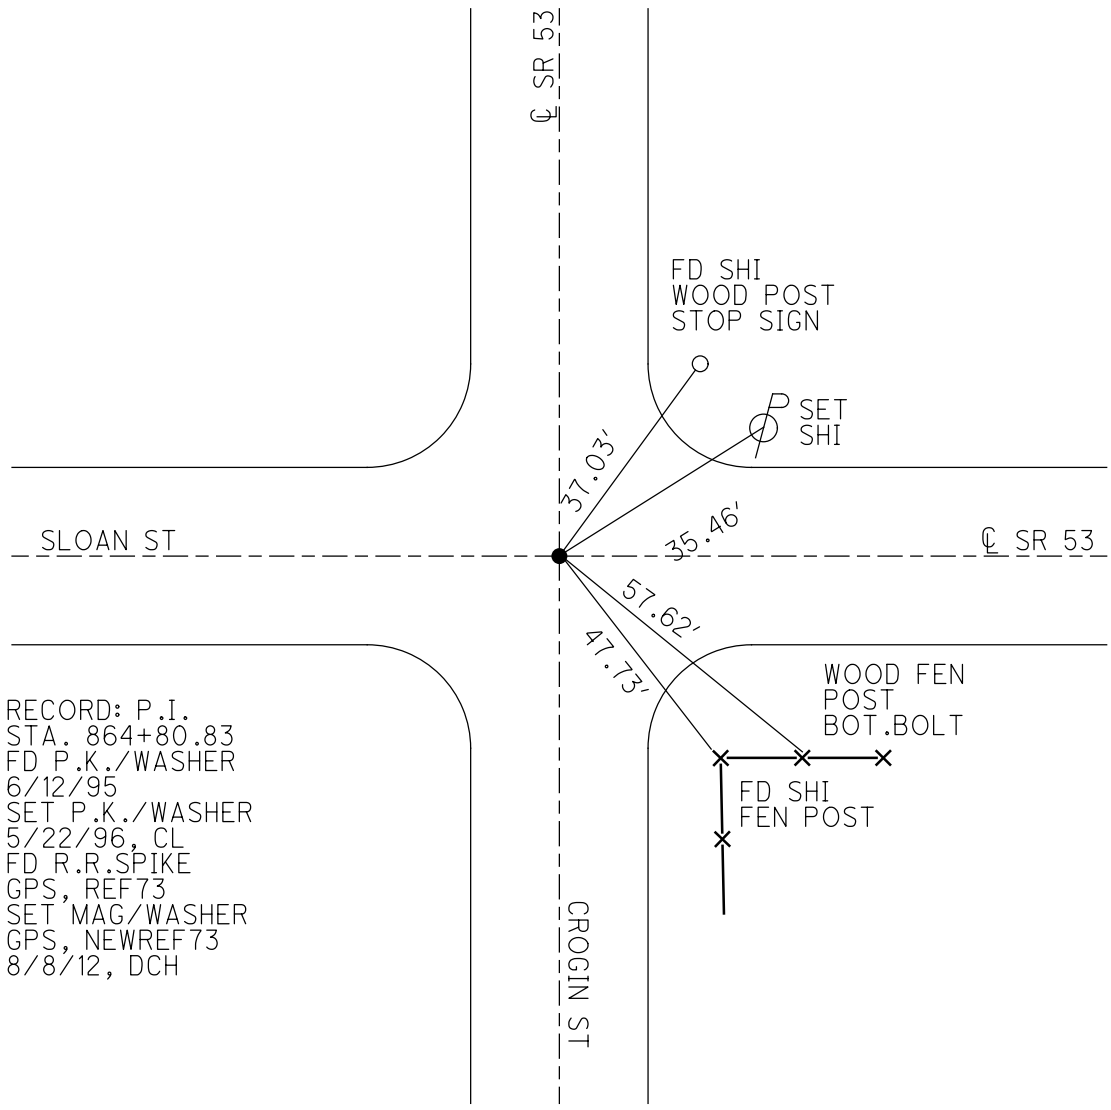


RECORD: P.I.
 STA. 864+80.83
 FD P.K./WASHER
 6/12/95
 SET P.K./WASHER
 5/22/96, CL
 FD R.R. SPIKE
 GPS, REF 73
 SET MAG/WASHER
 GPS, NEWREF 73
 8/8/12, DCH

O.D.O.T. DISTRICT 2 SURVEY OFFICE (USE ONLY)


PERSONNEL _____ REFERENCE NO. 73 SHEET 35 OF 36
 NOTES HOMAN DATE 9/6/11 ROUTE SR 53
 H.C. ROUSOS WEATHER CLOUDY COUNTY OTTAWA
 R.C. HOMAN TEMP. 65° TOWNSHIP CATAWBA ISL
 _____ SECTION 4-26

TYPE MONUMENT R.R.SPIKE
 ON SURFACE - ~~BELOW~~ 1"
 LEFT - ☉ PAV'T - RIGHT ON
- TO - EDGE PAVEMENT
 S.L.M. 938+15.18

NOTE:
THIS MAP IS FOR ODOT PURPOSES ONLY
TO INDEX REFERENCE TIES, AND DOES NOT
REPRESENT TRUE LAND SUBDIVISION.

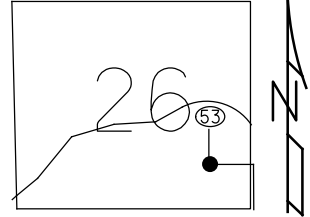

GRID: NORTHING: 699209.730 EASTING: 1876425.316

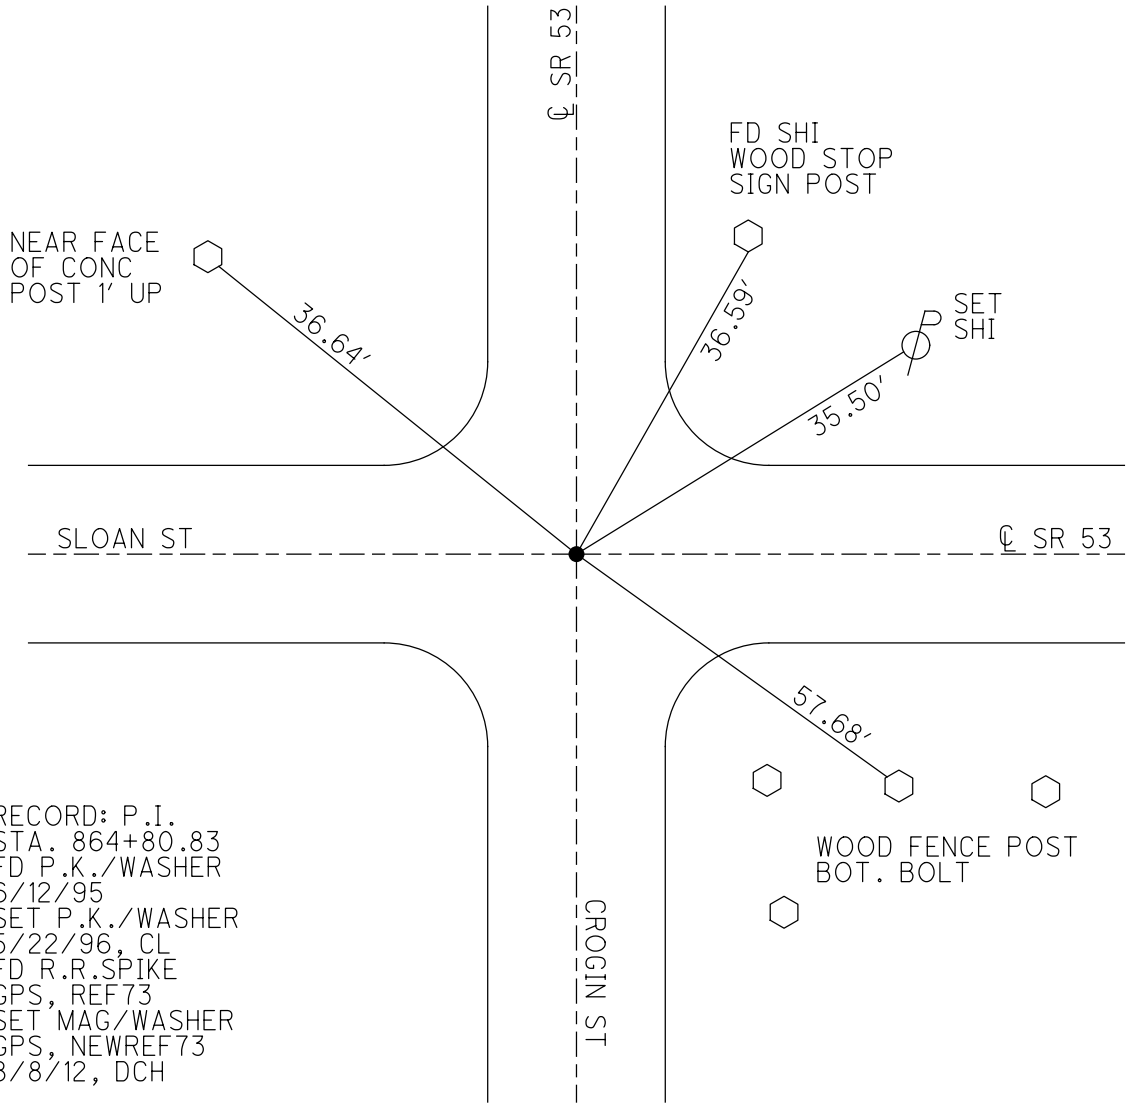

RECORD: P.I.
 STA. 864+80.83
 FD P.K./WASHER
 6/12/95
 SET P.K./WASHER
 5/22/96, CL
 FD R.R.SPIKE
 GPS, REF73
 SET MAG/WASHER
 GPS, NEWREF73
 8/8/12, DCH

O.D.O.T. DISTRICT 2 SURVEY OFFICE

PERSONNEL

REFERENCE NO. 73

SHEET 29 OF 30

NOTES VAN DOSEN

H.C. ROUSOS

R.C. HUSS

DATE 6-12-95

WEATHER FAIR

TEMP. +72

ROUTE S.R. 53

COUNTY OTTAWA

TOWNSHIP CATAWBA

SECTION _____

T _____ R _____

Reset

TYPE MONUMENT P.K. & WASHER

5-22-96


ON SURFACE - BELOW Yes

C.L.

LEFT - C PAV'T. - RIGHT Both

TO EDGE PAVEMENT


S.L.M. 938+27

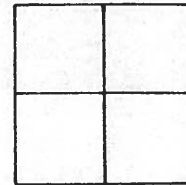

RECORD: P.I. - R/W

: Sta 864+80.83

R.R. SPIKE - 1984

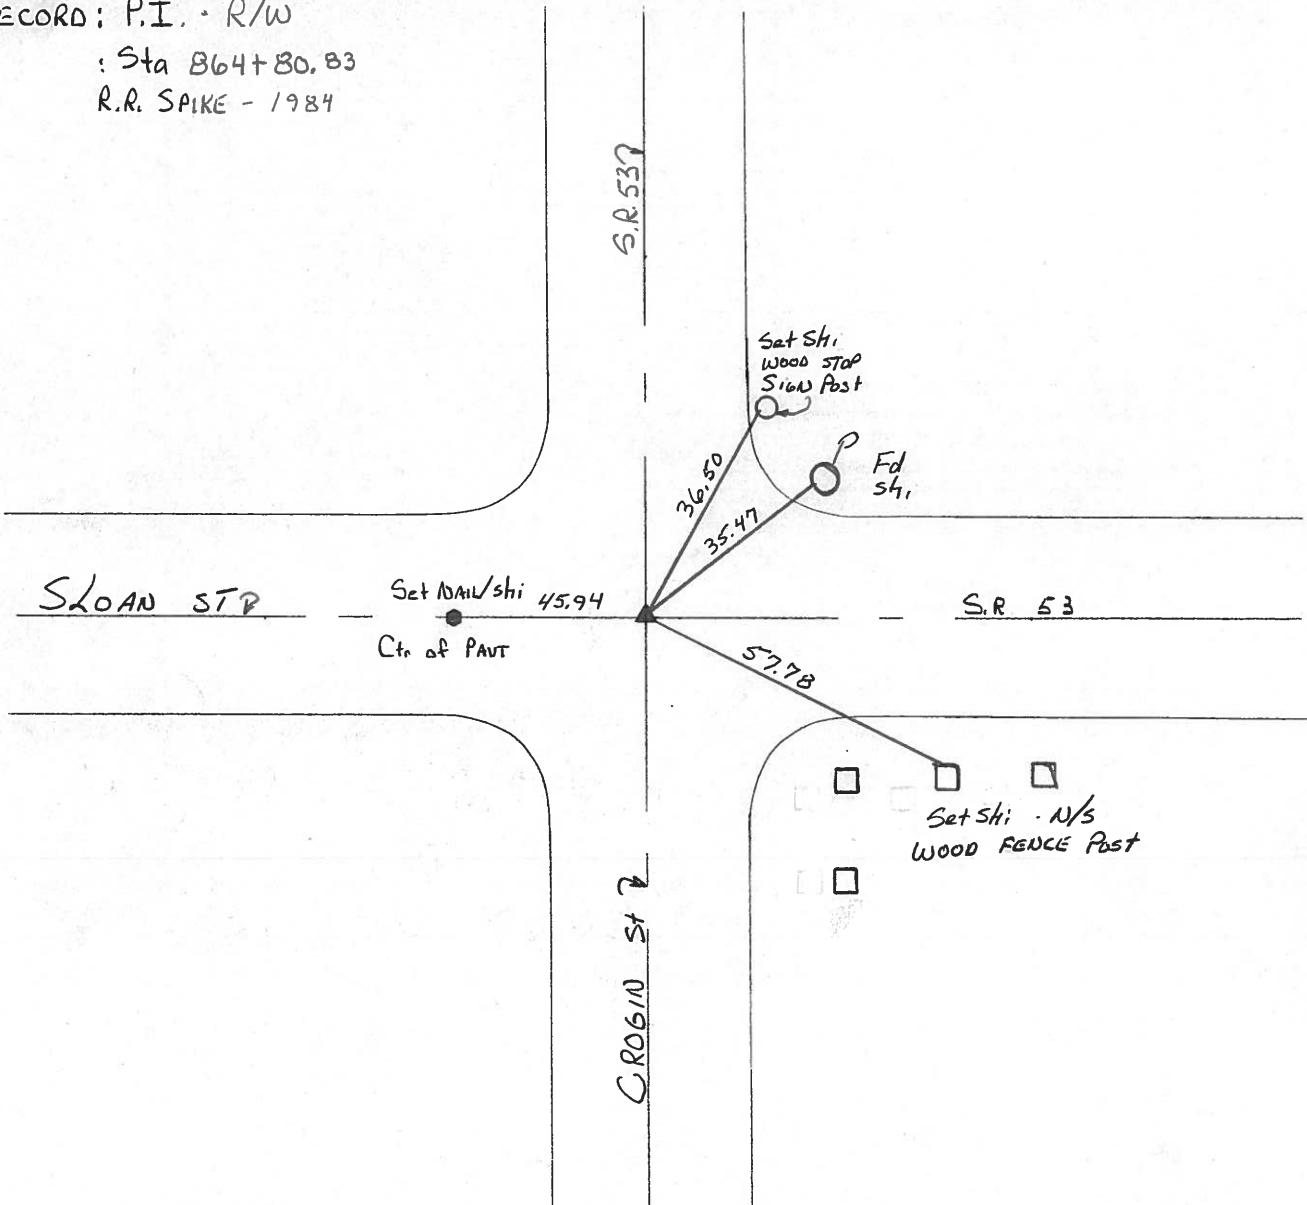

Q.D.O.T. DISTRICT 2 SURVEY OFFICE

SHEET _____ OF _____

County Ottawa S.R. # 53

Date 8/29/84

Township Catawba


Weather overcast - windy

Section _____

Temp. 68°

T N, R E

Personnel Cronin

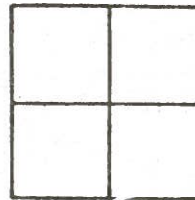

Ripple

Geyman

Barbour

PT 73




P.I. R/W

864+80.83

set P.K. & washer atop


R.R. spike

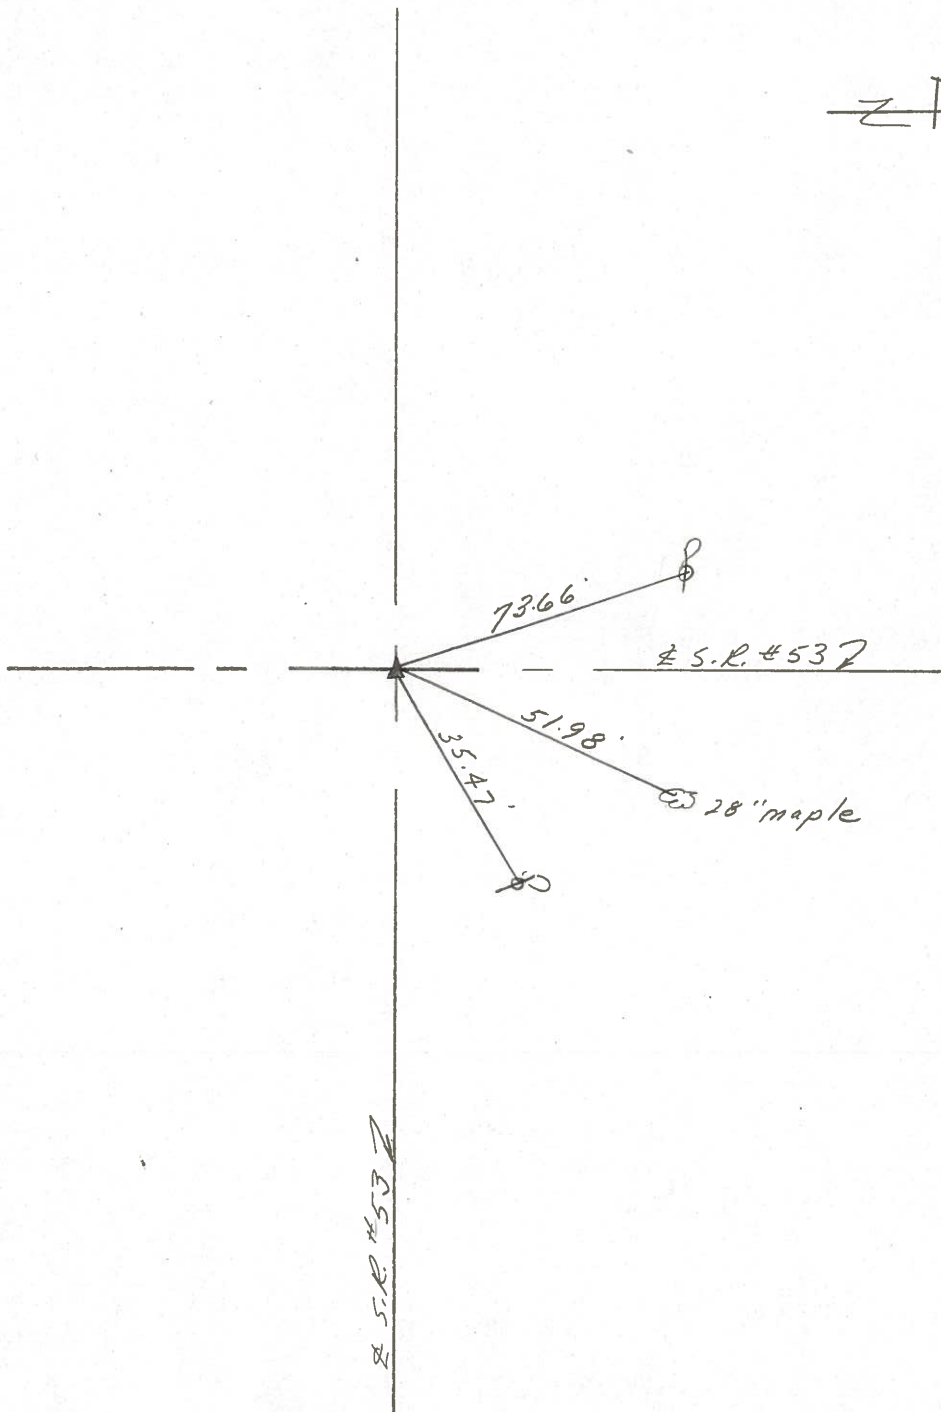

S.R. #537

PERSONNEL	TITLE	PERSONNEL	TITLE	COUNTY	DATE	WEATHER	TEMP.
				Ottawa	6-7-71	Hot	80°
				S. R. 53			
				SEC.			
DESCRIPTION S.R. 163 North							
	LEFT	CENTER LINE	RIGHT	JOB NO.			

3/23/84
Sunny - windy
36°

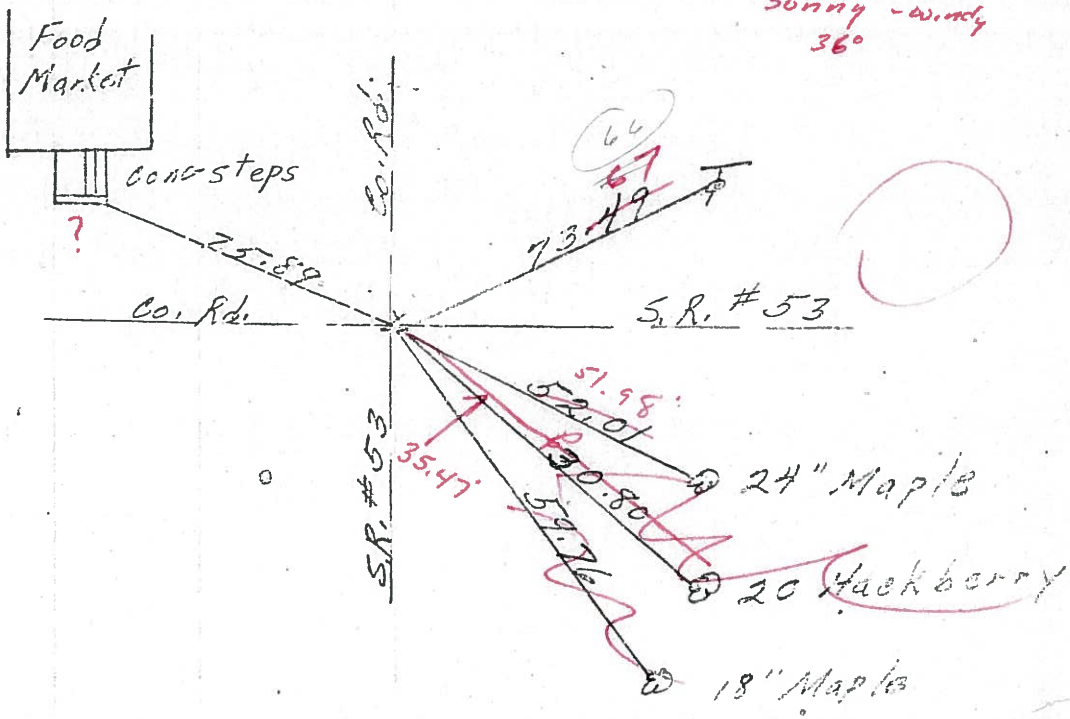

P.I.
864 + 80.83
R. R. spk.

73


P. I.
8.56 + 66.73 =
856 + 84.53

3/12/84
overcast - windy
20°

1.5 ft.
Rt. E.P.

72

IPin

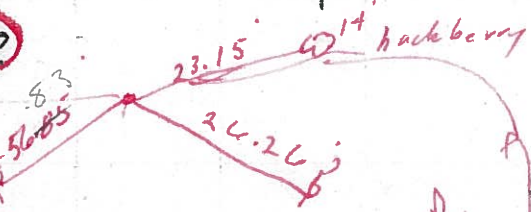


P. I. SUR
855 + 67.94
Iron Pin

71

FD P.I. SUR

854 + 6372
76772
926.3372

IPin

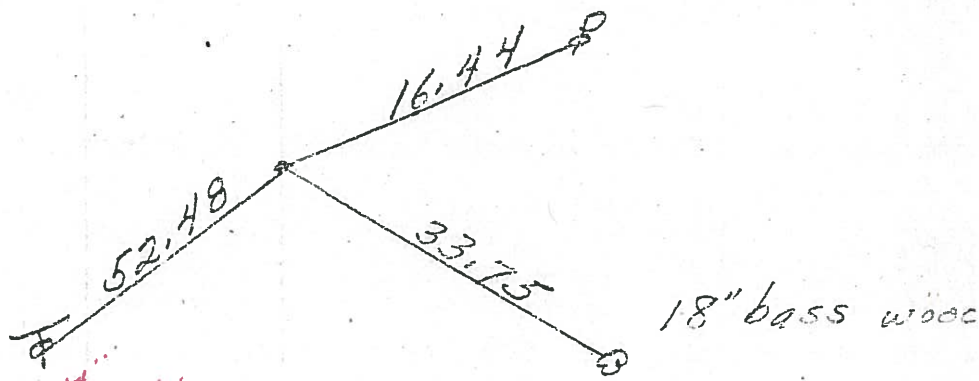

18" bass wood

twin
16" thorn apple

12' walnut


conc gate
Post

even with ground

PERSONNEL	TITLE	PERSONNEL	TITLE
COUNTY <u>Ottawa</u> DATE <u>6-7-71</u>			
S. R. <u>53</u> WEATHER <u>Hot</u>			
SEC. _____ TEMP. <u>80°</u>			
DESCRIPTION <u>S.R. 163 North</u>			JOB NO. _____
	LEFT	CENTER LINE	RIGHT


P.I.
864 + 80.83
R. R. spk.

73

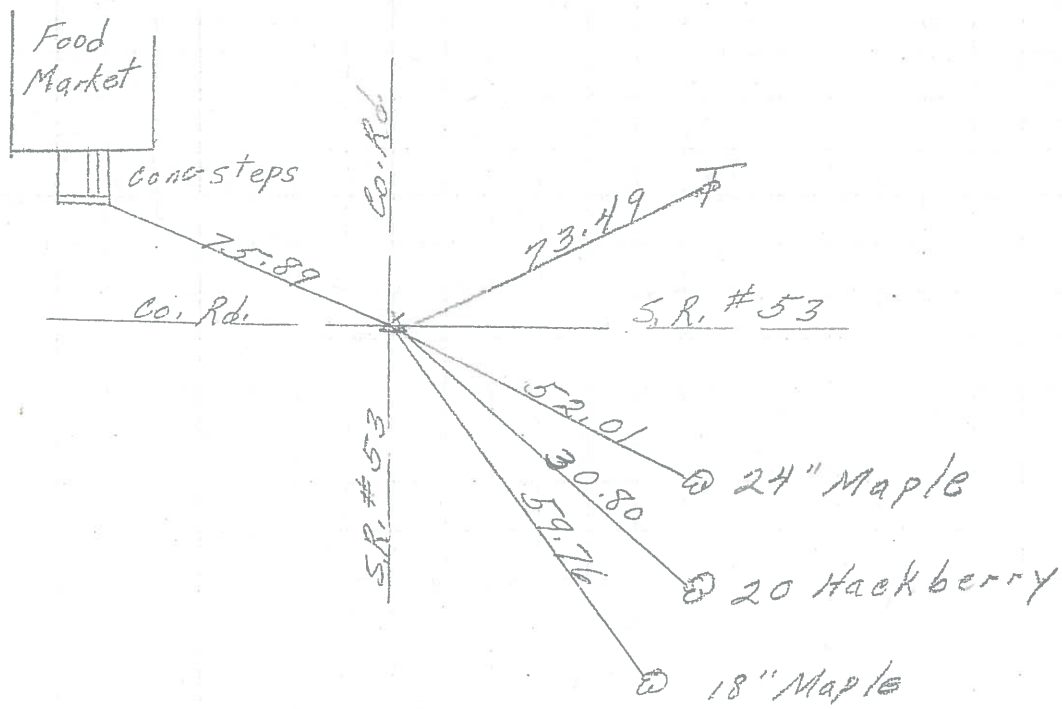


P. I.
856 + 66.73 =
856 + 84.53

72

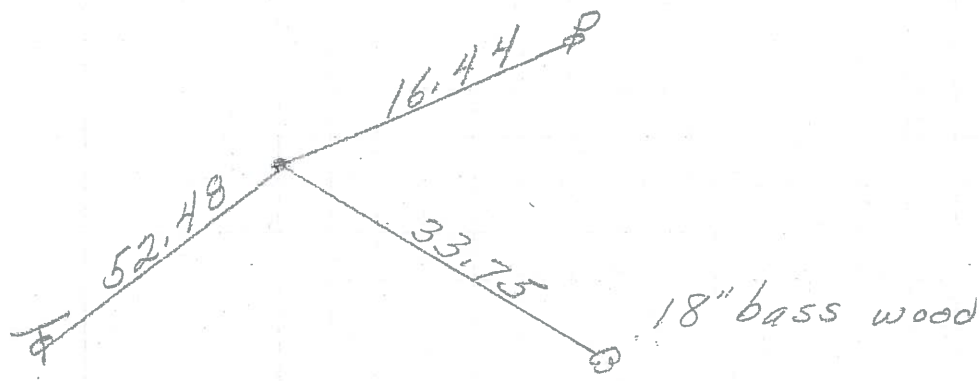

P. I.
855 + 67.94
Iron Pin

71

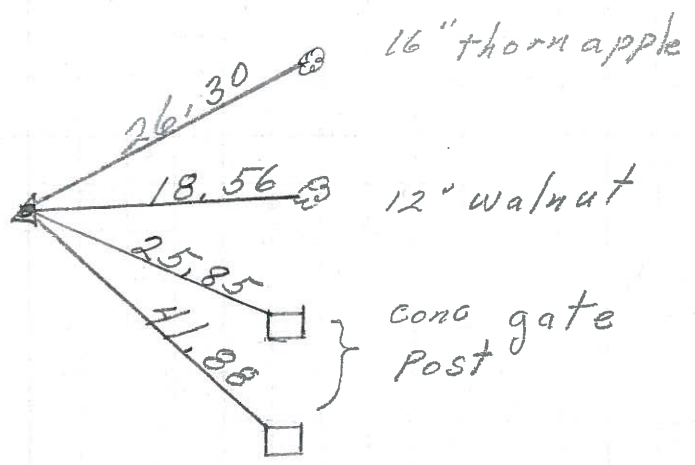

PERSONNEL	TITLE	PERSONNEL	TITLE
Schneider		Potts	
Mosser			
Barbour			
Redding			

COUNTY O. Iowa DATE 8-17-68
 S. R. 53 WEATHER Hot
 SEC. S.R. #16.3 North TEMP. 90°

DESCRIPTION Ties for control points JOB NO. _____
 LEFT CENTER LINE RIGHT

