

O.D.O.T. DISTRICT 2 SURVEY OFFICE (USE ONLY)

PERSONNEL

REFERENCE NO. 75

SHEET 34 OF 34

NOTES AUBLE DATE 8/26/22
H.C. NIESE WEATHER CLOUDY
R.C. RHOADES TEMP. 72°

ROUTE SR 53
COUNTY OTTAWA
TOWNSHIP CATAWBA
SECTION 4-26

DWG BY RHOADES PID 102905

CONNECTICUT WESTERN RESERVE

TYPE MONUMENT MONBOX W/1" IPIN

ON SURFACE - ~~BELOW~~ ON

OFFSET ☉ PAVEMENT 1.5' ~~±~~ : RT

- TO - EDGE PAVEMENT

STATION: 947+05.09


HORZ.DATUM: NAD83 2011

GEOID: NAVD88 2018

GRID: NORTHING: 699660.345

EASTING: 1875918.796

NOTE:
THIS MAP IS FOR ODOT PURPOSES ONLY
TO INDEX REFERENCE TIES, AND DOES NOT
REPRESENT TRUE LAND SUBDIVISION.

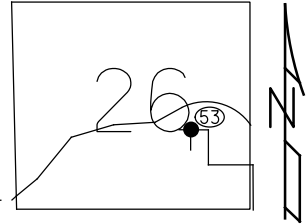

RECORD: P.O.T.
STA.947+05.09
FD MONBOX W/1" IPIN
REF75
8/26/22, TDN

