


*R/W obtained
as shown
JOP
3/10/44*

*1947
R/W
obtained*

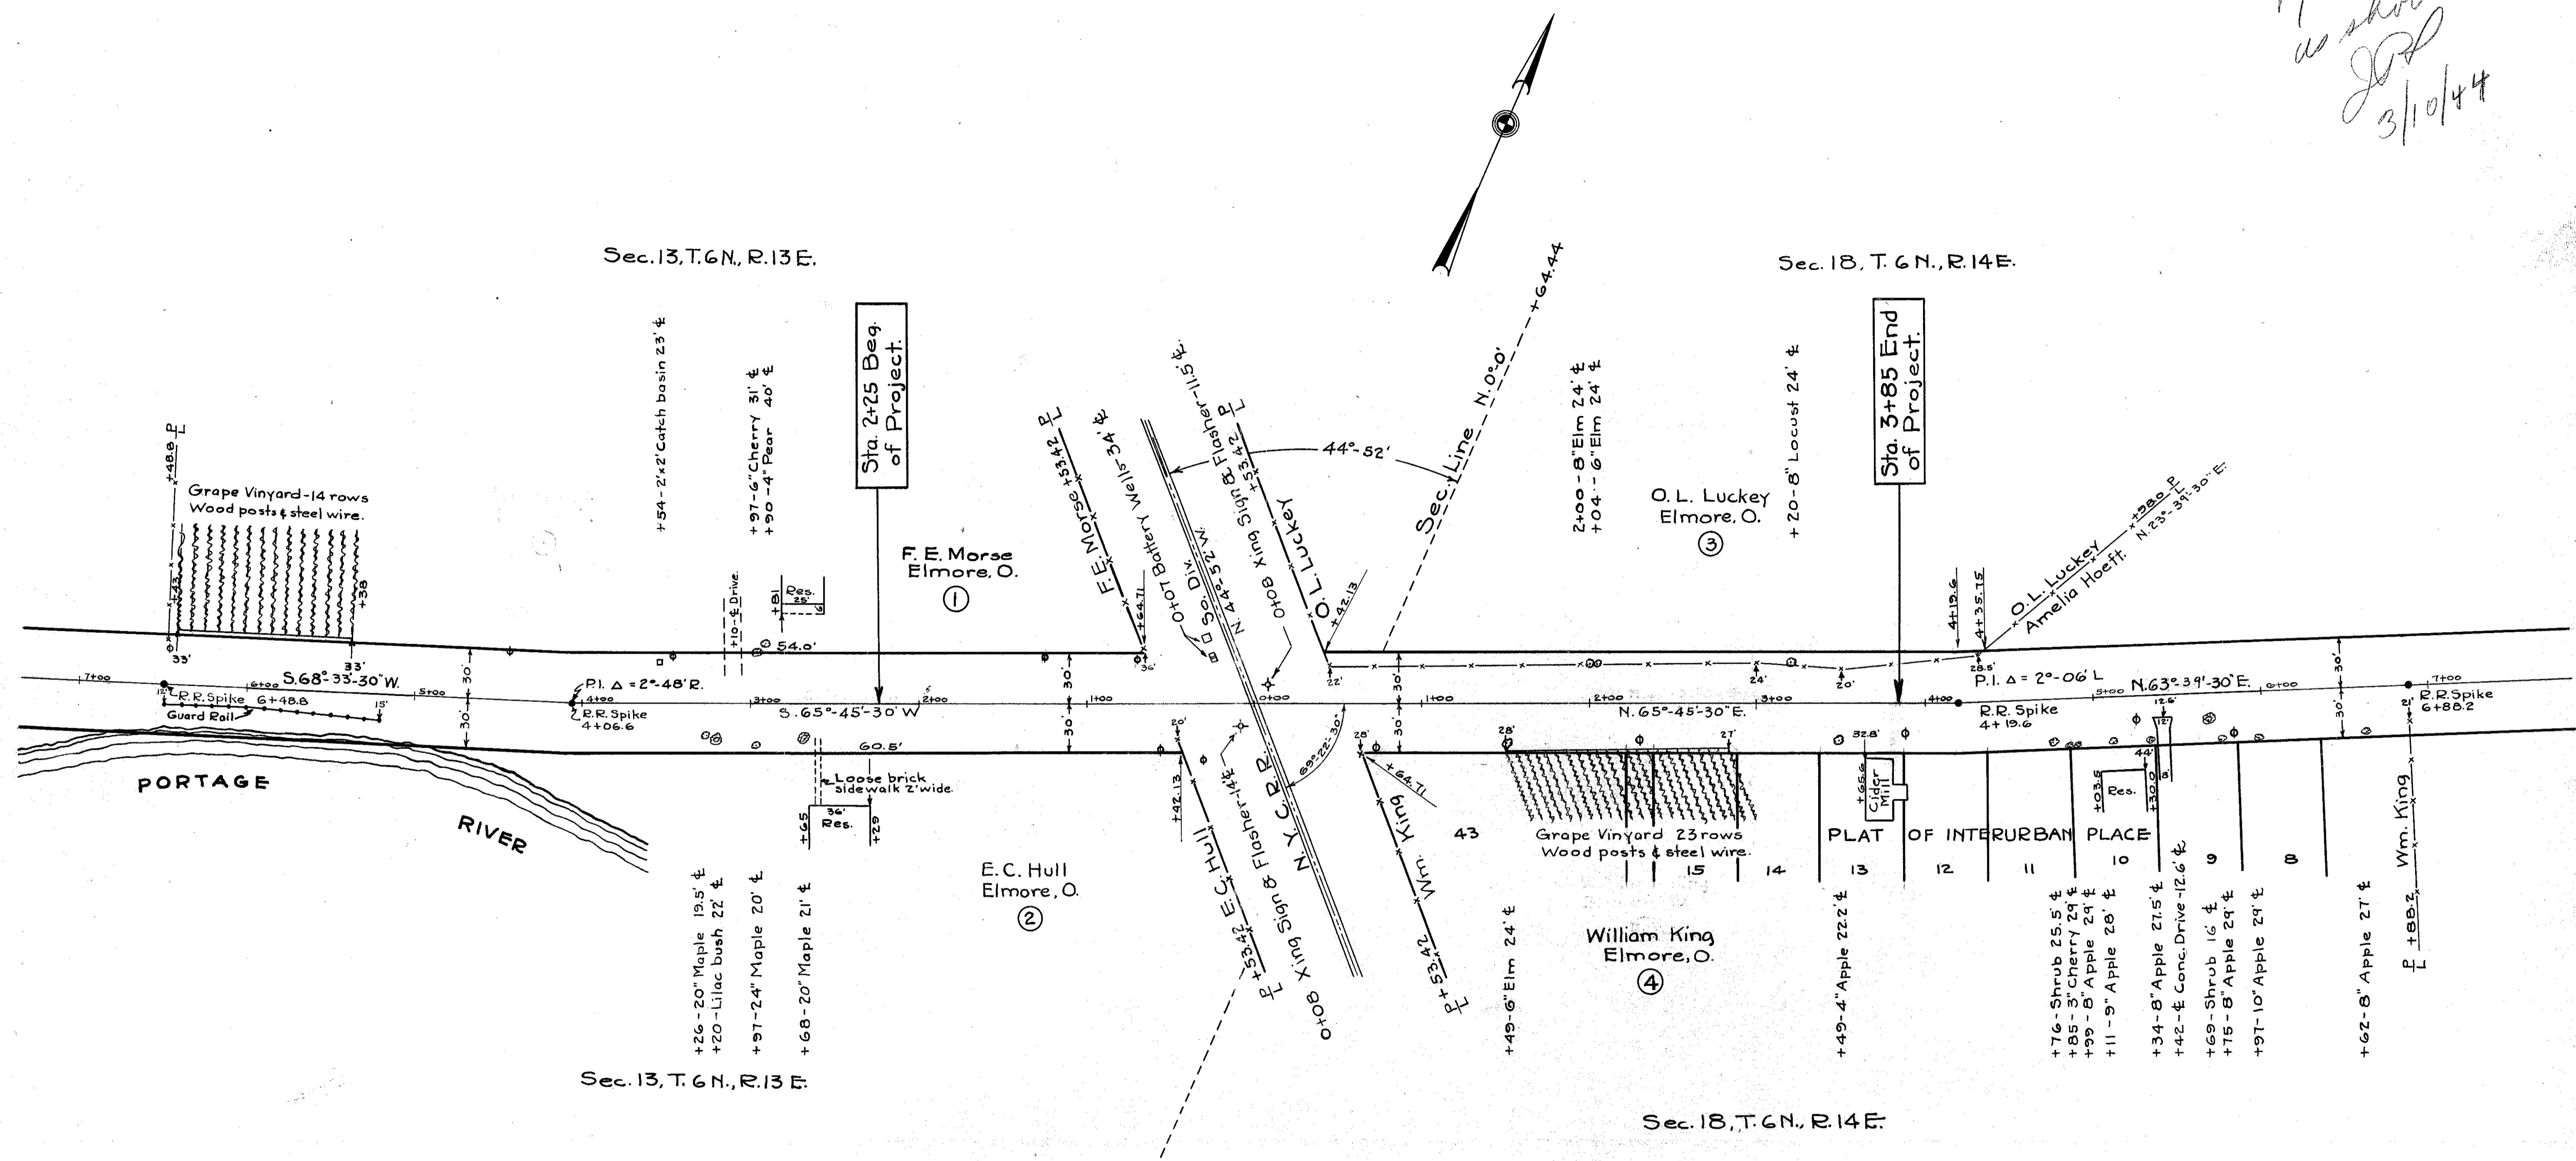

R-4105 # 2 E-15

E-15