



O.D.O.T. DISTRICT 2 SURVEY OFFICE (USE ONLY)

PERSONNEL	REFERENCE NO. <u>12</u>	SHEET <u>13</u> OF <u>33</u>
NOTES <u>RHOADES</u>	DATE <u>10/16/23</u>	ROUTE <u>SR 105</u>
H.C. <u>NIESE</u>	WEATHER <u>RAIN</u>	COUNTY <u>OTTAWA</u>
R.C. <u>AUBLE</u>	TEMP. <u>52°</u>	TOWNSHIP <u>HARRIS</u>
<u>ASTON</u>		SECTION <u>23</u>
DWG BY <u>RHOADES</u>	PID <u>CHIP SEAL</u>	T <u>6</u> N R <u>13</u> E
TYPE MONUMENT <u>LG.R.R.SPIKE</u>		
ON SURFACE - BELOW <u>3"</u>		
OFFSET <u>☉</u> PAVEMENT <u>ON</u> LT : RT		
<u>10.5'</u> TO <u>RT</u> EDGE PAVEMENT		
STATION: <u>38+70</u>		
HORZ.DATUM: <u>NAD83 2011</u>	GEOID: <u>NAVD88 2018</u>	
GRID: NORTHING: <u>657910.607</u>	EASTING: <u>1740804.143</u>	

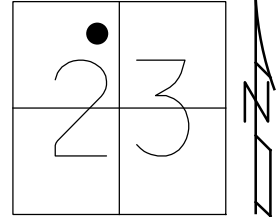


RECORD: P.O.T.
 SET P.K./WASHER
 9/28/94, MB
 FD LG.R.R.SPIKE
 3" DOWN
 OTTREF13
 5/3/13, DCH
 SET MAG/WASHER
 FINREFOTT12
 7/11/13, SDC
 FD HOLE
 REF12
 7/20/21, JFO
 FD LG.R.R.SPIKE
 3" DOWN
 REF12
 10/16/23, TDN

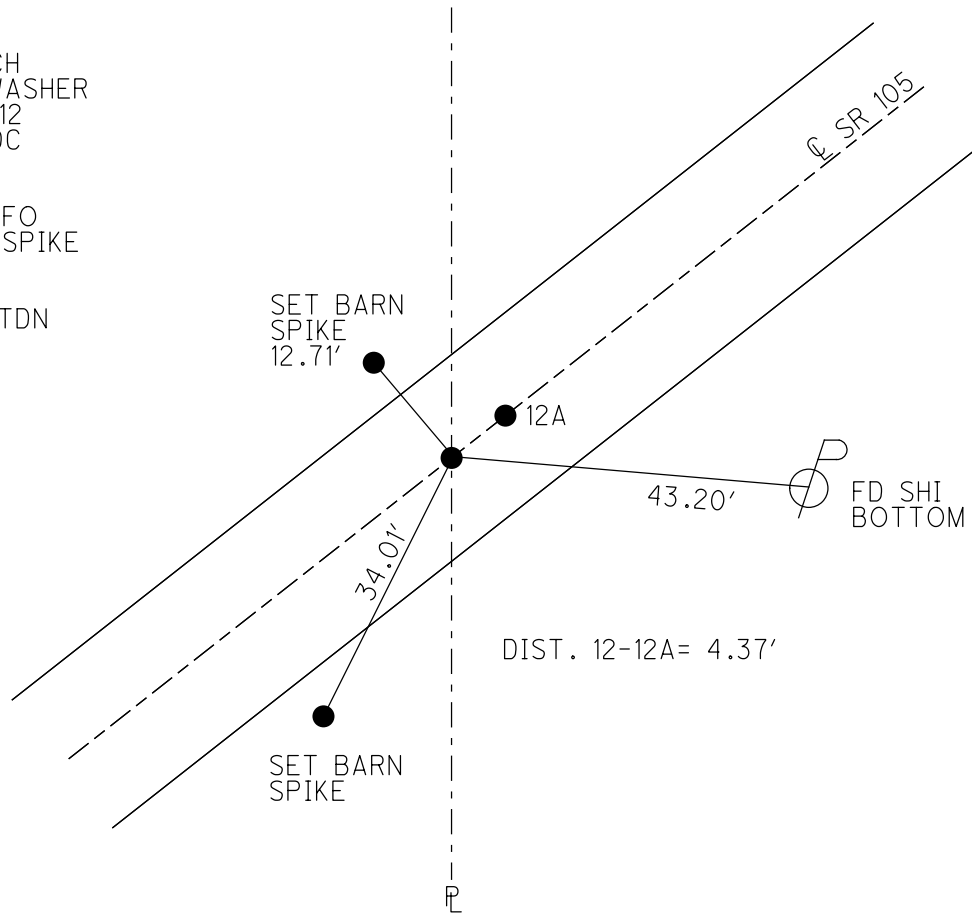

O.D.O.T. DISTRICT 2 SURVEY OFFICE (USE ONLY)


PERSONNEL _____ REFERENCE NO. 12 A SHEET 14 OF 33
 NOTES RHOADES DATE 7/20/21 ROUTE SR 105
 H.C. O'DONNELL WEATHER SUNNY COUNTY OTTAWA
 R.C. RHOADES TEMP. 80° TOWNSHIP HARRIS
 DWG BY RHOADES PID CHIP SEAL SECTION 23
 T 6 N R 13 E

TYPE MONUMENT MAG/WASHER
 ON SURFACE - ~~BELOW~~ ON
 OFFSET ☉ PAVEMENT ON LT : RT
- TO - EDGE PAVEMENT
 STATION: 38+74.4

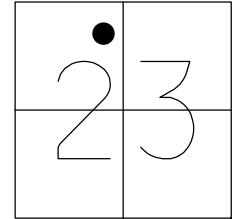

HORZ.DATUM: NAD83 2011 GEOID: NAVD88 2018
 GRID: NORTHING: 657913.167 EASTING: 1740807.672


RECORD:
 ORIGIN UNKNOWN
 FD P.K.NAIL
 5/3/13, DCH
 SET MAG/WASHER
 FINREFOTTA12
 7/11/13, SDC
 FD MAG/WASHER
 REFA12
 7/20/21, JFO
 10/20/21, JMR

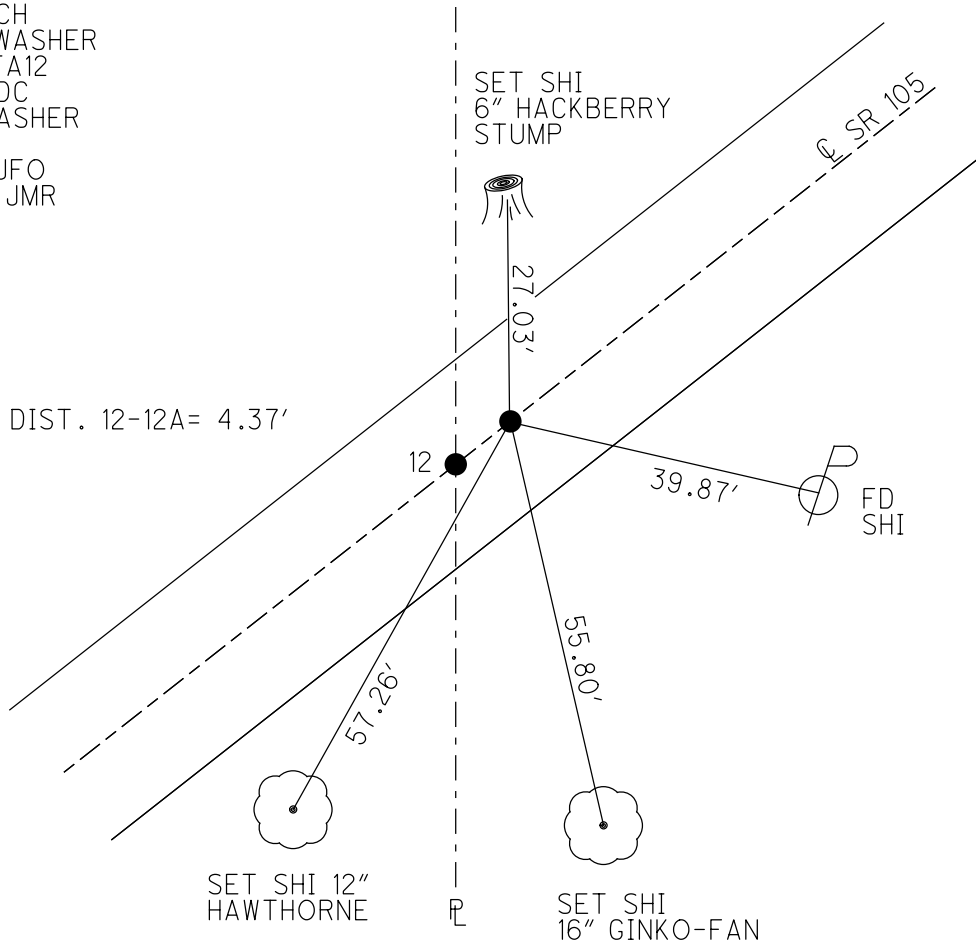

O.D.O.T. DISTRICT 2 SURVEY OFFICE (USE ONLY)

PERSONNEL	REFERENCE NO. <u>12 A</u>	SHEET <u>14</u> OF <u>33</u>
NOTES <u>HOMAN</u>	DATE <u>5/3/13</u>	ROUTE <u>SR 105</u>
H.C. <u>HOMAN</u>	WEATHER <u>CLOUDY</u>	COUNTY <u>OTTAWA</u>
R.C. <u>ROUSOS</u>	TEMP. <u>65°</u>	TOWNSHIP <u>HARRIS</u>
		SECTION <u>23</u>
		T <u>6</u> N R <u>13</u> E

TYPE MONUMENT P.K.NAIL
 ON SURFACE - ~~BELOW~~ ON
 LEFT - Q PAV'T - RIGHT ON
- TO - EDGE PAVEMENT
 S.L.M. 38+74.4

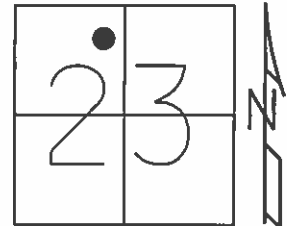

Grid: Northing: 657913.238 Easting: 1740807.601

ORIGIN UNKNOWN
 FD P.K.NAIL

SET MAG/WASHER
 7/9/13, SDC
 GPS, FINREFOTTA12
 7/11/13, SDC

DISTANCE 12-12A= 4.37'

