

O.D.O.T. DISTRICT 2 SURVEY OFFICE (USE ONLY)

PERSONNEL

REFERENCE NO. 21

SHEET 23 OF 33

NOTES RHOADES

DATE 7/21/21

ROUTE SR 105

H.C. O'DONNELL

WEATHER CLOUDY

COUNTY OTTAWA

R.C. RHOADES

TEMP. 65°

TOWNSHIP HARRIS

SECTION 13

DWG BY RHOADES

PID CHIP SEAL

T 6 N R 13 E

TYPE MONUMENT MAG/WASHER

ON SURFACE - ~~BELOW~~ ON

OFFSET Q PAVEMENT ON ~~LT~~ : RT

9.0' TO LT EDGE PAVEMENT



STATION: 104+05

HORZ.DATUM: NAD83 2011


GEOID: NAVD88 2018

GRID: NORTHING: 659294.016

EASTING: 1746940.363

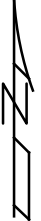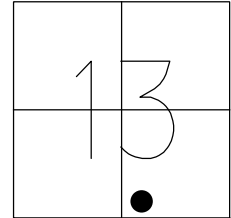


RECORD: P.I.  
 STA. 103+80.37  
 $\Delta = 1^{\circ}04' 00''$  LT  
 SET P.K./WASHER  
 10/12/94, MB  
 FD P.K./WASHER  
 OTTREF22  
 5/3/13, DCH  
 SET MAG/WASHER  
 FINREFOTT21  
 7/11/13, SDC  
 FD MAG/WASHER  
 REF21  
 7/21/21, JFO  
 10/20/21, JMR

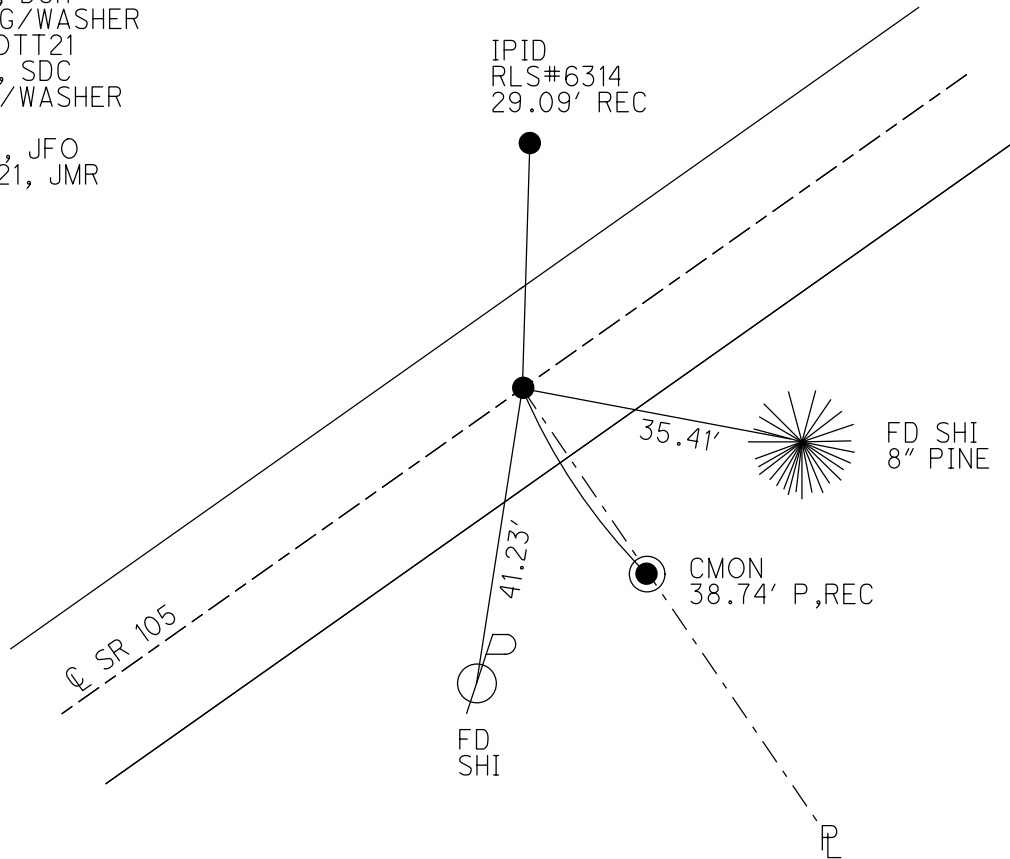

O.D.O.T. DISTRICT 2 SURVEY OFFICE (USE ONLY)

PERSONNEL	REFERENCE NO. <u>21</u>	SHEET <u>23</u> OF <u>33</u>
NOTES <u>HOMAN</u>	DATE <u>5/3/13</u>	ROUTE <u>SR 105</u>
H.C. <u>HOMAN</u>	WEATHER <u>SUNNY</u>	COUNTY <u>OTTAWA</u>
R.C. <u>ROUSOS</u>	TEMP. <u>75°</u>	TOWNSHIP <u>HARRIS</u>
		SECTION <u>13</u>
		T <u>6</u> N R <u>13</u> E

TYPE MONUMENT P.K./WASHER  
 ON SURFACE - ~~BELOW~~ ON  
 LEFT - Q PAV'T - RIGHT ON  
9.0' TO LT EDGE PAVEMENT  
 S.L.M. 104+05

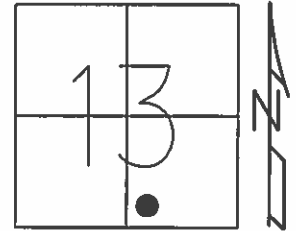


Grid: Northing: 659294.099 Easting: 1746940.209

RECORD: P.I.  
 $\Delta = 1^{\circ} 04' 00''$  LT  
 SLM: 103+80.37

RESET P.K./WASHER  
 10/12/94, MB

FD P.K.  
 GPS, OTTREF22

SET MAG/WASHER  
 7/10/13, SDC  
 GPS, FINREFOTT21  
 7/11/13, SDC

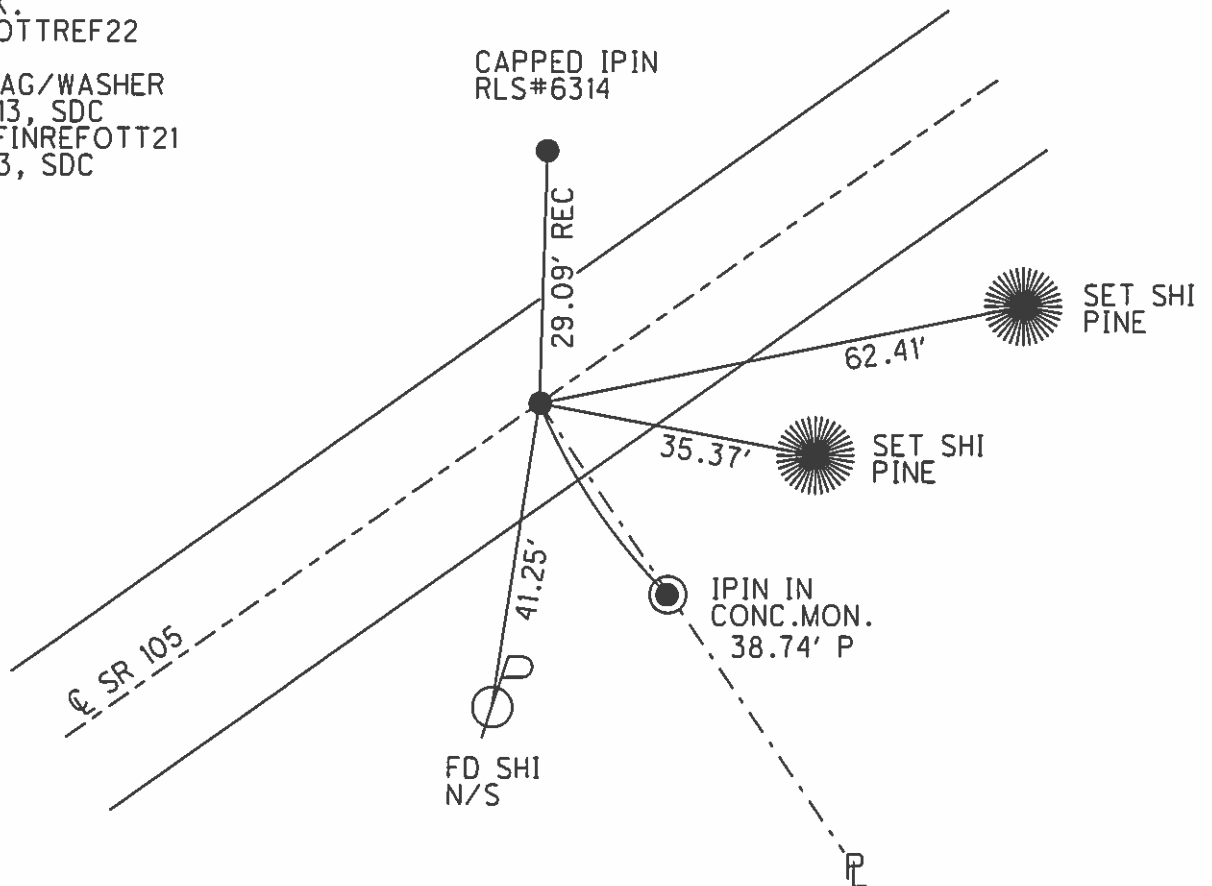

O.D.O.T. DISTRICT 2 SURVEY OFFICE

PERSONNEL \_\_\_\_\_

REFERENCE NO. 21

SHEET 18 OF 26

NOTES BARNHISEL

H.C. CORDES

DATE 9-15-94

ROUTE 105

R.C. SLOVAK

WEATHER SUNNY

COUNTY OTTAWA

TEMP. +81°

TOWNSHIP HARRIS

SECTION 13

T 6 N R 13 E


TYPE MONUMENT P.K. & WASHER

ON SURFACE - ~~BELOW~~ yes

~~LEFT~~ - & PAV'T. - ~~RIGHT~~ yes


9.0 TO LT EDGE PAVEMENT

S.L.M. 104+05

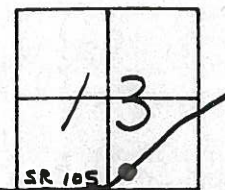

Record: P.I.  $\Delta = 1^{\circ}-04'-00''$  LT  
103+80.37

Reset P.K. & WASHER  
10-12-94  
MB

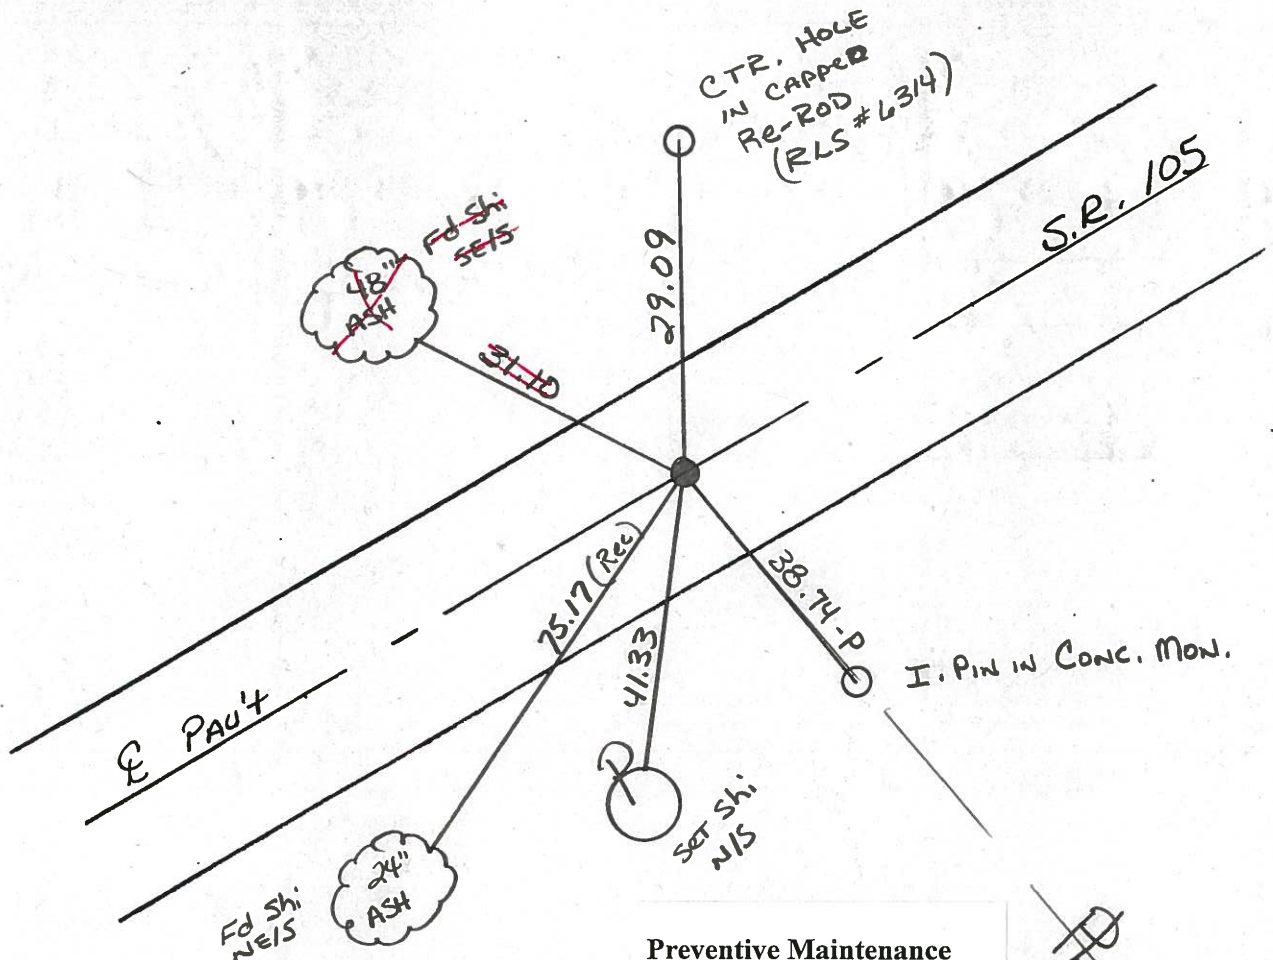

Preventive Maintenance  
Microsurfaced 2000  
Existing Point Uncovered  
Date 5-8-2000

# O.D.O.T. DISTRICT 2 SURVEY OFFICE

PERSONNEL

REFERENCE NO. 21

SHEET 6 OF 27

NOTES Hoffman

H.C. LOEHKE

R.C. BARWISSEL

DATE 5-1-85

WEATHER cloudy

TEMP. 60°

ROUTE SR 105

COUNTY OTTAWA

TOWNSHIP HARRIS

SECTION 13

T. 6 N. R. 13 E.

TYPE MONUMENT R.R. SPIKE

Fd P.K. / WASH


~~ON SURFACE - BELOW~~ 2"

8-27-85 SWH


~~LEFT - & PAV'T. - RIGHT~~ ON &

9.0 TO LT EDGE PAVEMENT

S.L.M. 103 + 80.37

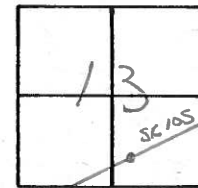

P.I.  $\Delta$  LT. 1°-04'-00"

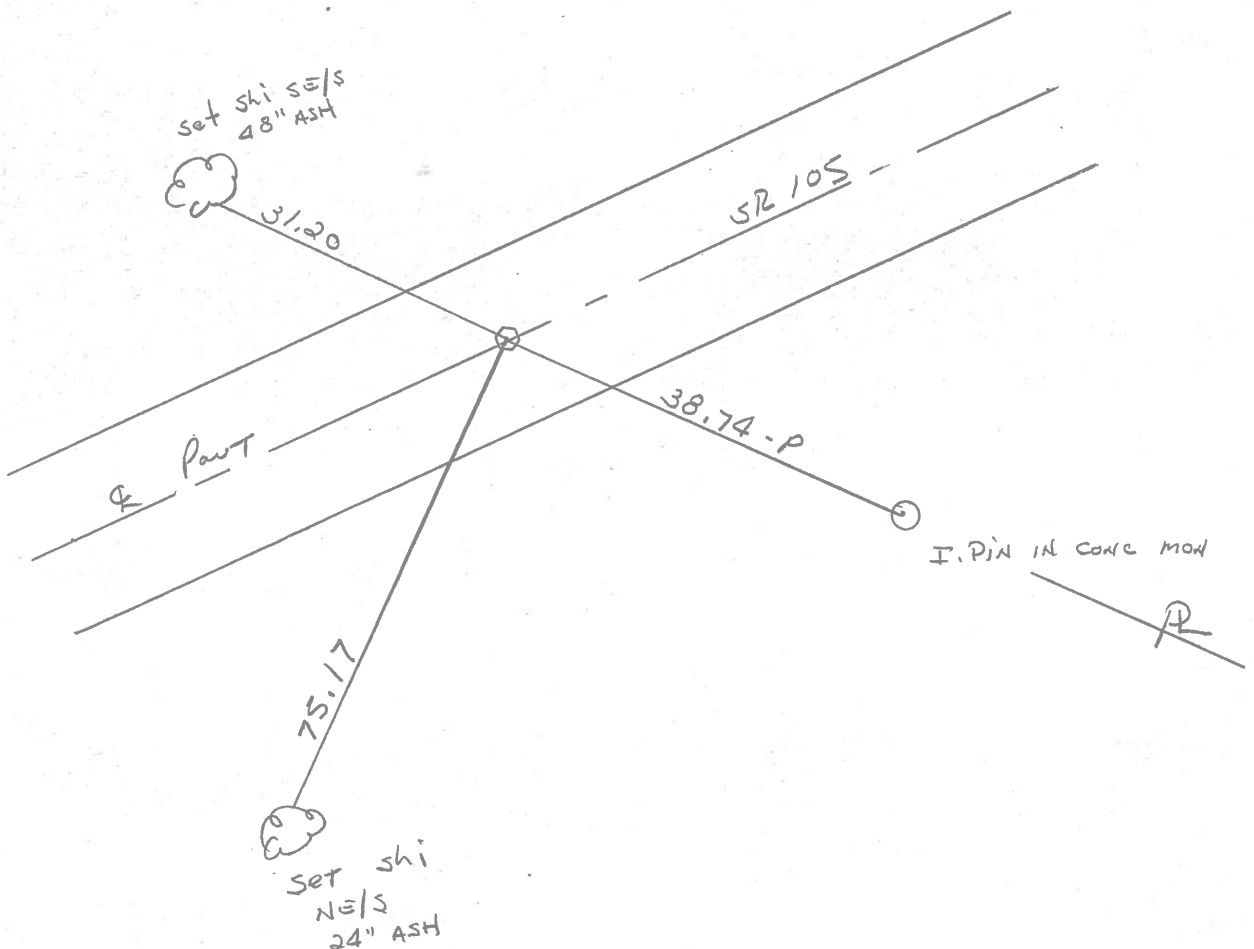

PERSONNEL TITLE PERSONNEL TITLE

COUNTY Ottawa DATE 8-7-74

S. R. 105 WEATHER Sunny

SEC. 13 TEMP. 80°

DESCRIPTION Harris Twp. JOB NO.

