

O.D.O.T. DISTRICT 2 SURVEY OFFICE (USE ONLY)

PERSONNEL

REFERENCE NO. 22

SHEET 24 OF 33

NOTES RHOADES

DATE 7/21/21

ROUTE SR 105

H.C. O'DONNELL

WEATHER CLOUDY

COUNTY OTTAWA

R.C. RHOADES

TEMP. 65°

TOWNSHIP HARRIS

SECTION 13

DWG BY RHOADES PID CHIP SEAL

T 6 N R 13 E

TYPE MONUMENT MAG/WASHER

ON SURFACE - ~~BELOW~~ ON

OFFSET 0.3' LT : RT

9.1' TO LT EDGE PAVEMENT


STATION: 106+52

HORIZ.DATUM: NAD83 2011


GEOID: NAVD88 2018

GRID: NORTHING: 659434.684

EASTING: 1747141.159

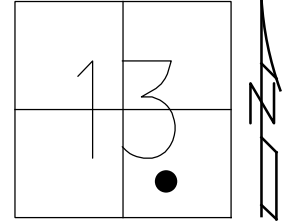


RECORD: P.I.  
 STA. 106+25.47  
 $\Delta = 0^{\circ}30'48''$  LT  
 SET P.K./WASHER  
 10/12/94, MB  
 FD P.K./WASHER  
 OTTREF23  
 5/3/13, DCH  
 SET MAG/WASHER  
 FINREFOTT22  
 7/11/13, SDC  
 FD MAG/WASHER  
 REF22  
 7/21/21, JFO  
 10/20/21, JMR

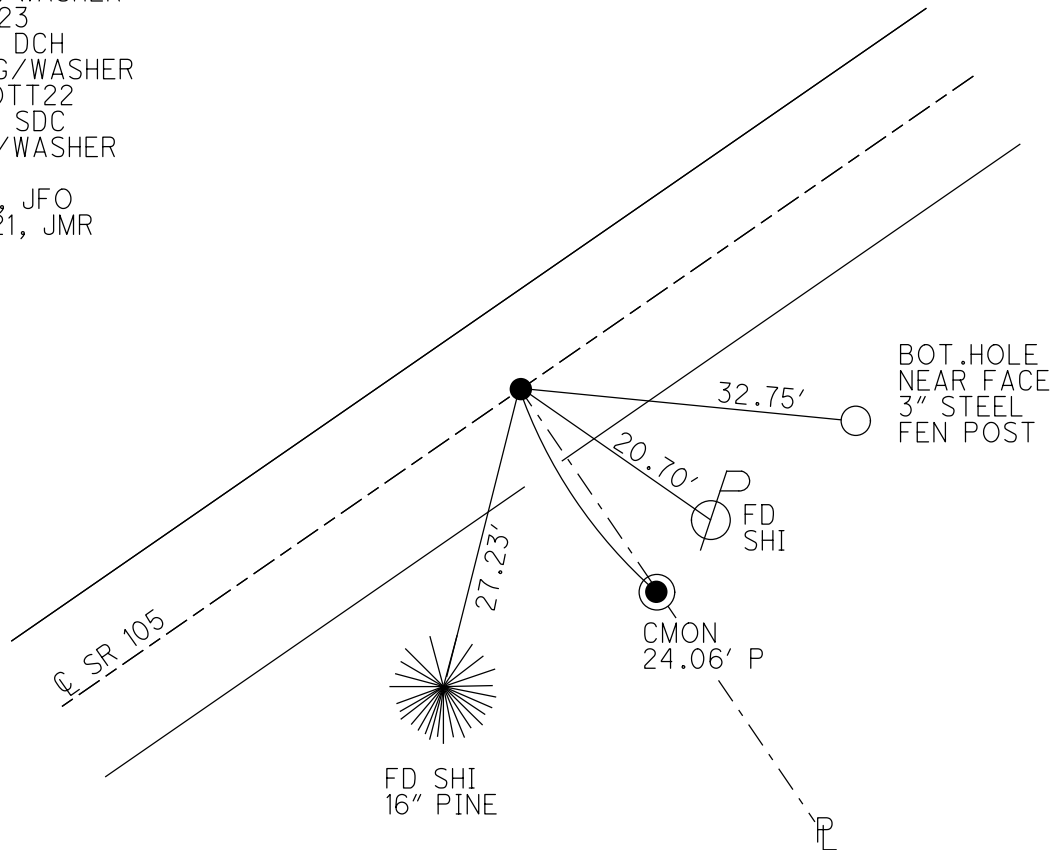

O.D.O.T. DISTRICT 2 SURVEY OFFICE (USE ONLY)

PERSONNEL	REFERENCE NO. <u>22</u>	SHEET <u>24</u> OF <u>33</u>
NOTES <u>HOMAN</u>	DATE <u>5/3/13</u>	ROUTE <u>SR 105</u>
H.C. <u>HOMAN</u>	WEATHER <u>SUNNY</u>	COUNTY <u>OTTAWA</u>
R.C. <u>ROUSOS</u>	TEMP. <u>75°</u>	TOWNSHIP <u>HARRIS</u>
		SECTION <u>13</u>
		T <u>6</u> N R <u>13</u> E

TYPE MONUMENT P.K./WASHER  
 ON SURFACE - ~~BELOW~~ ON  
~~LEFT~~ - Q PAV'T - RIGHT 0.3'  
9.1' TO LT EDGE PAVEMENT  
 S.L.M. 106+52

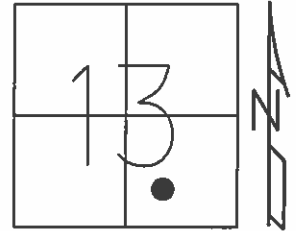


Grid: Northing: 659434.707 Easting: 1747141.066

RECORD: P.I.  
 $\Delta = 0^\circ 30' 48''$  LT  
 SLM: 106+25.47

RESET P.K./WASHER  
 10/12/94, MB

FD P.K./WASHER  
 GPS, OTTREF23

SET MAG/WASHER  
 7/10/13, SDC  
 GPS, FINREFOTT22  
 7/11/13, SDC

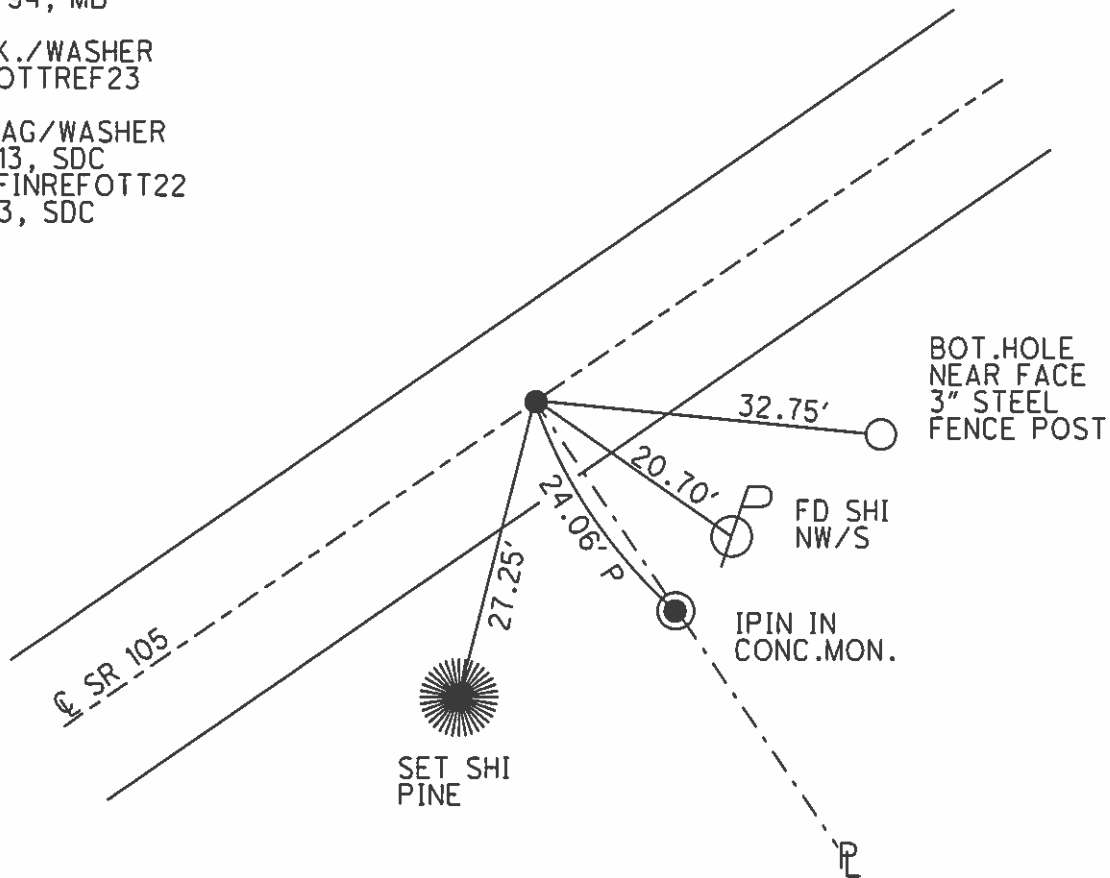

O.D.O.T. DISTRICT 2 SURVEY OFFICE

PERSONNEL \_\_\_\_\_

REFERENCE NO. 22

SHEET 19 OF 26

NOTES BARNHISEL

H.C. CORDES

DATE 9-15-94

ROUTE 105

R.C. SLOVAK

WEATHER SUNNY

COUNTY OTTAWA

TEMP. +81°

TOWNSHIP HARRIS

SECTION 13

T 6 N R 13 E


TYPE MONUMENT P.K. & WASHER

ON SURFACE - ~~BELW~~ yes

~~PAV'T.~~ - RIGHT 0.3


9.1 TO LT EDGE PAVEMENT

S.L.M. 106+52

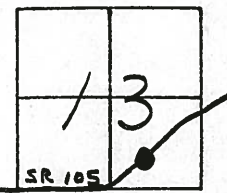

RECORD: P.I. =  $A \cdot 0^{\circ} - 30' - 48''$  LT  
106+25.47

Reset P.K. & WASHER  
10-12-94  
M.B.

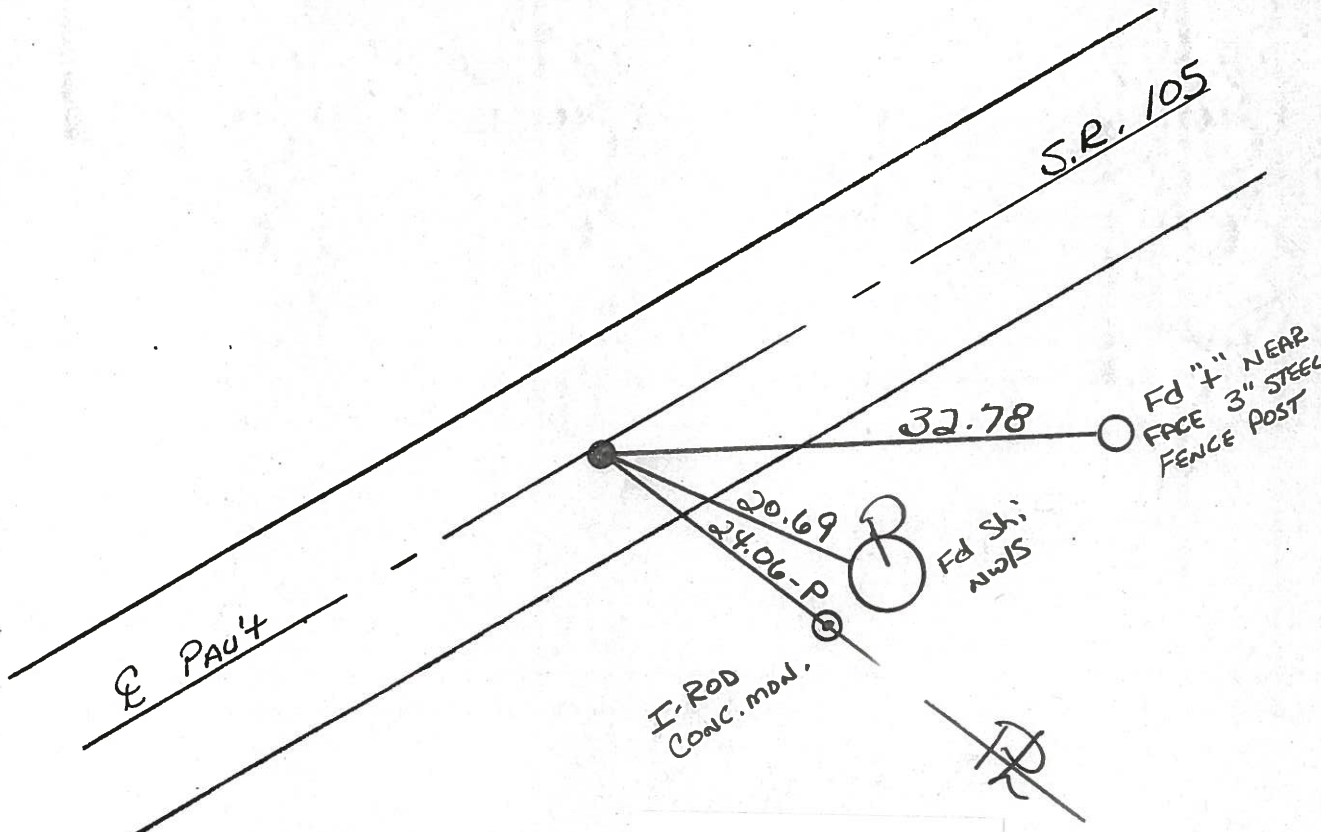

Preventive Maintenance  
Microsurfaced 2000  
Existing Point Uncovered  
Date 5-8-2000

# O.D.O.T. DISTRICT 2 SURVEY OFFICE

PERSONNEL \_\_\_\_\_

REFERENCE NO. 22

SHEET 7 OF 27

NOTES Hoffman

H.C. LOENRICE

R.C. BARNHISEL

DATE 5-1-85

WEATHER Cloudy

TEMP. 60°

ROUTE SR 105

COUNTY OTTAWA

TOWNSHIP HARRIS

SECTION 13

T 6 N R 13 E

TYPE MONUMENT P.K./WASHER

*Set P.K./WASHER*


ON SURFACE - BELOW

*8-27-85 SWS*


~~LEFT -~~ 0.3 ~~PAV'T. - RIGHT~~

9.1 TO ~~LT~~ EDGE PAVEMENT

S.L.M. 106 + 25.47

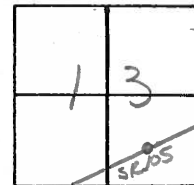

P.I. Δ LT. 0°-30'-48"

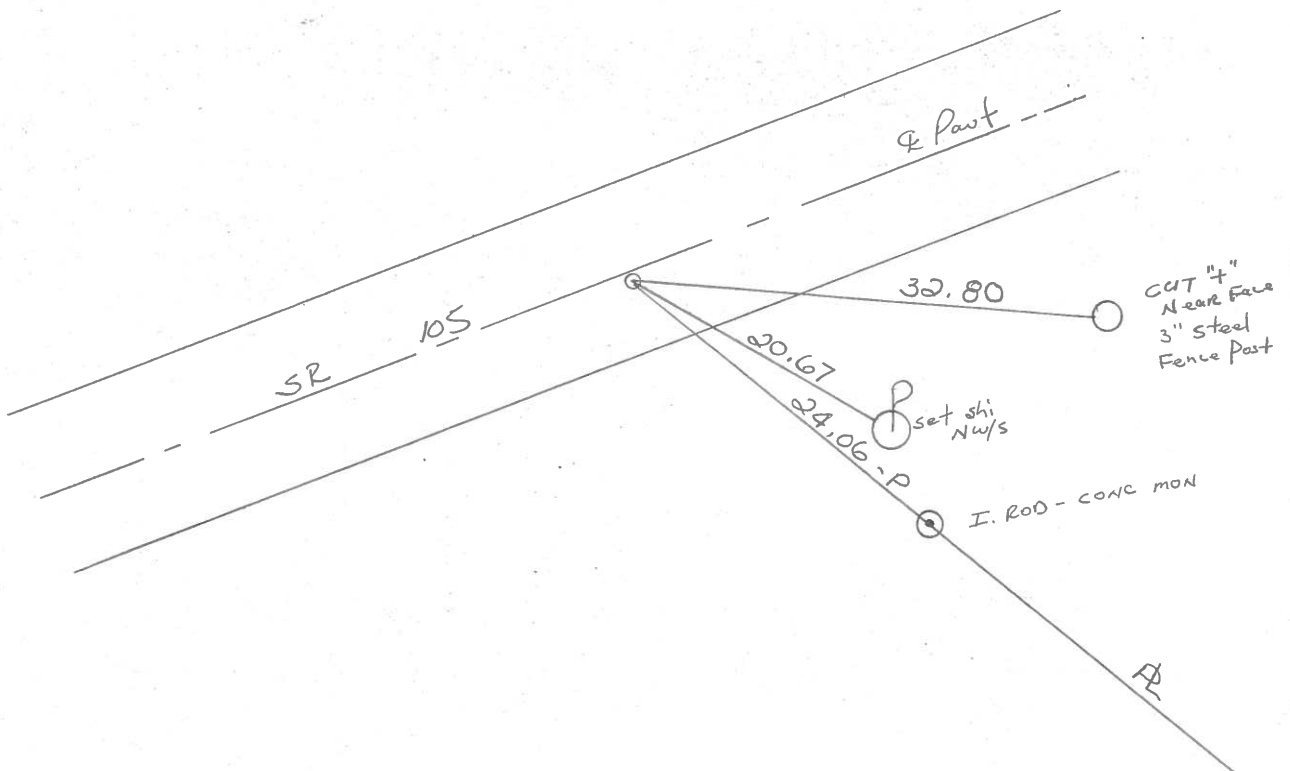



PERSONNEL TITLE PERSONNEL TITLE

COUNTY Ottawa DATE 8-7-74

S. R. 105 WEATHER Sunny

SEC. 13 TEMP. 80°

DESCRIPTION Harris Twp. JOB NO.

