

O.D.O.T. DISTRICT 2 SURVEY OFFICE (USE ONLY)

PERSONNEL _____ REFERENCE NO. 23 SHEET 25 OF 33
 NOTES RHOADES DATE 7/21/21 ROUTE SR 105
 H.C. O'DONNELL WEATHER CLOUDY COUNTY OTTAWA
 R.C. RHOADES TEMP. 65° TOWNSHIP HARRIS
 DWG BY RHOADES PID CHIP SEAL SECTION 13
 T 6 N R 13 E

TYPE MONUMENT MAG/WASHER

ON SURFACE - ~~BELOW~~ ON _____

OFFSET \odot PAVEMENT 0.2' ~~LT~~ : RT

8.6' TO LT EDGE PAVEMENT


STATION: 115+08

HORIZ.DATUM: NAD83 2011


GEOID: NAVD88 2018

GRID: NORTHING: 659930.395

EASTING: 1747835.772

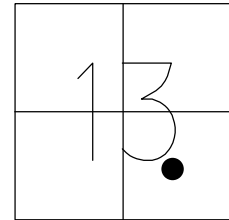


RECORD: P.I.
 STA. 114+78.98
 $\Delta = 0^{\circ}12' 00''$ RT
 SET P.K./WASHER
 10/12/94, MB
 FD P.K./WASHER
 OTTREF24
 5/3/13, DCH
 SET MAG/WASHER
 FINREFOTT23
 7/11/13, SDC
 FD MAG/WASHER
 REF23
 7/21/21, JFO
 10/20/21, JMR

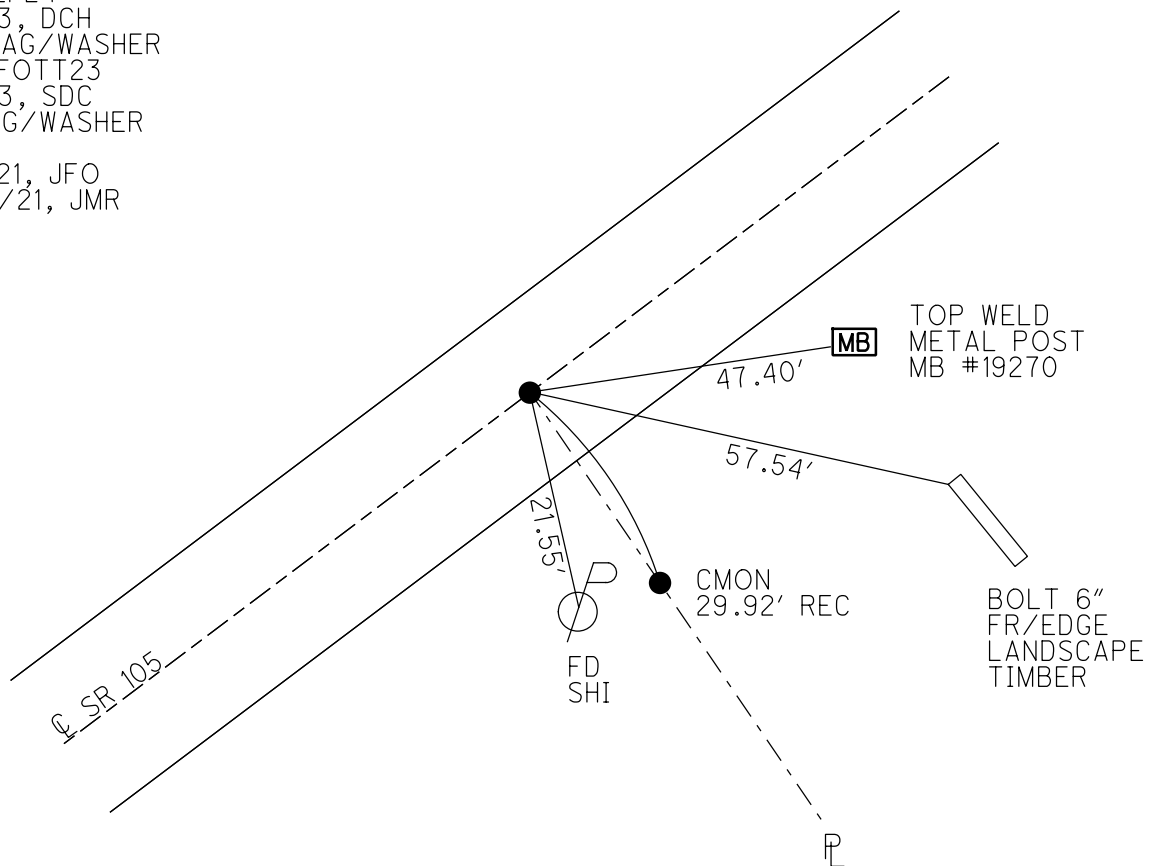

O.D.O.T. DISTRICT 2 SURVEY OFFICE (USE ONLY)

PERSONNEL	REFERENCE NO. <u>23</u>	SHEET <u>25</u> OF <u>33</u>
NOTES <u>HOMAN</u>	DATE <u>5/3/13</u>	ROUTE <u>SR 105</u>
H.C. <u>HOMAN</u>	WEATHER <u>SUNNY</u>	COUNTY <u>OTTAWA</u>
R.C. <u>ROUSOS</u>	TEMP. <u>75°</u>	TOWNSHIP <u>HARRIS</u>
		SECTION <u>13</u>
		T <u>6</u> N R <u>13</u> E

TYPE MONUMENT P.K./WASHER
 ON SURFACE - ~~BELOW~~ ON
~~LEFT~~ - C PAV'T - RIGHT 0.2'
8.6' TO LT EDGE PAVEMENT
 S.L.M. 115+08
 Grid: Northing: 659930.443 Easting: 1747835.729

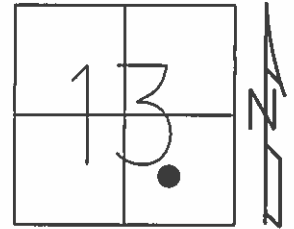


RECORD: P.I.
 $\Delta = 0^\circ 12' 00''$ RT
 SLM: 114+78.98

RESET P.K./WASHER
 10/12/94, MB

FD P.K./WASHER
 GPS, OTTREF24

SET MAG/WASHER
 7/10/13, SDC
 GPS, FINREFOTT23
 7/11/13, SDC

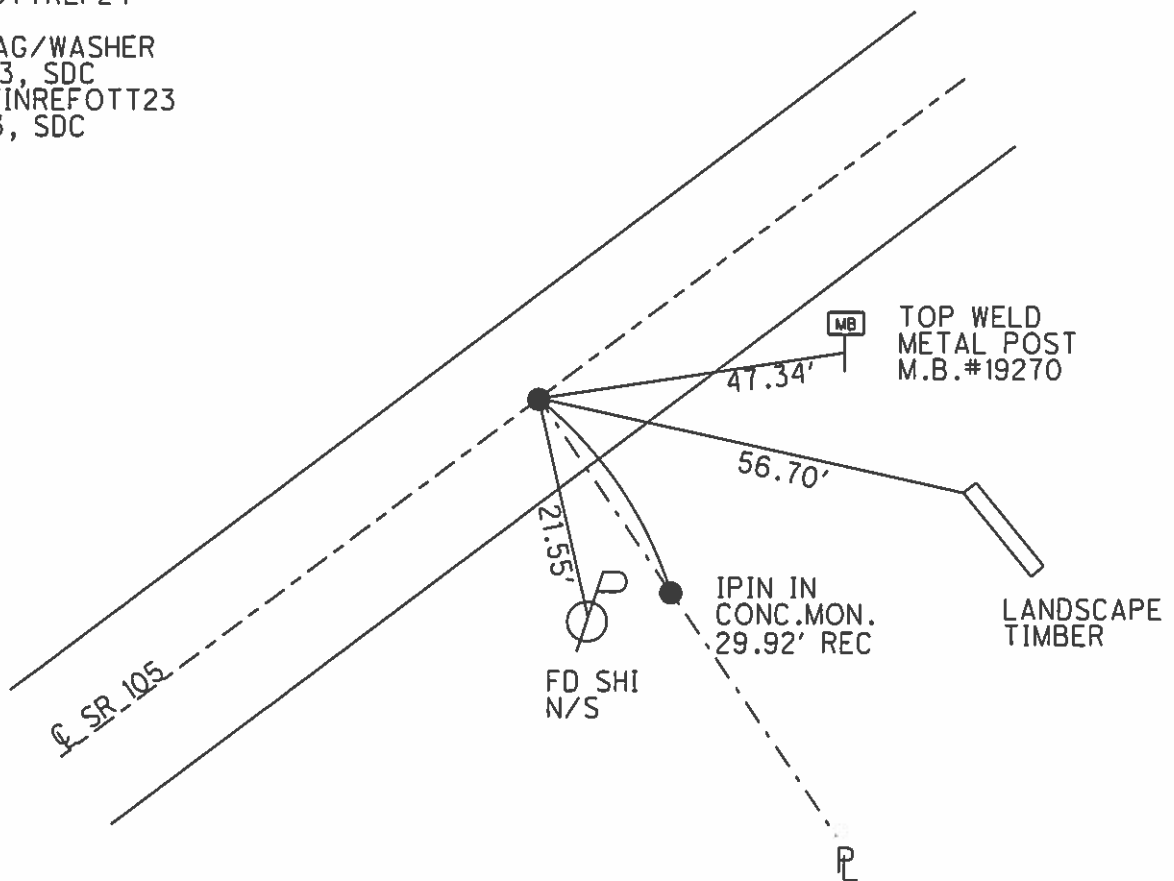

O.D.O.T. DISTRICT 2 SURVEY OFFICE

PERSONNEL _____

REFERENCE NO. 23

SHEET 20 OF 26

NOTES BARNHISEL

H.C. CORDES

R.C. SLOVAK

DATE 9-15-94

WEATHER SUNNY

TEMP. +81°

ROUTE 105

COUNTY OTTAWA

TOWNSHIP HARRIS

SECTION 13

T 6 N R 13 E


TYPE MONUMENT P.K. & WASHER

ON SURFACE - ~~BELOW~~ yes

~~SET~~ - & PAV'T. - RIGHT 0.2


8.6 TO LT EDGE PAVEMENT

S.L.M. 115+08

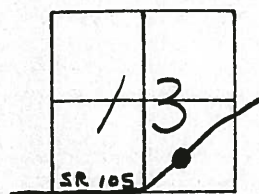

RECORD: P.I. $\Delta = 0^\circ-12'-00''$ RT
114+78.98

Pre-set P.K. & WASHER
10-12-94
MB

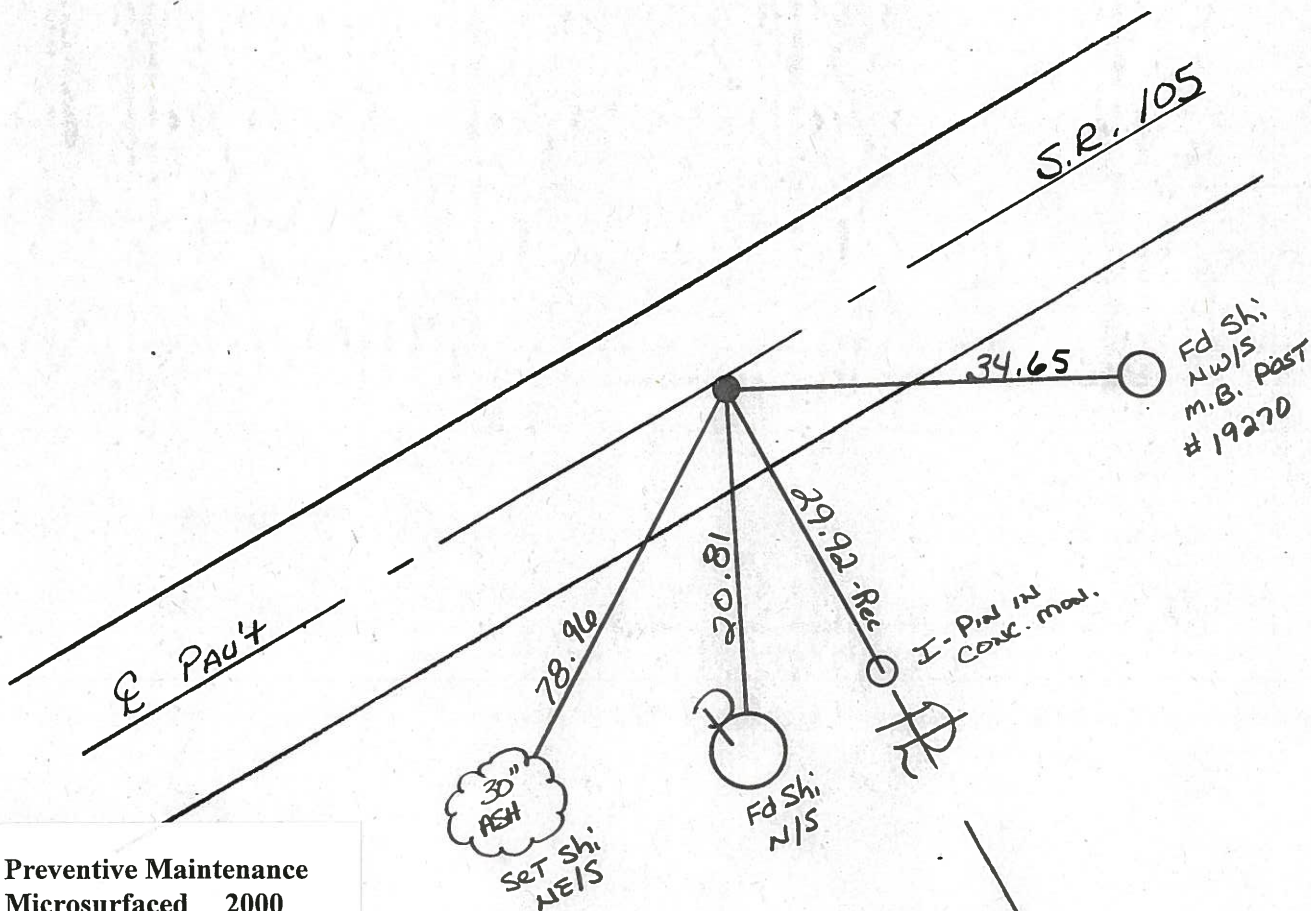

Preventive Maintenance
Microsurfaced 2000
Existing Point Uncovered
Date 5-8-2000

O.D.O.T. DISTRICT 2 SURVEY OFFICE

PERSONNEL

REFERENCE NO. 23

SHEET 8 OF 27

NOTES Hoffman

H.C. LOSHKEE

R.C. BARNHISEL

DATE 5-1-85

WEATHER cloudy

TEMP. 60°

ROUTE SR 105

COUNTY OTTAWA

TOWNSHIP HARRIS

SECTION 13

T. 6 N. R. 13 E.


TYPE MONUMENT P.K./WASHER Set P.K./WASHER

ON SURFACE - ~~BELOW~~ Yes 8-27-85 SWH


LEFT - & PAV'T. - RIGHT 0.2

8.6 TO LT EDGE PAVEMENT

S.L.M. 114 + 78.98

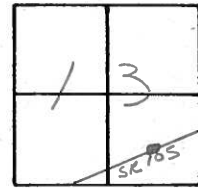

P.I. Δ RT. $00^{\circ}-12'-00''$

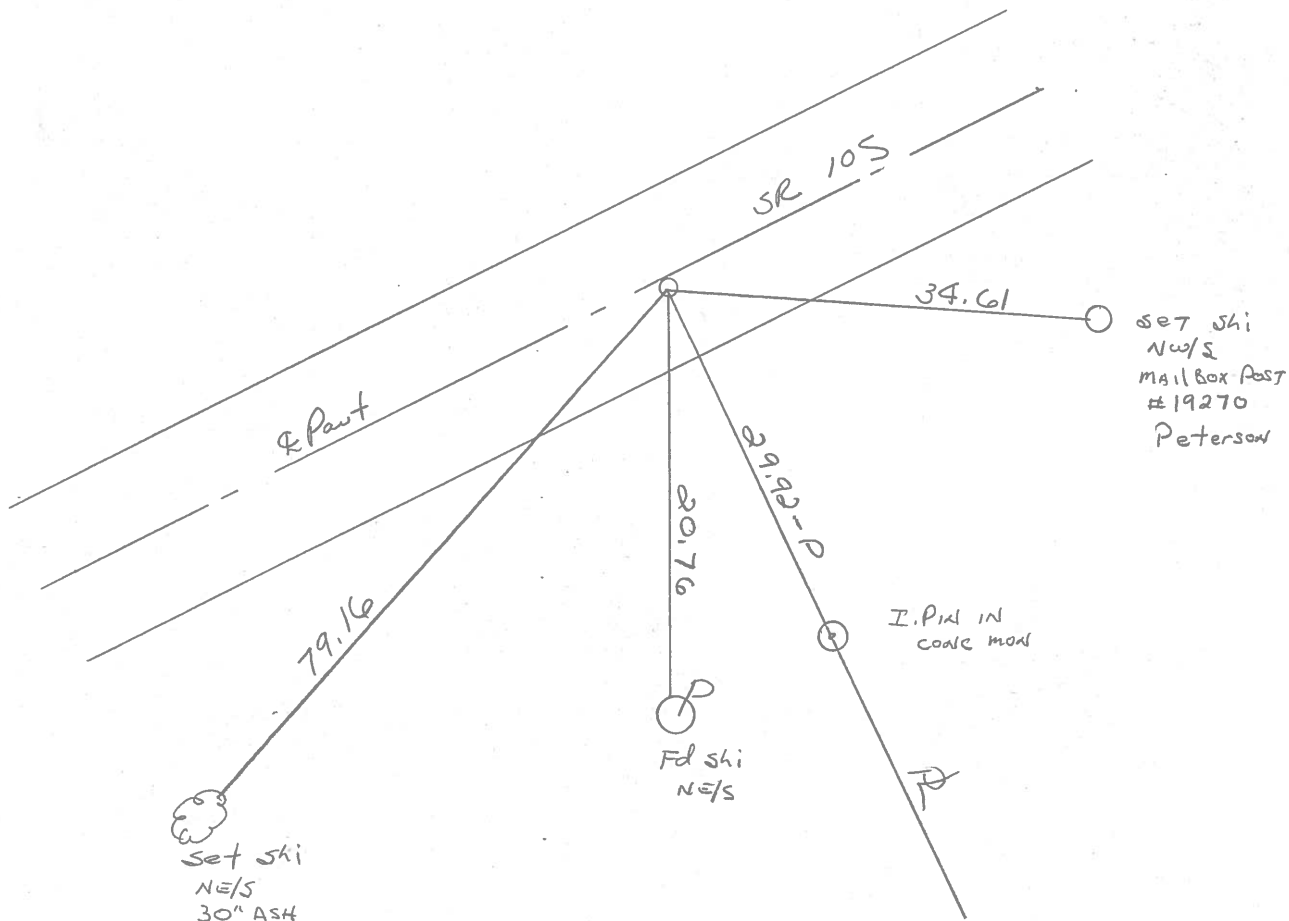

PERSONNEL TITLE PERSONNEL TITLE


COUNTY Ottawa DATE 8-7-74

S. R. 105 WEATHER Sunny

SEC. 13 TEMP. 80°


DESCRIPTION Harris Twp. JOB NO.

LEFT CENTER LINE RIGHT

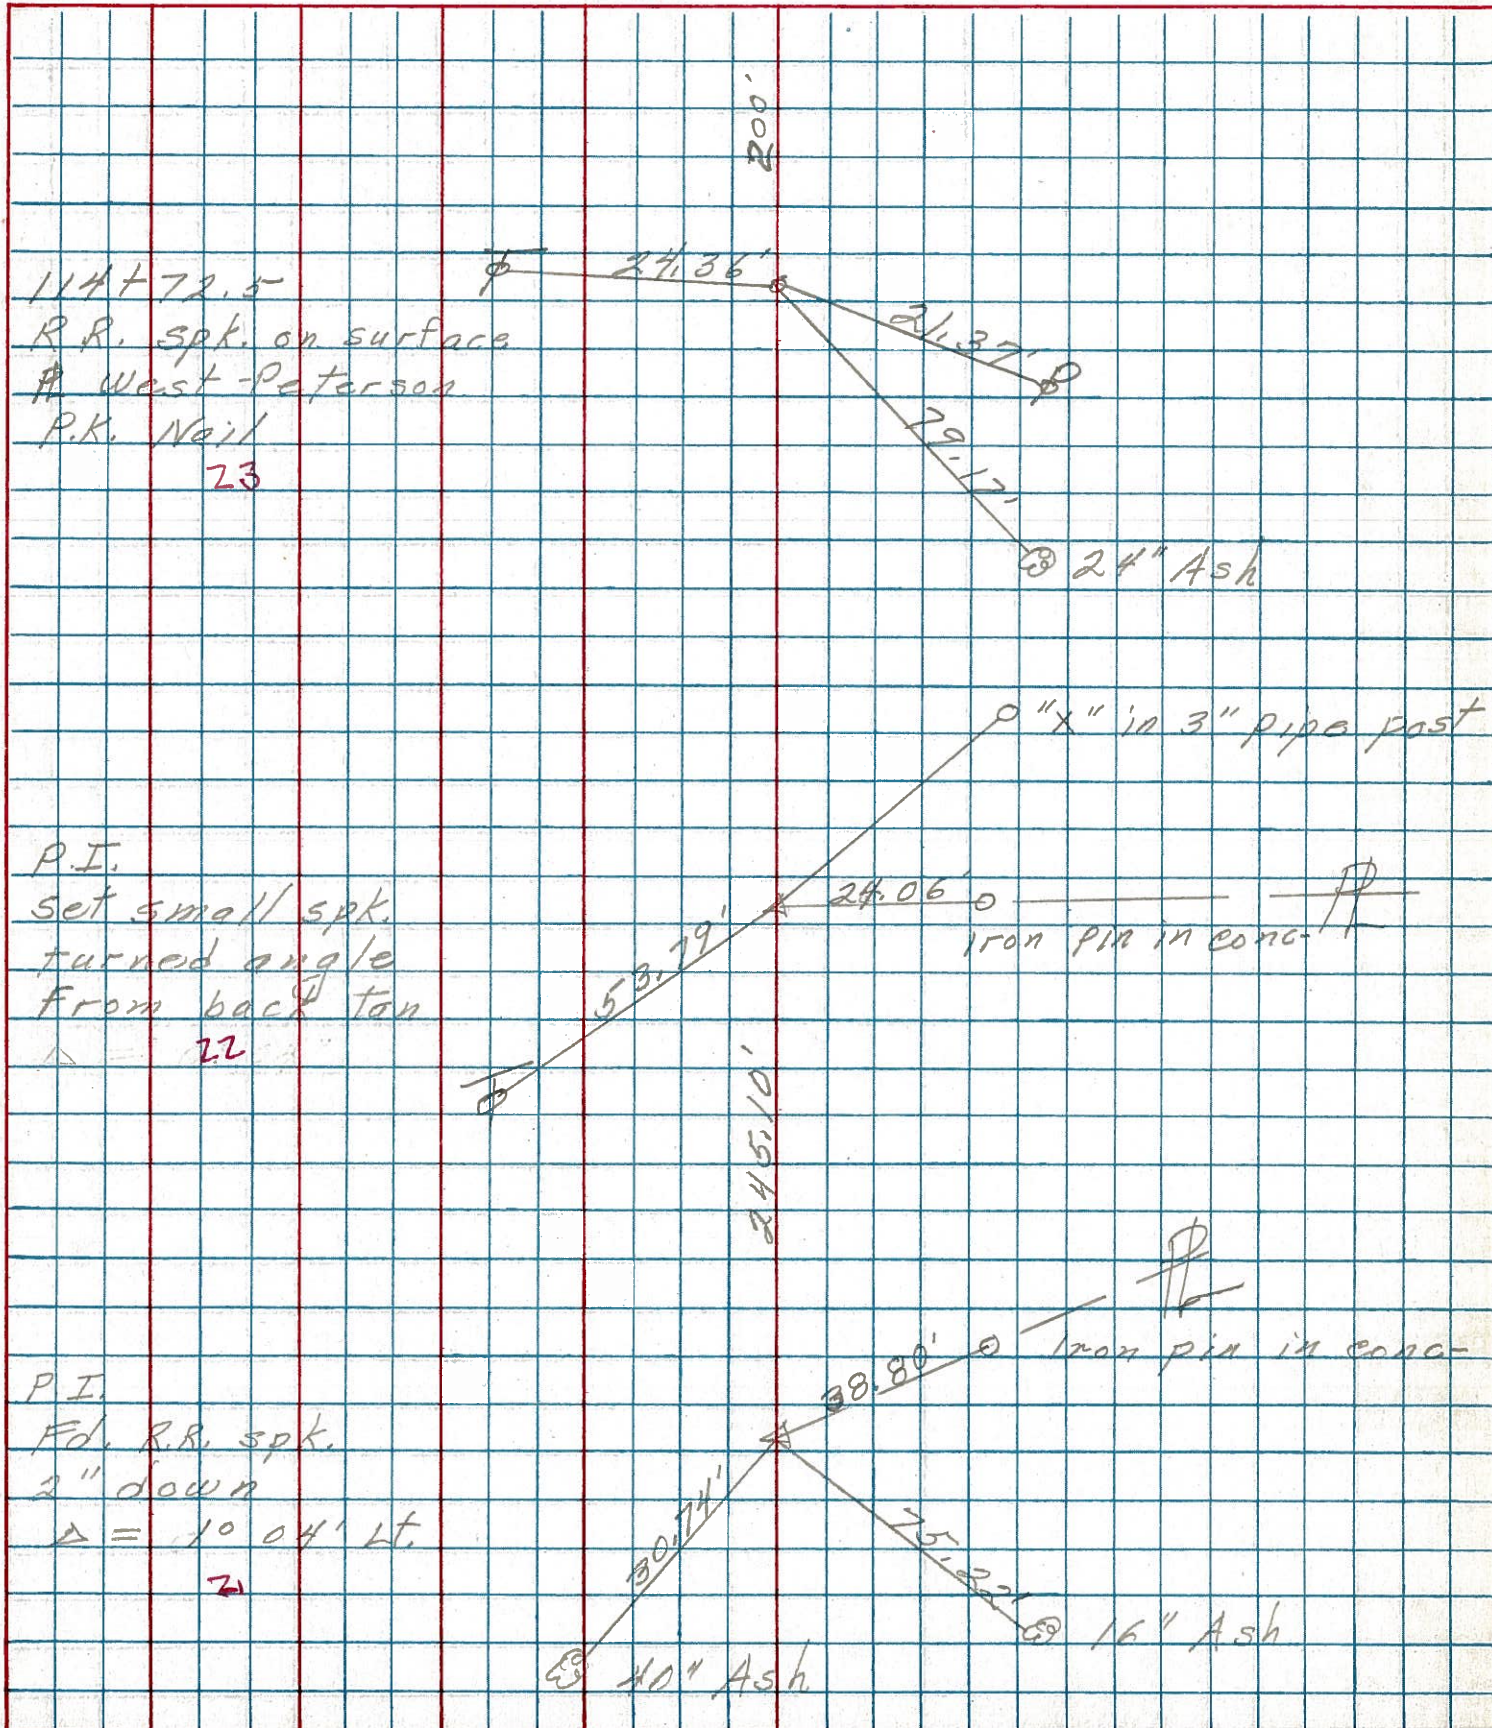

PERSONNEL	TITLE	PERSONNEL	TITLE	COUNTY	DATE	WEATHER
MOSSER				OTTAWA	8-18-71	SUNNY
BARBOUR				S. R.	105	
GEYMAN				SEC	OT. CO. LINE TO HARBAR	TEMP 65°
VINSON						

DESCRIPTION TIES FOR CONTROL POINTS JOB NO. _____

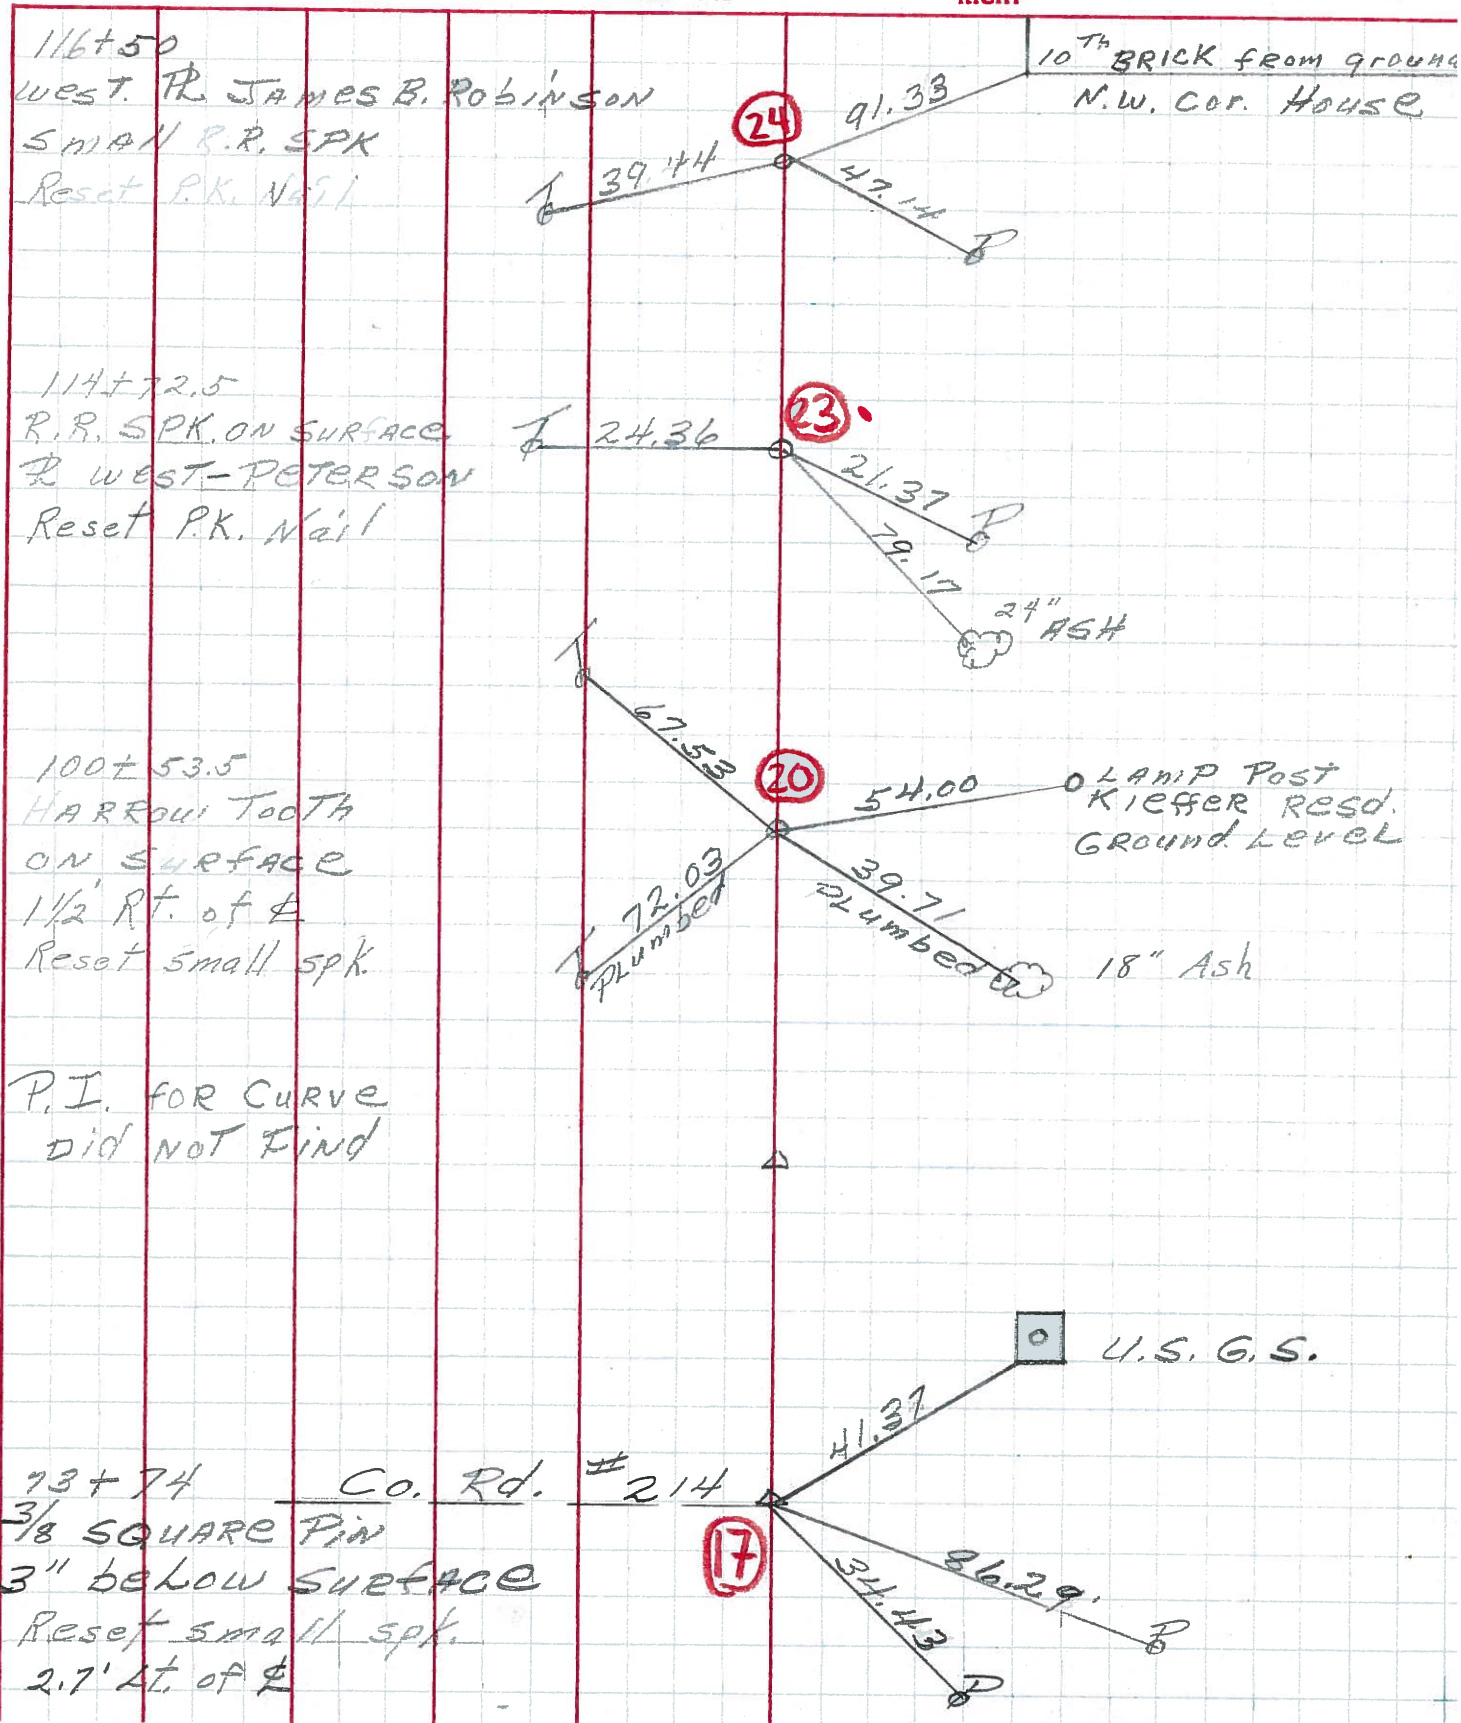

116+50
West. R. JAMES B. ROBINSON
SMALL R.R. SPK
Reset P.K. Nail

114+72.5
R.R. SPK. ON SURFACE
R. WEST-PETERSON
Reset P.K. Nail

100+53.5
HARROW TOOTH
ON SURFACE
1/2' Rt. of ϕ
Reset small spk.

P.I. FOR CURVE
DID NOT FIND

73+74 Co. Rd. # 214
3/8 SQUARE PIN
3" BELOW SURFACE
Reset small spk.
2.7' Lt. of ϕ

10TH BRICK from ground
N.W. COR. HOUSE

LAMP POST
KIEFFER RESD.
GROUND LEVEL

U.S.G.S.

18" Ash

24" ASH