


O.D.O.T. DISTRICT 2 SURVEY OFFICE (USE ONLY)


PERSONNEL _____ REFERENCE NO. 26 SHEET 29 OF 33
 NOTES RHOADES DATE 7/21/21 ROUTE SR 105
 H.C. O'DONNELL WEATHER CLOUDY COUNTY OTTAWA
 R.C. RHOADES TEMP. 65° TOWNSHIP HARRIS
 DWG BY RHOADES PID CHIP SEAL SECTION 13
 T 6 N R 13 E

TYPE MONUMENT MAG/WASHER
 ON SURFACE - ~~BELOW~~ ON
 OFFSET 4.5' \perp PAVEMENT 5.5' LT : ~~RT~~
4.5' TO LT EDGE PAVEMENT
 STATION: 124+38

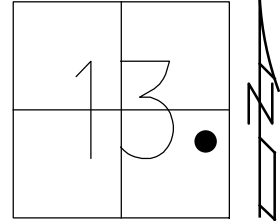

HORZ. DATUM: NAD83 2011 GEOID: NAVD88 2018
 GRID: NORTHING: 660465.327 EASTING: 1748612.060


RECORD: P.I.
 STA. 124+38
 $\Delta = 12^\circ 29' 18''$ RT
 SET P.K./WASHER
 10/12/94, MB
 FD P.K./WASHER
 OTTREF28
 5/7/13, DCH
 SET MAG/WASHER
 FINREFOTT26
 7/11/13, SDC
 FD MAG/WASHER
 REF26
 7/21/21, JFO
 10/20/21, JMR

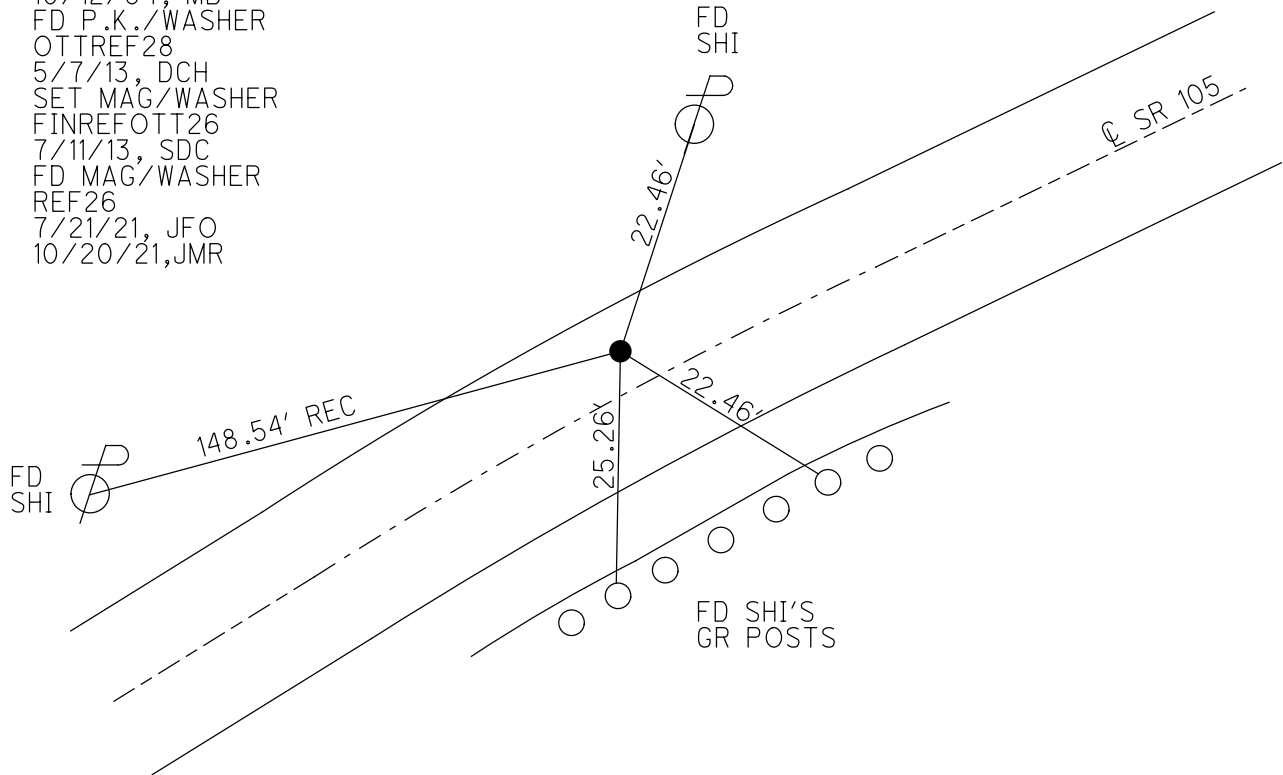

O.D.O.T. DISTRICT 2 SURVEY OFFICE (USE ONLY)

PERSONNEL	REFERENCE NO. <u>26</u>	SHEET <u>29</u> OF <u>33</u>
NOTES <u>RHOADES</u>	DATE <u>7/11/13</u>	ROUTE <u>SR 105</u>
H.C. <u>CODER</u>	WEATHER <u>SUNNY</u>	COUNTY <u>OTTAWA</u>
R.C. <u>RHOADES</u>	TEMP. <u>75°</u>	TOWNSHIP <u>HARRIS</u>
		SECTION <u>13</u>
		T. <u>6</u> N R. <u>13</u> E

TYPE MONUMENT MAG/WASHER
 ON SURFACE - ~~BELOW~~ ON _____
 LEFT - Q PAV'T - ~~RIGHT~~ 5.5'
4.5' TO LT EDGE PAVEMENT
 S.L.M. 124+38

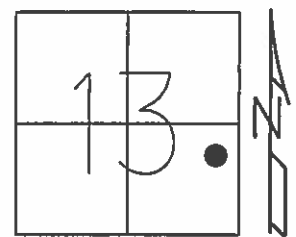


Grid: Northing: 660465.389 Easting: 1748611.981

RECORD: P.I.
 $\Delta = 12^\circ 29' 18''$ RT
 SLM: 124+38

RESET P.K./WASHER
 10/12/94, MB

FD P.K./WASHER
 GPS, OTTREF28

SET W/GPS
 SET MAG/WASHER
 GPS, FINREFOTT26
 7/11/13, SDC

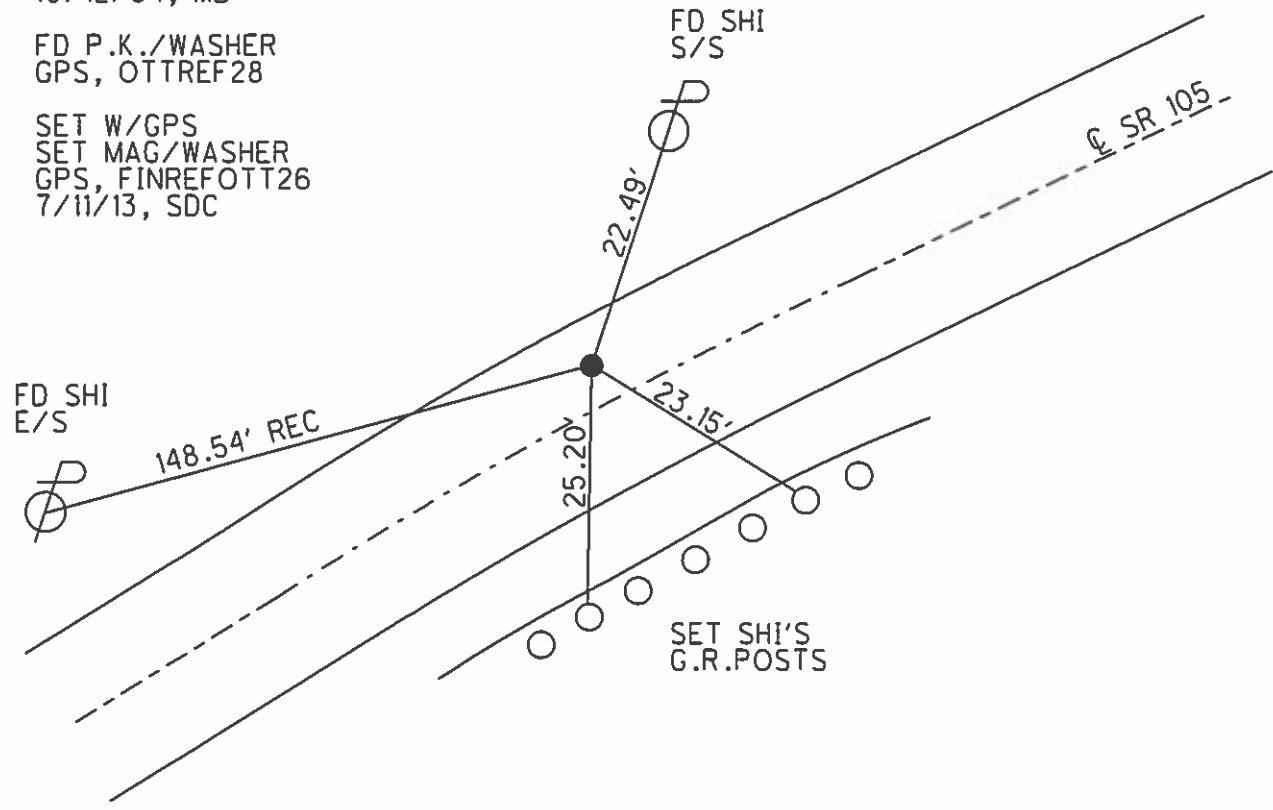

O.D.O.T. DISTRICT 2 SURVEY OFFICE

PERSONNEL _____

REFERENCE NO. 26

SHEET 24 OF 26

NOTES BARNHISEL

H.C. CORDES

R.C. SLOVAK

DATE 9-15-94

WEATHER SUNNY

TEMP. +81°

ROUTE 105

COUNTY OTTAWA

TOWNSHIP HARRIS

SECTION 13

T 6 N R 13 E


TYPE MONUMENT P.K. & WASHER

~~ON~~ SURFACE - BELOW 1 1/2

LEFT - 0 PAV'T. - RIGHT 4.0


3.9 TO LT EDGE PAVEMENT

S.L.M. 124+38

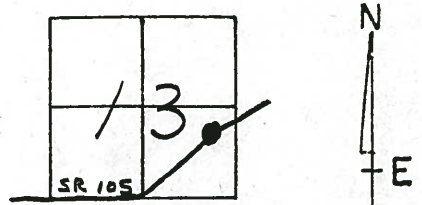

Record: P.I. $\Delta = 12^{\circ} - 29' - 18''$ RT
124+21.92

Reset P.K. & WASHER
10-12-94
M.B.

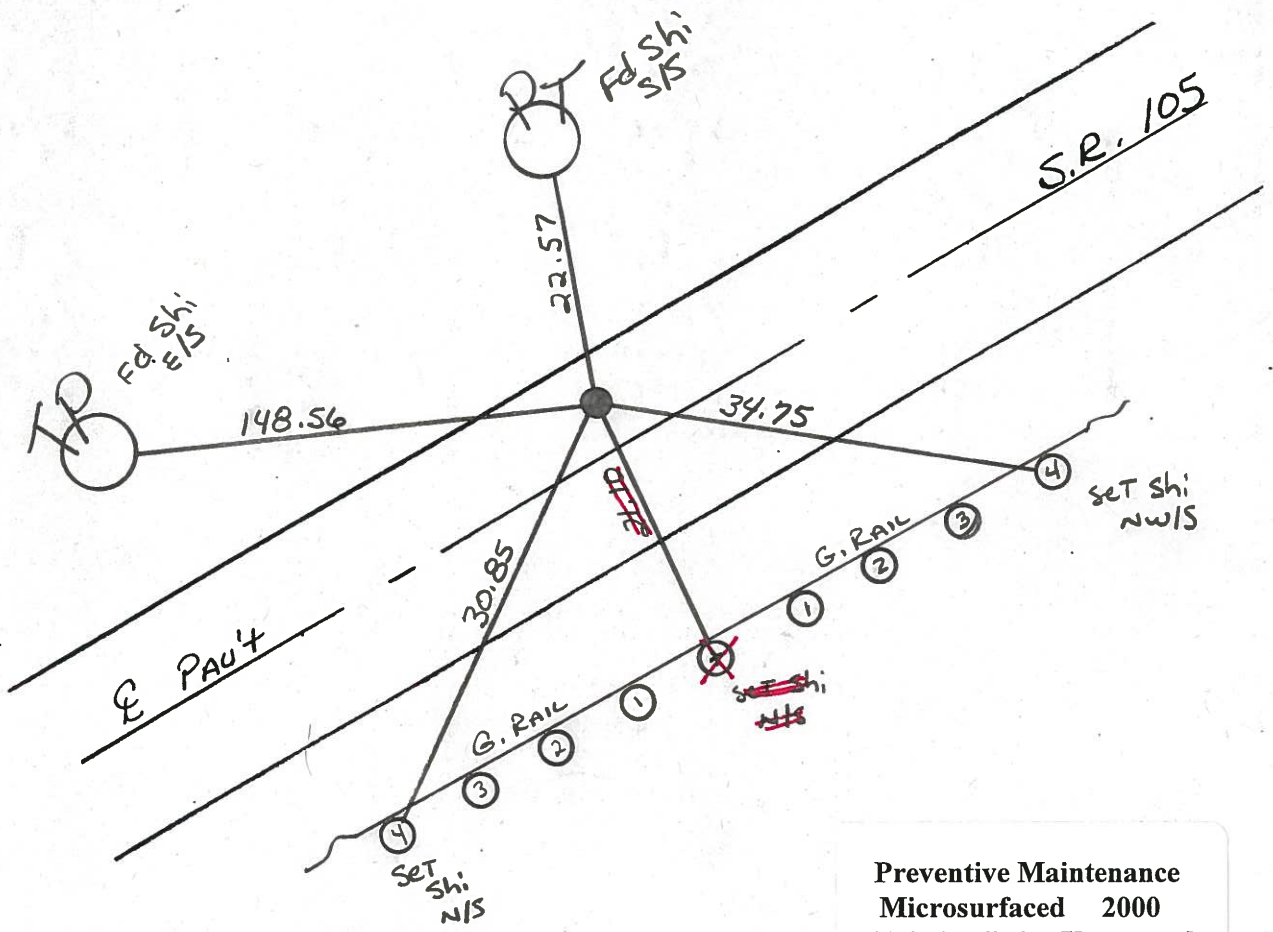

Preventive Maintenance
Microsurfaced 2000
Existing Point Uncovered
Date 5-8-2000

O.D.O.T. DISTRICT 2 SURVEY OFFICE

PERSONNEL _____

REFERENCE NO. 26

SHEET 11 OF 27

NOTES Hoffman

H.C. "

DATE 2-20-86

ROUTE SR 105

R.C. LOEHRKE

WEATHER OVERCAST

COUNTY OTTAWA

TEMP. 35°

TOWNSHIP HARRIS

SECTION 13

T6 N R 13 E


TYPE MONUMENT P.K./WASHER

ON SURFACE - ~~BELOW~~ yes

LEFT - ~~PAV'T.~~ - RIGHT 6.9'


2.0' TO LT. EDGE PAVEMENT

S.L.M. 124+22 (Resurfacing Sta.)

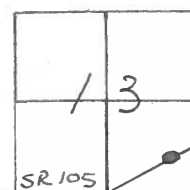

P.I. Δ Rt. 12°-29'-18"

STA. 124+21.92

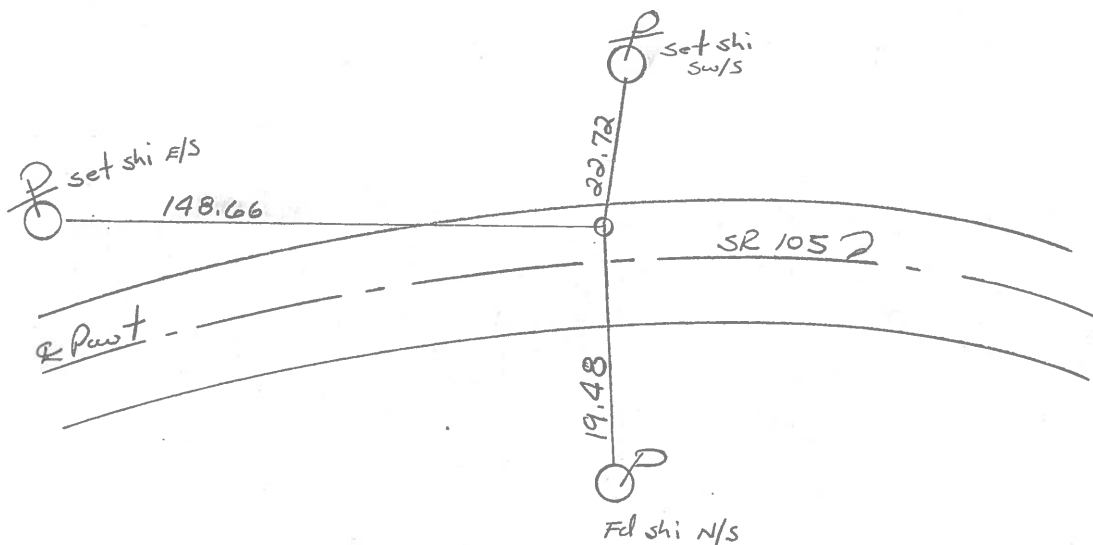

PERSONNEL TITLE PERSONNEL TITLE

COUNTY Ottawa DATE 8-8-74

S. R. 105 WEATHER cloudy

SEC. 13 TEMP. 85°

DESCRIPTION Harris Twp. JOB NO.

LEFT CENTER LINE RIGHT

