


O.D.O.T. DISTRICT 2 SURVEY OFFICE (USE ONLY)


PERSONNEL _____ REFERENCE NO. 27 SHEET 31 OF 33
 NOTES RHOADES DATE 7/21/21 ROUTE SR 105
 H.C. O'DONNELL WEATHER CLOUDY COUNTY OTTAWA
 R.C. RHOADES TEMP. 65° TOWNSHIP HARRIS
 _____ SECTION 13
 DWG BY RHOADES PID CHIP SEAL T 6 N R 13 E

TYPE MONUMENT MAG/WASHER
 ON SURFACE - ~~BELOW~~ ON
 OFFSET \odot PAVEMENT 4.1' LT : RT
6.0' TO RT EDGE PAVEMENT
 STATION: 128+27

HORIZ.DATUM: NAD83 2011 GEOID: NAVD88 2018
 GRID: NORTHING: 660601.623 EASTING: 1748963.180

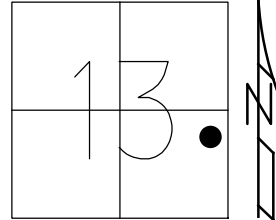


RECORD: P.I.
 STA. 127+97.68
 $\Delta = 3^{\circ}43'40''$ RT
 SET P.K./WASHER
 9/15/94, MB
 FD P.K./WASHER
 OTTREF29
 5/7/13, DCH
 SET MAG/WASHER
 FINREFOTT27
 7/11/13, SDC
 FD MAG/WASHER
 REF27
 7/21/21, JFO
 10/20/21, JMR

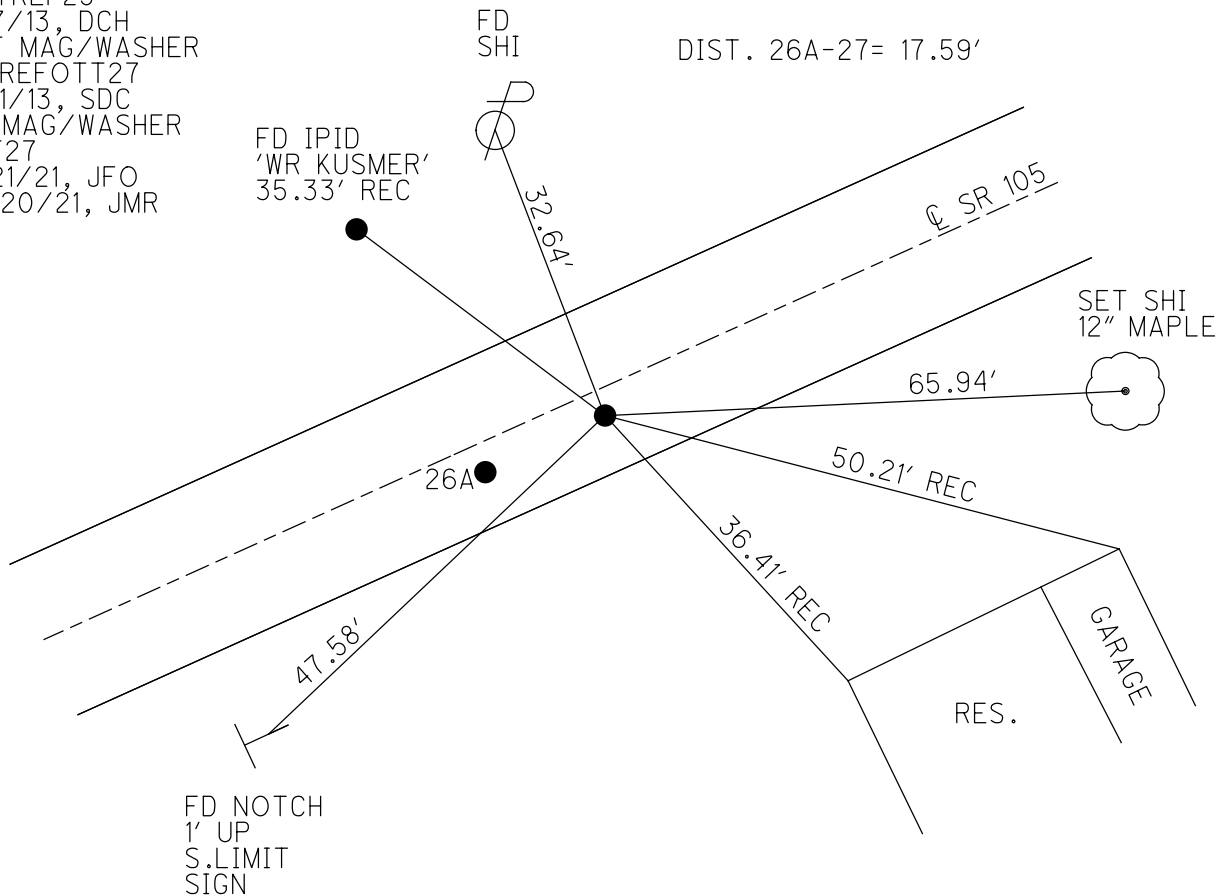

O.D.O.T. DISTRICT 2 SURVEY OFFICE (USE ONLY)

PERSONNEL	REFERENCE NO. <u>27</u>	SHEET <u>31</u> OF <u>33</u>
NOTES <u>HOMAN</u>	DATE <u>5/7/13</u>	ROUTE <u>SR 105</u>
H.C. <u>HOMAN</u>	WEATHER <u>CLEAR</u>	COUNTY <u>OTTAWA</u>
R.C. <u>ROUSOS</u>	TEMP. <u>70°</u>	TOWNSHIP <u>HARRIS</u>
		SECTION <u>13</u>
		T <u>6</u> N R <u>13</u> E

TYPE MONUMENT P.K./WASHER
 ON SURFACE - ~~BELOW~~ ON
~~LEFT~~ - CL PAV'T - RIGHT 4.1'
6.0' TO RT EDGE PAVEMENT
 S.L.M. 128+27

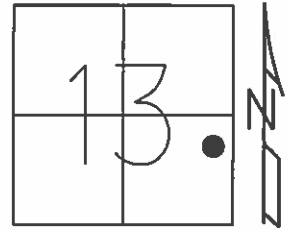


Grid: Northing: 660601.656 Easting: 1748963.105

RECORD: P.I.
 $\Delta = 3^{\circ} 43' 40''$ RT
 SLM: 127+97.68

RESET P.K./WASHER
 9/15/94, MB

FD P.K./WASHER
 GPS, OTTREF29

SET MAG/WASHER
 7/10/13, SDC
 GPS, FINREFOTT27
 7/11/13, SDC

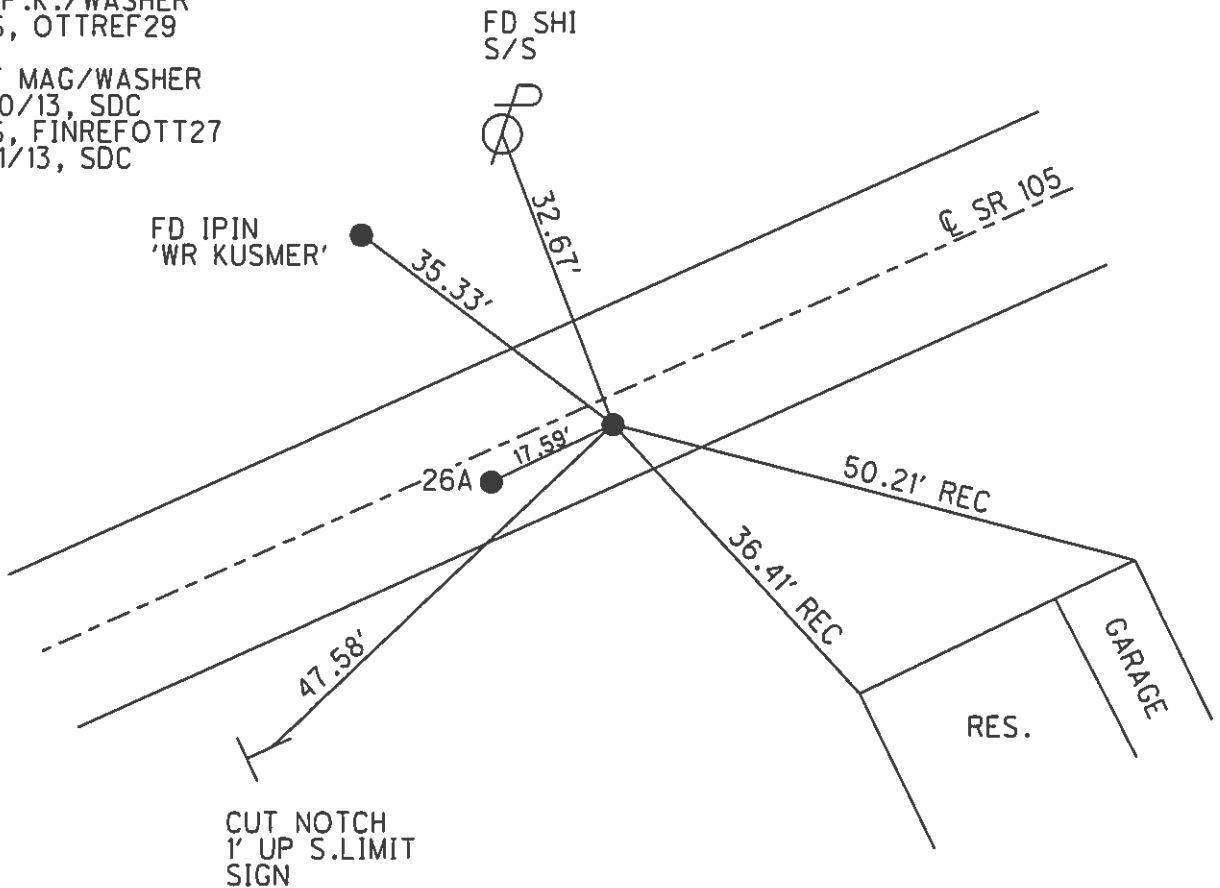

O.D.O.T. DISTRICT 2 SURVEY OFFICE

PERSONNEL

REFERENCE NO. 27

SHEET 25 OF 26

NOTES BARNHISEL

H.C. CORDES

DATE 9-15-94

ROUTE 105

R.C. SLOVAK

WEATHER SUNNY

COUNTY OTTAWA

TEMP. +81°

TOWNSHIP HARRIS

SECTION 13

T 6 N R 13 E


TYPE MONUMENT P.K. & WASHER

ON SURFACE - ~~NO~~ YES

~~EST~~ - E PAV'T. - RIGHT 4.1


6.0 TO RT EDGE PAVEMENT

S.L.M. 128+27

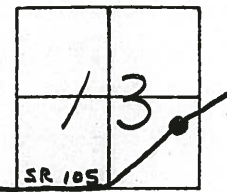

RECORD : P.I. $\Delta = 3^{\circ} 43' 40''$ LT
127+97.68

Reset P.K. & WASHER
9-15-94
MB

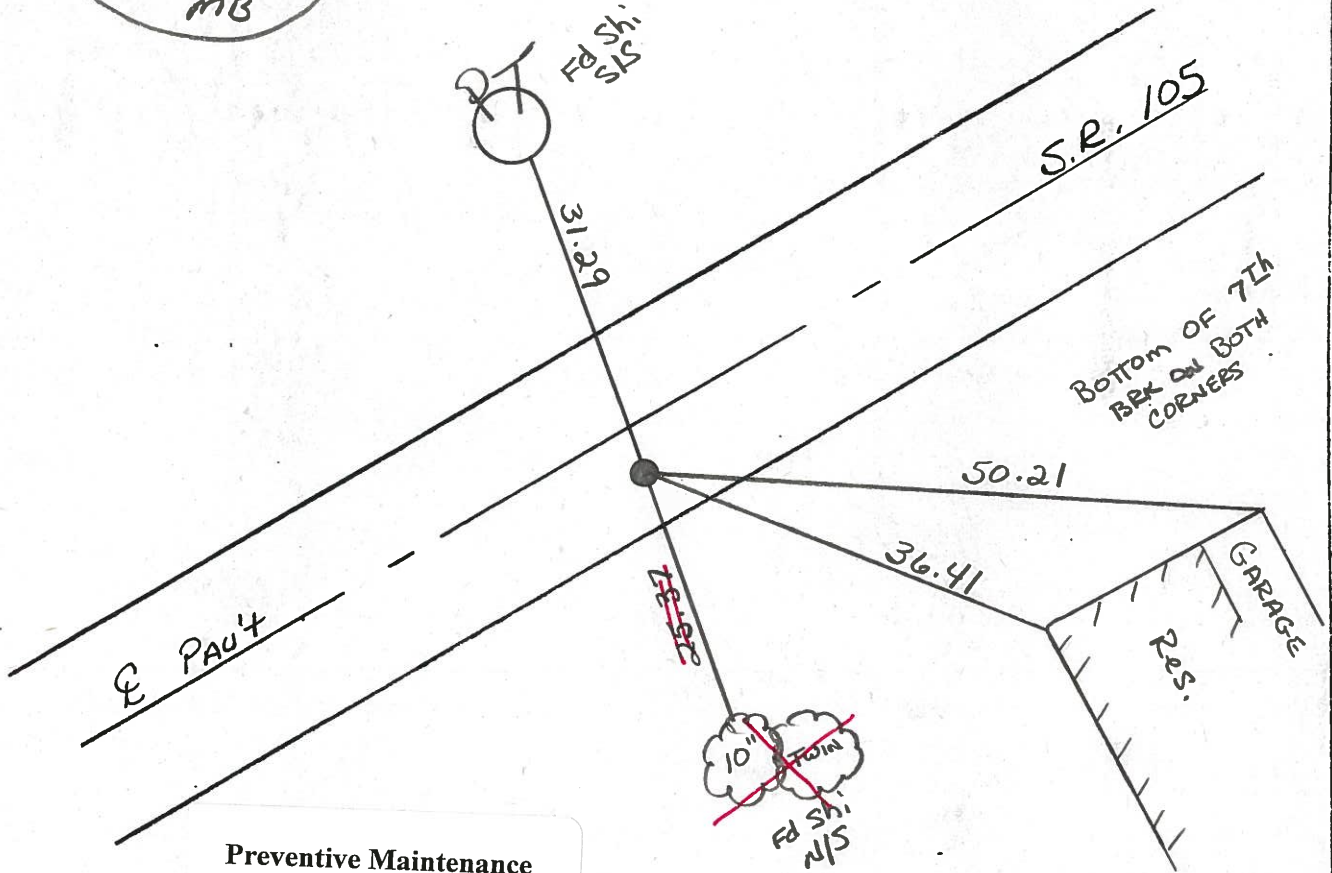

Preventive Maintenance
Microsurfaced 2000
Existing Point Uncovered
Date 5-8-2000

O.D.O.T. DISTRICT 2 SURVEY OFFICE

PERSONNEL _____

REFERENCE NO. 27

SHEET 12 OF 27

NOTES Hoffman

H.C. "

DATE 2-20-86

ROUTE 105

R.C. LOEHKE

WEATHER OVERCAST

COUNTY OTTAWA

TEMP. 35°

TOWNSHIP HARRIS

SECTION 13

T6 N R 13 E


TYPE MONUMENT P.K. / WASHER

ON SURFACE - BELOW yes

~~LEFT - C PAV'T.~~ - RIGHT 3.9'


4.9 TO RT EDGE PAVEMENT

S.L.M. 127+99 (Resurfacing Sta.)

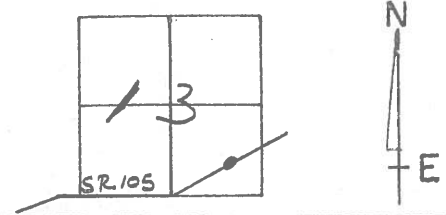

P.I. Δ Lt. 3° - 43' - 40"

STA. 127+97.68

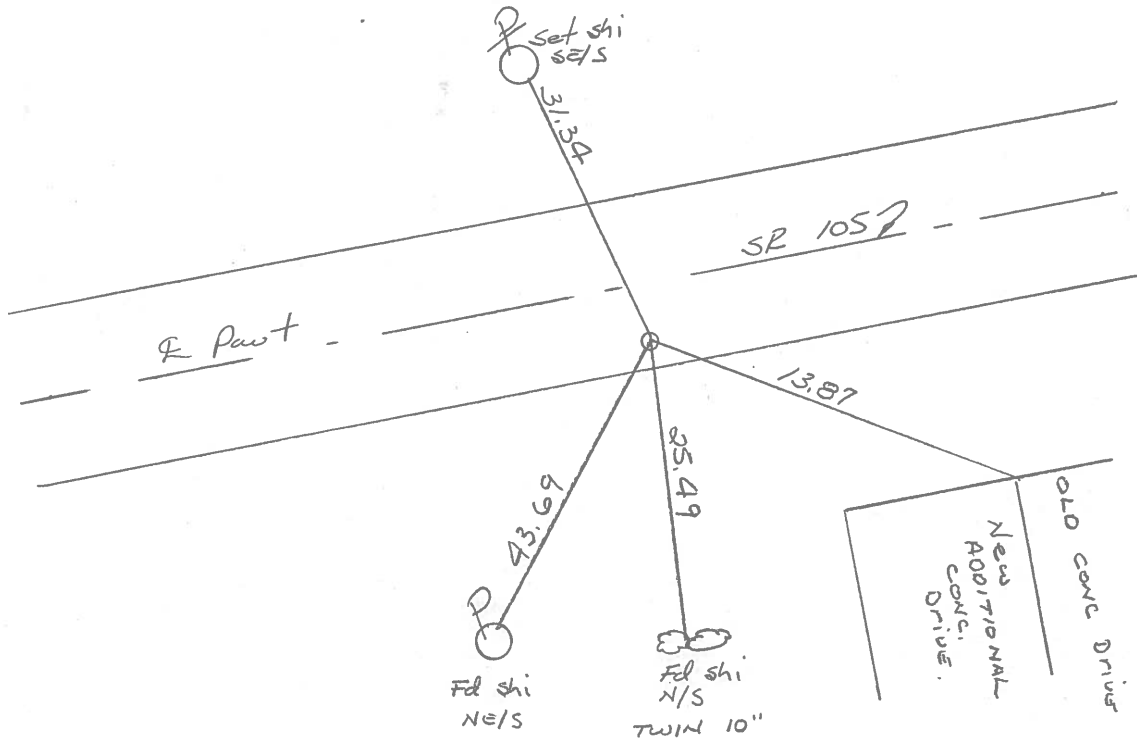

O.D.O.T. DISTRICT 2 SURVEY OFFICE

PERSONNEL

REFERENCE NO. 27

SHEET 12 OF 27

NOTES HOFFMAN

H.C. BARNHISEL

DATE April 17, 1985

ROUTE 105

R.C. LOEHRKE

WEATHER sleet

COUNTY OTTAWA

TEMP. +35°

TOWNSHIP HARRIS

SECTION 13

T.6 N R.13 E

TYPE MONUMENT P.I. / WASHER


Set P.I. / WASHER
7-16-85 SWH

ON SURFACE - BELOW yes


LEFT- & PAV'T. - RIGHT 3.9

4.9 TO RT EDGE PAVEMENT 13.0 TO LT. EP.

S.L.M. 127+99 (Resurfacing STATIONING)

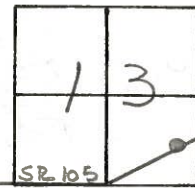

P.I. Δ LT. 3°-43' - 40"

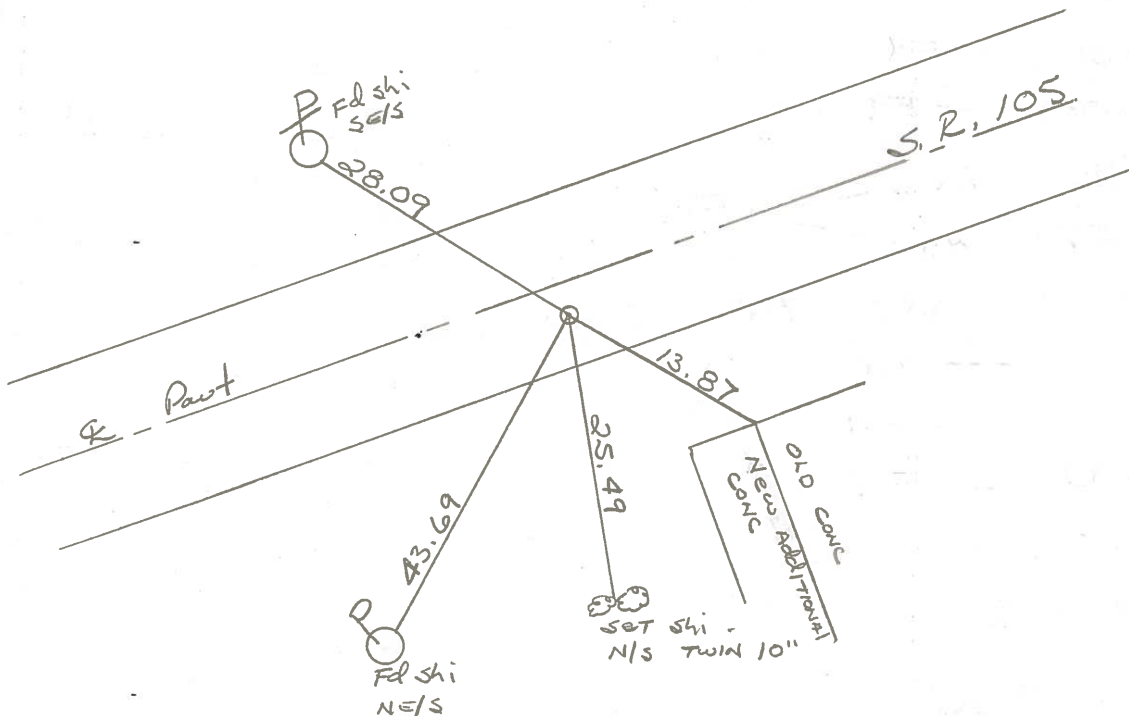


PERSONNEL TITLE PERSONNEL TITLE

COUNTY Ottawa DATE 8-8-74

S. R. 105 WEATHER cloudy

SEC. 13 TEMP. 85°

DESCRIPTION Harris Twp. JOB NO.

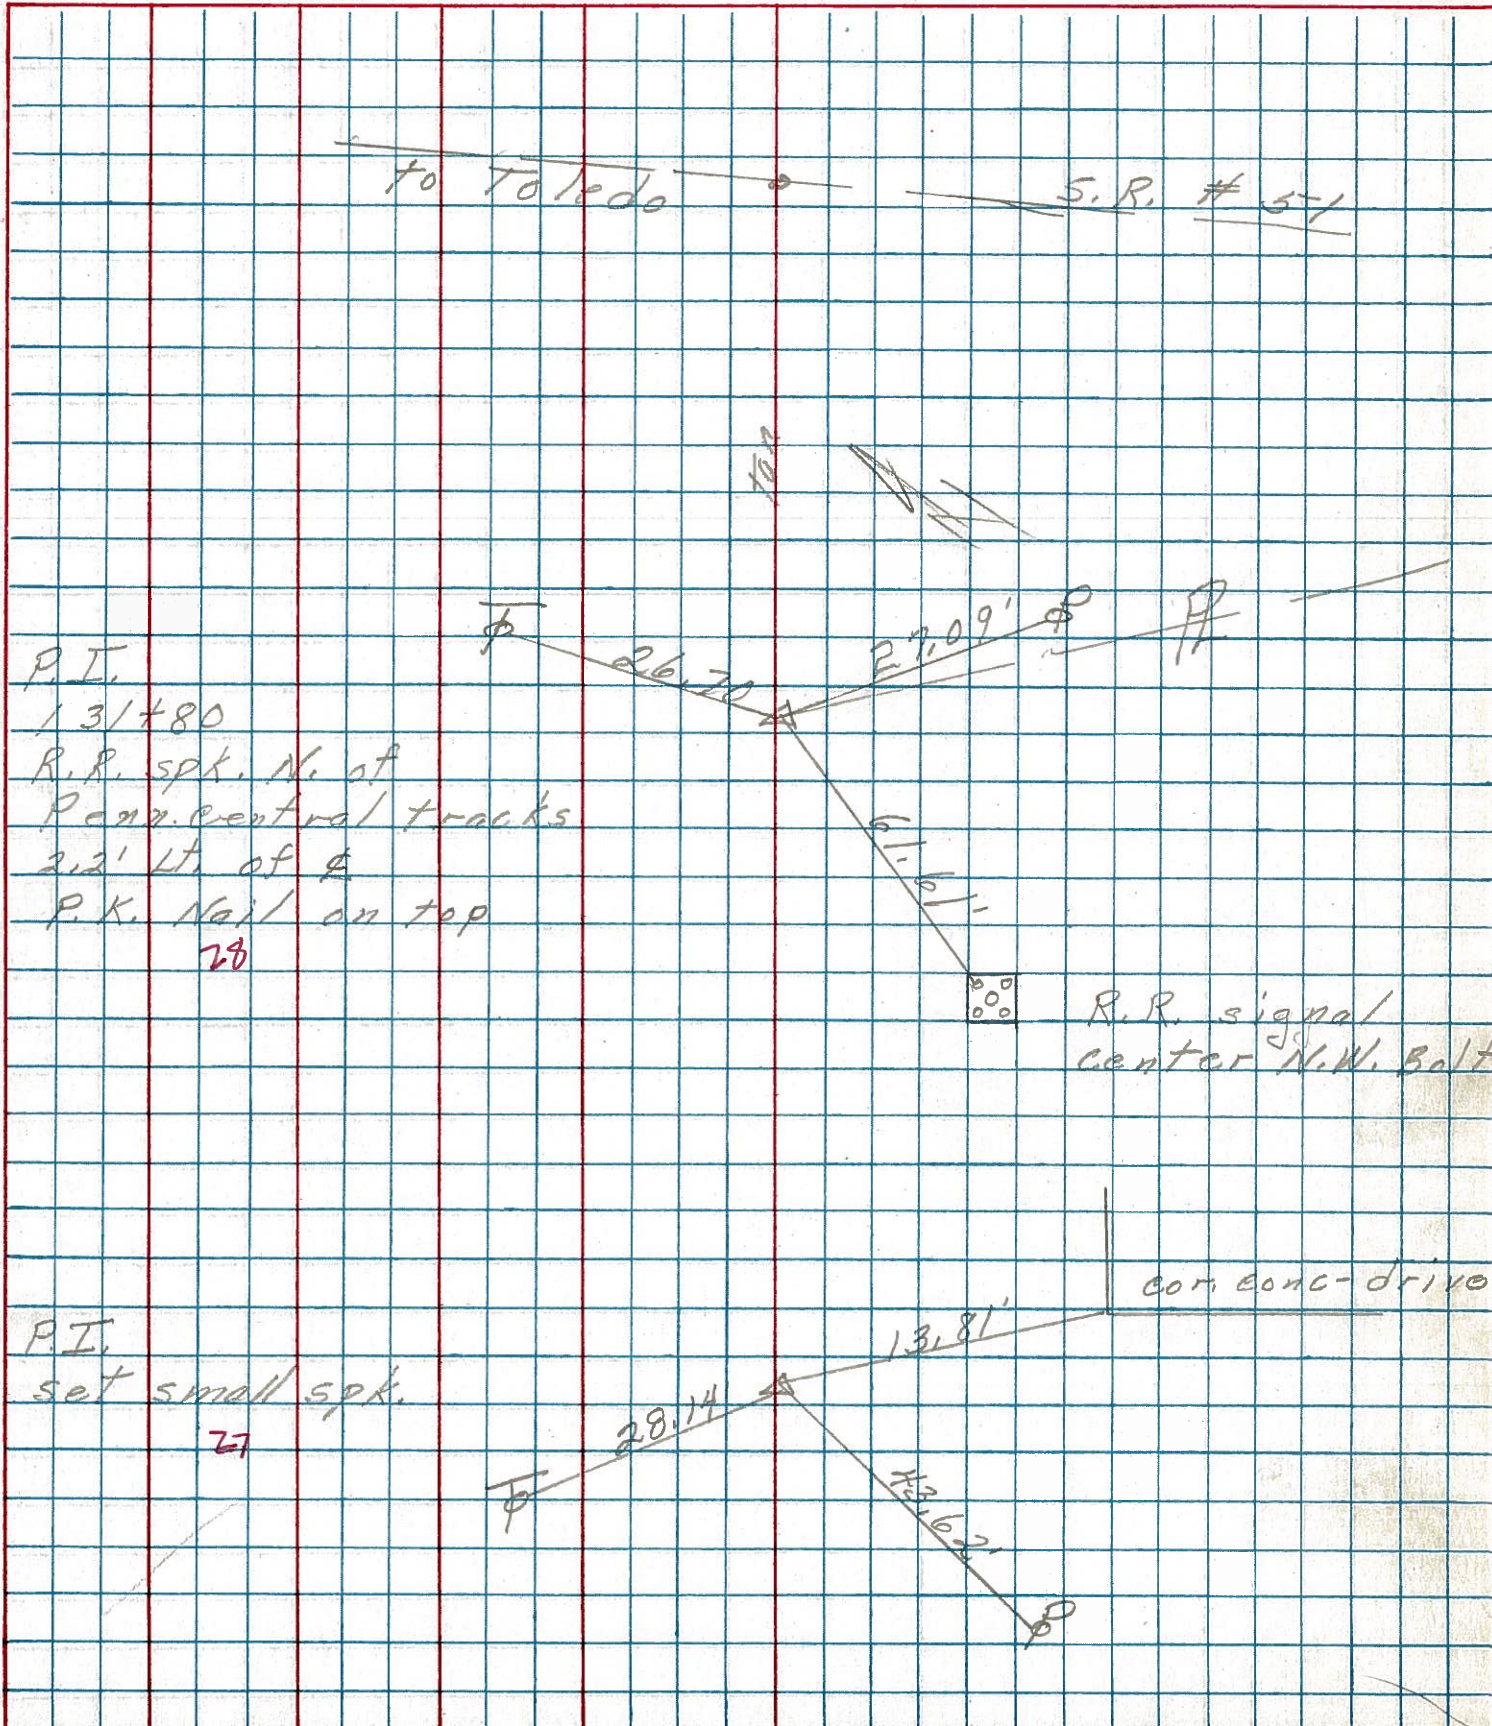

P.I.
 131+80
 R.R. spk. N. of
 Penn. central tracks
 2.2' Lt. of ϕ
 P.K. Nail on top
 20

R.R. signal
 center N.W. Bolt

P.I.
 set small spk.
 21

con conc-drive