

O.D.O.T. DISTRICT 2 SURVEY OFFICE (USE ONLY)

PERSONNEL

REFERENCE NO. 34

SHEET 6 OF 63

NOTES RHOADES DATE 7/29/19
 H.C. O'DONNELL WEATHER SUNNY
 R.C. MILLER TEMP. 83°
AUBLE

ROUTE SR 105
 COUNTY OTTAWA
 TOWNSHIP HARRIS
 SECTION 18

DWG BY BALBAUGH PID 92131

T 6 N R 14 E

TYPE MONUMENT P.K./WASHER

ON SURFACE - ~~BELOW~~ ON

OFFSET ☉ PAVEMENT 1.7' ~~ET~~ : RT

8.6' TO RT EDGE PAVEMENT


STATION: 194+06.53

HORZ.DATUM: NAD83 2011

GEOID: 2012A


GRID: NORTHING: 664238.441

EASTING: 1754424.164

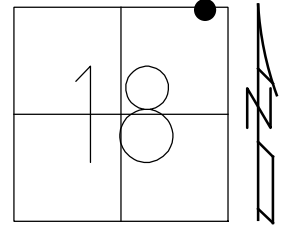

RECORD: P.I.
 FD P.K./WASHER ATOP
 P.K. BELOW SURFACE
 FD P.K./WASHER
 4/3/00, MC
 SET P.K./WASHER
 6/21/00, KPM
 FD P.K./WASHER
 REF 34
 4/5/18, JFO
 FD P.K./WASHER
 7/29/19, JFO
 SET MAG/WASHER
 11/15/19, JFO

"BENCHES NURSERY"

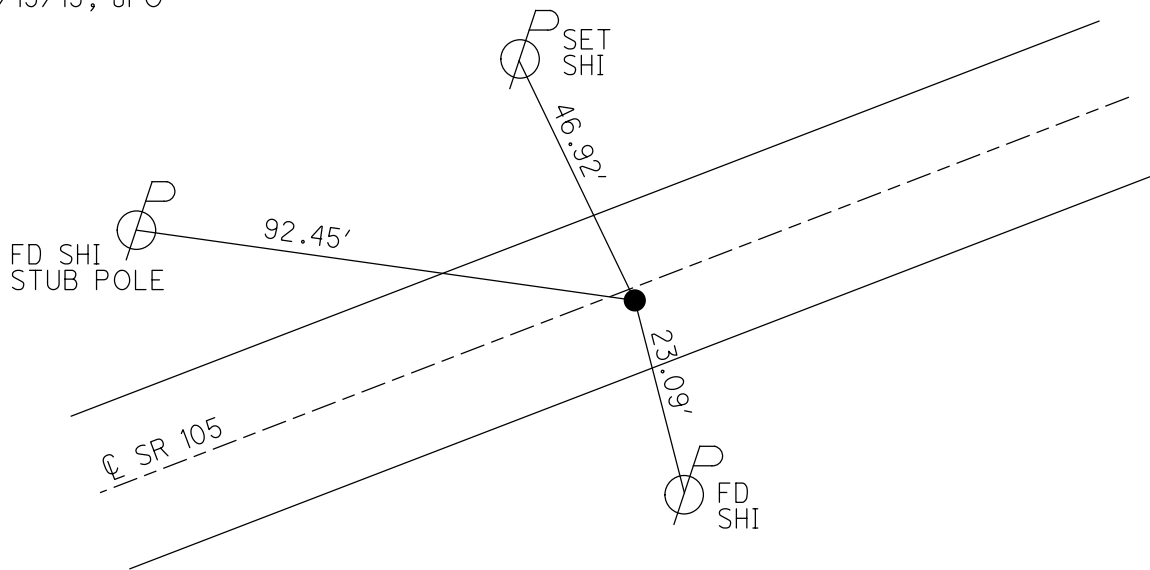

O.D.O.T. DISTRICT 2 SURVEY OFFICE

PERSONNEL

REFERENCE NO. 34

SHEET 7 OF 96

NOTES K. MOSER

H.C. M. CANTERBURY

DATE 4-3-00

ROUTE S.R. 105

R.C. M. BARNHISEL

WEATHER Sunny

COUNTY OTTAWA

TEMP. +50°F

TOWNSHIP HARRIS

SECTION 18

T6 N R 14 E


TYPE MONUMENT PK / WASHER

ON SURFACE - ~~BELOW~~ ON SURFACE

~~LEFT - C PAV'T.~~ - RIGHT 1.7' RT


B.L. TO RT EDGE PAVEMENT

S.L.M. 194 + 59

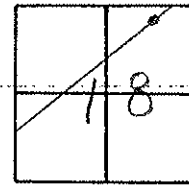

RECORD PI
 $\Delta = ??$
 PK / WASHER ATOP
 PK BELOW SURFACE

RESET PK / WASHER
 6-21-00
 KPM

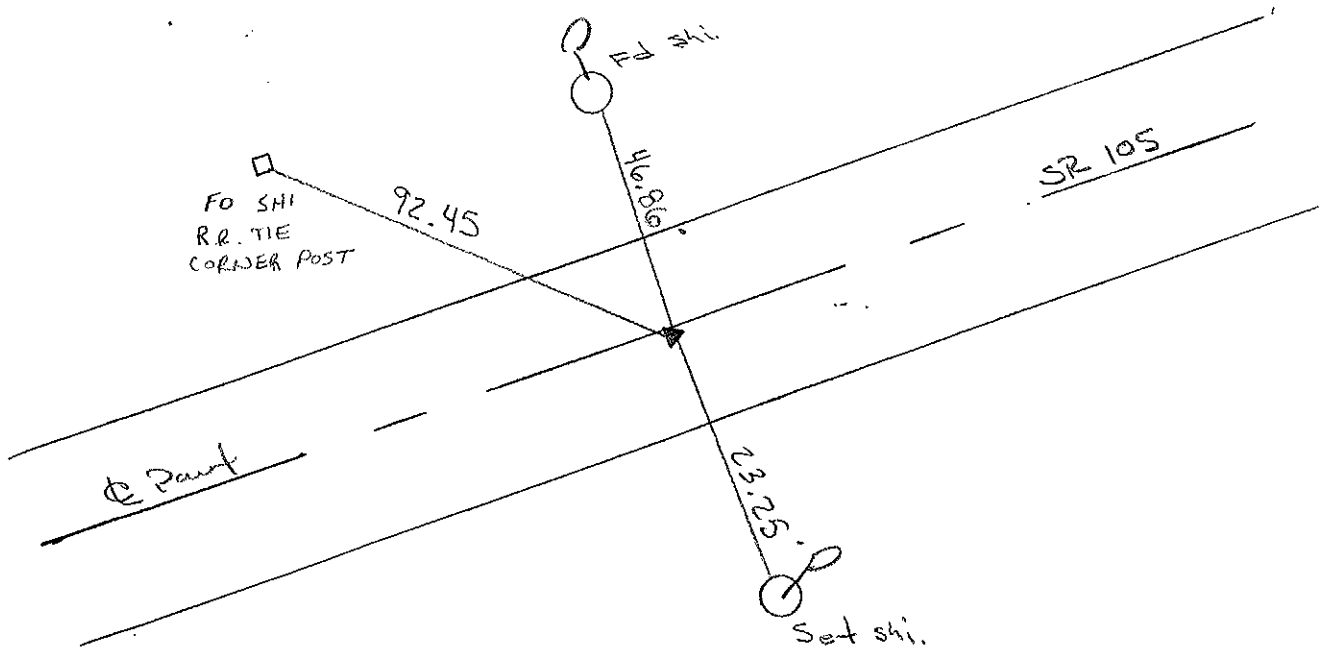

O.D.O.T. DISTRICT 2 SURVEY OFFICE

PERSONNEL _____ REFERENCE NO. 34 SHEET _____ OF _____

NOTES Cronin DRAWN 9/23/87

H.C. Ripple DATE 5/26/87

R.C. Barbour WEATHER sunny

Geyman TEMP. 90°

ROUTE 105

COUNTY Ottawa

TOWNSHIP Harris

SECTION 18

T6 N R 14 E


TYPE MONUMENT P.R. Washer

ON SURFACE - BELOW on surface

LEFT - 1.7' PAV'T. - RIGHT 2.3 R.F. Pav't.

8.6 TO RT EDGE PAVEMENT

S.L.M. 194733 194+59

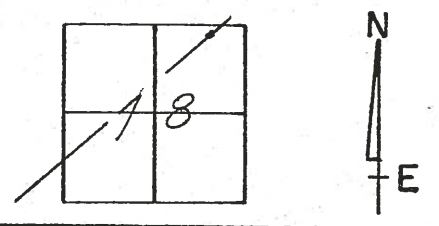


P.I.

P.K. washer atop

P.K. below surface

Δ = ??

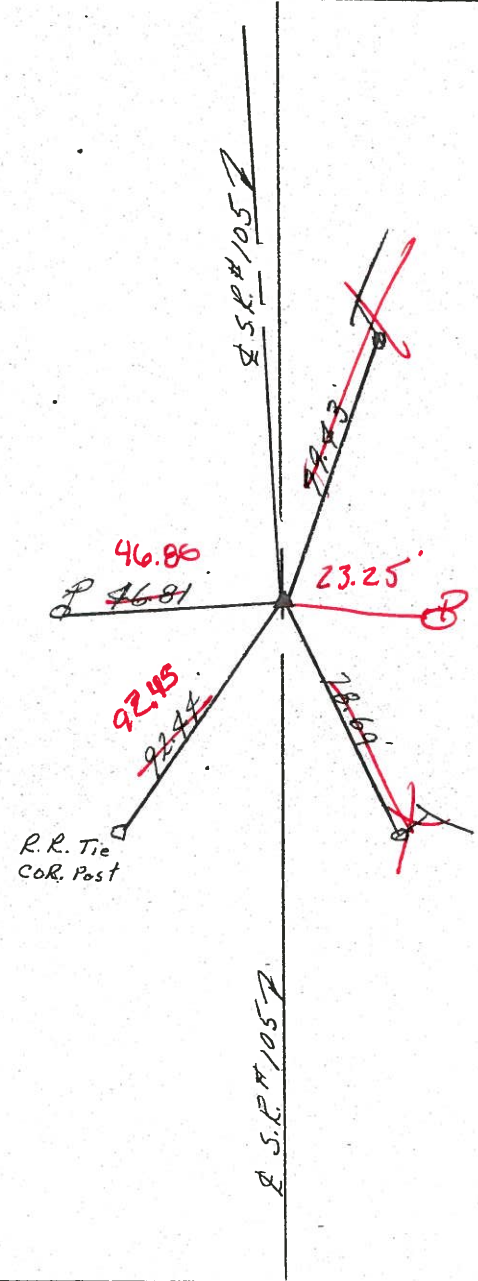

O.D.O.T. DISTRICT 2 SURVEY OFFICE


PERSONNEL

NOTES Cronin
H.C. Ripple
R.C. Barbour
Geyman


REFERENCE NO. 34
DRAWN 9/23/87
DATE 5/26/87
WEATHER sunny
TEMP. 70°

SHEET OF
ROUTE 105
COUNTY Ottawa
TOWNSHIP Harris
SECTION 18
T 6 N R 14 E

TYPE MONUMENT P.R. washer
ON SURFACE - BELOW on surface
LEFT - ℄ PAV'T. - RIGHT 2.3 R.T. & Pav't.
TO EDGE PAVEMENT
S.L.M. 194733

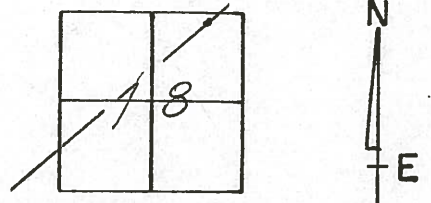

P.I.
P.K. washer at top
P.K. below surface
Δ = ??

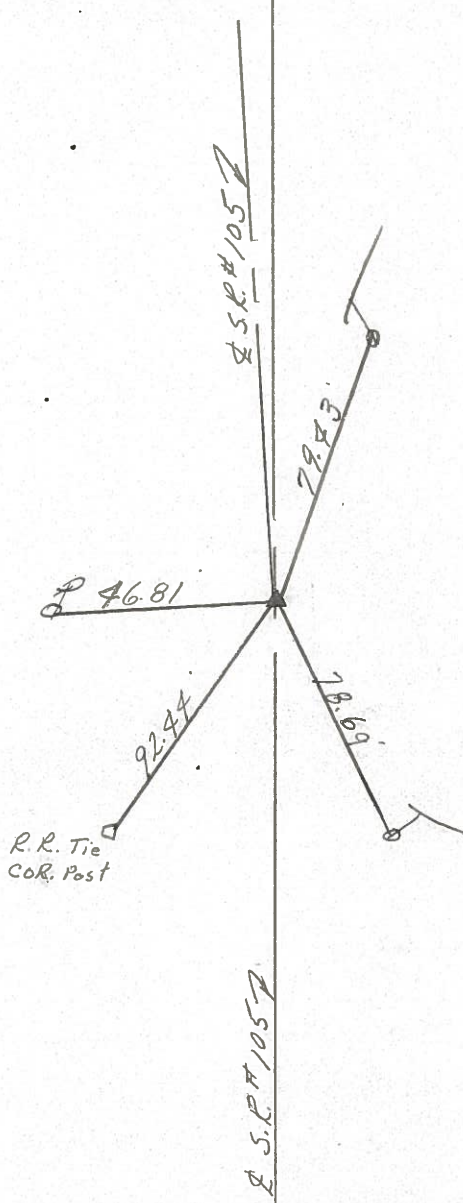

PERSONNEL TITLE PERSONNEL TITLE

COUNTY Ottawa

DATE 2-20-74

S. R. 105

WEATHER Fair

SEC. Sec 8

TEMP. 35°


DESCRIPTION Harris Twp.

JOB NO.

LEFT

CENTER LINE

RIGHT

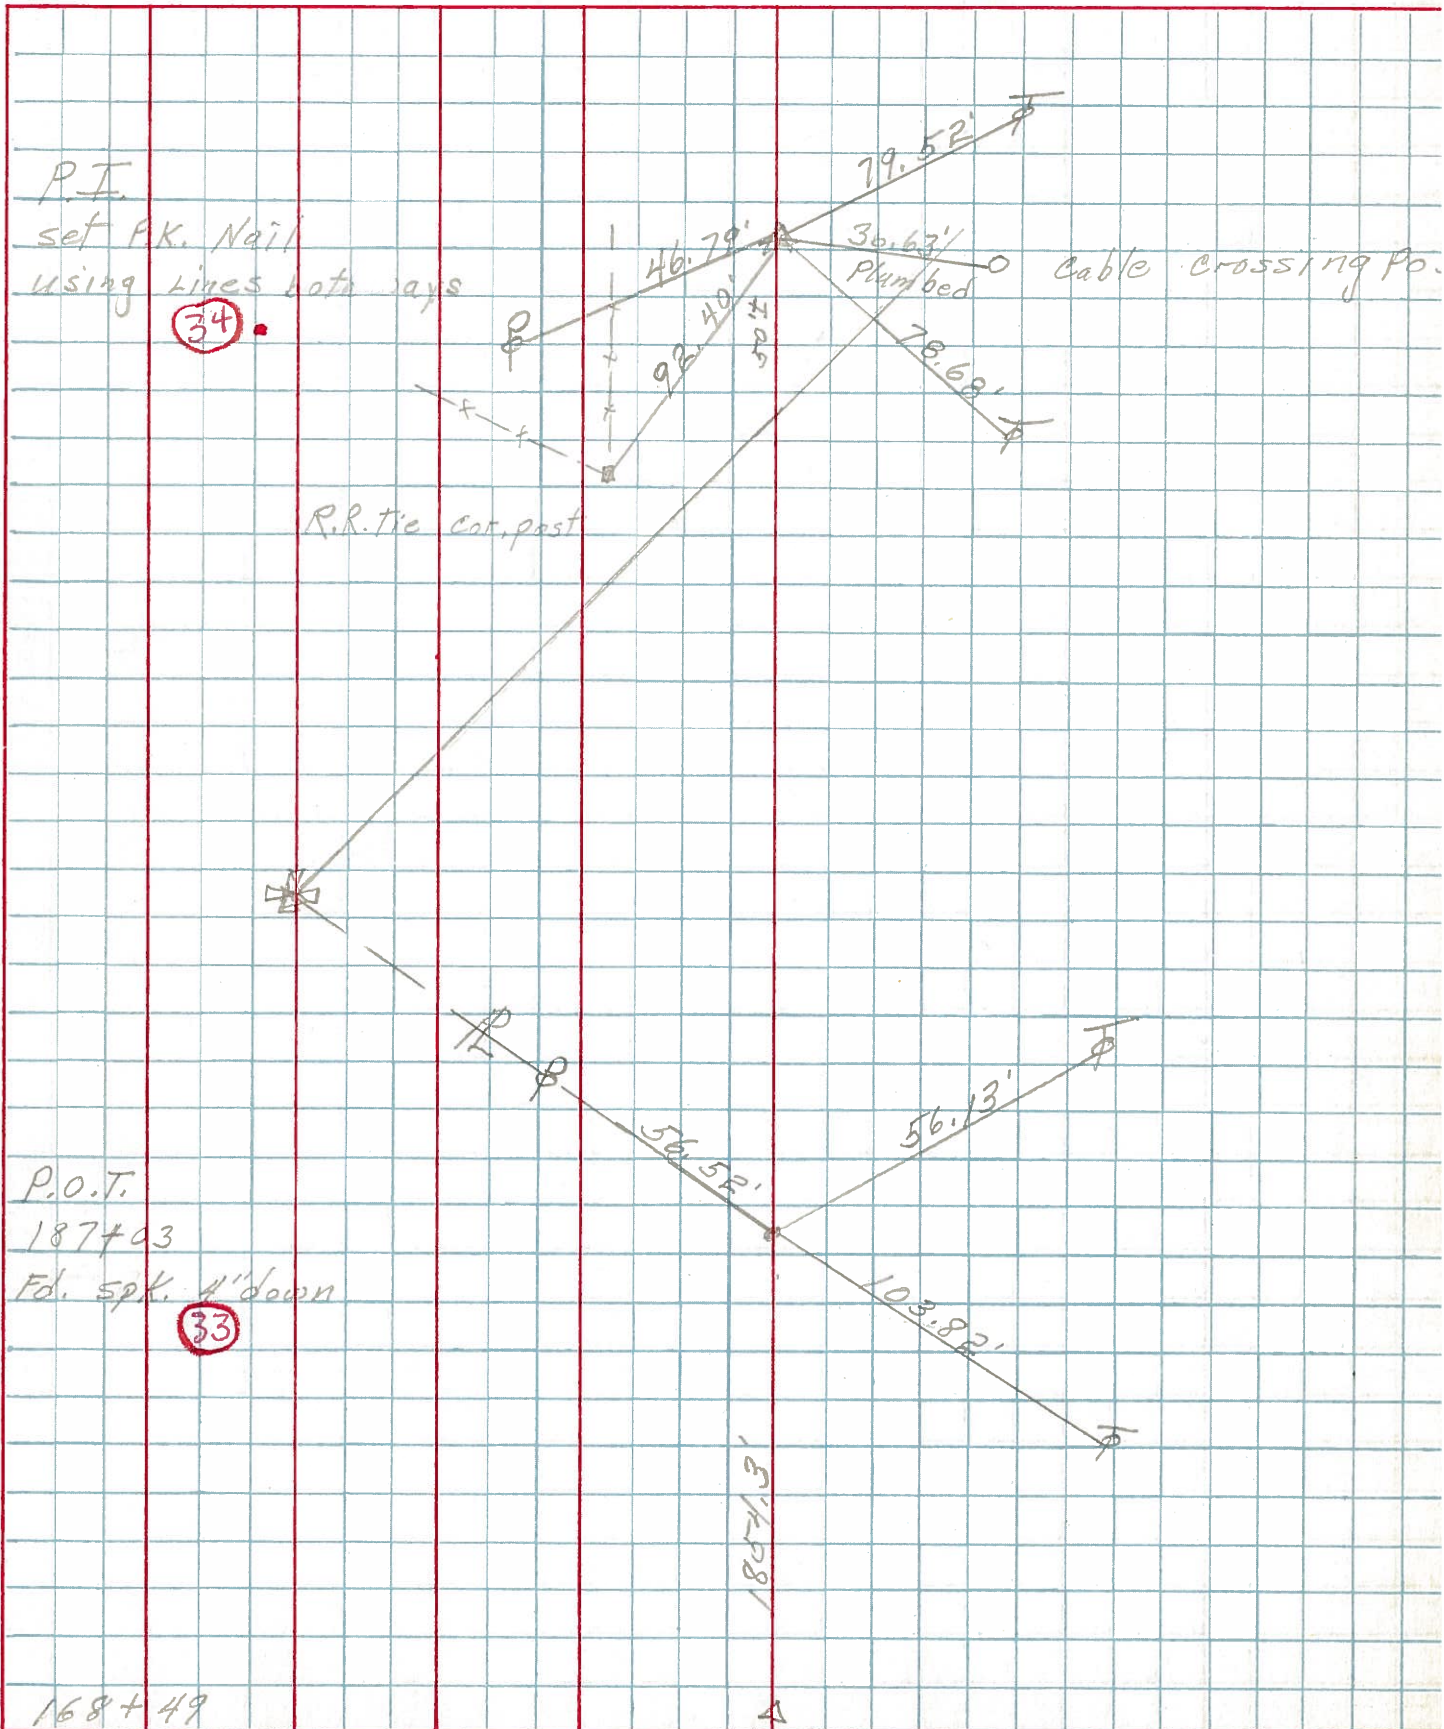

168+49