


O.D.O.T. DISTRICT 2 SURVEY OFFICE (USE ONLY)


PERSONNEL _____ REFERENCE NO. 35 A SHEET 8 OF 63
 NOTES RHOADES DATE 7/29/19 ROUTE SR 105
 H.C. O'DONNELL WEATHER SUNNY COUNTY OTTAWA
 R.C. MILLER TEMP. 83° TOWNSHIP HARRIS
AUBLE
 DWG BY BALBAUGH PID 92131 SECTION 7
 T 6 N R 14 E

TYPE MONUMENT P.K./WASHER
 ON SURFACE - ~~BELOW~~ ON _____
 OFFSET ☒ PAVEMENT 10.2' LT : RT
21.2' TO RT EDGE PAVEMENT
 STATION: 200+84.78

HORZ.DATUM: NAD83 2011 GEOID: 2012A
 GRID: NORTHING: 664686.339 EASTING: 1754933.486

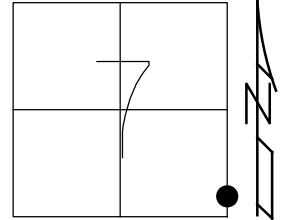

RECORD: P.K. ATOP P.K.
 FROM OLD SURVEY PLAT
 8/6/87
 FD P.K./WASHER
 4/3/00, MC
 SET P.K./WASHER
 6/21/00, KPM
 FD P.K. SHANK
 REFA35
 4/5/18, JFO
 FD P.K. SHANK
 7/29/19, JFO
 SET MAG/WASHER
 11/15/19, JFO

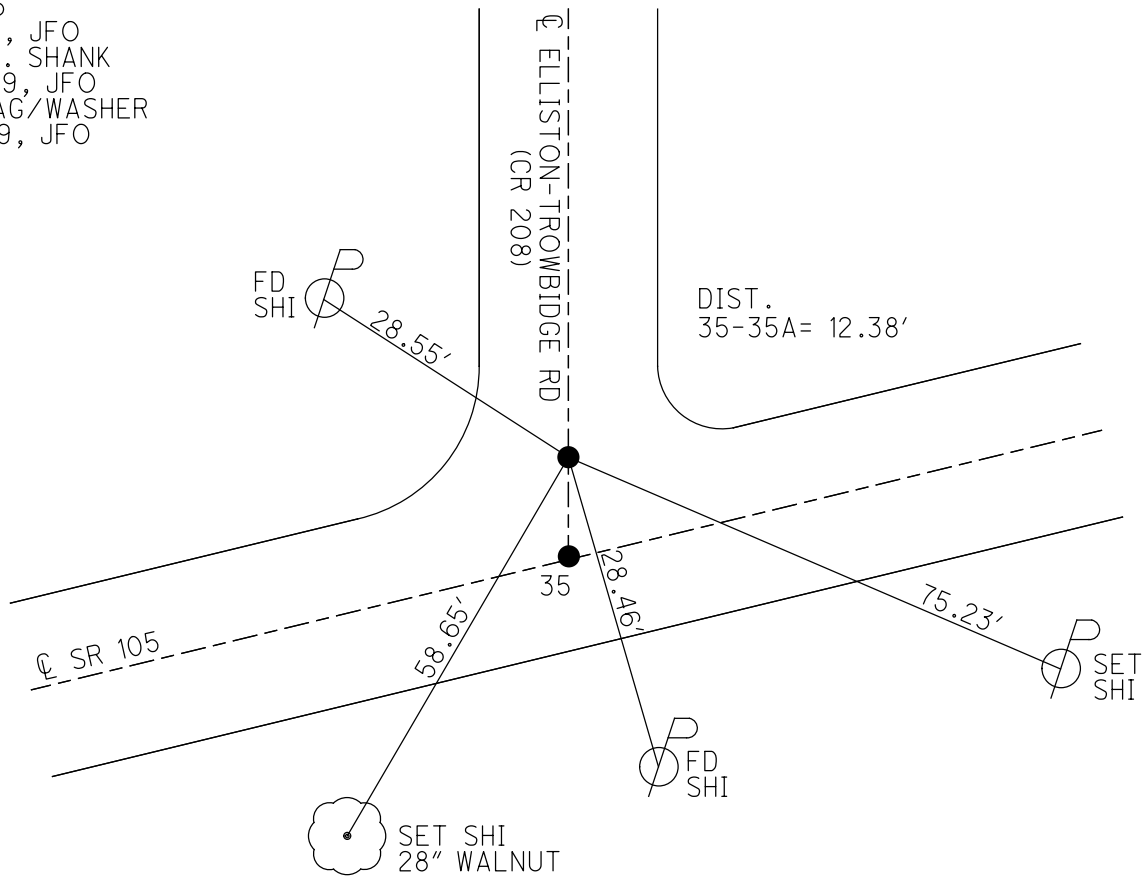

O.D.O.T. DISTRICT 2 SURVEY OFFICE

PERSONNEL

REFERENCE NO. 35

SHEET 8 OF 96

NOTES K. Moser

H.C. M. CANTERBURY

DATE 4-3-00

ROUTE S.R. 105

R.C. M. BARNHISEL

WEATHER SUNNY

COUNTY OTTAWA

TEMP. +50°F

TOWNSHIP HARRIS

SECTION 7

T6 N R 14 E


TYPE MONUMENT PK / WASHER

ON SURFACE - ~~BELOW~~ ON SURFACE

LEFT - ~~C PAV'T.~~ RIGHT 0.8' LT

11.0 TO RT. EDGE PAVEMENT


S.L.M. 201 + 31

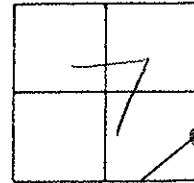

A) RECORD PK ATOP PK
FROM OLD SURVEY PLAT
8/06/87

RESET PK'S / WASHERS
6-21-00
1KPM

B) PK & WASHER ATOP
I. PIPE BELOW SURFACE
5-26-87

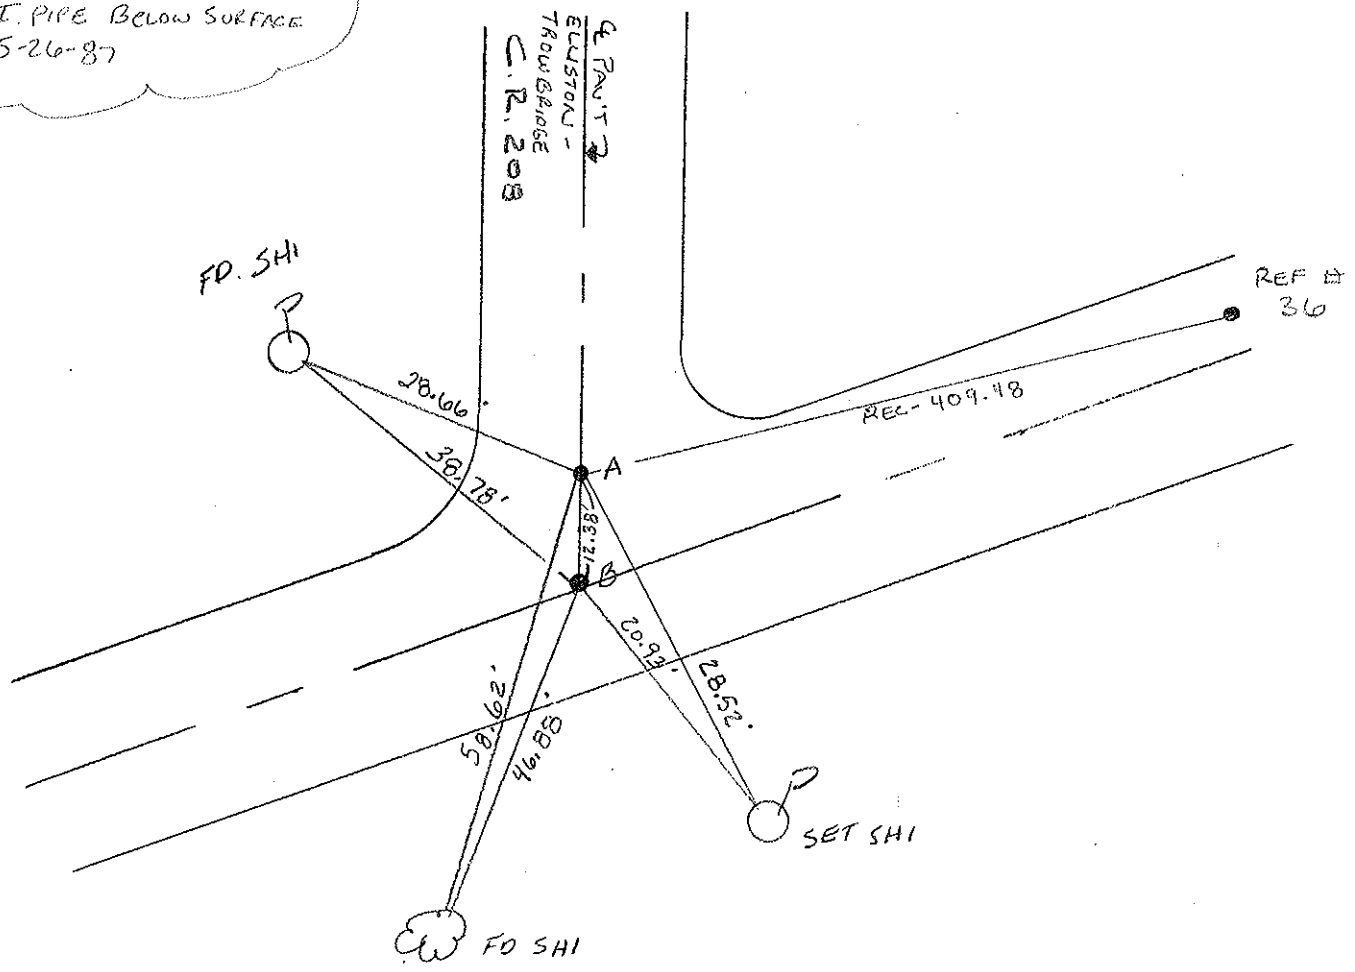

PERSONNEL TITLE PERSONNEL TITLE

COUNTY Ottawa DATE 1-24-7

S. R. 105 WEATHER Fair

SEC. SW. 1/4 sec 8 TEMP 40°

DESCRIPTION Harris Twp.

JOB NO.

LEFT CENTER LINE RIGHT

