


O.D.O.T. DISTRICT 2 SURVEY OFFICE (USE ONLY)

PERSONNEL _____ REFERENCE NO. 42 SHEET 14 OF 63
 NOTES RHOADES DATE 7/29/19 ROUTE SR 105
 H.C. O'DONNELL WEATHER SUNNY COUNTY OTTAWA
 R.C. MILLER TEMP. 83° TOWNSHIP HARRIS
AUBLE
 DWG BY BALBAUGH PID 92131 SECTION 8
 T 6 N R 14 E


TYPE MONUMENT P.K.NAIL
 ON SURFACE - ~~BELOW~~ ON
 OFFSET CL PAVEMENT ON ~~LT~~ : ~~RT~~
9.9' TO RT EDGE PAVEMENT
 STATION: 212+88.76

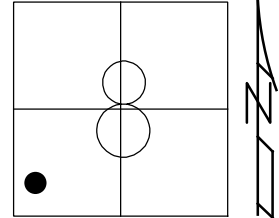

HORZ.DATUM: NAD83 2011 GEOID: 2012A
 GRID: NORTHING: 665456.520 EASTING: 1755859.018

RECORD:
 FD P.K./WASHER
 4/3/00, MC
 SET P.K./WASHER
 6/21/00, KPM
 FD P.K.NAIL
 REF42
 4/18/18, JFO
 FD P.K.NAIL
 7/29/19, JFO
 SET MAG/WASHER
 11/18/19, JFO

DIST.
 42-43= 16.21'

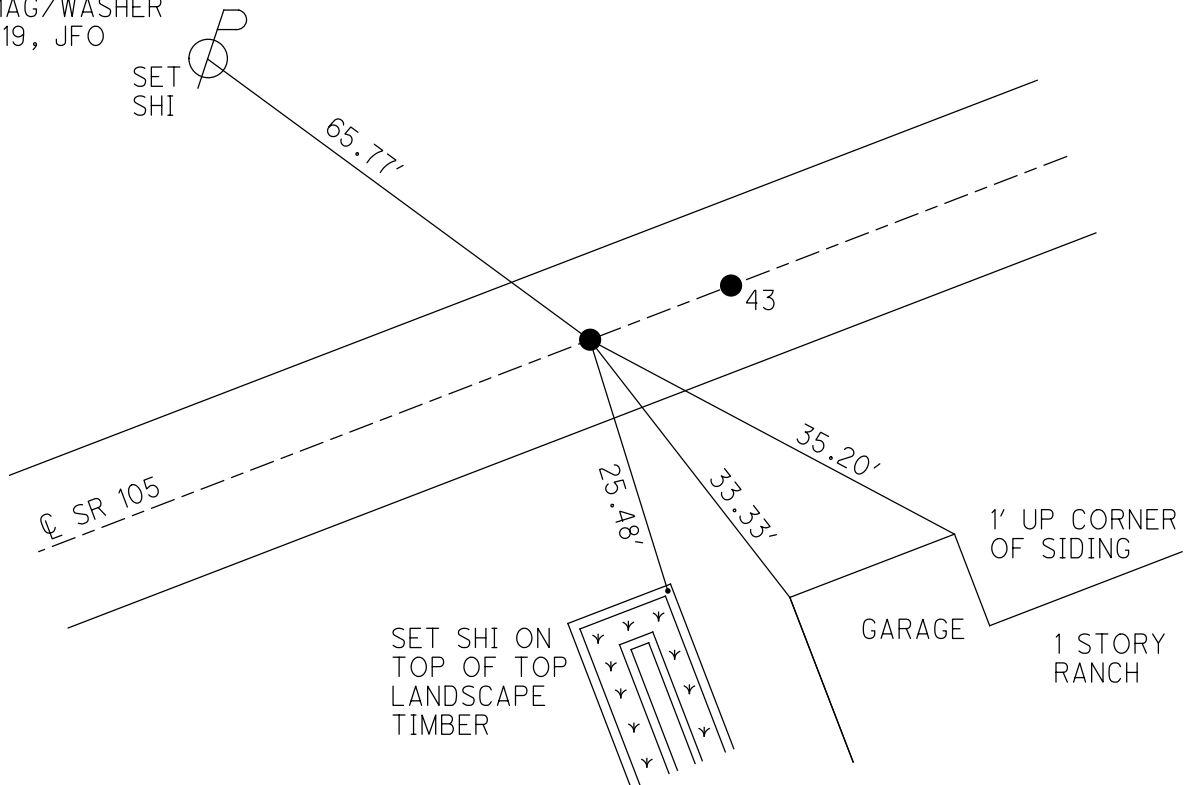

O.D.O.T. DISTRICT 2 SURVEY OFFICE

PERSONNEL

REFERENCE NO. 42, 43

SHEET 12 OF 96

NOTES K. Moser

H.C. M. CANTERBURY

DATE 4-3-00

ROUTE S.R. 105

R.C. M. BARNHISEL

WEATHER Sunny

COUNTY OTTAWA

TEMP. +50°F

TOWNSHIP HARRIS

SECTION 8

T6 N R 14 E



TYPE MONUMENT PK/WASHERS

ON SURFACE - ~~BELOW~~ ON SURFACE


~~LEFT~~ - C PAV'T. - RIGHT A-C B-0.5' RT.

TO RT. EDGE PAVEMENT A-9.9' B-9.4'

S.L.M. 213 +45 -A

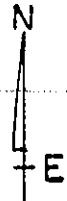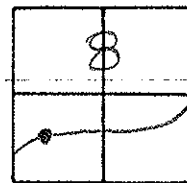

RESET PK/WASHER
 6-21-00
 K.P.M.

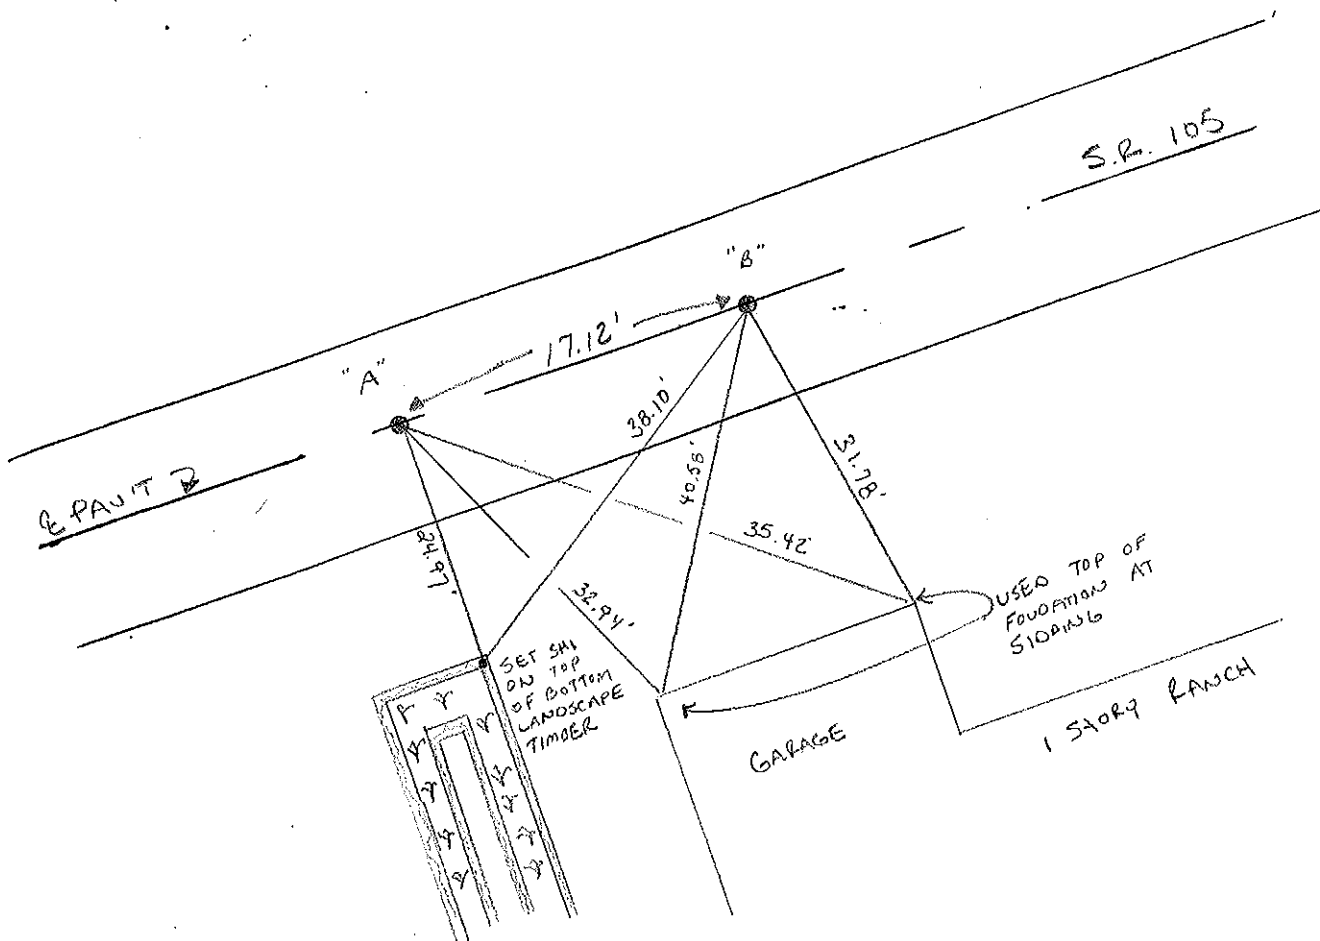

O.D.O.T. DISTRICT 2 SURVEY OFFICE

PERSONNEL

REFERENCE NO. 42

SHEET 1 OF

NOTES 1. Stone

H.C. D. Curtis

DATE 23 June 89

ROUTE SR# 105

R.C. J. Householder

WEATHER H+T

COUNTY Ottawa

TEMP. 88°

TOWNSHIP Harris

SECTION 8

T 6 N R 14 E




TYPE MONUMENT PK Nail & Washer

ON SURFACE - BELOW Surface

LEFT - ☉ PAV'T. - RIGHT on ☉

TO EDGE PAVEMENT

S.L.M. 213+11.81

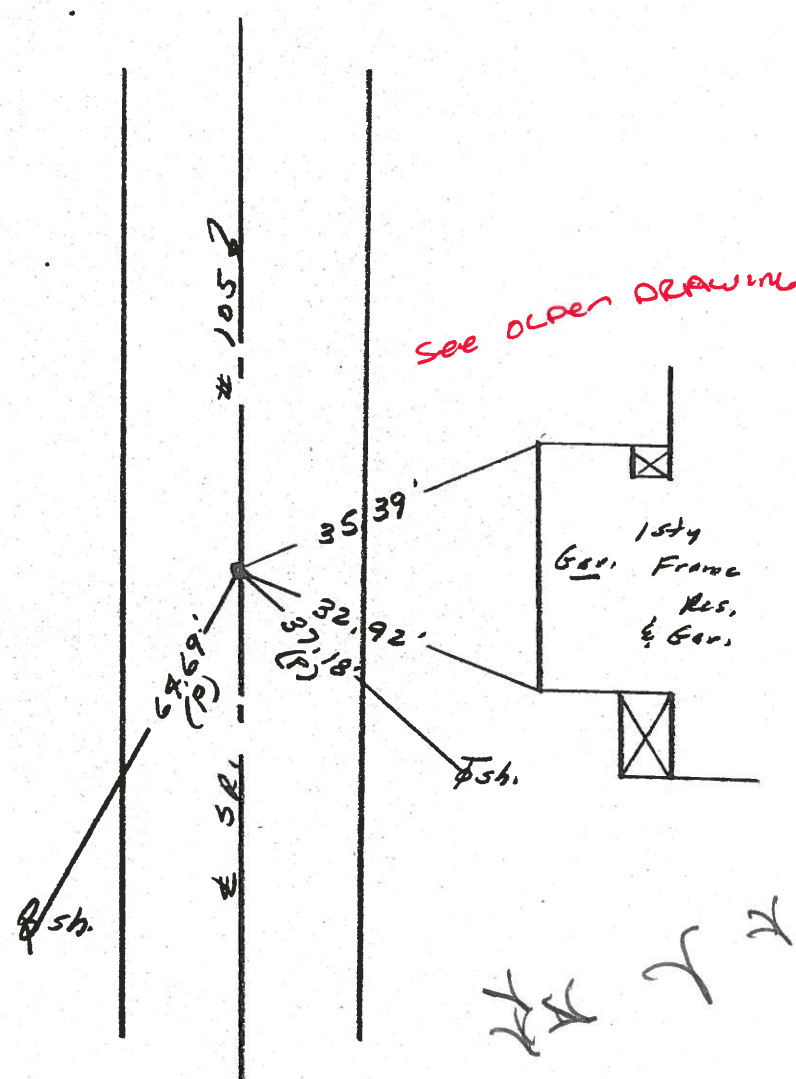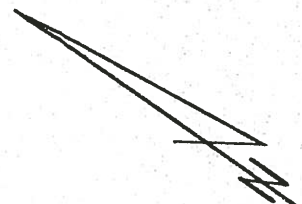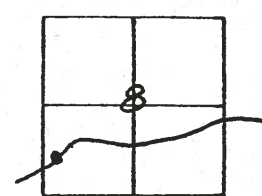

O.D.O.T. DISTRICT 2 SURVEY OFFICE

PERSONNEL _____

REFERENCE NO. 42

SHEET 1 OF _____

NOTES 1. Stone

H.C. D. Curtis

DATE 23 June 89

ROUTE SR # 105

R.C. J. Householder

WEATHER H+T

COUNTY Ottawa

TEMP. 88°

TOWNSHIP Harris

SECTION 8

T 6 N R 14 E



TYPE MONUMENT PK Nail & Washer

ON SURFACE - BELOW Surface

LEFT - & PAV'T. - RIGHT on E

TO _____ EDGE PAVEMENT

S.L.M. 213+11.81

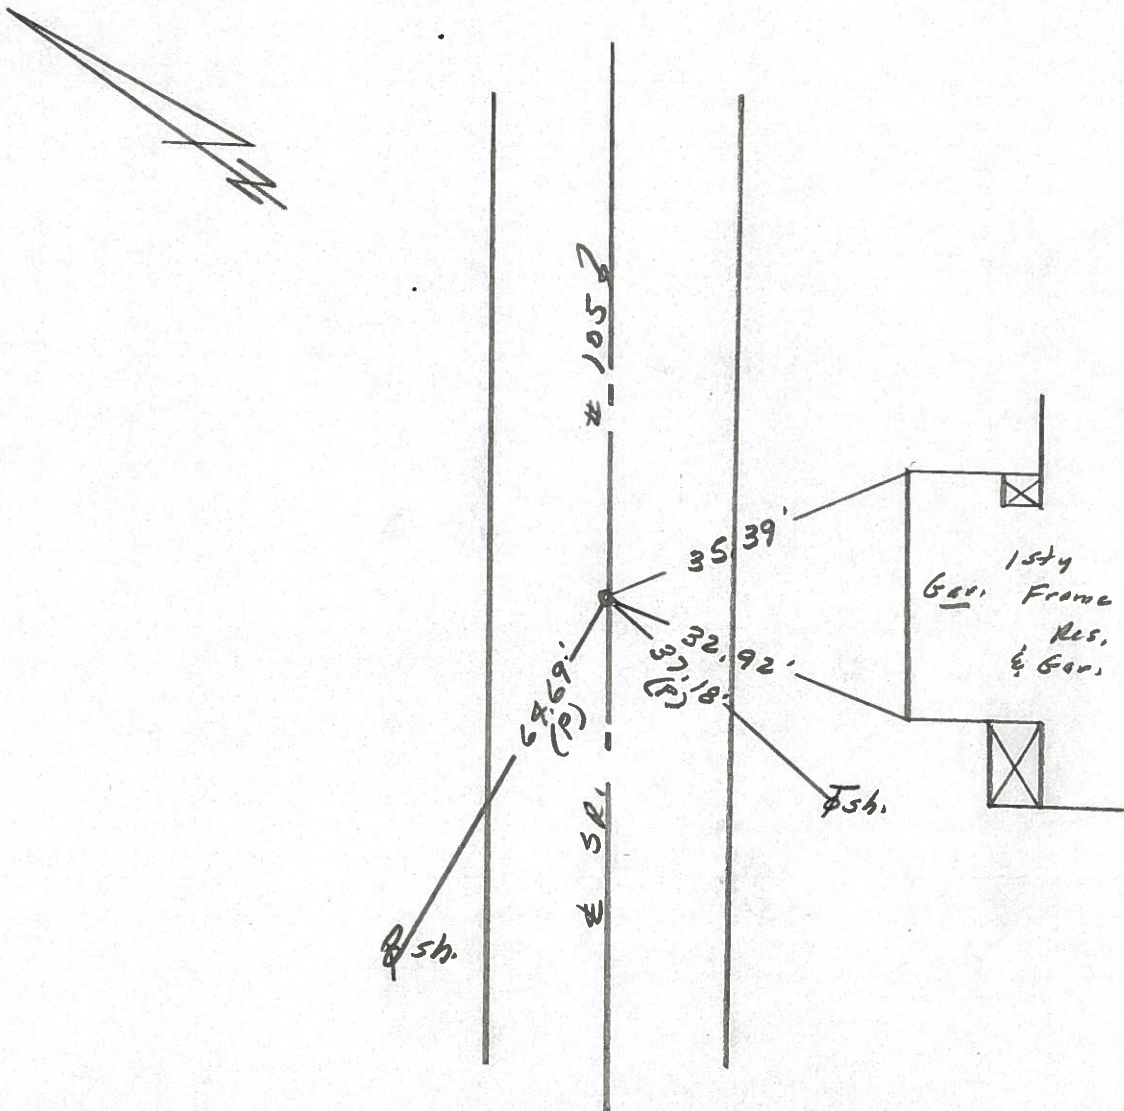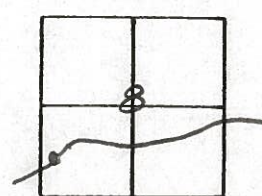

PERSONNEL TITLE PERSONNEL TITLE


COUNTY Ottawa DATE 1-24-

S. R. 105 WEATHER Fair

SEC. S.W 1/4 sec 8 TEMP. 40°

DESCRIPTION Harris Twp. JOB NO.

LEFT CENTER LINE RIGHT

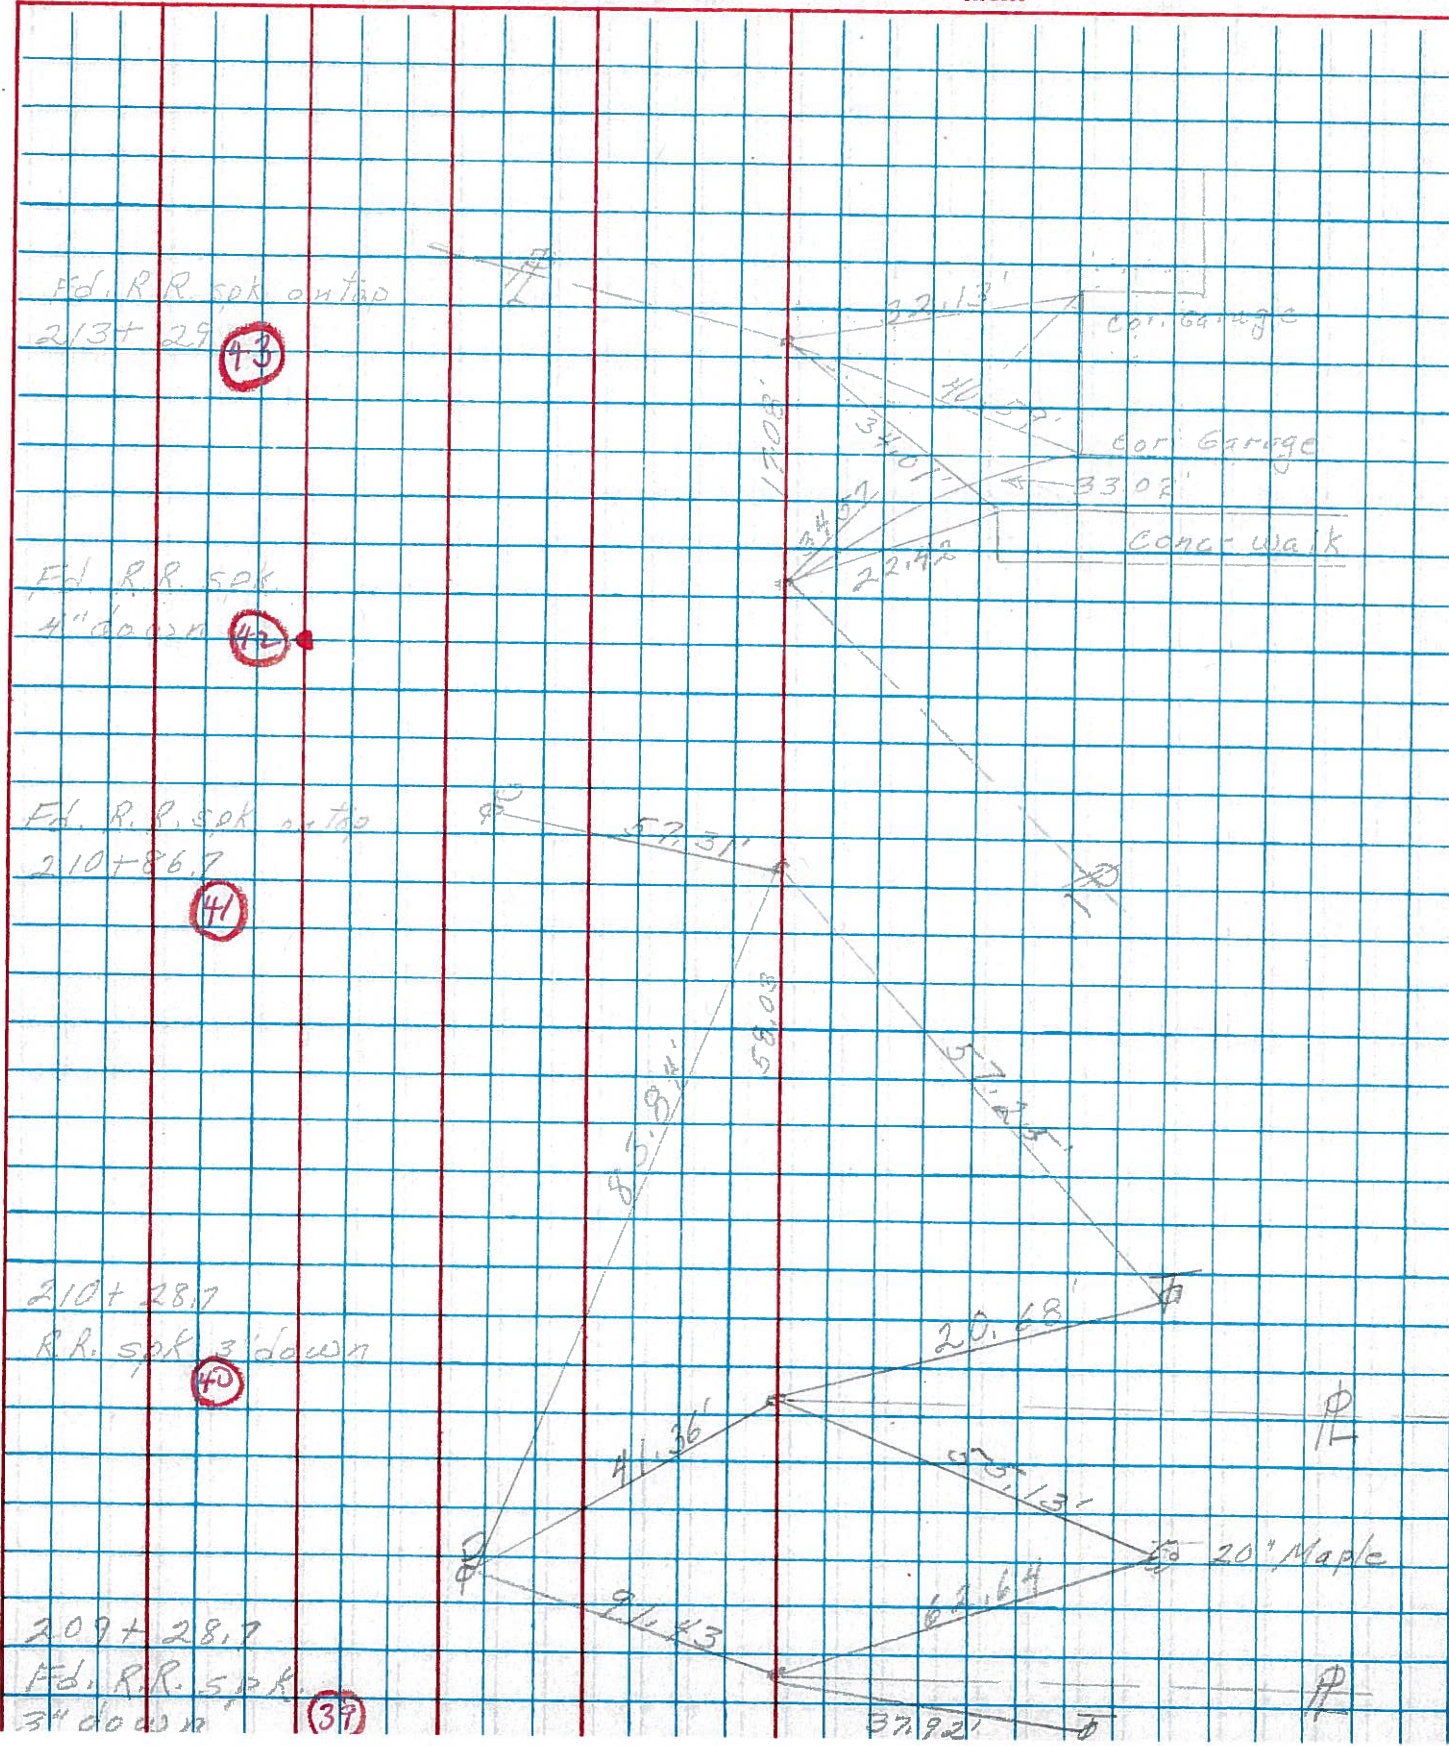

Fd. R.R. spk outtop
213+29 (43)

Fd. R.R. spk
4" down (42)

Fd. R.R. spk outtop
210+86.7 (41)

210+28.7
R.R. spk 3' down (40)

209+28.7
Fd. R.R. spk
3" down (39)

Garage

Garage

Conc. Walk

20" Maple