

O.D.O.T. DISTRICT 2 SURVEY OFFICE (USE ONLY)

PERSONNEL

REFERENCE NO. 45 A

SHEET 17 OF 63

NOTES MOSER

DATE 4/14/00

ROUTE SR 105

H.C. CANTERBURY

WEATHER SUNNY

COUNTY OTTAWA

R.C. BARNHISER

TEMP. 83°

TOWNSHIP HARRIS

DWG BY BALBAUGH

PID 92131

SECTION 8

T 6 N R 14 E

TYPE MONUMENT 3/4" IPIPE BENT

~~ON SURFACE~~ - BELOW 2"

OFFSET 27.3' LT : ~~RT~~

17.1' TO LT EDGE PAVEMENT


STATION: 218+52.67

HORZ. DATUM: NAD83 2011


GEOID: 2012A

GRID: NORTHING: 665782.482

EASTING: 1756318.902

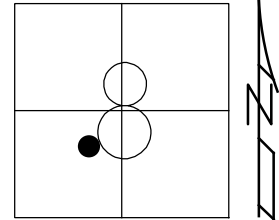

RECORD: P.I.
 STA 218+76.51
 FD 3/4" IPIPE BENT
 4/14/00, MC
 SET P.K./WASHER
 6/21/00, KPM
 FD 3/4" I.P.IPE
 4" DOWN
 BENT NORTHEASTERLY
 REFA45
 4/18/18, JFO

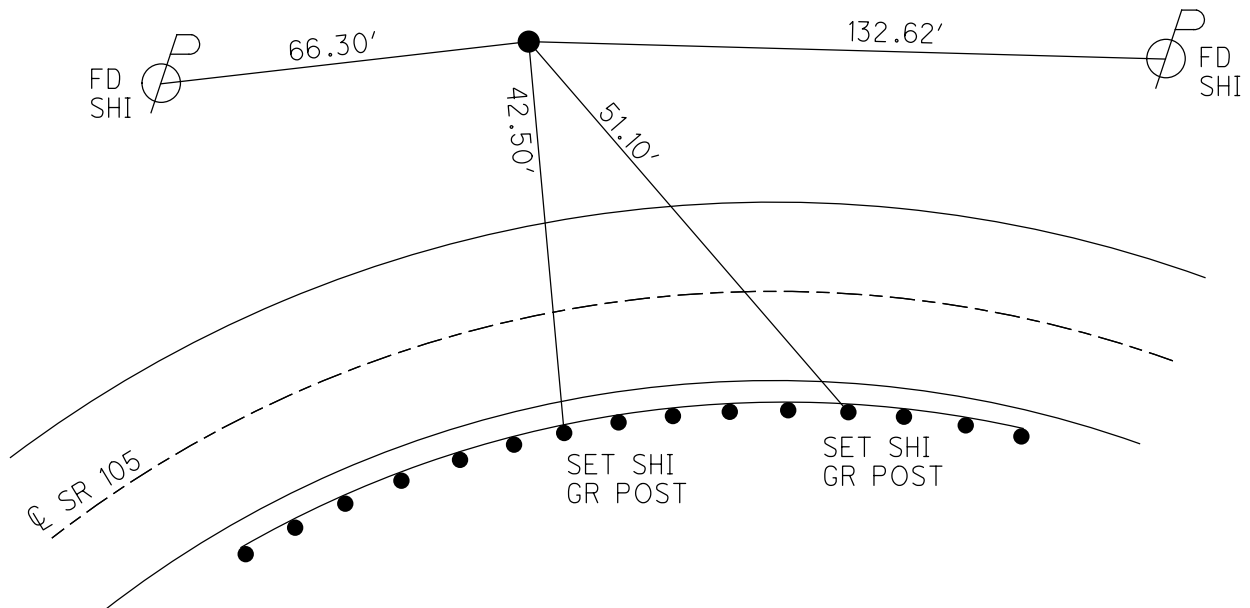

O.D.O.T. DISTRICT 2 SURVEY OFFICE

PERSONNEL

NOTES K. MOSER
 H.C. M. CANTERBURY
 R.C. M. BARNHISEL


REFERENCE NO. 45-A

DATE 4-14-00
 WEATHER SUNNY
 TEMP. +60°F

SHEET 14 OF 96


ROUTE S.R. 105
 COUNTY OTTAWA
 TOWNSHIP HARRIS
 SECTION 8
 T6 N R 14 E

TYPE MONUMENT 3/4" I. PIPE (BENT)
~~ON SURFACE~~ - BELOW 2" BELOW
 LEFT-~~C~~ PAV'T. - RIGHT 27.3' LT. OF Q
~~17.1~~ ^{FROM} ~~TO~~ LT. EDGE PAVEMENT
 S.L.M. 218+98

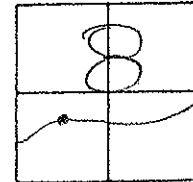

RECORD: 218+76.51 = P.T.

RESET PK/WASHER
 6-21-00
 K.P.M

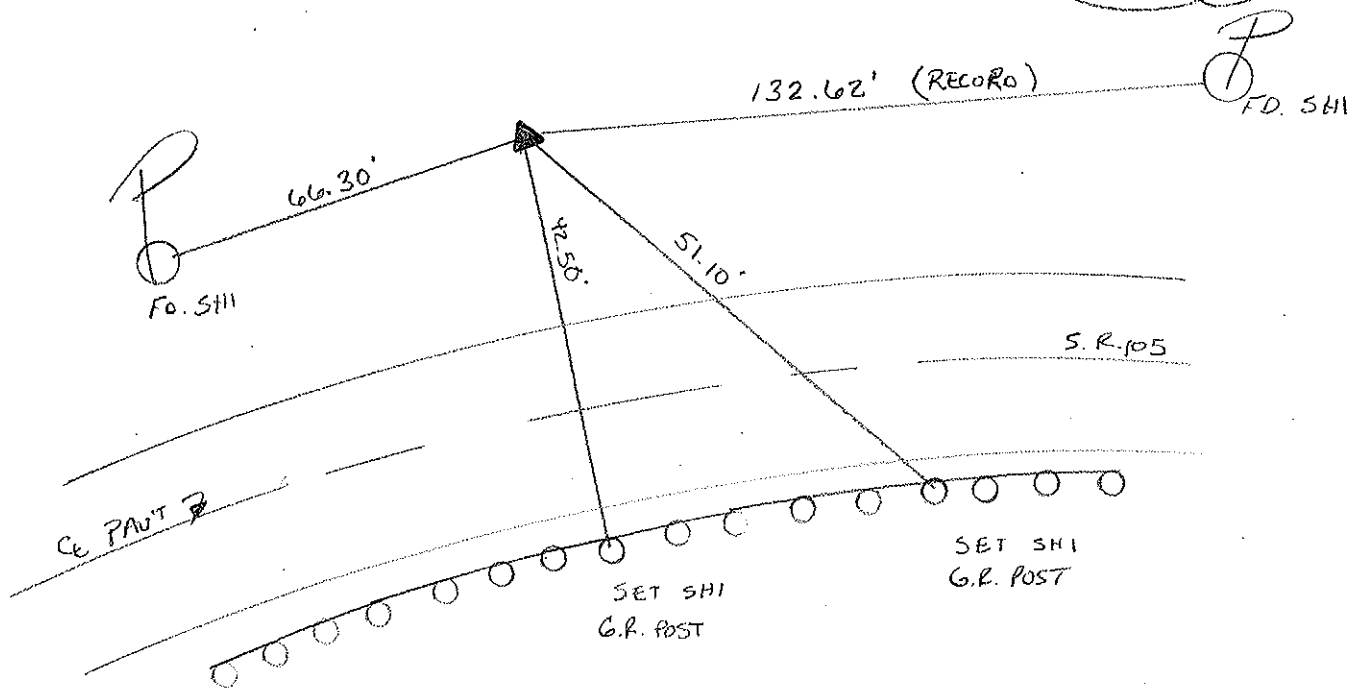

O.D.O.T. DISTRICT 2 SURVEY OFFICE

PERSONNEL

REFERENCE NO. 45-A SHEET 3 OF

NOTES 1. Stone

H.C. D. Curtis

R.C. T. Householder

DATE 26 June 89

WEATHER Hot

TEMP. 90°

ROUTE SR#105

COUNTY Ottawa

TOWNSHIP Harris

SECTION 8

T 6 N R 14 E


TYPE MONUMENT 3/4" I. pipe 10 cent

ON SURFACE - BELOW Surface


LEFT- & PAV'T. - RIGHT 27.3 LT OF CL

17.1 ^{from} TO LT. EDGE PAVEMENT

S.L.M. 218+76.51 = P.I.

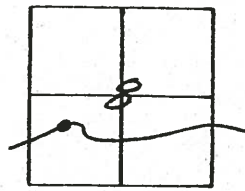

218+98

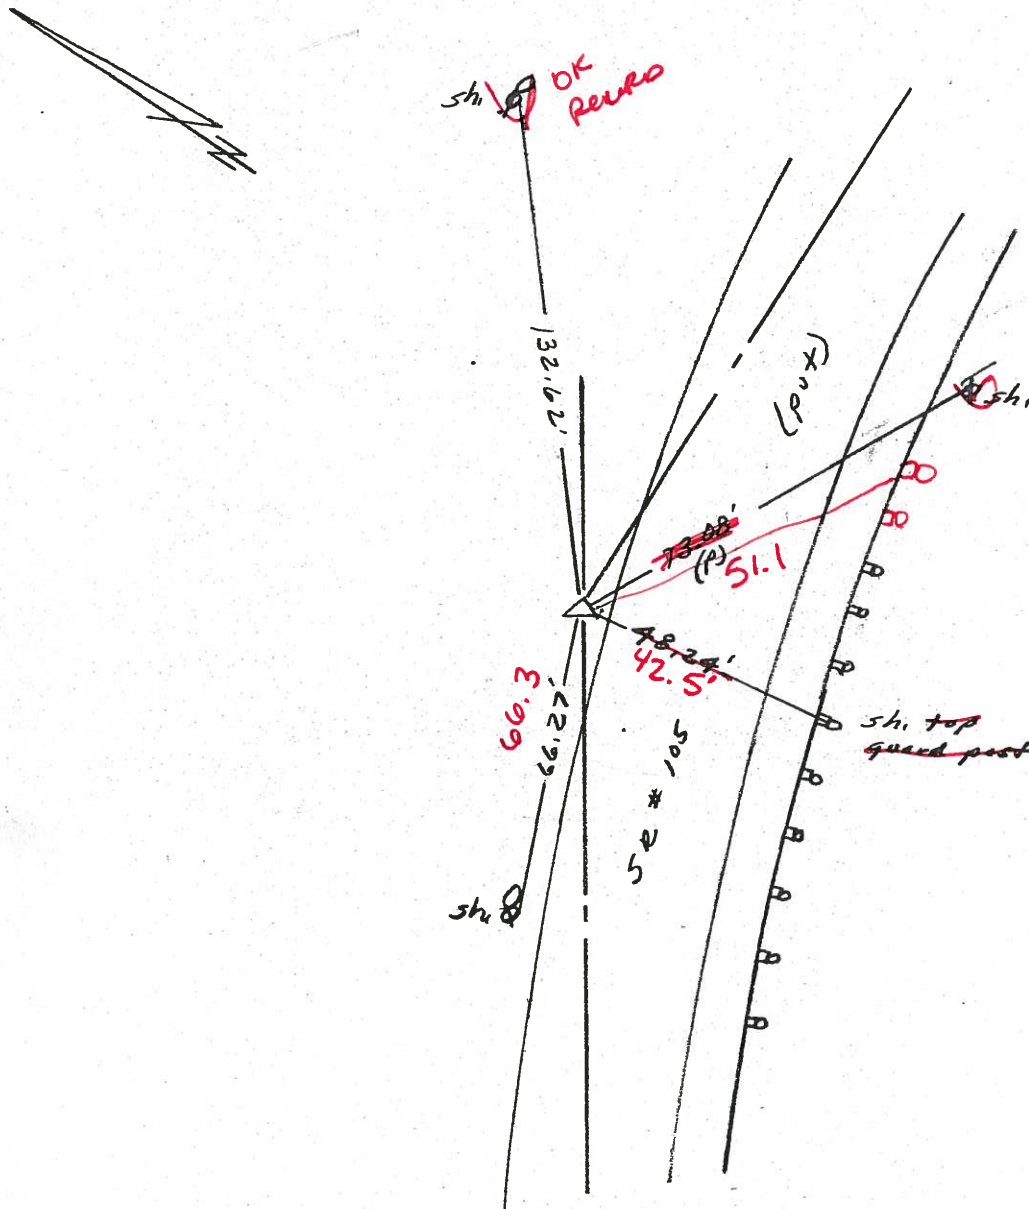

O.D.O.T. DISTRICT 2 SURVEY OFFICE

PERSONNEL

REFERENCE NO. 45-A

SHEET 3 OF

NOTES 1. Stone

H.C. D. Curtis

R.G. J. Householder

DATE 26 June 89

WEATHER Hot

TEMP. 90°

ROUTE SR#105

COUNTY Ottawa

TOWNSHIP Harris

SECTION 8

T 6 N R 14 E



TYPE MONUMENT 3/4" Pipe

ON SURFACE - BELOW Surface

LEFT - \odot PAV'T. - RIGHT

 TO EDGE PAVEMENT

S.L.M. 218+76.51 = P.I.

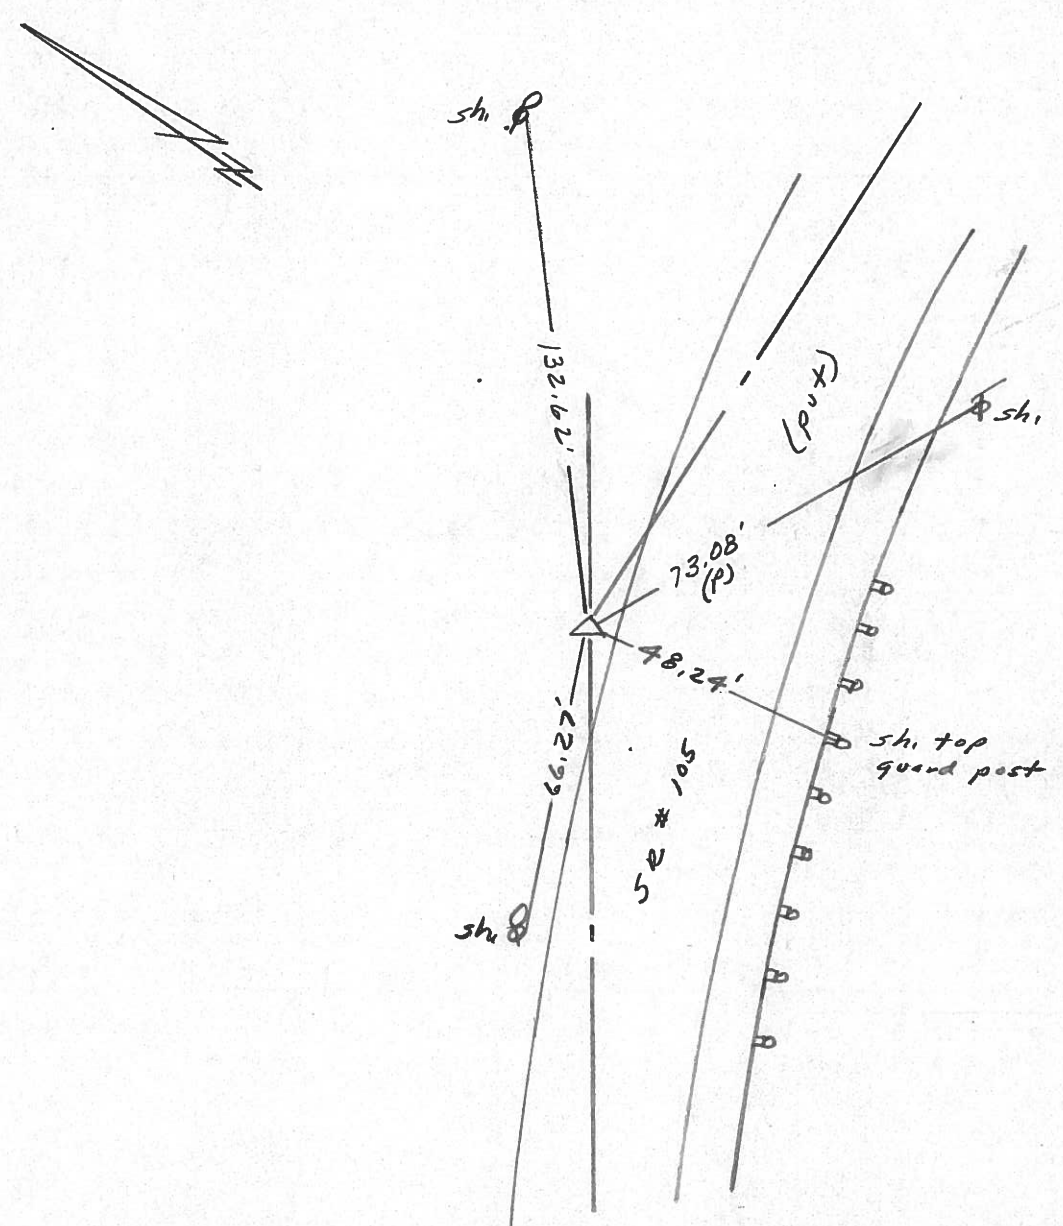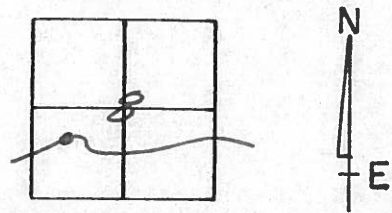

O.D.O.T. DISTRICT 2 SURVEY OFFICE

PERSONNEL

REFERENCE NO. 45-A

SHEET OF

NOTES Hoffman

H.C. BARNHISEL

DATE 5-29-85

ROUTE SR 105

R.C. LOENRICE

WEATHER Clear

COUNTY OTTAWA

TEMP. 70°

TOWNSHIP HARRIS

SECTION 8

T. 6 N. 14 E

TYPE MONUMENT I. Pipe

ON SURFACE - ~~BELOW~~ surface

LEFT - C PAV'T. - ~~RIGHT~~ 27.2'

17.5 TO LT EDGE PAVEMENT

S.L.M. 219+78

