


O.D.O.T. DISTRICT 2 SURVEY OFFICE (USE ONLY)


PERSONNEL _____ REFERENCE NO. 50 D SHEET 26 OF 63
 NOTES MOSE DATE 4/14/00 ROUTE SR 105
 H.C. CANTERBURY WEATHER SUNNY COUNTY OTTAWA
 R.C. BARNHISEL TEMP. +60° TOWNSHIP HARRIS
 DWG BY BALBAUGH PID 92131 SECTION 8
 T 6 N R 14 E

TYPE MONUMENT P.K./WASHER
~~ON SURFACE~~ - BELOW 1.5"
 OFFSET \odot PAVEMENT 1.0' ~~RT~~ : RT
9.5' TO RT EDGE PAVEMENT
 STATION: 242+42

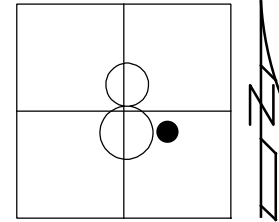

HORIZ.DATUM: _____ GEOID: _____
 GRID: NORTHING: _____ EASTING: _____

RECORD:
 ORIGIN UNKNOWN
 POSSIBLE PROP. CORNER
 STA.242+42
 FD P.K./WASHER
 4/14/00, MC
 D.N.F.
 7/30/19, JFO

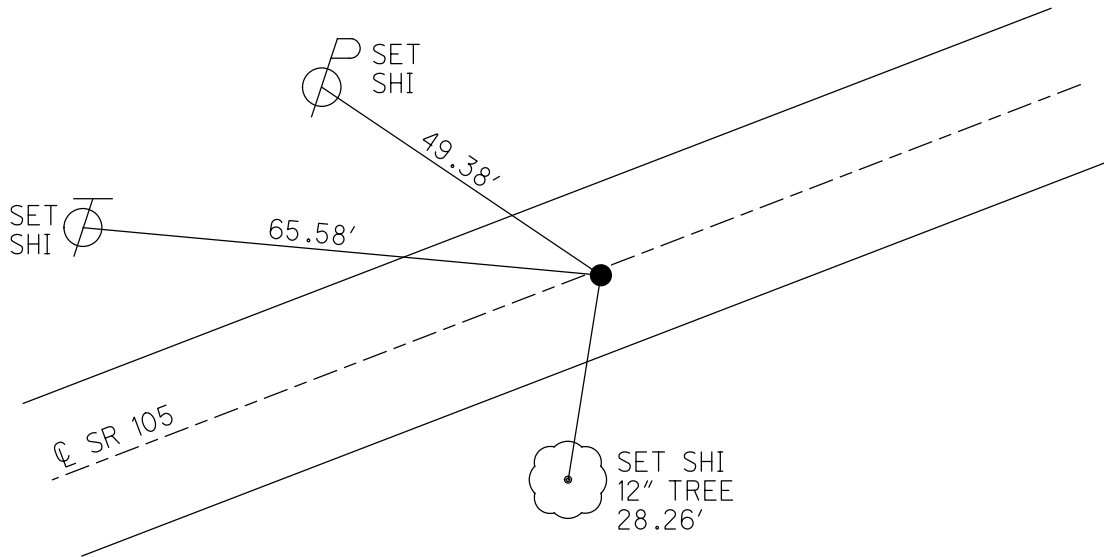

O.D.O.T. DISTRICT 2 SURVEY OFFICE

PERSONNEL

REFERENCE NO. 50-D

SHEET 22 OF 96

NOTES K. MOSER

H.C. M. CANTERBURY

DATE 4-14-00

ROUTE S.R. 105

R.C. M. BARNHISEL

WEATHER Sunny

COUNTY OTTAWA

TEMP. +60°F

TOWNSHIP HARRIS

SECTION 8

T6 N R 14 E


TYPE MONUMENT PK / WASHER

~~ON SURFACE~~ - BELOW 1 1/2" Below

~~LEFT - C PAV'T.~~ - RIGHT 1.0' RT.


9.5' TO Rt. EDGE PAVEMENT

S.L.M. 242 +42

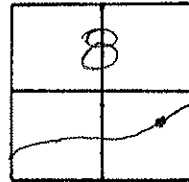

ORIGINS UNKNOWN
POSSIBLE PROP. LINE

DIG IF NEEDED

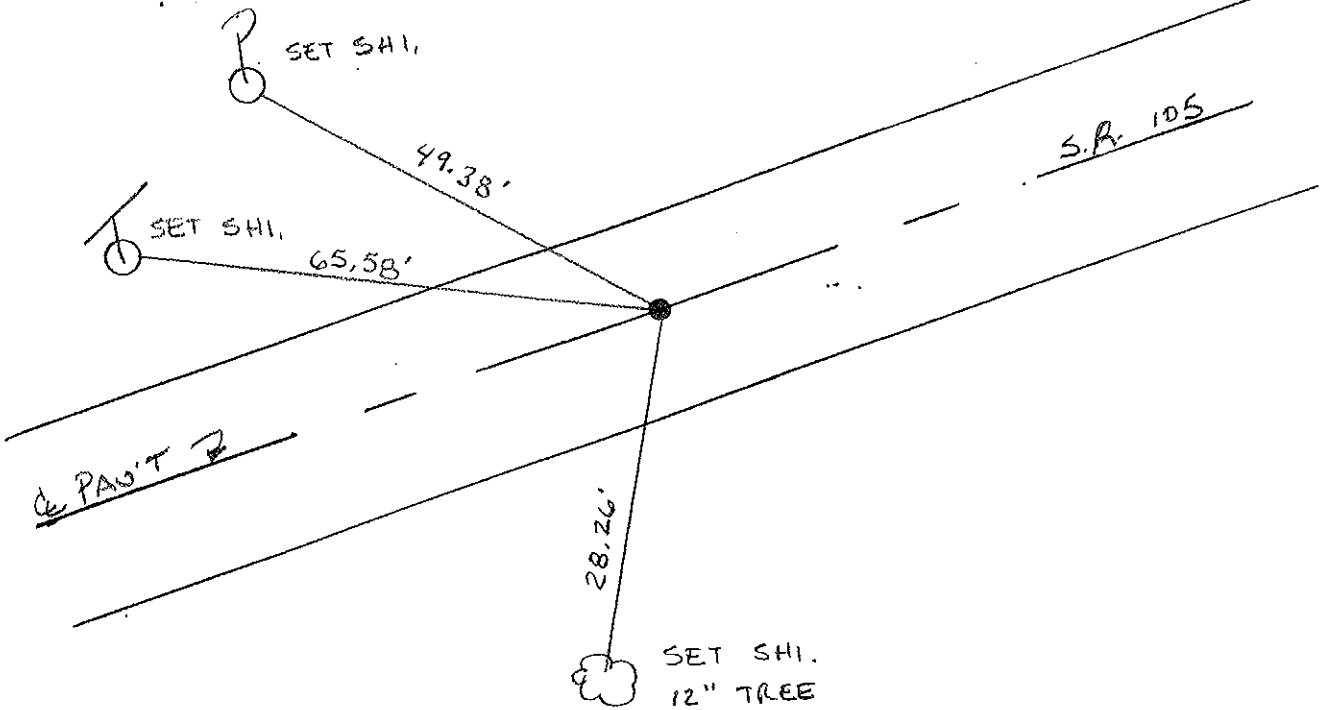

PERSONNEL	TITLE	PERSONNEL	TITLE	COUNTY	DATE
				S.R.	WEATHER
				SEC.	TEMP.

DESCRIPTION _____ JOB NO. _____

LEFT CENTER LINE RIGHT

