



O.D.O.T. DISTRICT 2 SURVEY OFFICE (USE ONLY)

PERSONNEL _____ REFERENCE NO. 50 E SHEET 27 OF 63
 NOTES MOSE DATE 4/14/00 ROUTE SR 105
 H.C. CANTERBURY WEATHER SUNNY COUNTY OTTAWA
 R.C. BARNHEISEL TEMP. +60° TOWNSHIP HARRIS
 DWG BY BALBAUGH PID 92131 SECTION 8
 T 6 N R 14 E

TYPE MONUMENT P.K.NAIL
 ON SURFACE - ~~BELOW~~ ON _____
 OFFSET \varnothing PAVEMENT 1.3' ~~RT~~ : RT
9.0' TO RT EDGE PAVEMENT
 STATION: 243+43
 HORZ.DATUM: _____ GEOID: _____
 GRID: NORTHING: _____ EASTING: _____

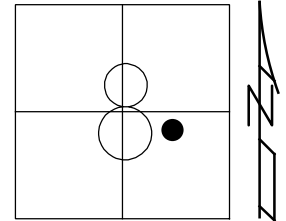

RECORD:
 UNKOWN ORIGIN
 POSSIBLE PROP. LINE
 STA.243+43
 FD P.K.NAIL
 4/14/00, MC
 D.N.F.
 7/30/19, JFO

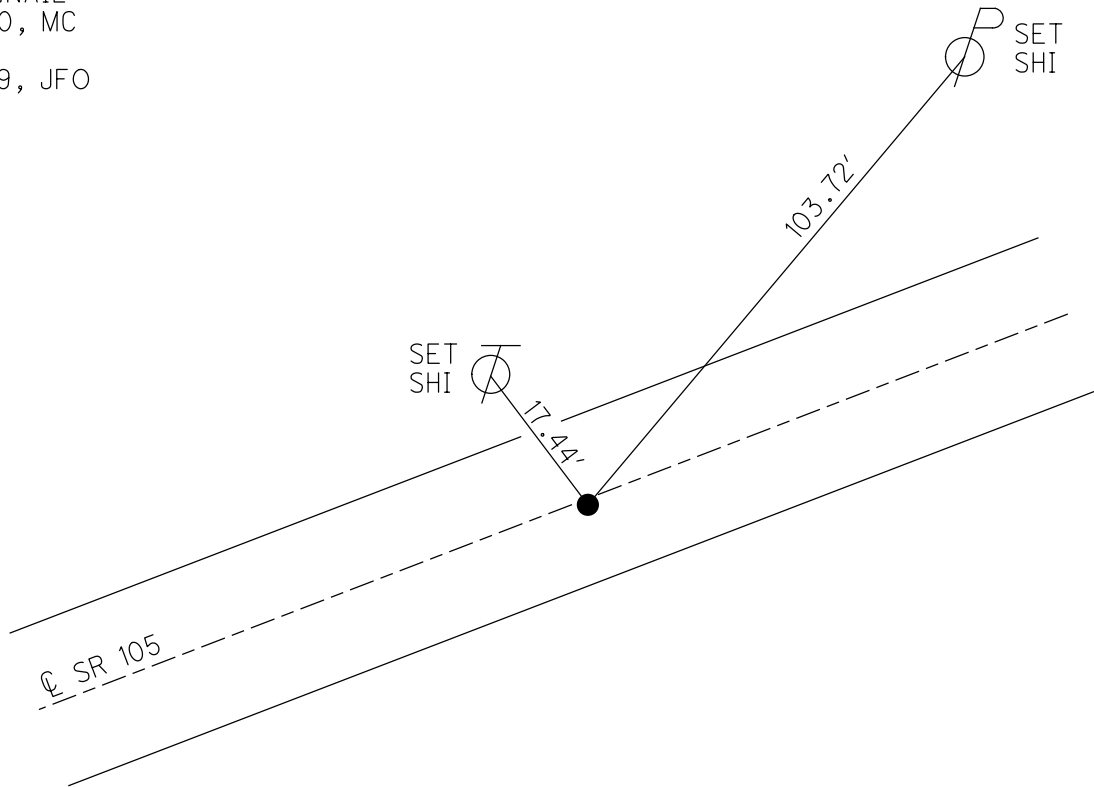

O.D.O.T. DISTRICT 2 SURVEY OFFICE

PERSONNEL

REFERENCE NO. 50-E

SHEET 23 OF 96

NOTES K. MOSER

H.C. M. CANTERBURY

DATE 4-14-00

ROUTE S.R. 105

R.C. M. BARNHISEL

WEATHER SUNNY

COUNTY OTTAWA


TEMP. +60°F

TOWNSHIP HARRIS

SECTION 8


T6 N R 14 E

TYPE MONUMENT PK NAIL
ON SURFACE - BELOW SURFACE
LEFT - C PAV'T. - RIGHT 1.3 RT
9.0 TO RT. EDGE PAVEMENT
S.L.M. 243 +43

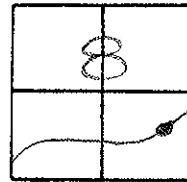

ORIGON UNKNOWN
POSSIBLE PROP LINE

DIG IF NEEDED

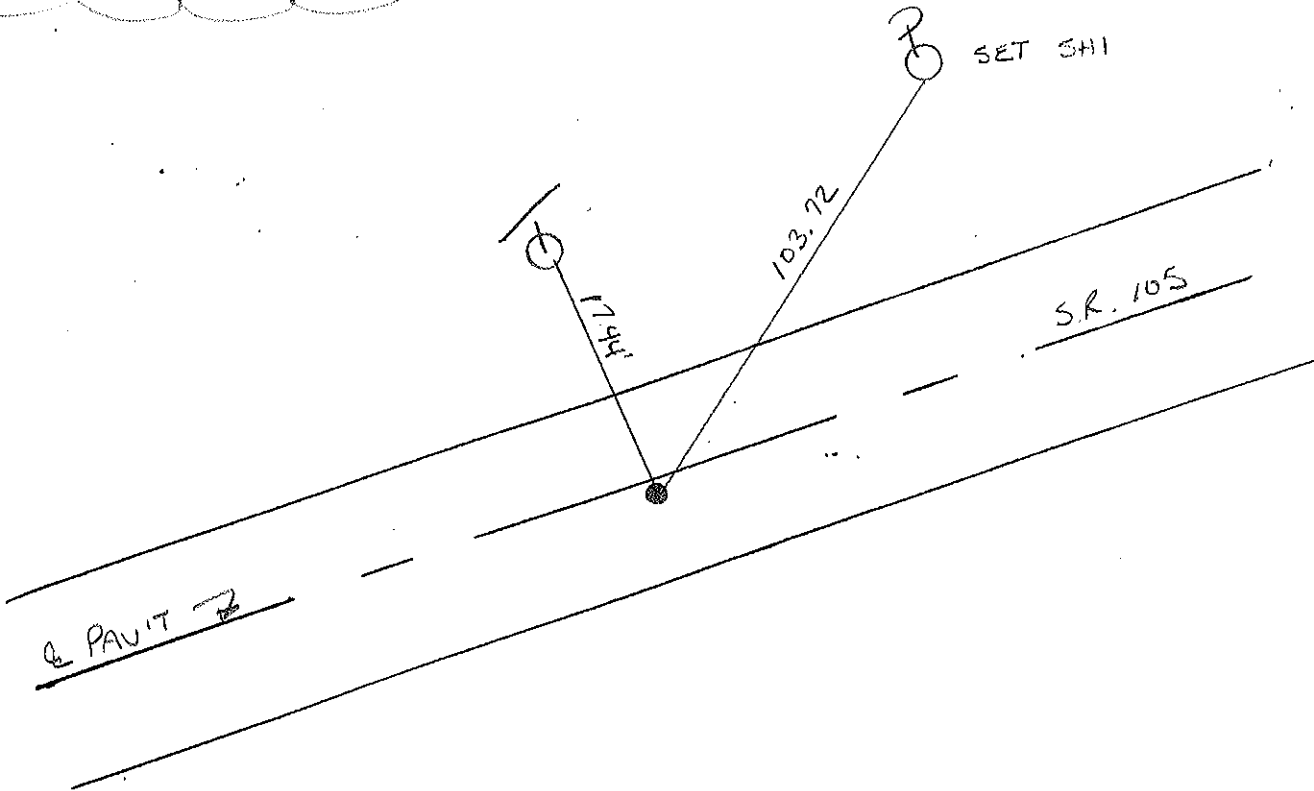

PERSONNEL	TITLE	PERSONNEL	TITLE	COUNTY	DATE
				S.R.	WEATHER
				SEC.	TEMP

DESCRIPTION _____ JOB NO. _____

