

O.D.O.T. DISTRICT 2 SURVEY OFFICE (USE ONLY)

PERSONNEL

REFERENCE NO. 55A

NOTES NIESE

DATE 8/19/25

ROUTE SR-105

H.C.

WEATHER

COUNTY OTTAWA

R.C.

TEMP.

TOWNSHIP HARRIS

DWG BY BARRIERE

PID

SECTION 8

T 6 N R 14 E

TYPE MONUMENT MAG NAIL

ON SURFACE - BELOW ON

OFFSET \oslash PAVEMENT

STATION: 254+20.90

HORZ.DATUM:


GEOID:

GRID: NORTHING:

EASTING:

LDP: NORTHING:

EASTING:

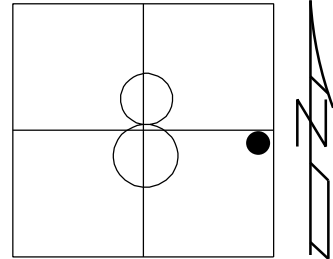

RECORD:

P.I. STA 254+20.90

OTT-105-04.90-2021

SEE PLANS FOR MORE DETAILS

**DRAWING CREATED FOR FUTURE REFERENCE.

POINT HAS NOT BEEN LOCATED AND

LOCATION WILL NEED VERIFIED IN FIELD.

8/19/25, TDN

