

O.D.O.T. DISTRICT 2 SURVEY OFFICE (USE ONLY)

PERSONNEL


REFERENCE NO. 55B

NOTES NIESE DATE 8/19/25
H.C. NIESE WEATHER _____
R.C. PRESTON-COLVIN TEMP. _____
FRUCHEY

ROUTE SR-105
COUNTY OTTAWA
TOWNSHIP HARRIS
SECTION 8
T 6 N R 14 E

DWG BY BARRIERE PID NO PID

TYPE MONUMENT MONBOX W/ 1" IPIN
ON SURFACE - BELOW ON
OFFSET $\oslash$ PAVEMENT ON

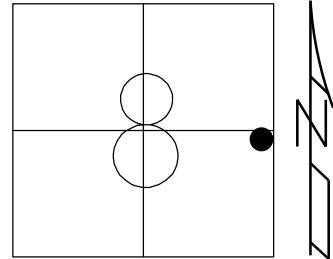

STATION: 256+78.74

HORZ.DATUM: NAD83 ('11) GEOID: 18

GRID: NORTHING: 666852.431 EASTING: 1759976.347

LDP: NORTHING: 326130.064 EASTING: 119883.508

RECORD:
P.I. STA 256+78.74
OTT-105-04.90-2021
SEE PLANS FOR MORE DETAILS

FD MONBOX W/ 1" IPIN
REF58
6/13/25, TDN

