


O.D.O.T. DISTRICT 2 SURVEY OFFICE (USE ONLY)



PERSONNEL _____ REFERENCE NO. 56 SHEET 35 OF 63
 NOTES MOSER DATE 4/14/00 ROUTE SR 105
 H.C. CANTERBURY WEATHER SUNNY COUNTY OTTAWA
 R.C. BARNHEISEL TEMP. +60° TOWNSHIP HARRIS
 _____ SECTION 8
 DWG BY BALBAUGH PID 92131 T 6 N R 14 E

TYPE MONUMENT 3/4" IPIN
 ON SURFACE - ~~BELOW~~ 1"
 OFFSET Q PAVEMENT 63'± LT : ~~RT~~
TO EDGE PAVEMENT
 STATION: 257+47.86

HORZ. DATUM: NAD83 2011 GEOID: 2012A
 GRID: NORTHING: 666917.223 EASTING: 1759989.566

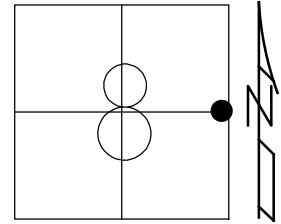

RECORD:
 FD 3/4" IPIN
 4/14/00, MC
 FD 3/4" IPIN
 3" DOWN
 REF56
 4/19/18, JFO

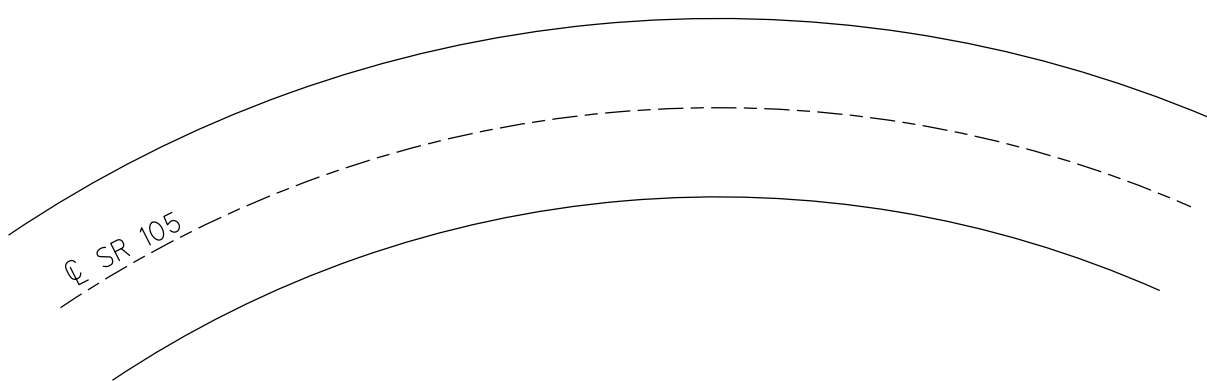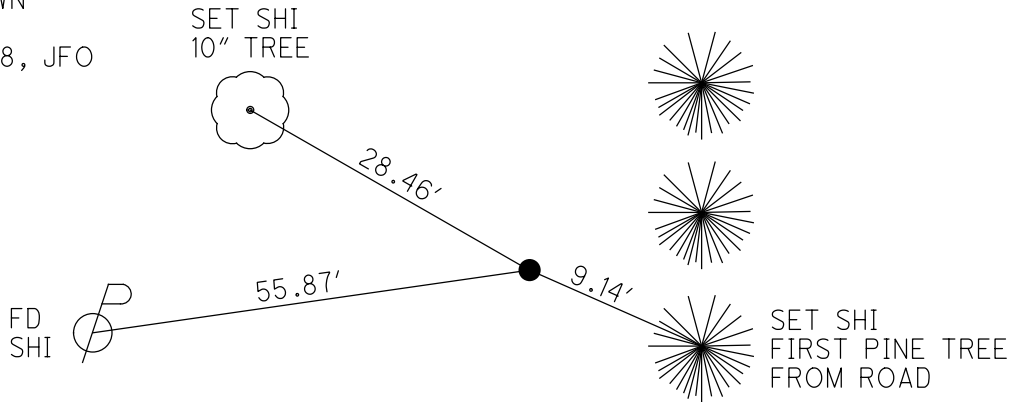

O.D.O.T. DISTRICT 2 SURVEY OFFICE

PERSONNEL

REFERENCE NO. 56

SHEET 28 OF 96

NOTES K. MOSER

H.C. M. CANTERBURY

R.C. M. BARNHISEL

DATE 4-14-00

WEATHER Sunny

TEMP. +60°F

ROUTE S.R. 105

COUNTY OTTAWA

TOWNSHIP HARRIS

SECTION 8

T6 N R14 E



TYPE MONUMENT 3/4" F. ROD

~~ON SURFACE~~ - BELOW 1" BELOW

LEFT - ~~C PAV'T~~ RIGHT 63' ± LT. OF C

TO EDGE PAVEMENT

S.L.M. 257 +97 ±

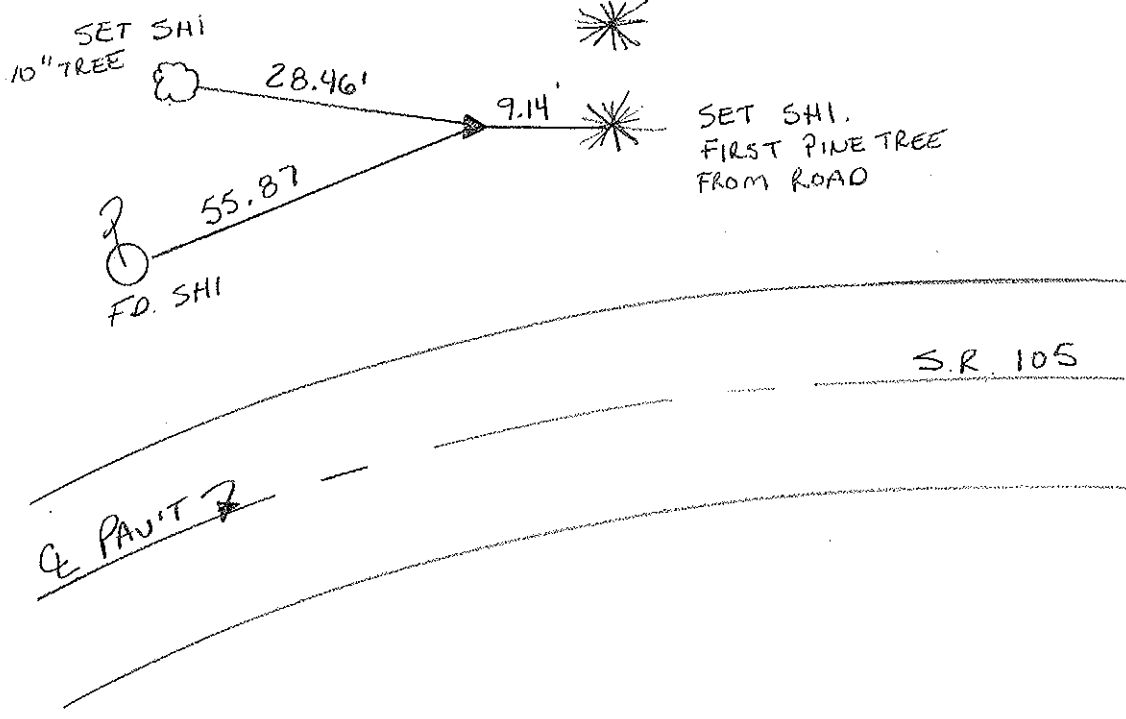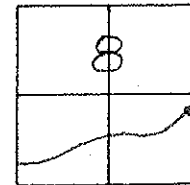

O.D.O.T. DISTRICT 2 SURVEY OFFICE

PERSONNEL _____

REFERENCE NO. 56

SHEET _____ OF _____

NOTES Cronin

H.C. Ripple

R.G. Barbour

Geyman

DATE Drawn 5/25/88

WEATHER sunny-windy

TEMP. 50°

ROUTE #105

COUNTY Ottawa

TOWNSHIP Harris

SECTION 8

T 6 N R 14 E



TYPE MONUMENT 3/4" I.R.d

ON SURFACE - BELOW _____

LEFT - CL PAV'T. - RIGHT 80' ± Lt. & Pav't

TO _____ EDGE PAVEMENT

S.L.M. 2557

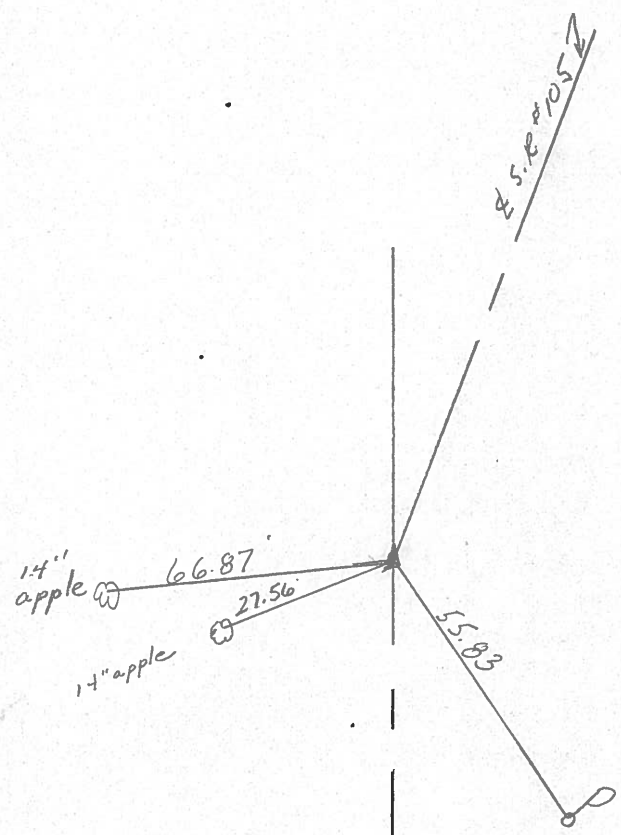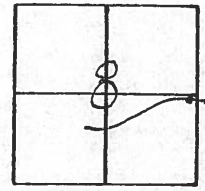

PERSONNEL TITLE PERSONNEL TITLE

COUNTY Ottawa

DATE 3-6-74

S. R. 105

WEATHER Cloudy

SEC. 8

TEMP. 40°

DESCRIPTION Harris Twp


LEFT

CENTER LINE

RIGHT


JOB NO.

P.I.
set 3/4" Rod
(56)

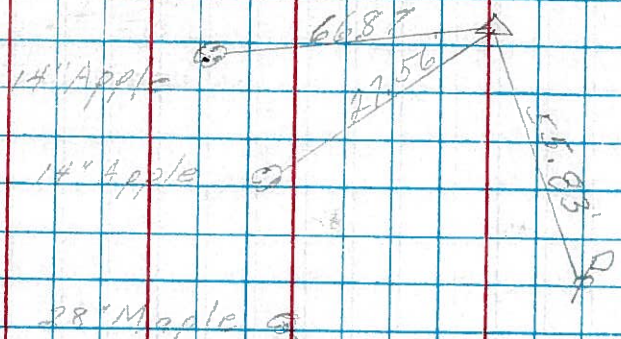

28" Maple
44.44'
36" Maple

250+ 69.5
Fd. R.R. Spk.
2" down (55)

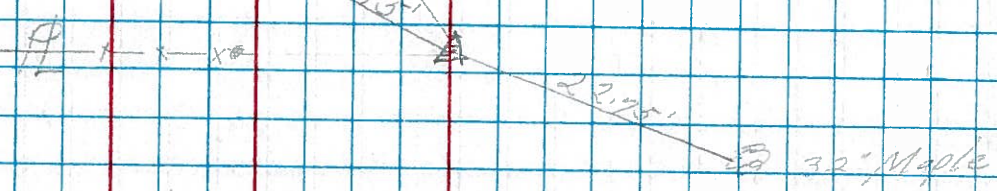

249+305
Fd. R.R. Spk.
2" down (54)

