


O.D.O.T. DISTRICT 2 SURVEY OFFICE (USE ONLY)


PERSONNEL \_\_\_\_\_ REFERENCE NO. 68 SHEET 50 OF 63  
 NOTES RHOADES DATE 7/30/19 ROUTE SR 105  
 H.C. O'DONNELL WEATHER CLOUDY COUNTY OTTAWA  
 R.C. MILLER TEMP. 82° TOWNSHIP HARRIS  
 \_\_\_\_\_ SECTION 9  
 DWG BY BALBAUGH PID 92131 T 6 N R 14 E

TYPE MONUMENT P.K./WASHER  
 ON SURFACE - ~~BELOW~~ ON \_\_\_\_\_  
 OFFSET ☐ PAVEMENT 1.3' LT : ~~RT~~  
9.7' TO LT EDGE PAVEMENT  
 STATION: 304+27.18

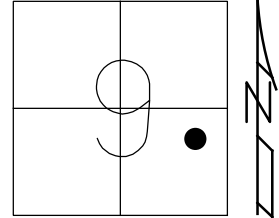

HORZ.DATUM: NAD83 2011 GEOID: 2012A  
 GRID: NORTHING: 666105.863 EASTING: 1764607.679

RECORD:  
 FD P.K.SHANK  
 4/18/00, MC  
 SET P.K./WASHER  
 6/22/00, KPM  
 FD P.K.NAIL  
 REF68  
 4/27/18, JFO  
 FD P.K.NAIL/WASHER  
 7/30/19, JFO  
 SET MAG/WASHER  
 12/20/19, JFO

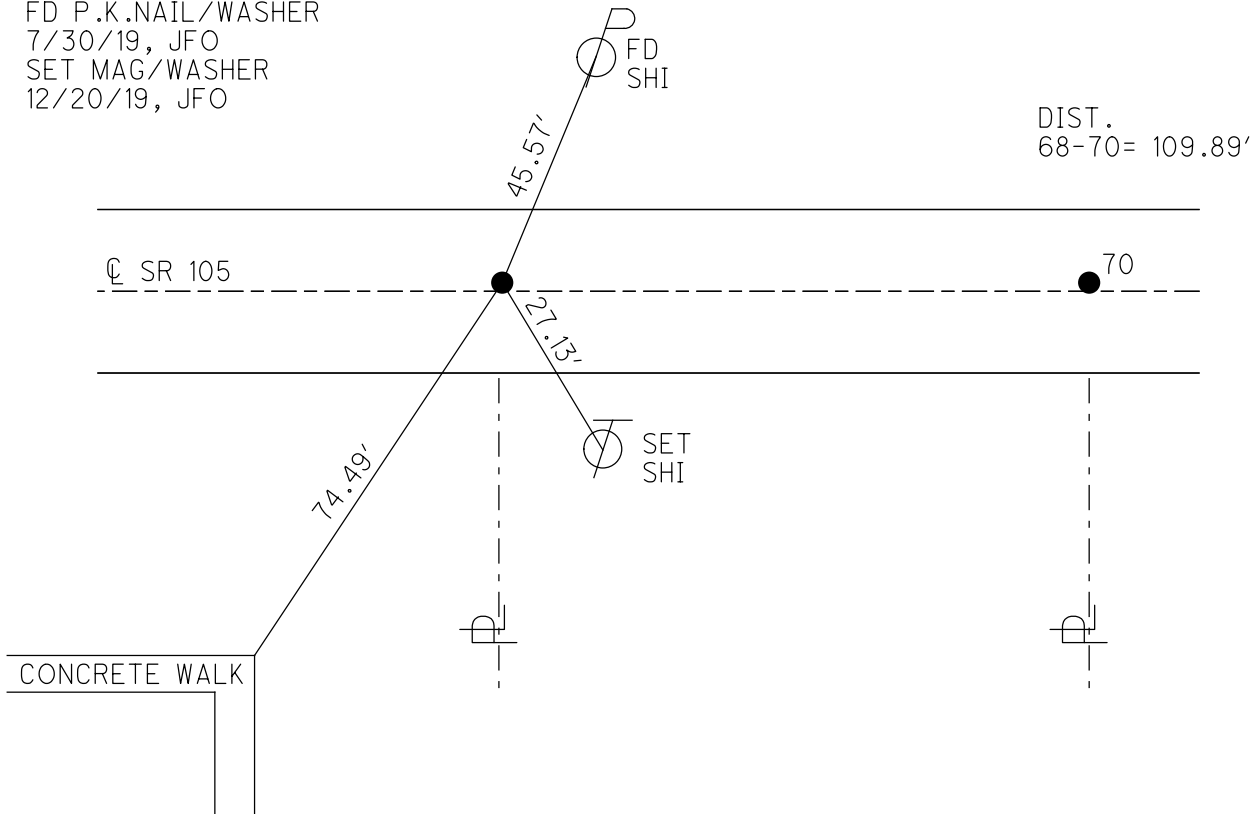

# O.D.O.T. DISTRICT 2 SURVEY OFFICE

PERSONNEL

NOTES K. MOSER

H.C. M. CANTERBURY

R.C. M. BARNAISEL

REFERENCE NO. 68, 70  
# 69 - D.N.F.

DATE 4-18-00

WEATHER CLOUDY

TEMP. +55 °F

SHEET 41 OF 96

ROUTE S.R. 105

COUNTY OTTAWA

TOWNSHIP HARRIS

SECTION \_\_\_\_\_

T6 N R 14 E


TYPE MONUMENT A = PK SHANK B = PK NAIL

ON SURFACE - BELOW A = 2" BELOW B = SURFACE


LEFT - C PAV'T - RIGHT A = 1.3' LT B = 1.3' LT

A = 9.7'  
B = 10.2' TO LT. EDGE PAVEMENT

S.L.M. A = 305 + 01 B = 306 + 11

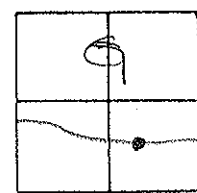

RESET PK/WASHER  
6:22-00  
K.P.M

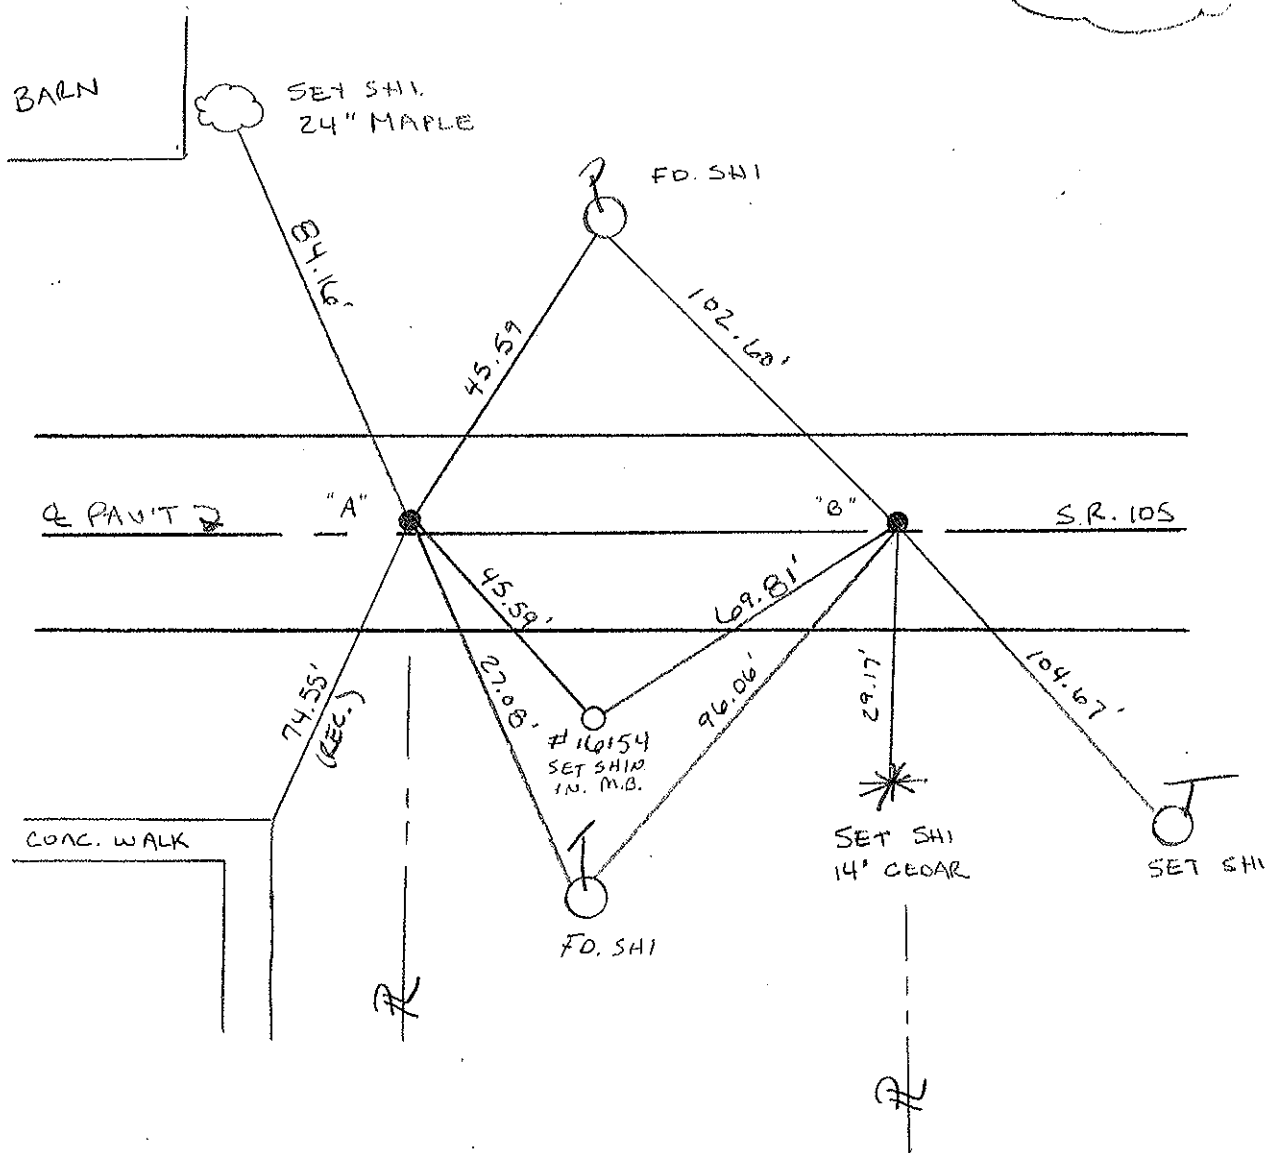


PERSONNEL TITLE PERSONNEL TITLE

COUNTY Ottawa DATE 3-13-74

S. R. 105 WEATHER Cold-Windy

SEC. 4-19-00 CLOUDY +6000 TEMP 25°

DESCRIPTION Harris Twp. LEFT CENTER LINE RIGHT JOB NO.

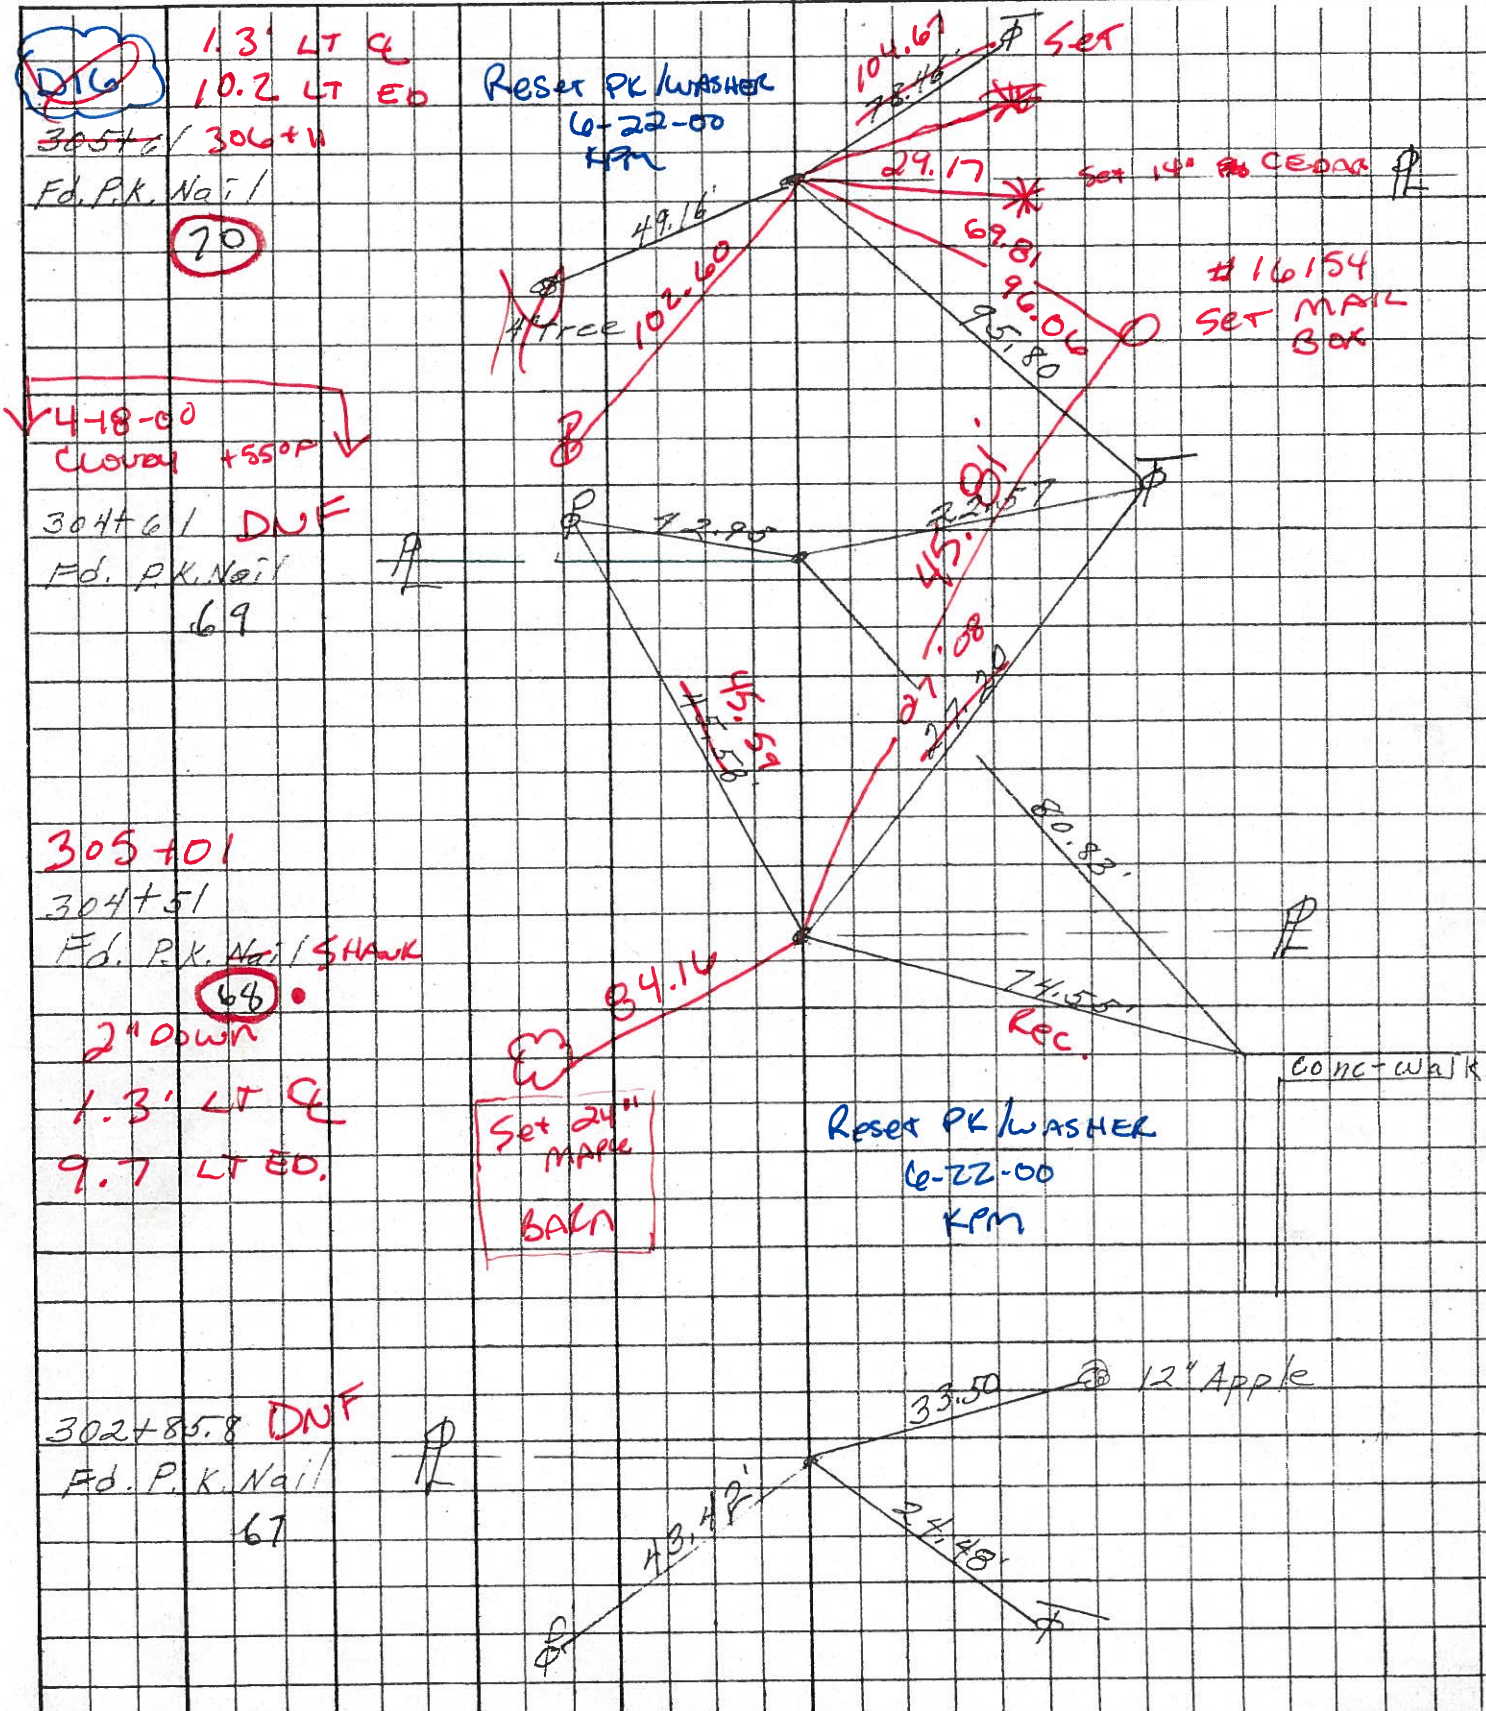



PERSONNEL TITLE PERSONNEL TITLE

COUNTY Ottawa

DATE 3-13-74

S. R. 105

WEATHER Cold-windy

SEC. 9

TEMP. 25°

DESCRIPTION Harris Twp.


JOB NO.

LEFT


CENTER LINE

RIGHT


305+61  
Fd. P.K. Nail  
70

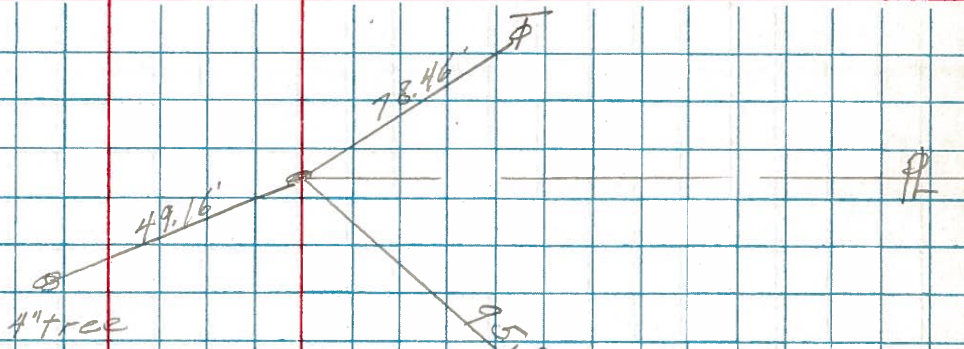

304+61  
Fd. P.K. Nail  
69

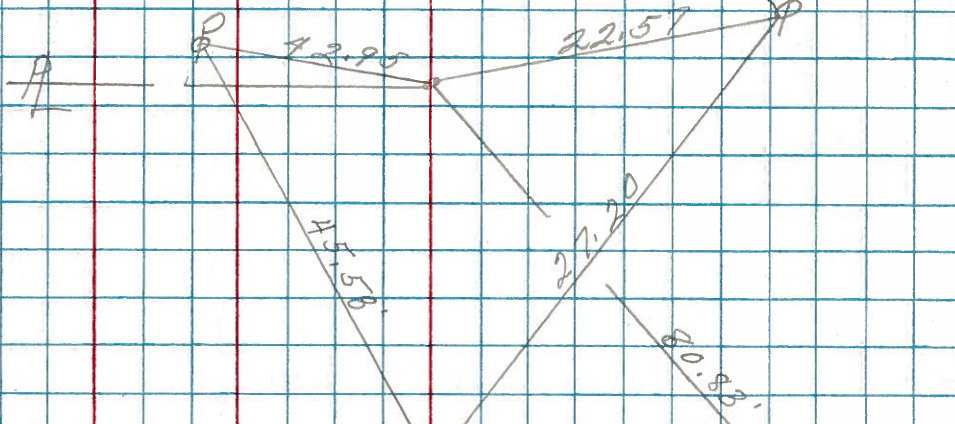

304+51  
Fd. P.K. Nail  
68

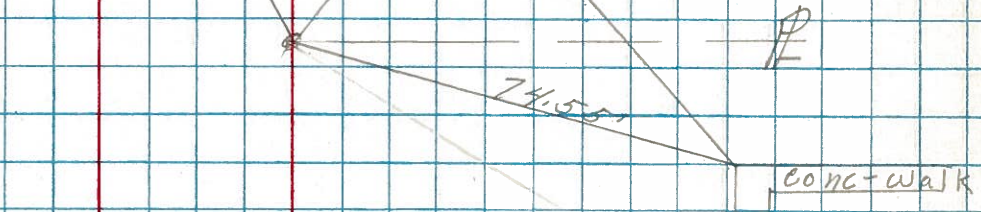

302+85.8  
Fd. P.K. Nail  
67

