

PERSONNEL TITLE PERSONNEL TITLE

COUNTY Ottawa

DATE 3-13-74

S. R. 105

WEATHER Cold-Windy

SEC.

4-19-00  
CLOUDY  
+600P

TEMP. 25°


DESCRIPTION Harris Twp.

JOB NO.

LEFT

CENTER LINE

RIGHT

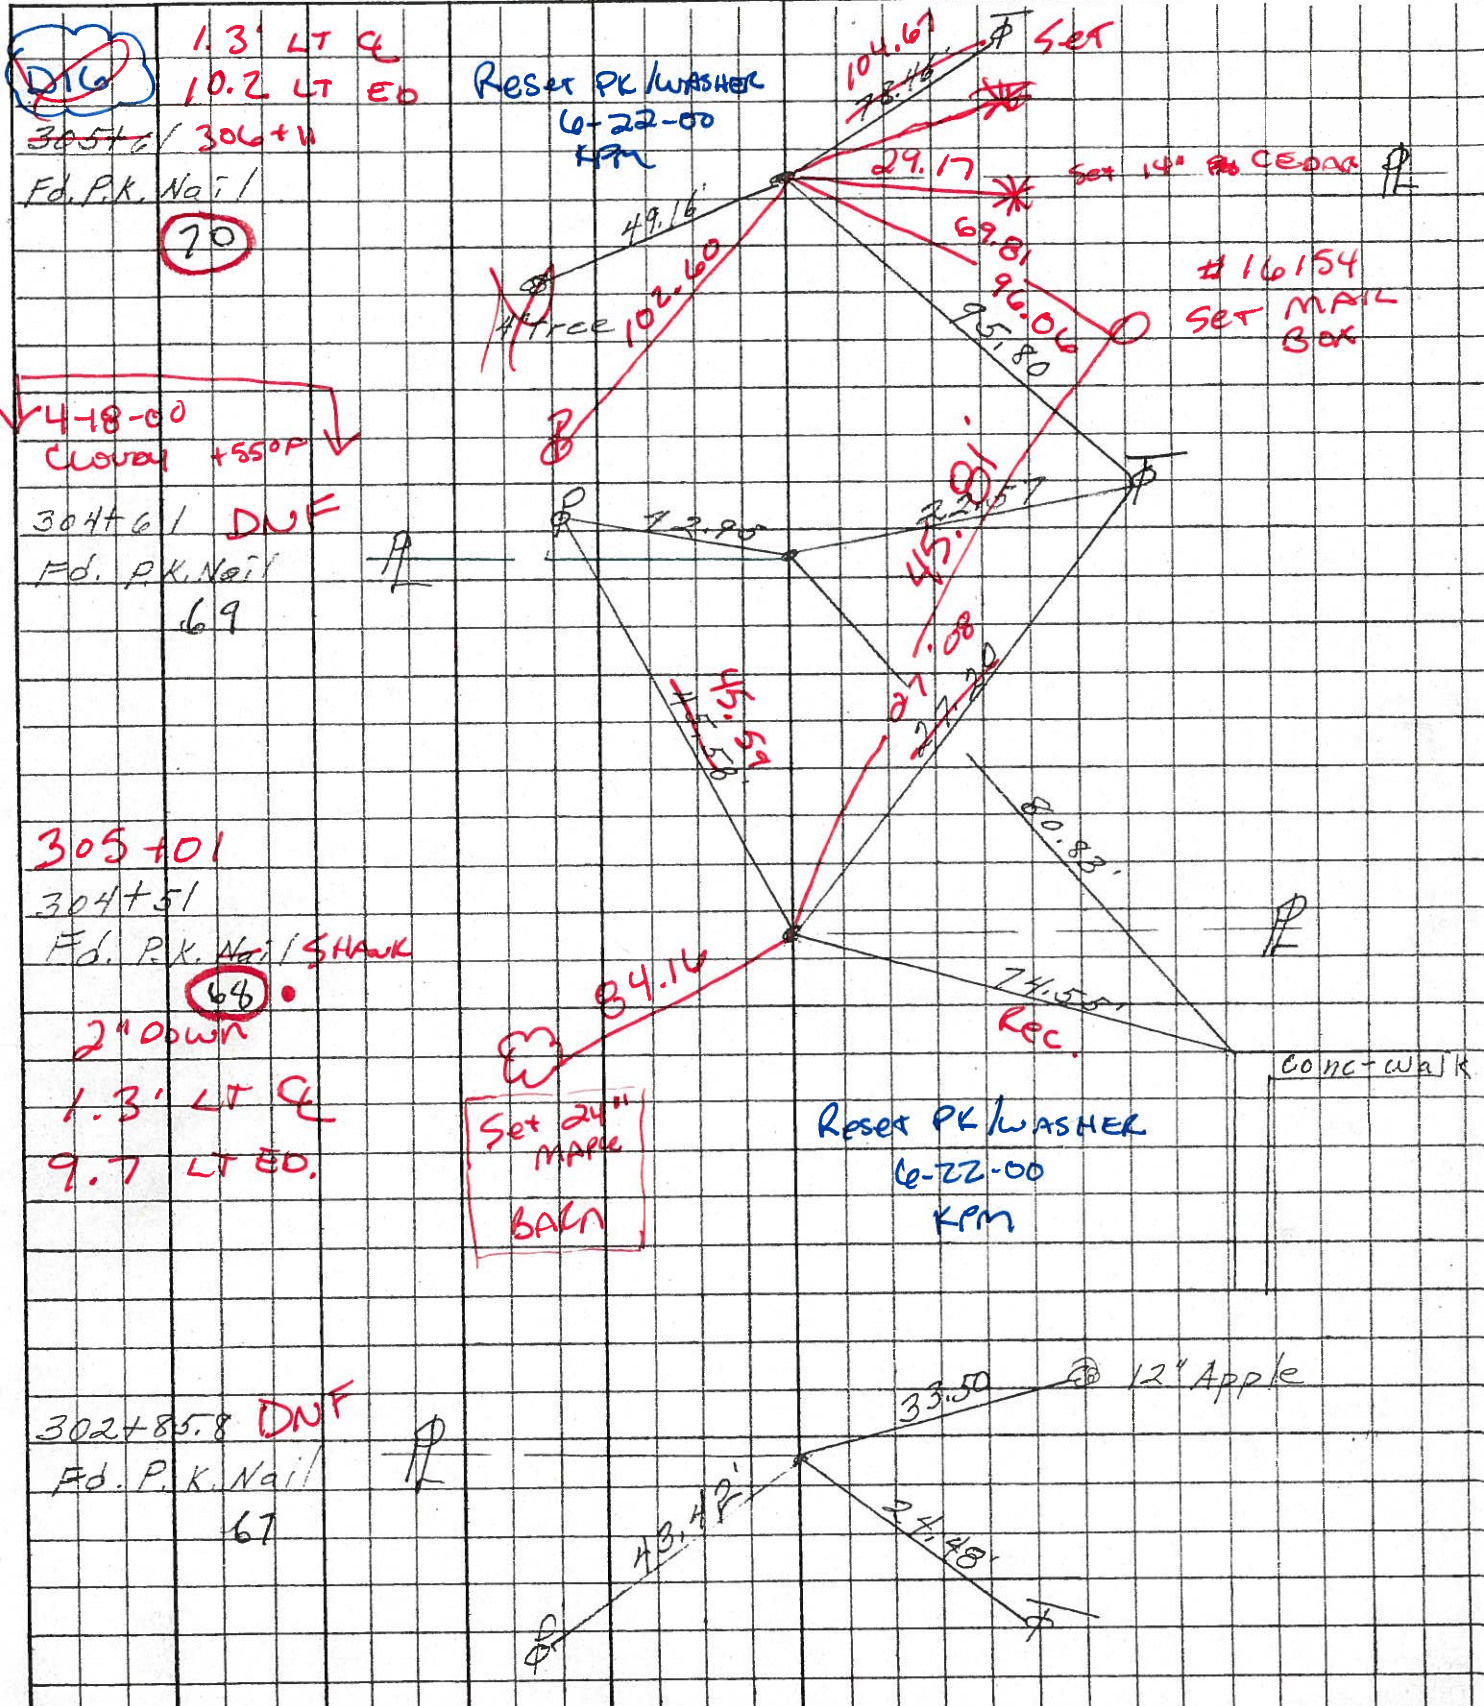

|             |       |           |       |             |        |         |            |
|-------------|-------|-----------|-------|-------------|--------|---------|------------|
| PERSONNEL   | TITLE | PERSONNEL | TITLE | COUNTY      | Ottawa | DATE    | 3-13-74    |
|             |       |           |       | S. R.       | 105    | WEATHER | Cold-windy |
|             |       |           |       | SEC.        | 9      | TEMP.   | 25°        |
| DESCRIPTION |       |           |       | HARRIS TWP. |        | JOB NO. |            |

