

O.D.O.T. DISTRICT 2 SURVEY OFFICE (USE ONLY)

PERSONNEL

REFERENCE NO. 72

SHEET 53 OF 63

NOTES MOSER

DATE 4/18/00

ROUTE SR 105

H.C. CANTERBURY

WEATHER CLOUDY

COUNTY OTTAWA

R.C. BARNHISEL

TEMP. +55°

TOWNSHIP HARRIS

SECTION 9

DWG BY BALBAUGH PID 92131

T 6 N R 14 E

TYPE MONUMENT D.N.F.

ON SURFACE - BELOW \_\_\_\_\_


OFFSET  $\text{C}$  PAVEMENT \_\_\_\_\_ LT : RT

\_\_\_\_\_ TO \_\_\_\_\_ EDGE PAVEMENT

STATION: 311+48±


HORZ.DATUM: \_\_\_\_\_ GEOID: \_\_\_\_\_

GRID: NORTHING: \_\_\_\_\_ EASTING: \_\_\_\_\_

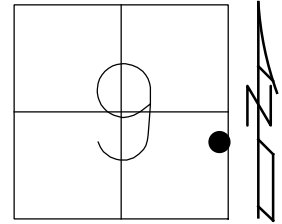

RECORD:  
 STA. 311+30  
 SET IPIN  
 1' DOWN  
 1974  
 D.N.F.  
 4/18/00, MC  
 D.N.F.  
 6/22/00, KPM  
 D.N.F.  
 4/30/18, JFO

NOTE: CALC PT  
 N: 665975.664  
 E: 1765275.835

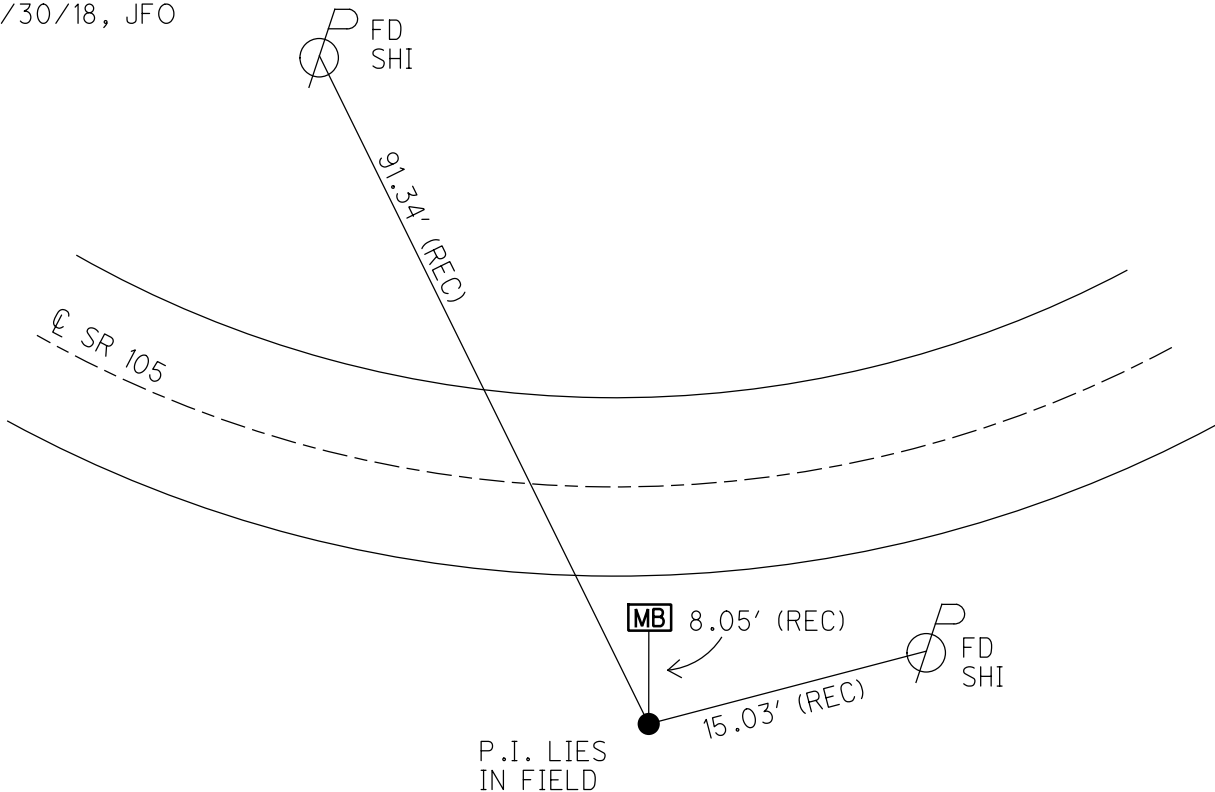

# O.D.O.T. DISTRICT 2 SURVEY OFFICE

PERSONNEL

REFERENCE NO. 72

SHEET 43 OF 96

NOTES K. MOSER

H.C. M. CANTERBURY

DATE 4-18-00

ROUTE S.R. 105

R.C. M. BARDHISEL

WEATHER CLOUDY

COUNTY OTTAWA

TEMP. +55 °F

TOWNSHIP HARRIS

SECTION 9

T6 N R 14 E


TYPE MONUMENT DNF

ON SURFACE - BELOW —

LEFT - & PAV'T. - RIGHT —


— TO — EDGE PAVEMENT

S.L.M. 307 +81 ±

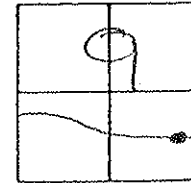

RECORD: SET I. ROD  
311-130 1' DOWN  
E = 22' "1974

D.N.F.  
RESET WHEN  
NEEDED

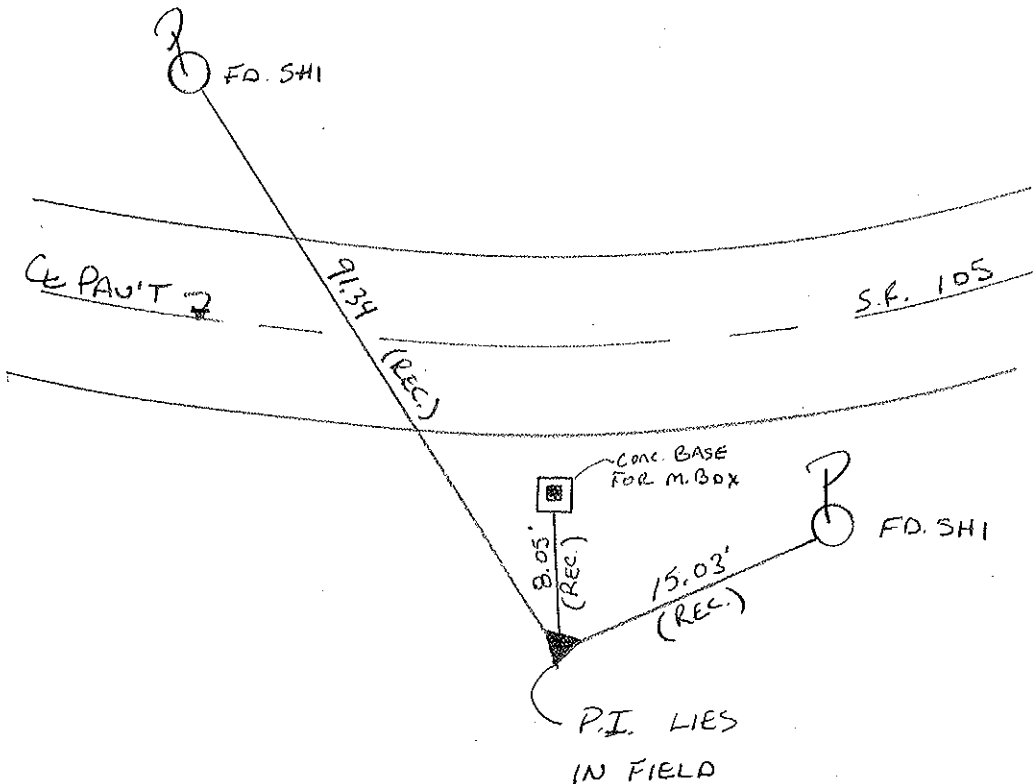

# O.D.O.T. DISTRICT 2 SURVEY OFFICE

PERSONNEL \_\_\_\_\_ REFERENCE NO. 72 SHEET \_\_\_\_\_ OF \_\_\_\_\_

NOTES Cronin DRAWN 6/02/88

H.C. Ripple DATE 5/26/87 ROUTE #105

R.C. Barbour WEATHER sunny COUNTY Ottawa

Geyman TEMP. \_\_\_\_\_ TOWNSHIP Harris

SECTION 9

T. 6 N. R. 14 E.


TYPE MONUMENT I. Rod

ON SURFACE - BELOW 1'


LEFT - & PAV'T. - RIGHT 22'

TO \_\_\_\_\_ EDGE PAVEMENT

S.L.M. 311f30

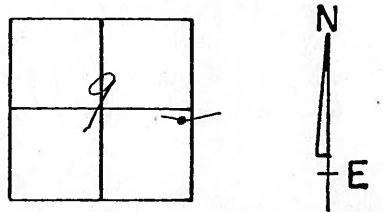

\* this point should  
be checked to see  
if it coincides with  
survey points ahead

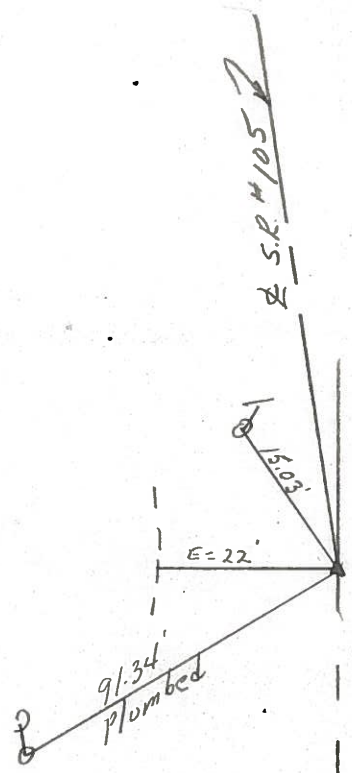

# O.D.O.T. DISTRICT 2 SURVEY OFFICE

PERSONNEL \_\_\_\_\_

REFERENCE NO. 72

SHEET \_\_\_\_\_ OF \_\_\_\_\_

NOTES Hoffman

H.C. Loehle

DATE 5-9-85

ROUTE SR 105

R.C. BARWISSEL

WEATHER Clear

COUNTY OTTAWA

\_\_\_\_\_

TEMP. 65°

TOWNSHIP HARRIS

\_\_\_\_\_

SECTION 9

T \_\_\_\_\_ R \_\_\_\_\_

TYPE MONUMENT I. 200

ON SURFACE - BELOW 1'

~~LEFT~~ - & PAW'T. - RIGHT 22.4'

10.4 TO RT EDGE PAVEMENT

S.L.M. 311 + 30

