

O.D.O.T. DISTRICT 2 SURVEY OFFICE (USE ONLY)

PERSONNEL

REFERENCE NO. 107

SHEET 18 OF 42

NOTES RHOADES
 H.C. O'DONNELL
 R.C. MILLER

DATE 8-1-2019
 WEATHER SUNNY
 TEMP. 78°F

ROUTE SR 105
 COUNTY OTTAWA
 TOWNSHIP HARRIS
 SECTION 12
 T 6 N R 14 E

DWG BY AUBLE PID 92131

TYPE MONUMENT P.K.NAIL


ON SURFACE - ~~BELOW~~ ON _____

OFFSET 0.9' LT : ~~RT~~
9.3' TO LT EDGE PAVEMENT


STATION: 463+00.19

HORIZ.DATUM: NAD83 (2011) GEOID: 2012A

GRID: NORTHING: 668687.685 EASTING: 1780138.199

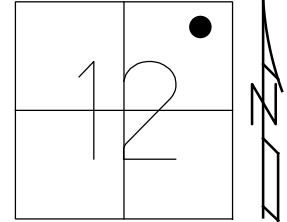

RECORD: P.I.
 Δ= 01° 31' 00" RT
 FD P.K./WASHER
 4/24/00, MB
 SET P.K./WASHER
 6-13-00, MDB
 FD P.K./WASHER
 REF107
 5-8-18, JFO
 SET MAG/WASHER
 4-8-20, JFO

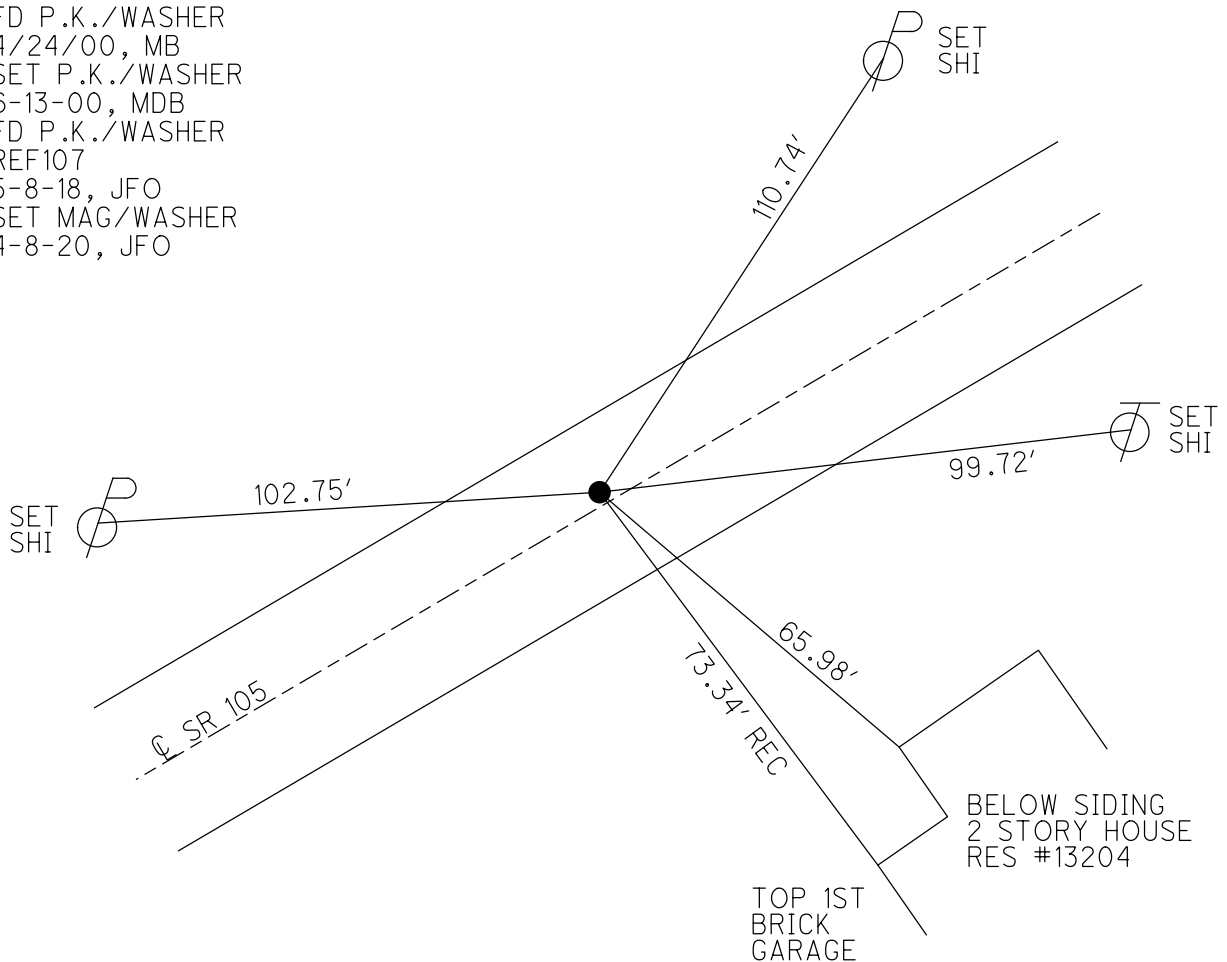

O.D.O.T. DISTRICT 2 SURVEY OFFICE

PERSONNEL

REFERENCE NO. 107

SHEET 74 OF 96

NOTES M. BARNHISEL

H.C. M. CAUTERBURY

R.C. M. BARNHISEL

Drawn By: K. M. SER

DATE 4-24-00

WEATHER Sunny

TEMP. +60°F

ROUTE S.R. 105


COUNTY OTTAWA

TOWNSHIP HARRIS

SECTION 12


T6 N R 14 E

TYPE MONUMENT PK / WASHER
 ON SURFACE - ~~BELOW~~ SURFACE
 LEFT - ~~0 PAV'T~~ RIGHT 0.9' LT
9.3 TO LT. EDGE PAVEMENT
 S.L.M. 464 + 18

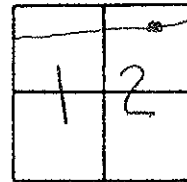

RECORD: $PI = \Delta = 01^{\circ} - 31' - 00'' RT$

RESET PK / WASHER
 6-13-00
 MAB

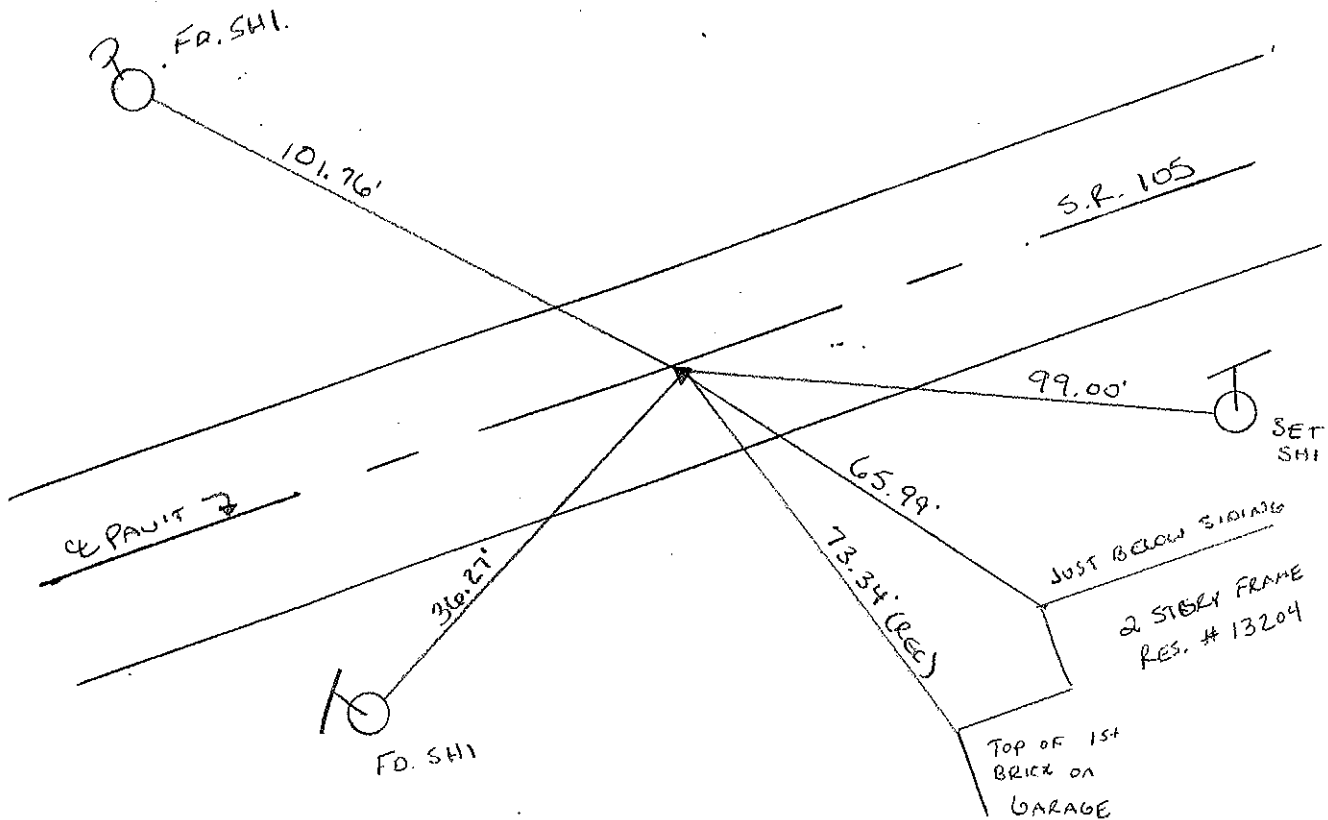

O.D.O.T. DISTRICT 2 SURVEY OFFICE

PERSONNEL _____ REFERENCE NO. 107 SHEET _____ OF _____

NOTES Cronin DRAWN 6/06/88

H.C. Ripple DATE 8/20/87 ROUTE # 105

R.C. Barbour WEATHER sunny COUNTY Ottawa

Geyman TEMP. 79° TOWNSHIP Harris

SECTION 12

T 6 N 14 E


TYPE MONUMENT P.K. & washer

ON SURFACE - BELOW _____

LEFT - & PAV'T. - RIGHT 1'

TO _____ EDGE PAVEMENT



S.L.M. 463+25

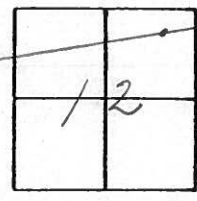

A = 01° 31' 00" Rt.

P.K. at top bent R.R.

spike below P.K. & washer

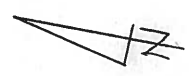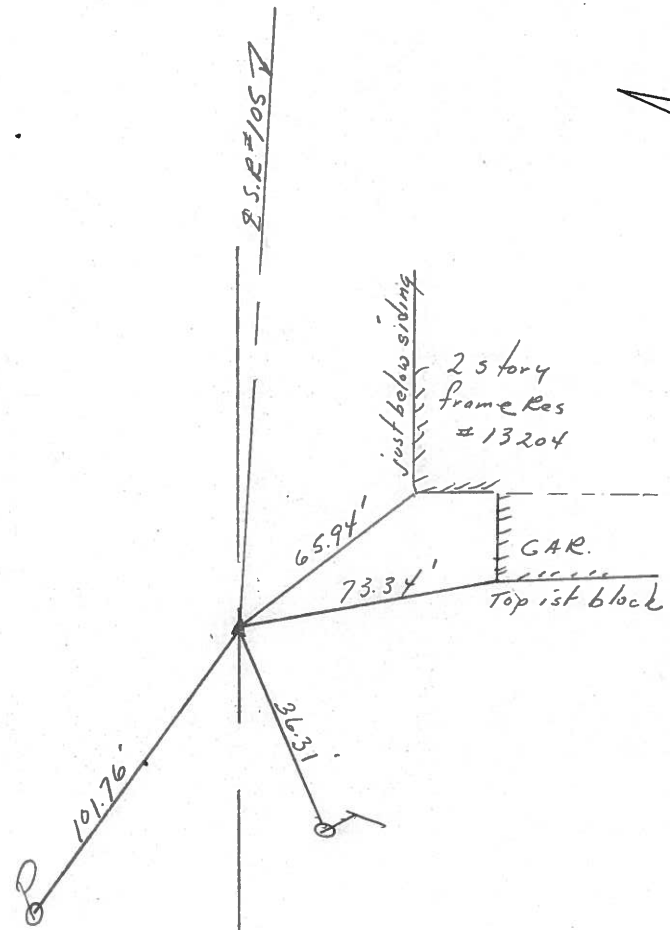

PERSONNEL TITLE PERSONNEL TITLE

COUNTY Ottawa DATE 5-21-74

S. R. 105 WEATHER Fair

SEC. 12 TEMP 75°


DESCRIPTION Harris Twp.

JOB NO.

LEFT

CENTER LINE

RIGHT

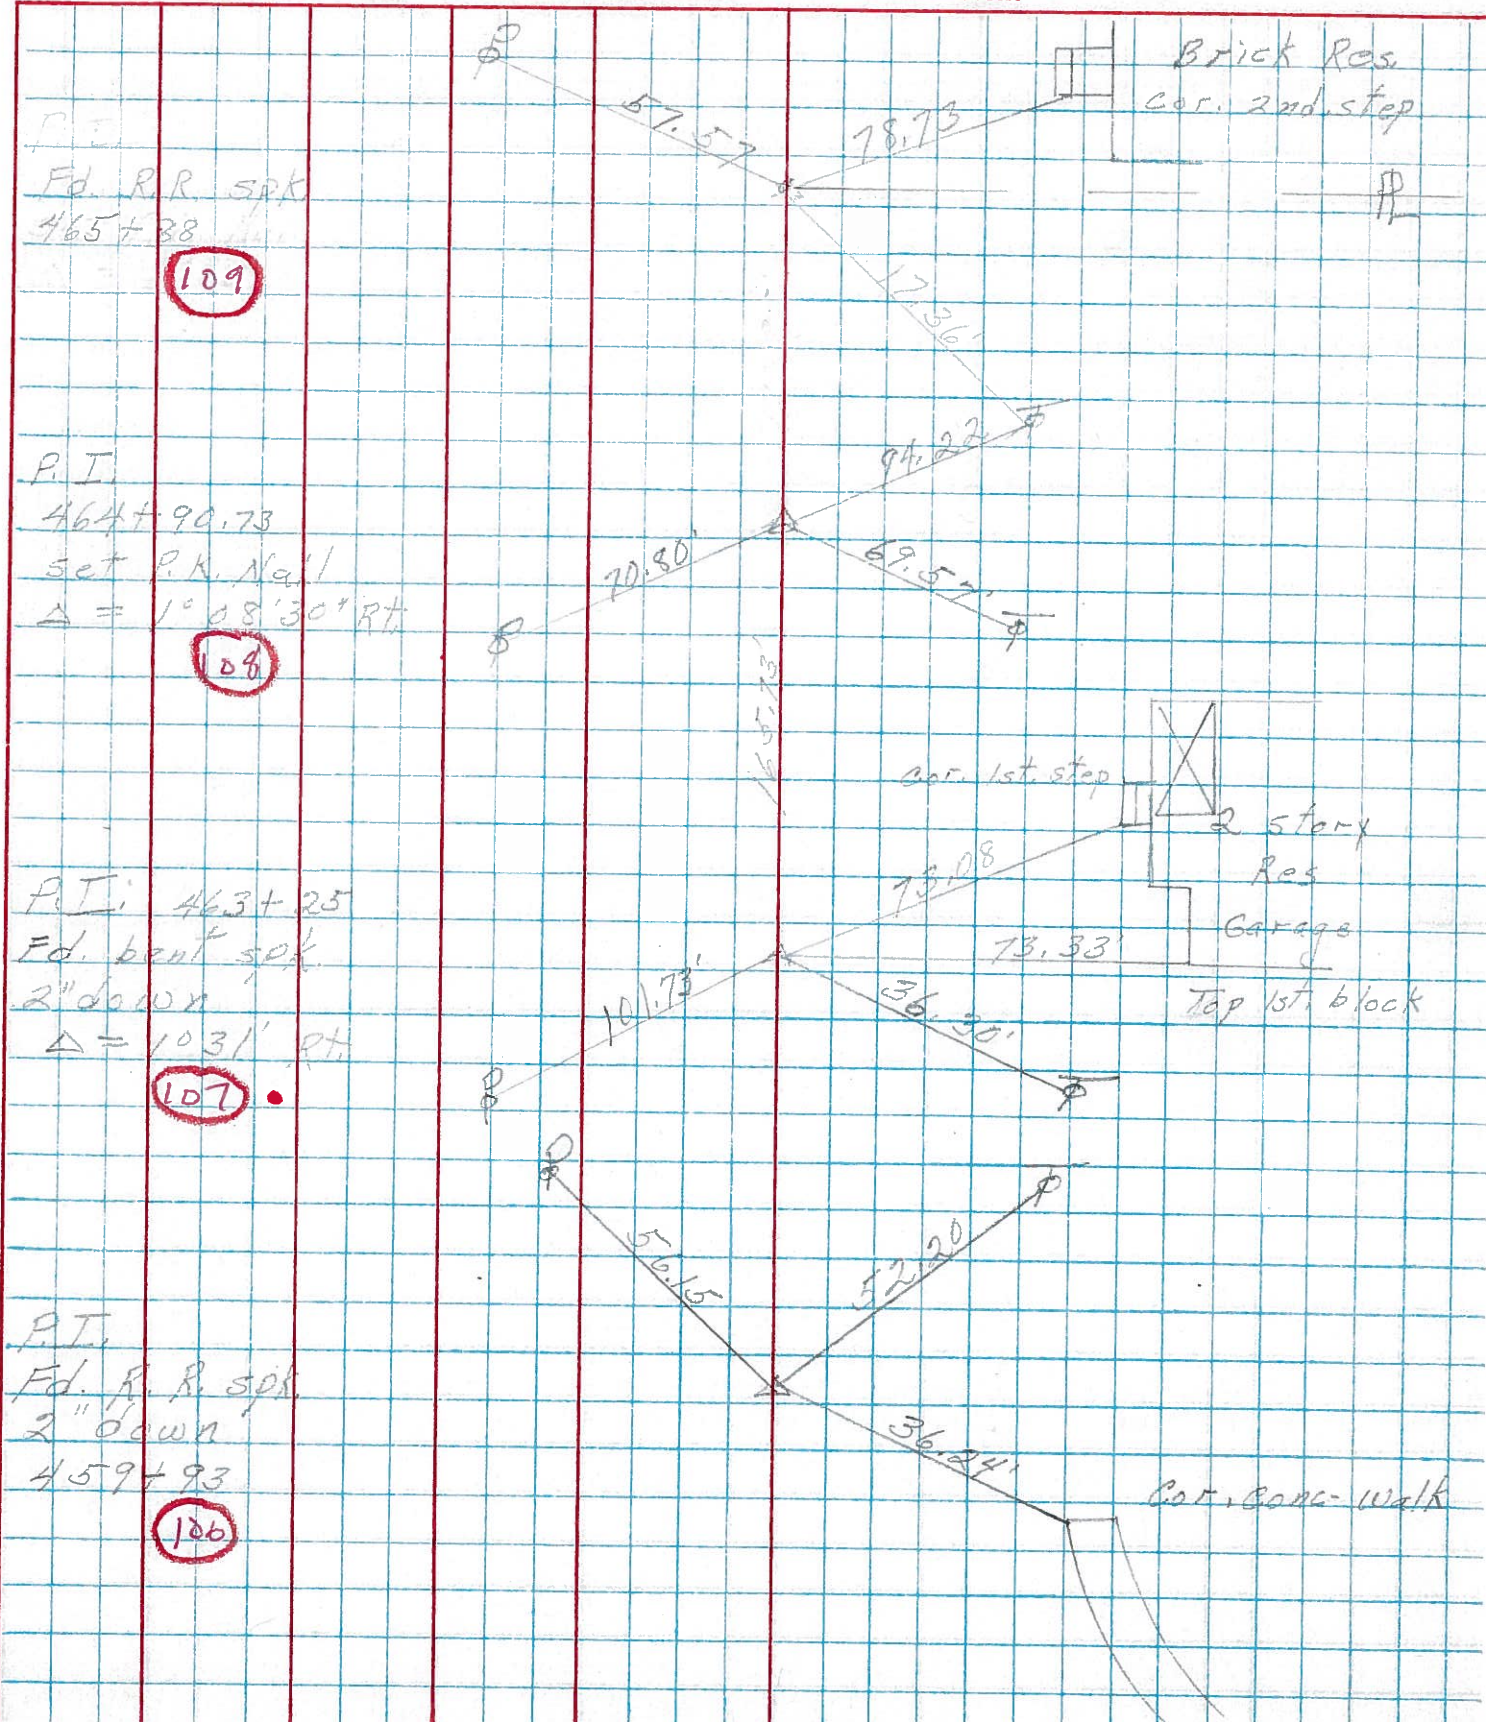

P.E.
Fd. R.R. spk
465+38
109

P.I.
464+90.73
set P.K. Nail
 $\Delta = 1^{\circ}08'30''$ RT
108

P.T.
463+25
Fd. bent spk
2" down
 $\Delta = 1031'$ RT
107

P.T.
Fd. R. R. spk
2" down
459+93
106

Brick Res.
cor. 2nd. step

cor. 1st. step
2 story
Res
Garage
Top 1st. block

Cor. Conc. walk

165.73

57.57

78.73

12.36

94.22

70.80

69.57

73.08

73.33

36.30

101.73

56.15

52.20

36.24