



O.D.O.T. DISTRICT 2 SURVEY OFFICE (USE ONLY)

PERSONNEL _____ REFERENCE NO. 110 SHEET 21 OF 42
 NOTES RHOADES DATE 8-5-2019 ROUTE SR 105
 H.C. O'DONNELL WEATHER SUNNY COUNTY OTTAWA
 R.C. MILLER TEMP. 74°F TOWNSHIP HARRIS
 DWG BY AUBLE PID 92131 SECTION 12
 T 6 N R 14 E

TYPE MONUMENT P.K./WASHER
 ON SURFACE - ~~BELOW~~ ON _____
 OFFSET C PAVEMENT 1.2' LT : ~~RT~~
8.7' TO LT EDGE PAVEMENT
 STATION: 466+59.91
 HORZ. DATUM: NAD83 (2011) GEOID: 2012A
 GRID: NORTHING: 668752.189 EASTING: 1780492.069

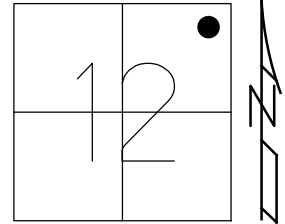

RECORD: P.I.
 $\Delta = 01^\circ 05' 00''$ RT
 FD P.K./WASHER
 4/24/00, MB
 RESET PK/W
 6-13-00, KPM
 FD P.K./WASHER
 REF110
 5-8-18, JFO
 SET MAG/WASHER
 4-8-20, JFO

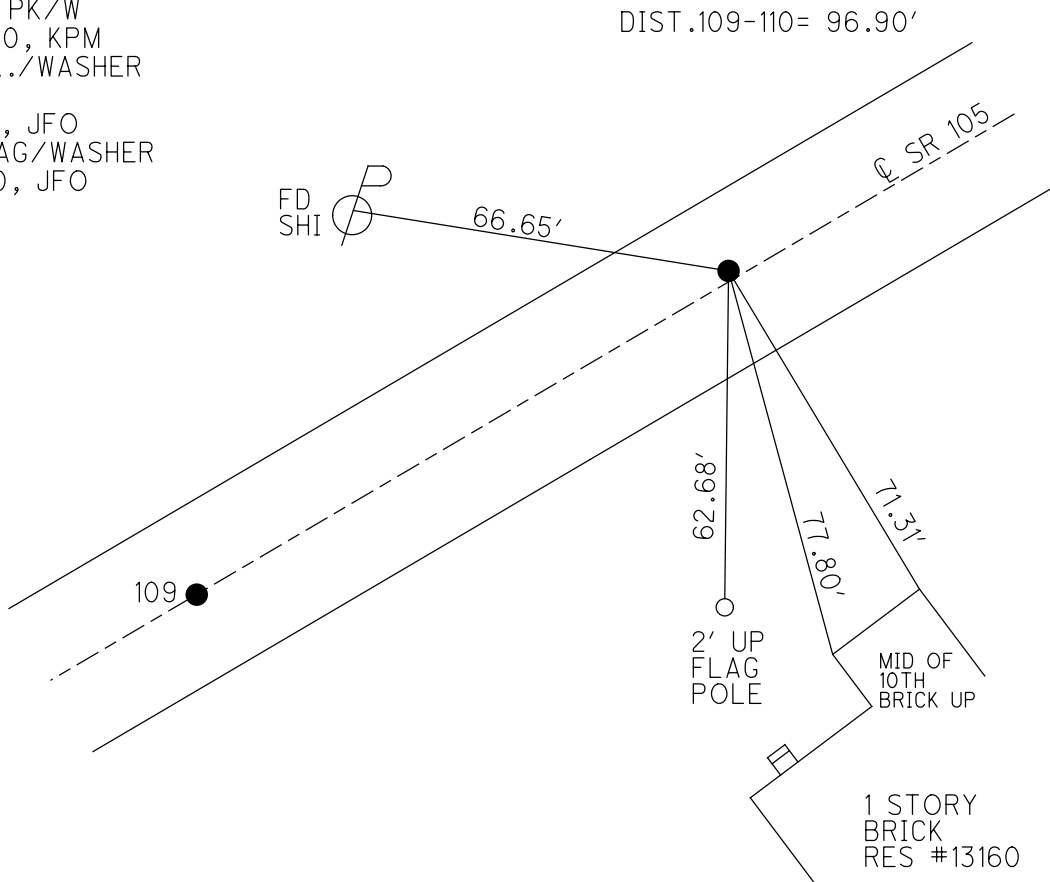

O.D.O.T. DISTRICT 2 SURVEY OFFICE

PERSONNEL

REFERENCE NO. 110

SHEET 77 OF 96

NOTES M. BARNHISEL

H.C. M. CAUTERBURY

R.C. M. BARNHISEL

DRAWN BY: K. MOSER

DATE 4-24-00

WEATHER Sunny

TEMP. +60°F

ROUTE S.R. 105

COUNTY OTTAWA

TOWNSHIP HARRIS

SECTION 12

T6 N R 14 E


TYPE MONUMENT PK / WASHER

ON SURFACE - BELOW SURFACE

LEFT - C PAV'T. RIGHT 1.2'


B.7 TO LT. EDGE PAVEMENT

S.L.M. 467+78

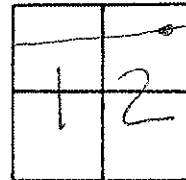

Records:
 $\Delta = 01^{\circ} - 05' - 00''$ RT
 P.K. Below P.K/Washer

RESET PK/WASHER
 6-13-00
 KPM.

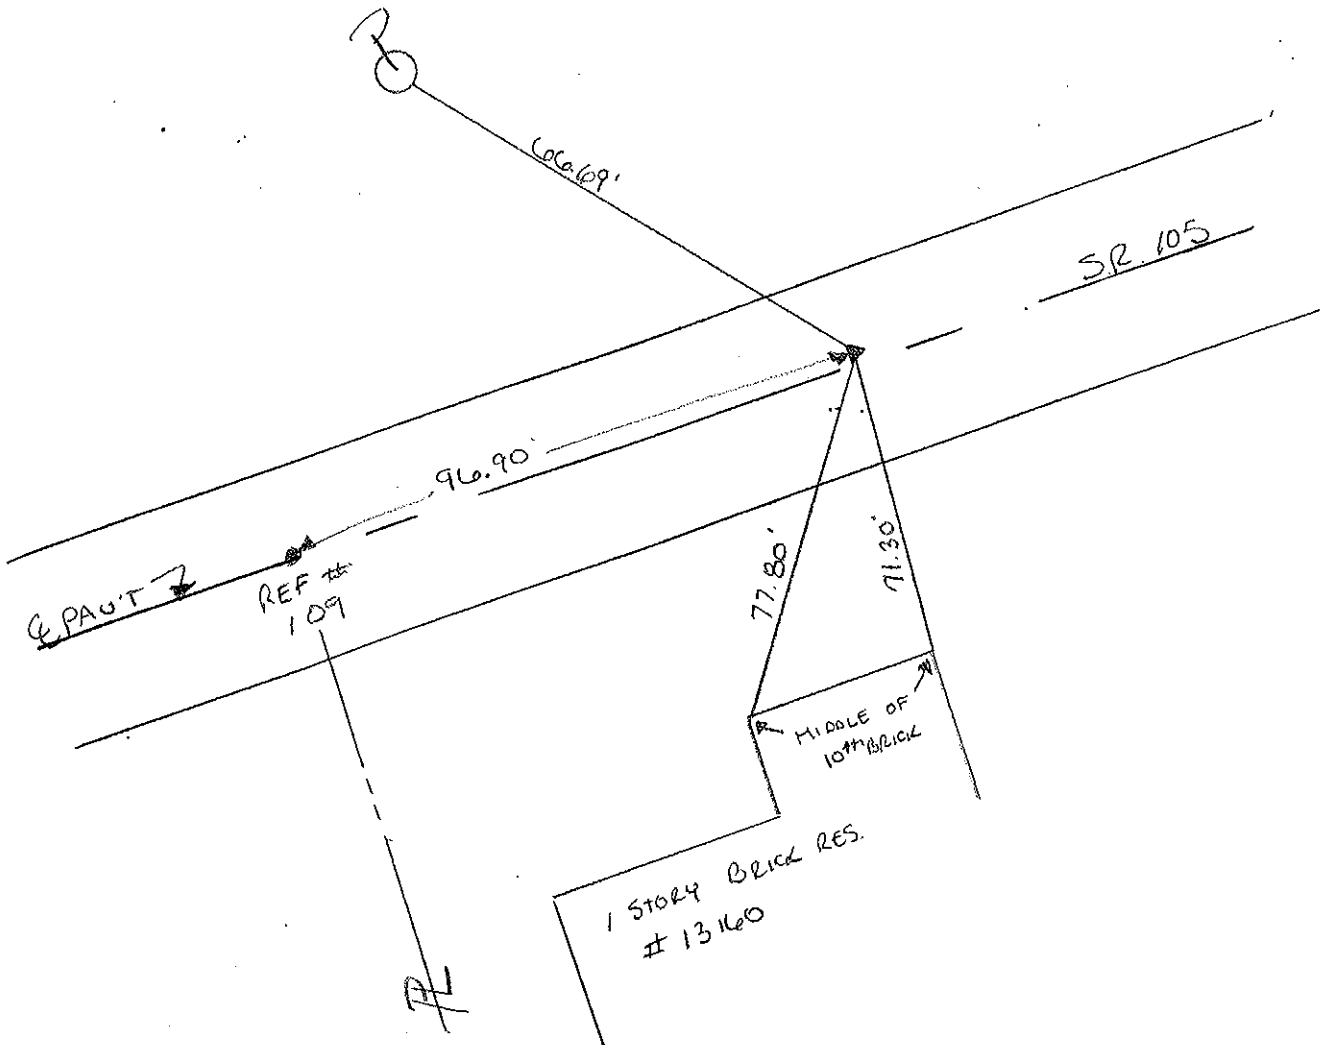

O.D.O.T. DISTRICT 2 SURVEY OFFICE

PERSONNEL _____ REFERENCE NO. 110 SHEET _____ OF _____

NOTES Cronin DRAWN 6/06/88

H.C. Ripple DATE 8/20/87 ROUTE #105

R.C. Barbour WEATHER sunny COUNTY Ottawa

Geyman TEMP. 82° TOWNSHIP Harris

SECTION 12

T 6 N R 14 E


TYPE MONUMENT P.K. & washer

ON SURFACE - BELOW _____

LEFT - CL PAV'T. - RIGHT 1'

TO _____ EDGE PAVEMENT


S.L.M. 466+85

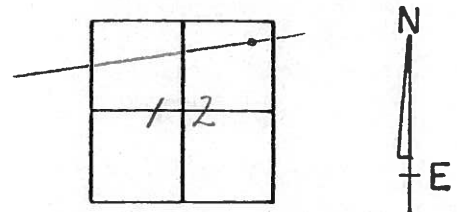

Δ = 01° 05' 00" Rt.


P.K. below P.K.

& washer

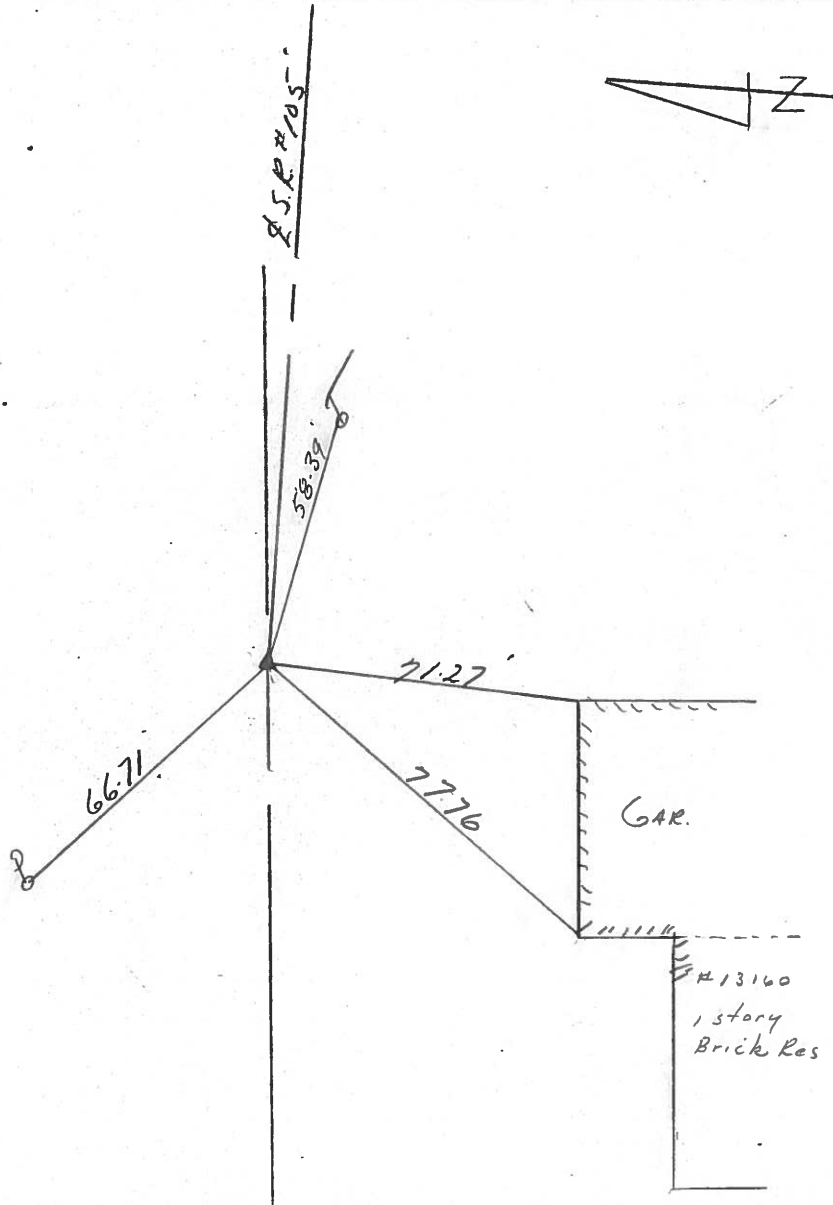

PERSONNEL	TITLE	PERSONNEL	TITLE	COUNTY	DATE	WEATHER	TEMP.
Schneider		Ash		Ottawa	5-21-74	Fair	75°
Messer		Cronart		S. R. 105			
Barbour		Ripple		SEC. 12			
		Geyman					

DESCRIPTION Harris Twp. JOB NO. _____

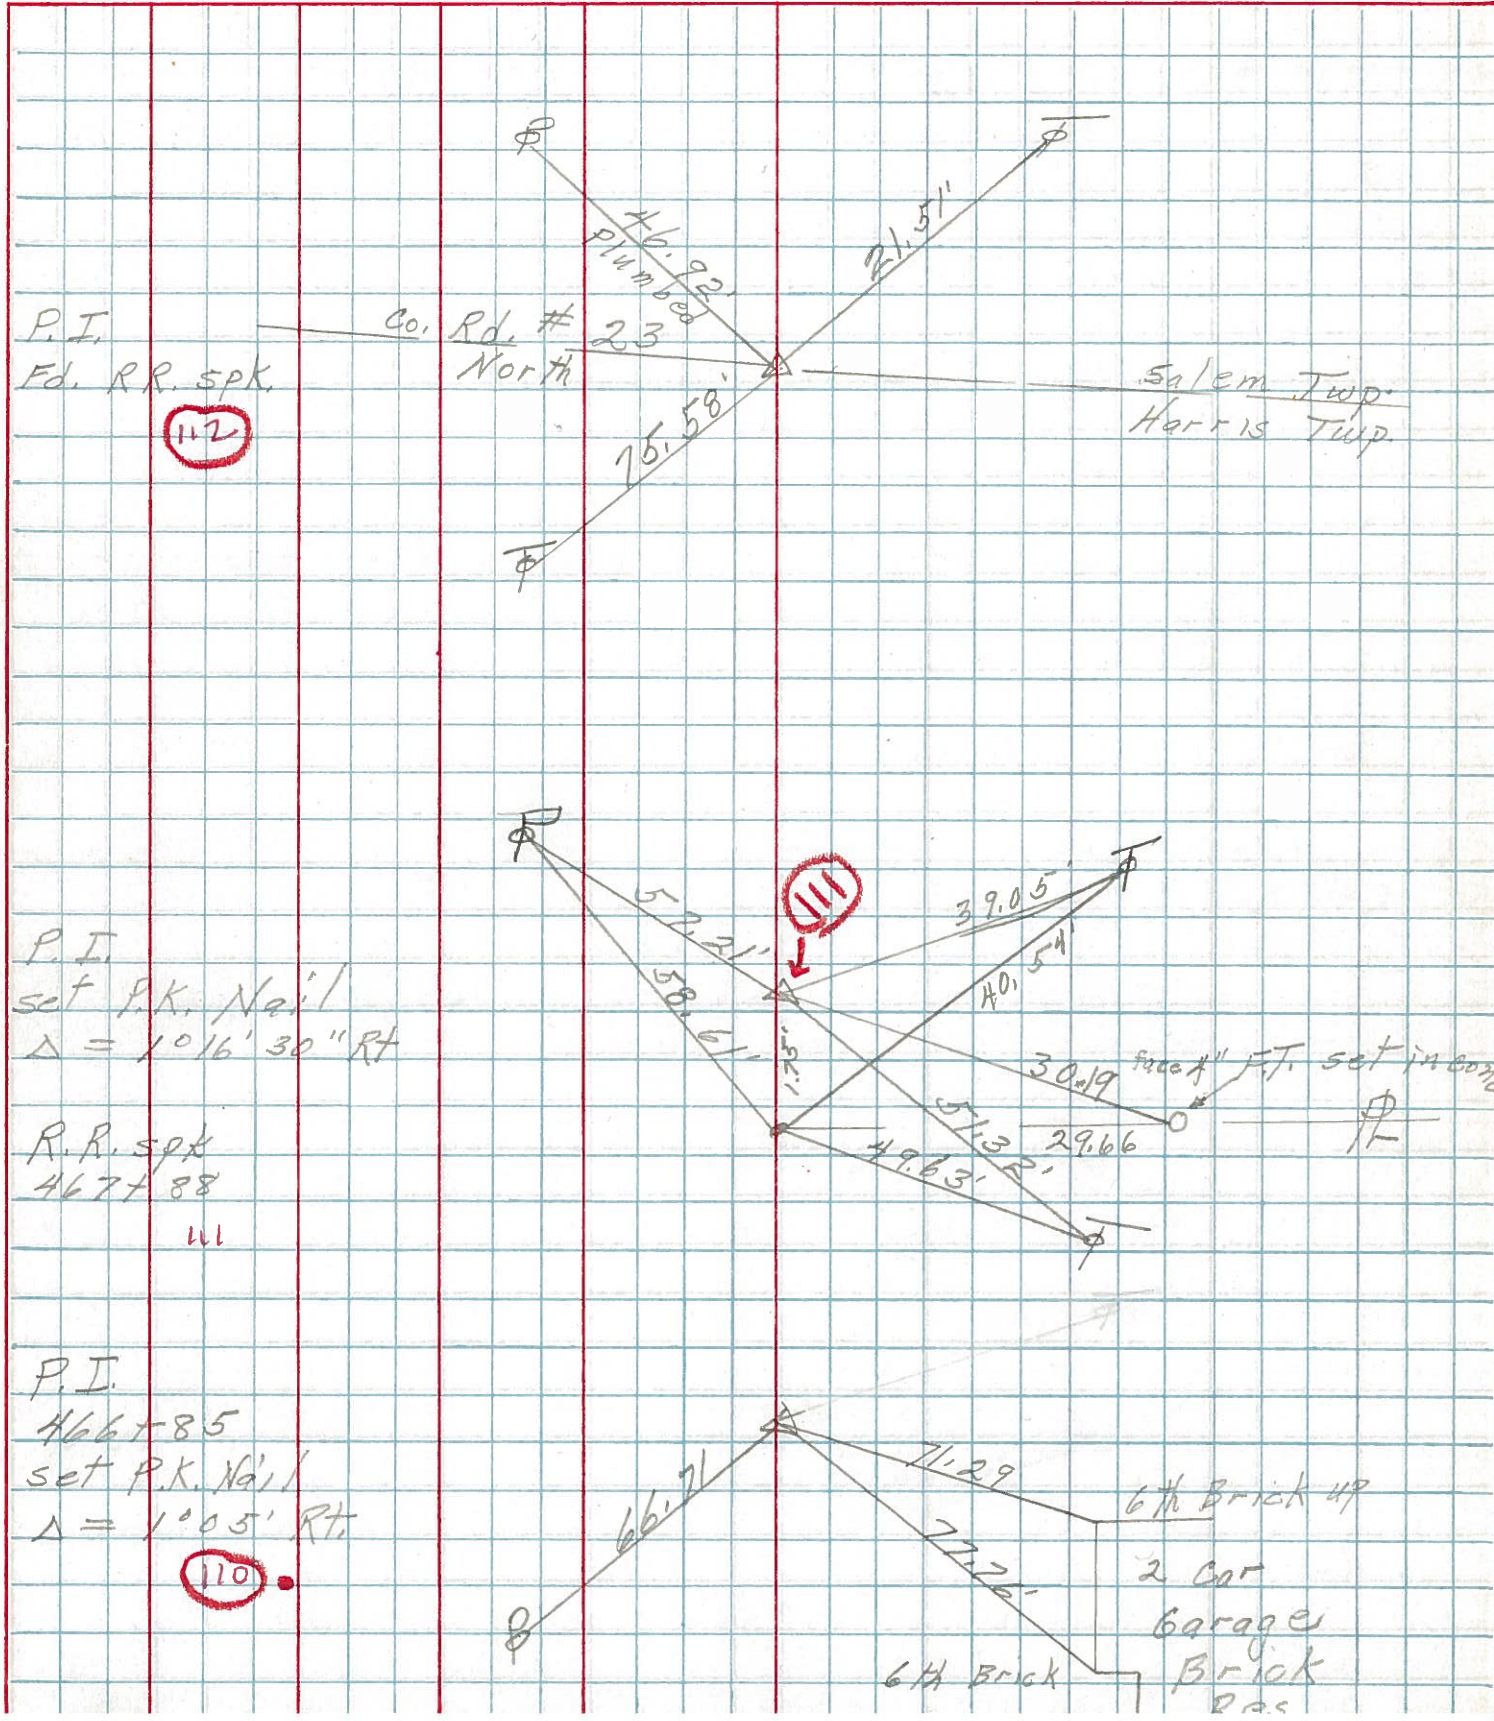

P.I.
Ed. R.R. spk.
112

P.I.
set P.K. Nail
 $\Delta = 1016' 30" RT$
R.R. spk
467+88
466+85
111

P.I.
466+85
set P.K. Nail
 $\Delta = 1005' RT$
110

Salem Twp.
Harris Twp.

800x4" FT. set in corner

6th Brick 49
2 Car
Garage
Brick
Bas