

O.D.O.T. DISTRICT 2 SURVEY OFFICE (USE ONLY)

PERSONNEL

REFERENCE NO. 111

SHEET 22 OF 42

NOTES RHOADES

DATE 8-5-2019

ROUTE SR 105

H.C. O'DONNELL

WEATHER SUNNY

COUNTY OTTAWA

R.C. MILLER

TEMP. 74°F

TOWNSHIP HARRIS

SECTION 12

DWG BY AUBLE

PID 92131

T 6 N R 14 E

TYPE MONUMENT P.K.NAIL

ON SURFACE - ~~BELOW~~ ON

OFFSET CL PAVEMENT 1.0' LT : ~~RT~~

8.8' TO LT EDGE PAVEMENT


STATION: 467+64.70

HORZ.DATUM: NAD83 (2011)


GEOID: 2012A

GRID: NORTHING: 668768.113

EASTING: 1780595.641

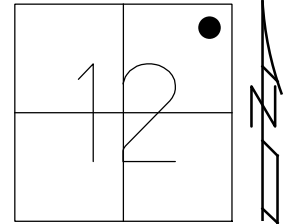

RECORD: P.I.  
 $\Delta = 01^{\circ} 16' 30''$  RT  
 FD P.K./WASHER  
 4/24/00, MB  
 SET P.K./WASHER  
 6-13-00, KPM  
 FD P.K./WASHER  
 REF111  
 5-8-18, JFO  
 SET MAG/WASHER  
 4-8-20, JFO

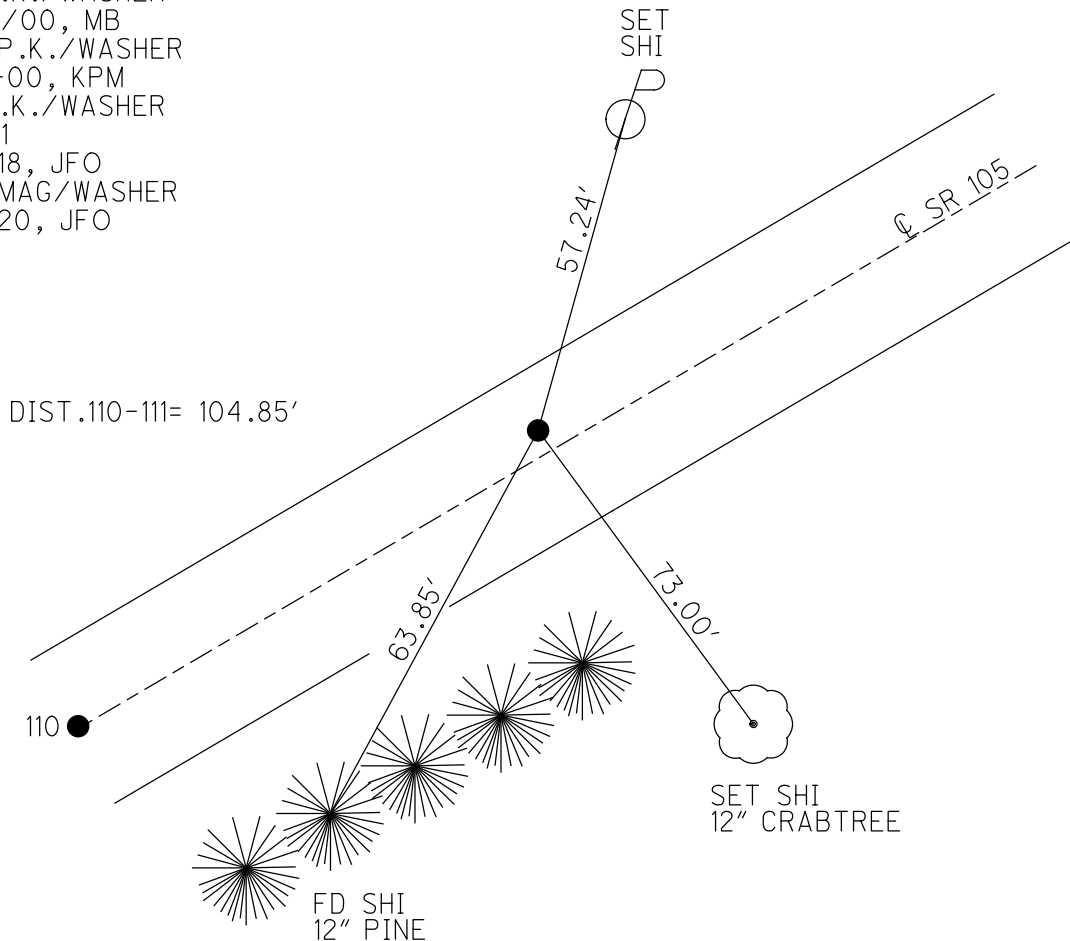

# O.D.O.T. DISTRICT 2 SURVEY OFFICE

PERSONNEL

REFERENCE NO. 111

SHEET 78 OF 96

NOTES M. BARNHISEL

H.C. M. CAULFIELD

R.C. M. BARNHISEL

Drawn by: K. MOSEK

DATE 4-24-00

WEATHER Sunny

TEMP. +6.0°F

ROUTE S.R. 105

COUNTY OTTAWA

TOWNSHIP HARRIS

SECTION 12

T6 N R 14 E


TYPE MONUMENT PK / WASHER

ON SURFACE - BELOW SURFACE

LEFT - PAV'T. - RIGHT 1.0'


8.8' TO LT. EDGE PAVEMENT

S.L.M. 468 + 82

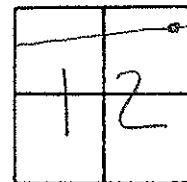

RECORD: PI  $\Delta = 01^\circ - 10' - 30''$  RT.

RESET PK / WASHER  
6-13-00  
KPM

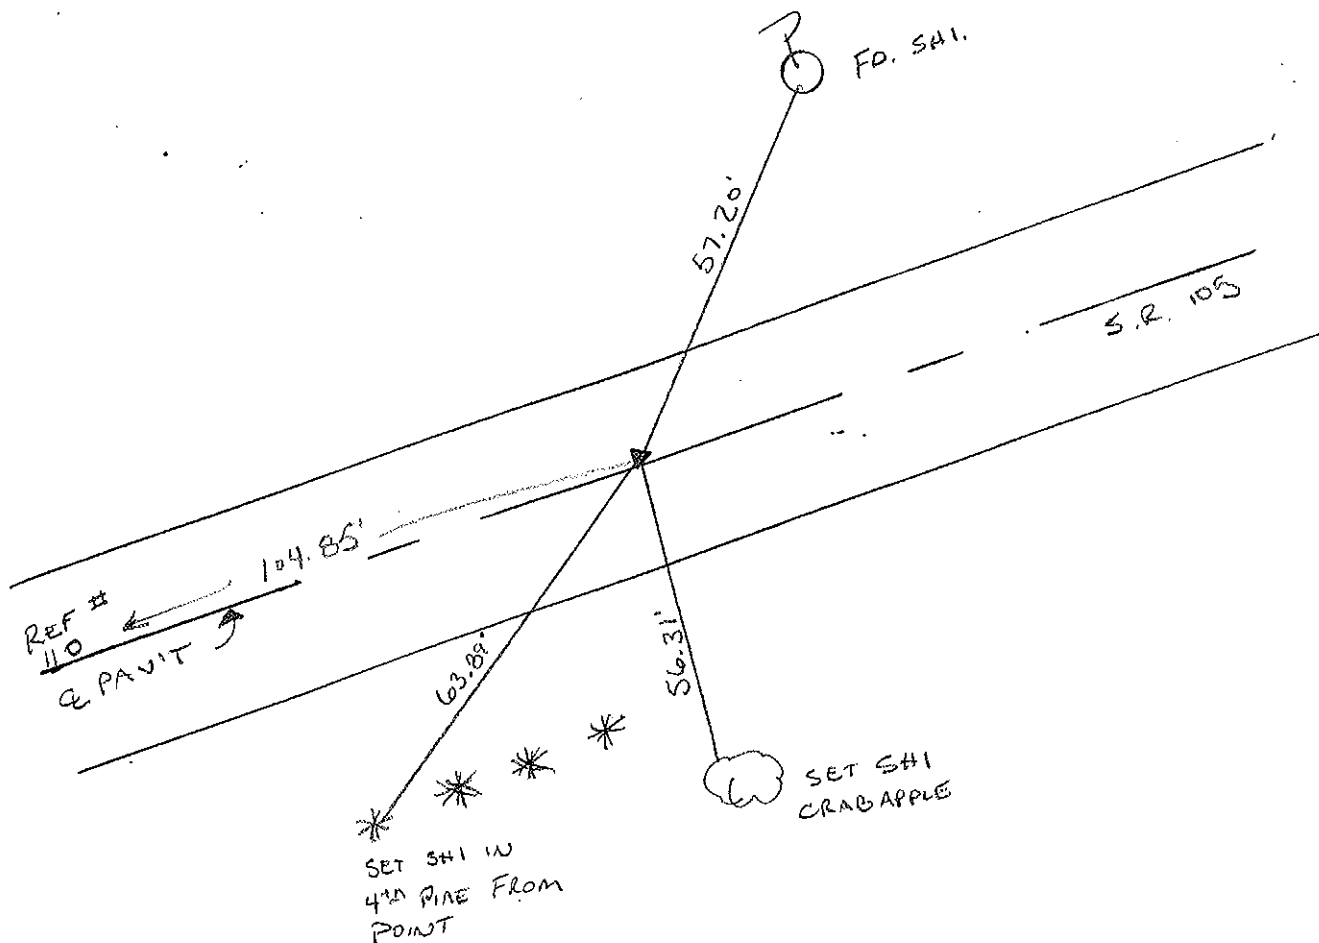

# O.D.O.T. DISTRICT 2 SURVEY OFFICE

PERSONNEL

REFERENCE NO. 111

SHEET      OF     

NOTES Cronin

DRAW 6/06/88

ROUTE # 105

H.C. Ripple

DATE 8/20/87

COUNTY Ottawa

R.C. Barbour

WEATHER sunny

TOWNSHIP Harris

Geyman

TEMP. 82°

SECTION 12

T 6 N R 14 E



TYPE MONUMENT P.K. & washer

ON SURFACE - BELOW     

LEFT -      PAV'T. - RIGHT 1'

     TO      EDGE PAVEMENT

S.L.M. 467+88

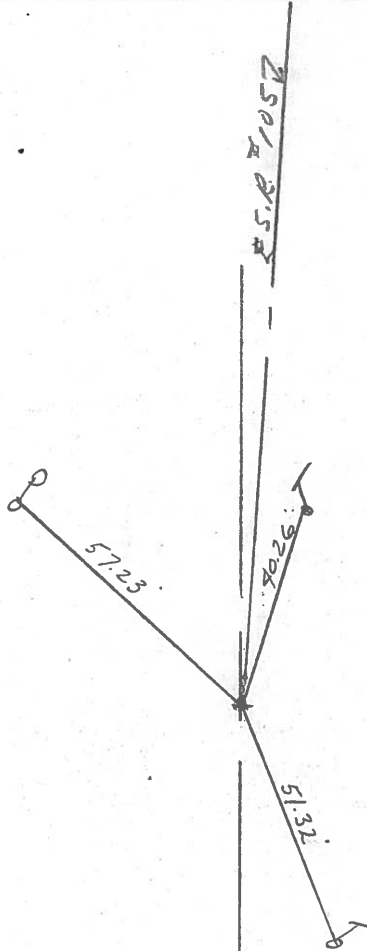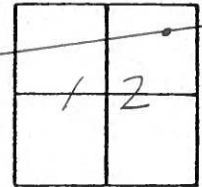

$\Delta = 01^{\circ}16'30''$  Rt.

P.K. atop P.K. atop R.R. spike.  
below P.K. & washer

PERSONNEL	TITLE	PERSONNEL	TITLE	COUNTY	DATE
<u>Schneider</u>		<u>Ash</u>		<u>Ottawa</u>	<u>5-21-74</u>
<u>Mosser</u>		<u>Crenell</u>		S. R. <u>105</u>	WEATHER <u>Fair</u>
<u>Barbour</u>		<u>Ripple</u>		SEC. <u>12</u>	TEMP. <u>75°</u>
		<u>Geyman</u>			

DESCRIPTION Harris Twp. JOB NO. \_\_\_\_\_

