

O.D.O.T. DISTRICT 2 SURVEY OFFICE (USE ONLY)

PERSONNEL

REFERENCE NO. 114 A

SHEET 26 OF 42

NOTES MOSE

DATE 4-26-00

ROUTE SR 105

H.C. CANTERBURY

WEATHER SUNNY

COUNTY OTTAWA

R.C. BARNHISEL

TEMP. 60°F

TOWNSHIP SALEM

SECTION 7

DWG BY MAHLER

PID 92131

T 6 N R 14 E

TYPE MONUMENT P.K./WASHER

ON SURFACE - ~~BELOW~~ ON

OFFSET 1.1' LT : ~~RT~~

10.3' TO LT EDGE PAVEMENT


STATION: 486+30

HORZ. DATUM: -


GEOID: -

GRID: NORTHING: -

EASTING: -

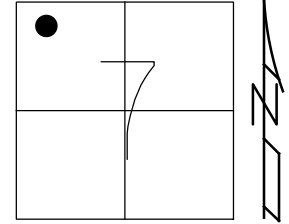

RECORD:  
DNF  
5/16/18, JFO

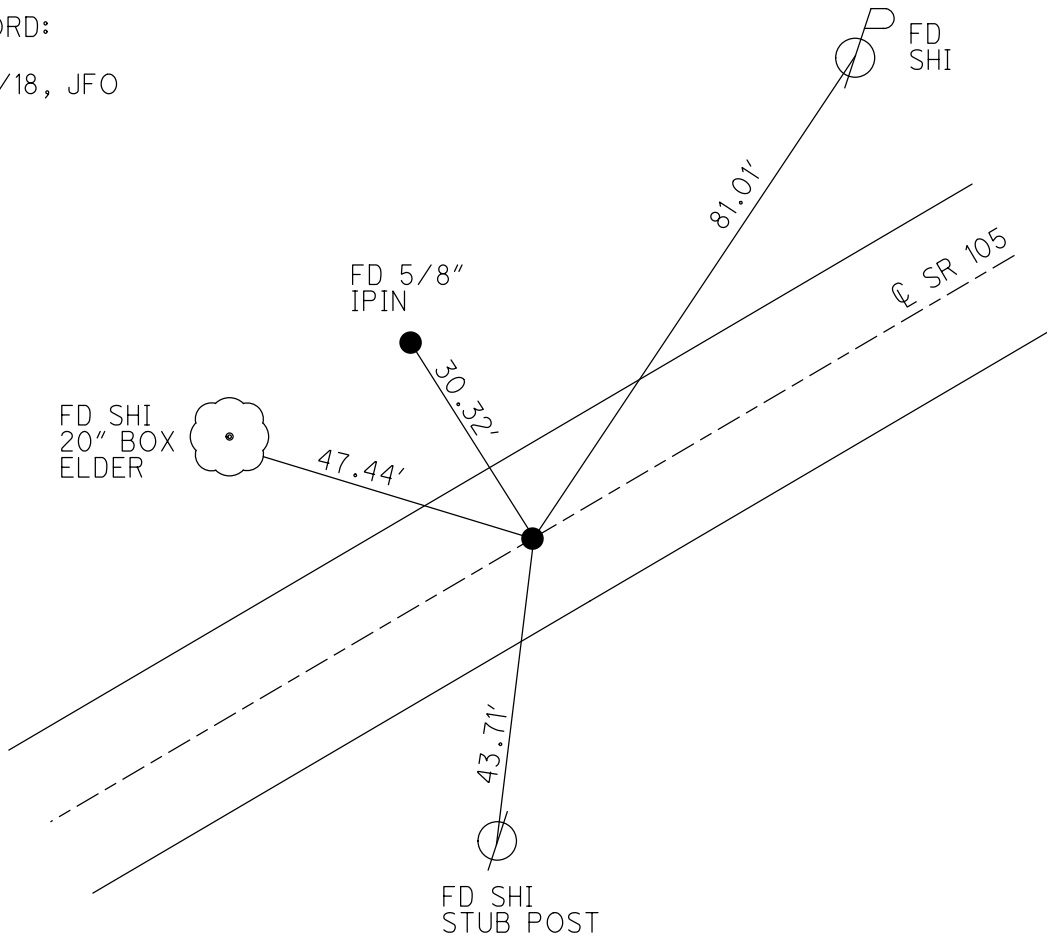

# O.D.O.T. DISTRICT 2 SURVEY OFFICE

PERSONNEL

REFERENCE NO. 114-A

SHEET 82 OF 96

NOTES K. MOSER

H.C. M. CAUTERBURY

DATE 4-26-00

ROUTE S.R. 105

R.C. M. BALNISEL

WEATHER SUNNY

COUNTY OTTAWA

TEMP. +60°F

TOWNSHIP SALEM

SECTION 7

T6 N R 14 E


TYPE MONUMENT PK / WASHER

ON SURFACE - ~~BEL~~ LOW SURFACE


LEFT - ~~PAV'T.~~ RIGHT 1.1' LT.

10.3 TO LT. EDGE PAVEMENT

S.L.M. 486 +30

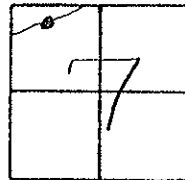

DIG IF  
NEEDED

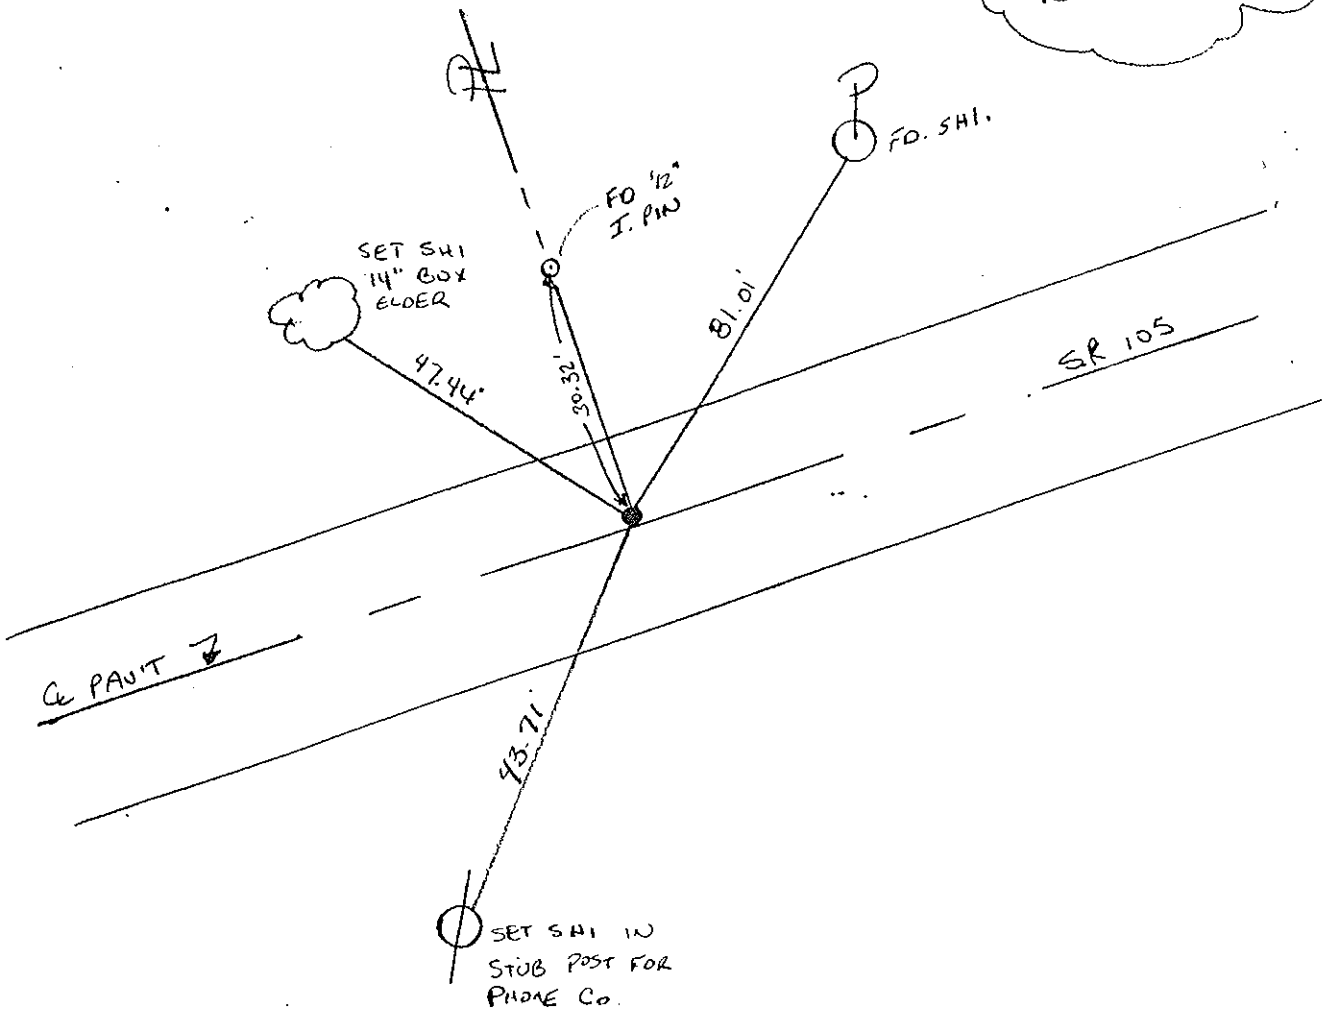

O.D.O.T. DISTRICT 2 SURVEY OFFICE


PERSONNEL

NOTES Cronin  
H.C. Ripple  
R.C. Barbour  
Geyman



REFERENCE NO. 114  
DRAW 6/06/88  
DATE 8/20/87  
WEATHER sunny  
TEMP. 83°

SHEET 83 OF 96  
ROUTE #105  
COUNTY Ottawa  
TOWNSHIP Salem  
SECTION 7  
T 6 N R 14 E

TYPE MONUMENT P.K.  
ON SURFACE - BELOW  
LEFT - ☉ PAV'T. - RIGHT 1.0'  
TO EDGE PAVEMENT  
S.L.M. 487+33

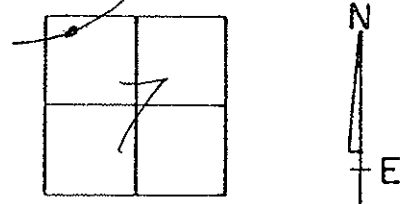

DNF  
4-26-00

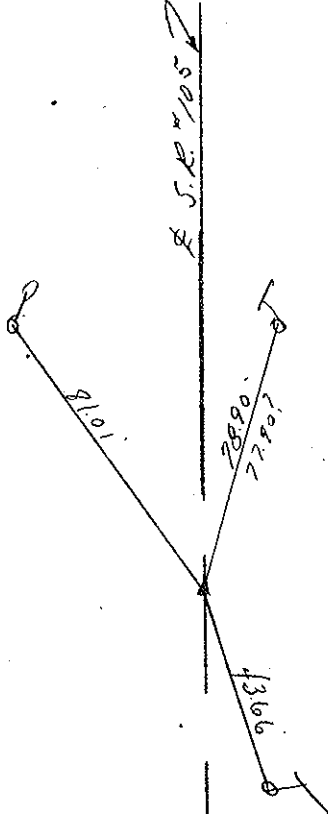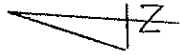

P.K. below P.K.  
d.g. when needed