

O.D.O.T. DISTRICT 2 SURVEY OFFICE (USE ONLY)

PERSONNEL

REFERENCE NO. 115

SHEET 27 OF 42

NOTES MOSER DATE 4-26-00
 H.C. CANTERBURY WEATHER SUNNY
 R.C. BARNHISEL TEMP. 60°F

ROUTE SR 105
 COUNTY OTTAWA
 TOWNSHIP SALEM
 SECTION 7
 T 6 N R 14 E

DWG BY MAHLER PID 92131

TYPE MONUMENT 1/2" IPIN

~~ON SURFACE~~ - BELOW 1'


OFFSET Q PAVEMENT 13.1' ~~LT~~ : RT

3.0' RT TO RT EDGE PAVEMENT


STATION: 492+61.95

HORIZ.DATUM: NAD83 (2011) GEOID: 2012A

GRID: NORTHING: 669073.071 EASTING: 1783074.139

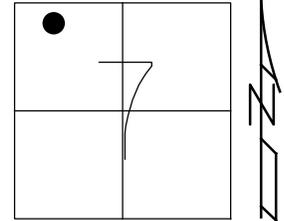

RECORD:
 FD 1/2" IPIN
 8" DOWN
 4/26/00, MB
 SET P.K./WASHER
 6-13-00, KPM
 FD 1/2" IPIN
 1' DOWN
 REF15
 5-8-18, JFO

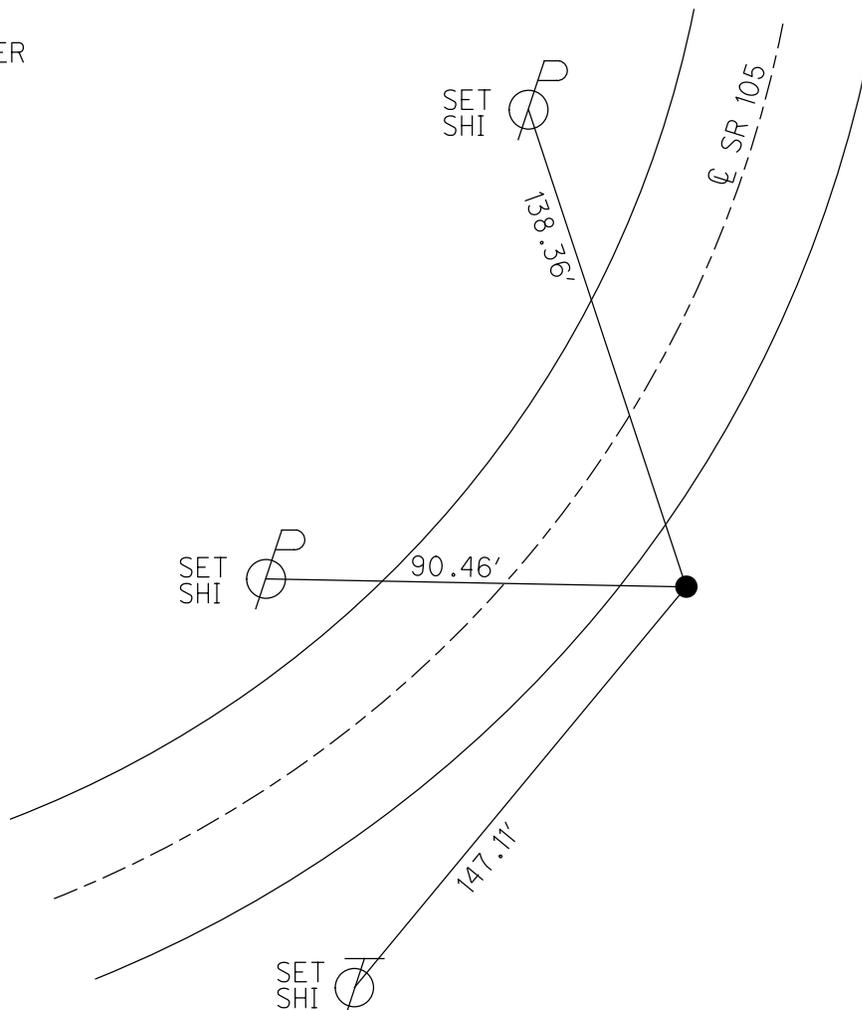

O.D.O.T. DISTRICT 2 SURVEY OFFICE

PERSONNEL

NOTES K. MOSEK

H.C. M. CAMERBURY

R.C. M. BARNHISEL

REFERENCE NO. 115

DATE 4-26-00

WEATHER Sunny

TEMP. 76.0°F

SHEET 84 OF 96

ROUTE S.R. 105

COUNTY OTTAWA

TOWNSHIP SALEM

SECTION 7

T6 N R 14 E


TYPE MONUMENT 1/2" I. PIN

ON SURFACE - BELOW 8"

~~SET~~ - C. PAV'T. - RIGHT 13.1'


3.0 TORT. RT. EDGE PAVEMENT

S.L.M. 493 + 85

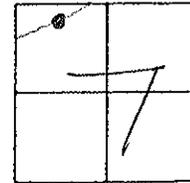

RESET PK/WASHER

6-13-00
KPM

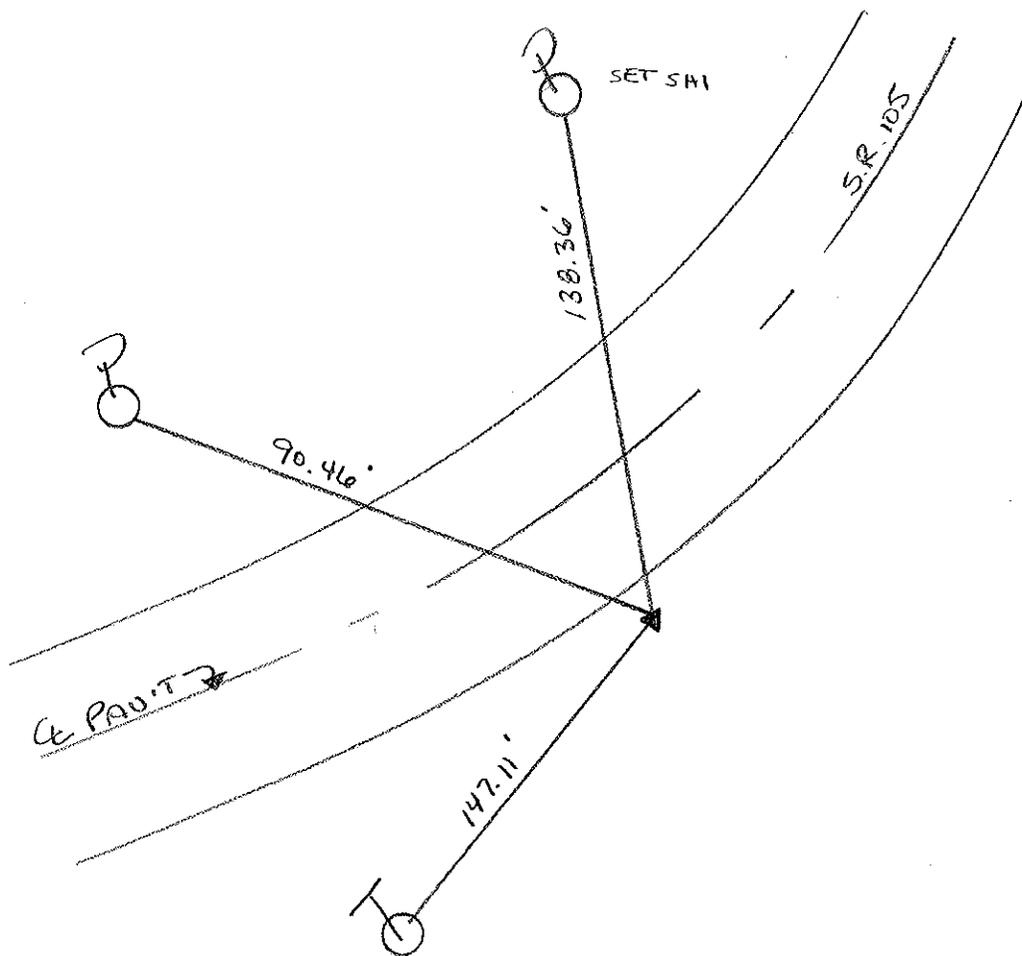

O.D.O.T. DISTRICT 2 SURVEY OFFICE

PERSONNEL

REFERENCE NO. 115

SHEET OF

NOTES Cronin

DRAWN 6/06/88

H.C. Ripple

DATE 8/20/87

ROUTE #105

R.C. Barbour

WEATHER sunny

COUNTY Ottawa

Geyman

TEMP. 83°

TOWNSHIP Salem

SECTION 7

T 6 N R 14 E



TYPE MONUMENT 1/2" I. Rod

ON SURFACE - BELOW 8"

LEFT - & PAV'T. - RIGHT 13'

 TO EDGE PAVEMENT

S.L.M. 492 + 86.5

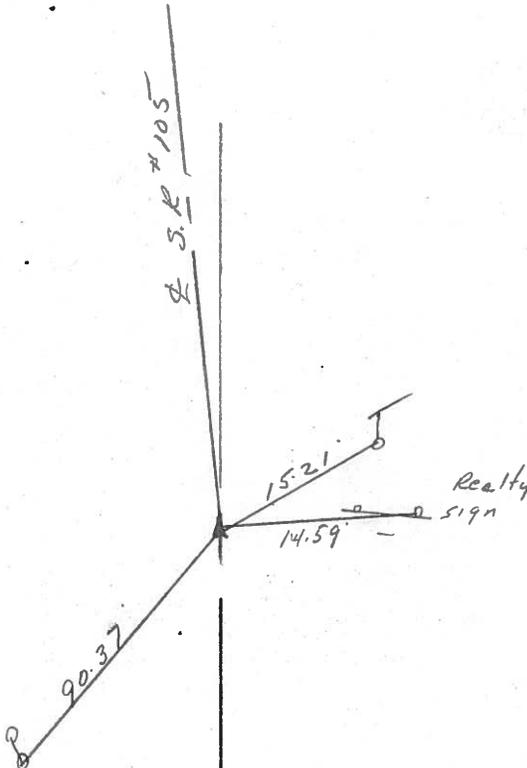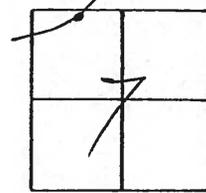

PERSONNEL	TITLE	PERSONNEL	TITLE	COUNTY	DATE	WEATHER	TEMP.
<u>SCHEIDT</u>		<u>ASH</u>		<u>OTTAWA</u>	<u>5-21-74</u>		
<u>MOSSE</u>		<u>CRONIN</u>		S. R. <u>105</u>			
<u>BARBER</u>		<u>RIPPLE</u>		SEC. <u>12</u>			
		<u>GEYMAN</u>					

DESCRIPTION _____ LEFT _____ CENTER LINE _____ RIGHT _____ JOB NO. _____

