

TWO-LANE RESURFACING PROGRAM

PRIORITY NO. 25 A PART 3 OF 3 SHEET 1 OF 3

COUNTY Ottawa ROUTE SR 163 SECTION 27.15

BEGIN LOG (SLM) 27.15 TERMINI Port Clintons East Corp. Line

END LOG (SLM) 31.21 TERMINI Const joint near SR 269

TOTAL LENGTH 4.06 MILES

MUNICIPALITY N/A BEGIN LOG (SLM) _____ END LOG (SLM) _____

MUNICIPALITY _____ BEGIN LOG (SLM) _____ END LOG (SLM) _____

PROPOSED WORK:

PAVEMENT 1 1/2" 404 SHOULDER Same, 617

OTHER Grind 5' ± @ all curb lines

EXISTING DATA:

SLM 1419+22 TO _____; PAV'T WIDTH 30.5' (type _____), SHLD WIDTH 7' (type PAVED)

SLM 1421+22 TO (4 LANE CONC. MEDIAN); PAV'T WIDTH 48' TOTAL (type _____), SHLD WIDTH 6' (type _____)

SLM SEE ADD. INFO SHEETS TO _____; PAV'T WIDTH _____ (type _____), SHLD WIDTH _____ (type _____)

SLM 1452+00 TO _____; PAV'T WIDTH 24' (type _____), SHLD WIDTH 3' (type ")

SLM 1479+14 TO _____; PAV'T WIDTH 24' (type _____), SHLD WIDTH 3' (type ")

SLM 1533+41 TO 1559+38; PAV'T WIDTH 24' (type _____), SHLD WIDTH 3' (type ")

SLM 1559+38 TO 1587+00; PAV'T WIDTH SEE SIGN (type _____), SHLD WIDTH _____ (type _____)

SLM 1587+00 TO _____; PAV'T WIDTH 24' (type _____), SHLD WIDTH 3' (type ")

SLM 1589+09 TO _____; PAV'T WIDTH 24' (type _____), SHLD WIDTH 3' (type ")

SLM 1642+56 TO _____; PAV'T WIDTH 24' (type _____), SHLD WIDTH 3' (type ")

END SLM 1643+58 TO _____; PAV'T WIDTH 24' (type _____), SHLD WIDTH 3' (type ")

STRUCTURES:

STR. NO. _____, WIDTH _____, LENGTH _____, PROP. WORK _____

STR. NO. _____, WIDTH _____, LENGTH _____, PROP. WORK _____

RAILROAD CROSSING:

NAME _____ STATION _____ NO. TRACKS _____ LENGTH ALONG C L _____ ft (no work)

NAME _____ STATION _____ NO. TRACKS _____ LENGTH ALONG C L _____ ft

NAME _____ STATION _____ NO. TRACKS _____ LENGTH ALONG C L _____ ft

MISCELLANEOUS:

NO. RAISED PAVEMENT MARKERS; EDGE OF PAVEMENT 195, CENTERLINE 362

NO. MAILBOX APPROACHES 0, MAILBOX SUPPORTS 0

REMARKS: BEGAN STATIONING @ 27.10 = 1430+88 ON WEST EDGE

Butt joints @ SR 53 OF 50' ± SPUR BRIDGE, MEASURED


BACK TO CONST. JOINT @ BEGINNING STA. 1419+22. END STA.

@ CONST. JOINT W. OF S.R. 269 1643+58.

[illegible]


PERSONNEL TITLE PERSONNEL TITLE COUNTY OTAWA DATE 9-14-1992
CHEWY W #163 WEATHER SUNNY
BARBOUR H. TAPE S. R. 27.15 - 31.21 TEMP. 75°
GEYMAN P. TAPE SEC. 026112-62

DESCRIPTION ADDITIONAL INFORMATION JOB NO. 026112-62

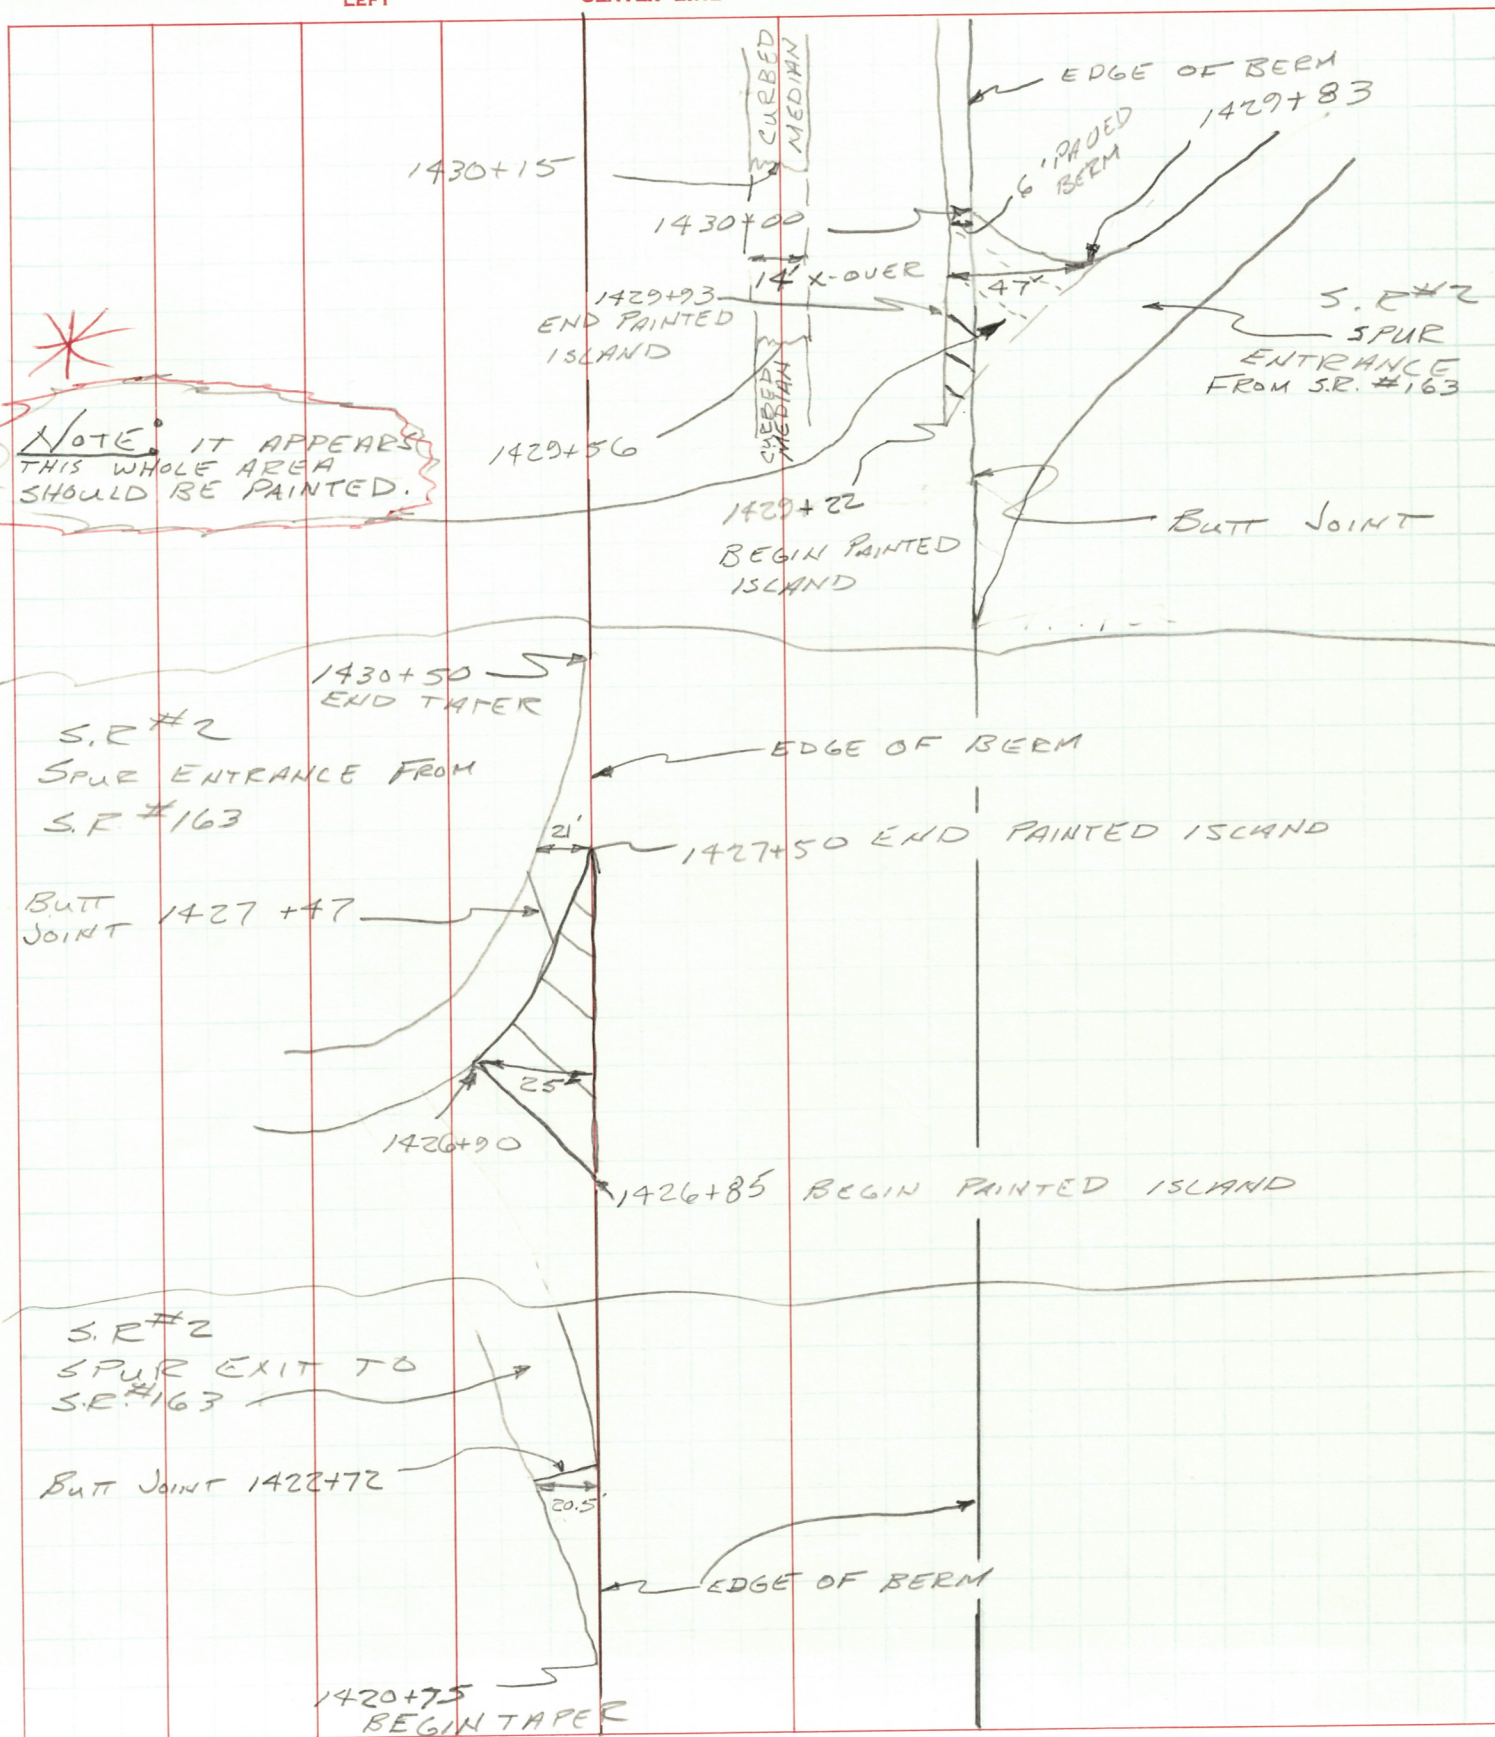


PERSONNEL	TITLE	PERSONNEL	TITLE	COUNTY	DATE
CHENEY				OTTAWA	9-14-1992
BARBOUR	H. TAPE			S. R. #163	WEATHER SUNNY
GEYMAN	R. TAPE			SEC. 27.15-31.21	TEMP. 80°


DESCRIPTION ADDITIONAL INFORMATION JOB NO. 026112-62

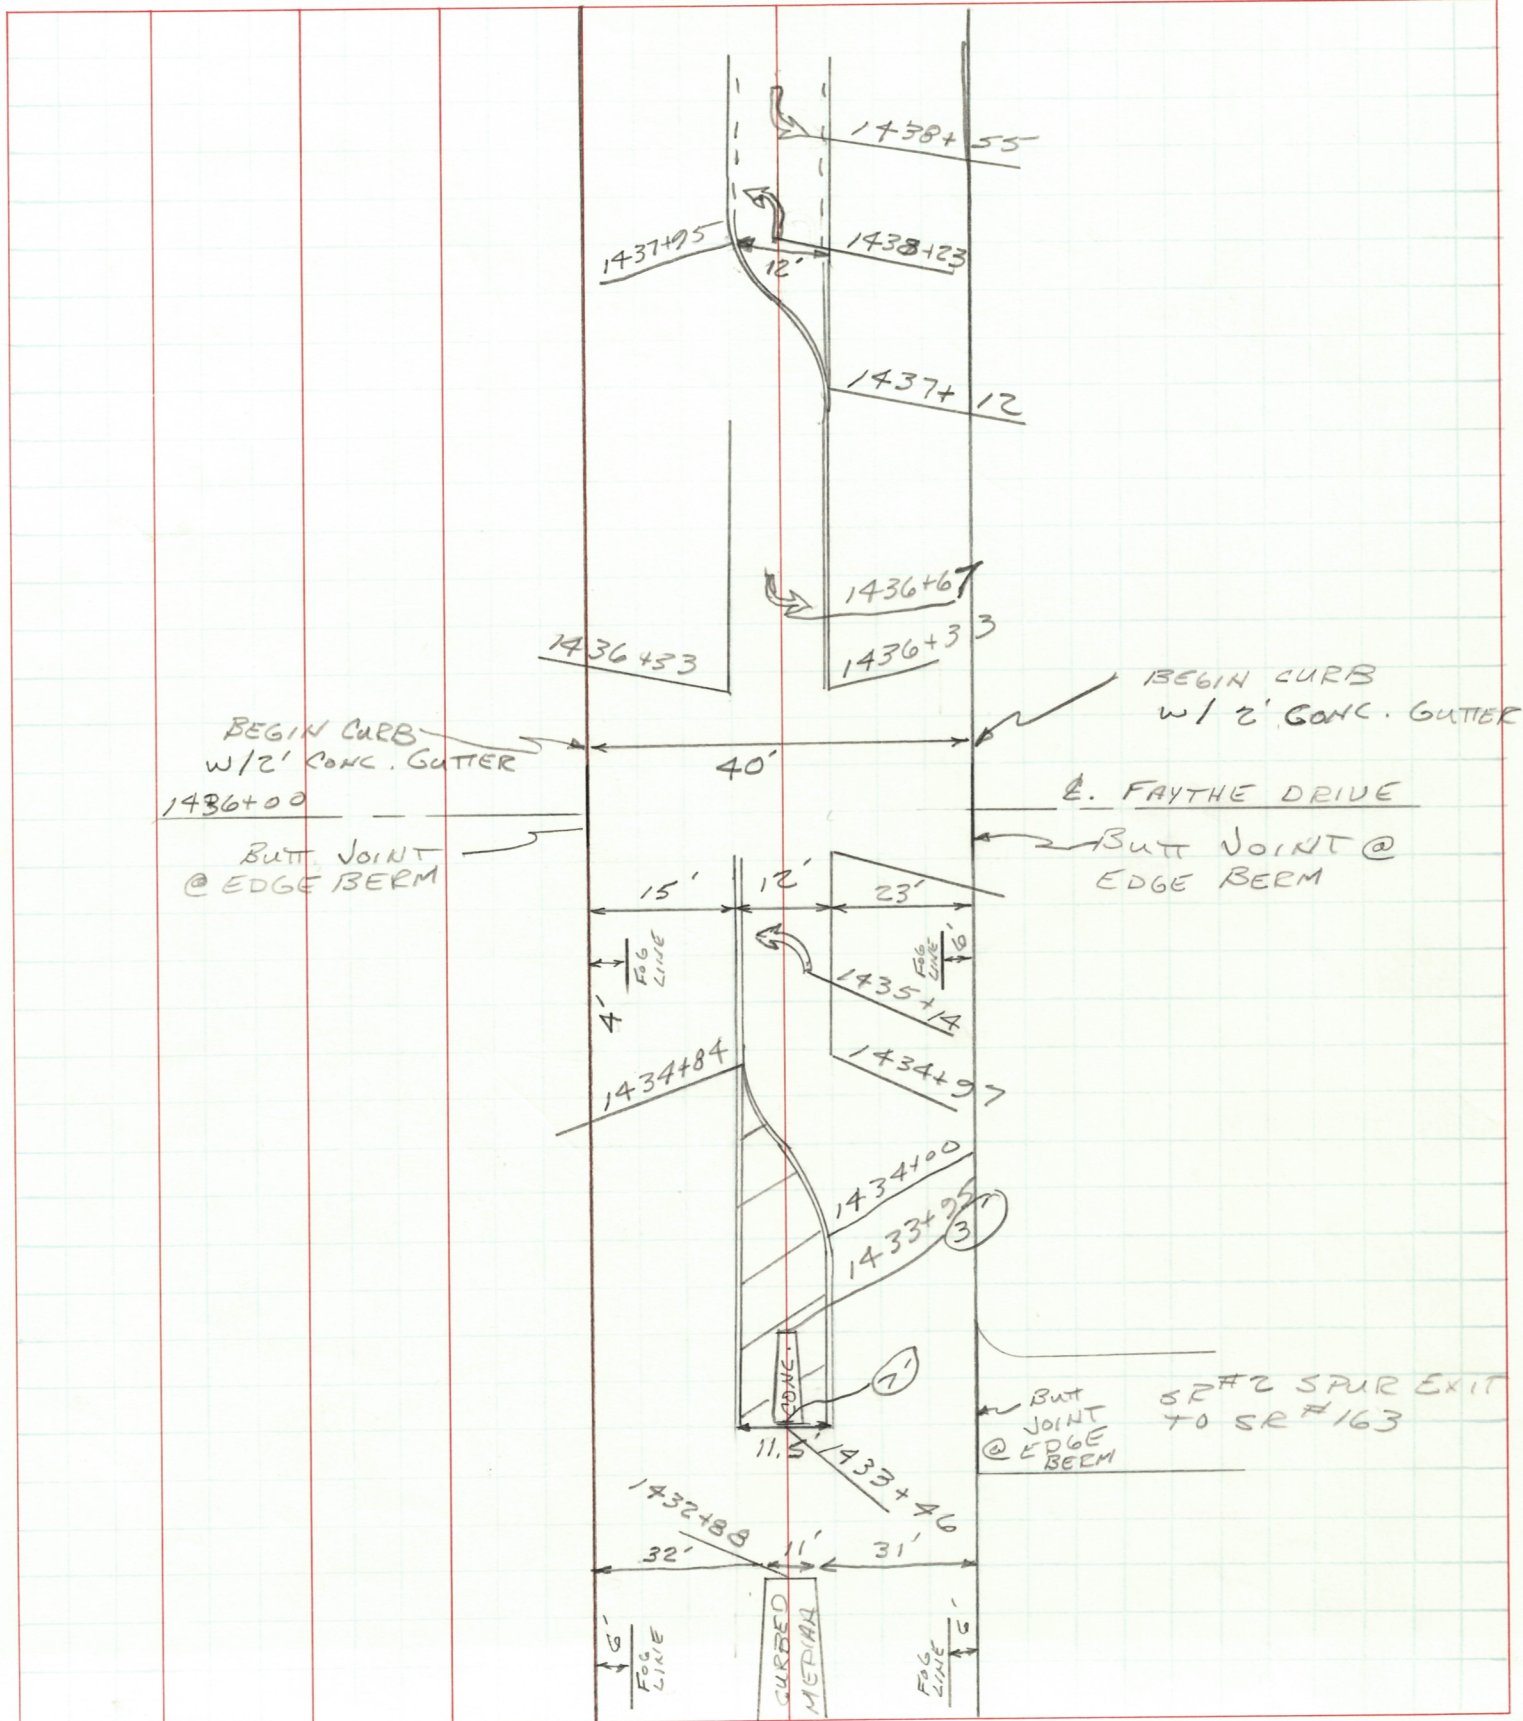


PERSONNEL	TITLE	PERSONNEL	TITLE	COUNTY	DATE
CHENEY				OTAWA	9-14-1992
BARBOUR	H. TAPE			S. R. #163	WEATHER SUNNY
GEYMAN	E. TAPE			SEC. 27.15-31.21	TEMP. 80°
DESCRIPTION				JOB NO. 026112-12	

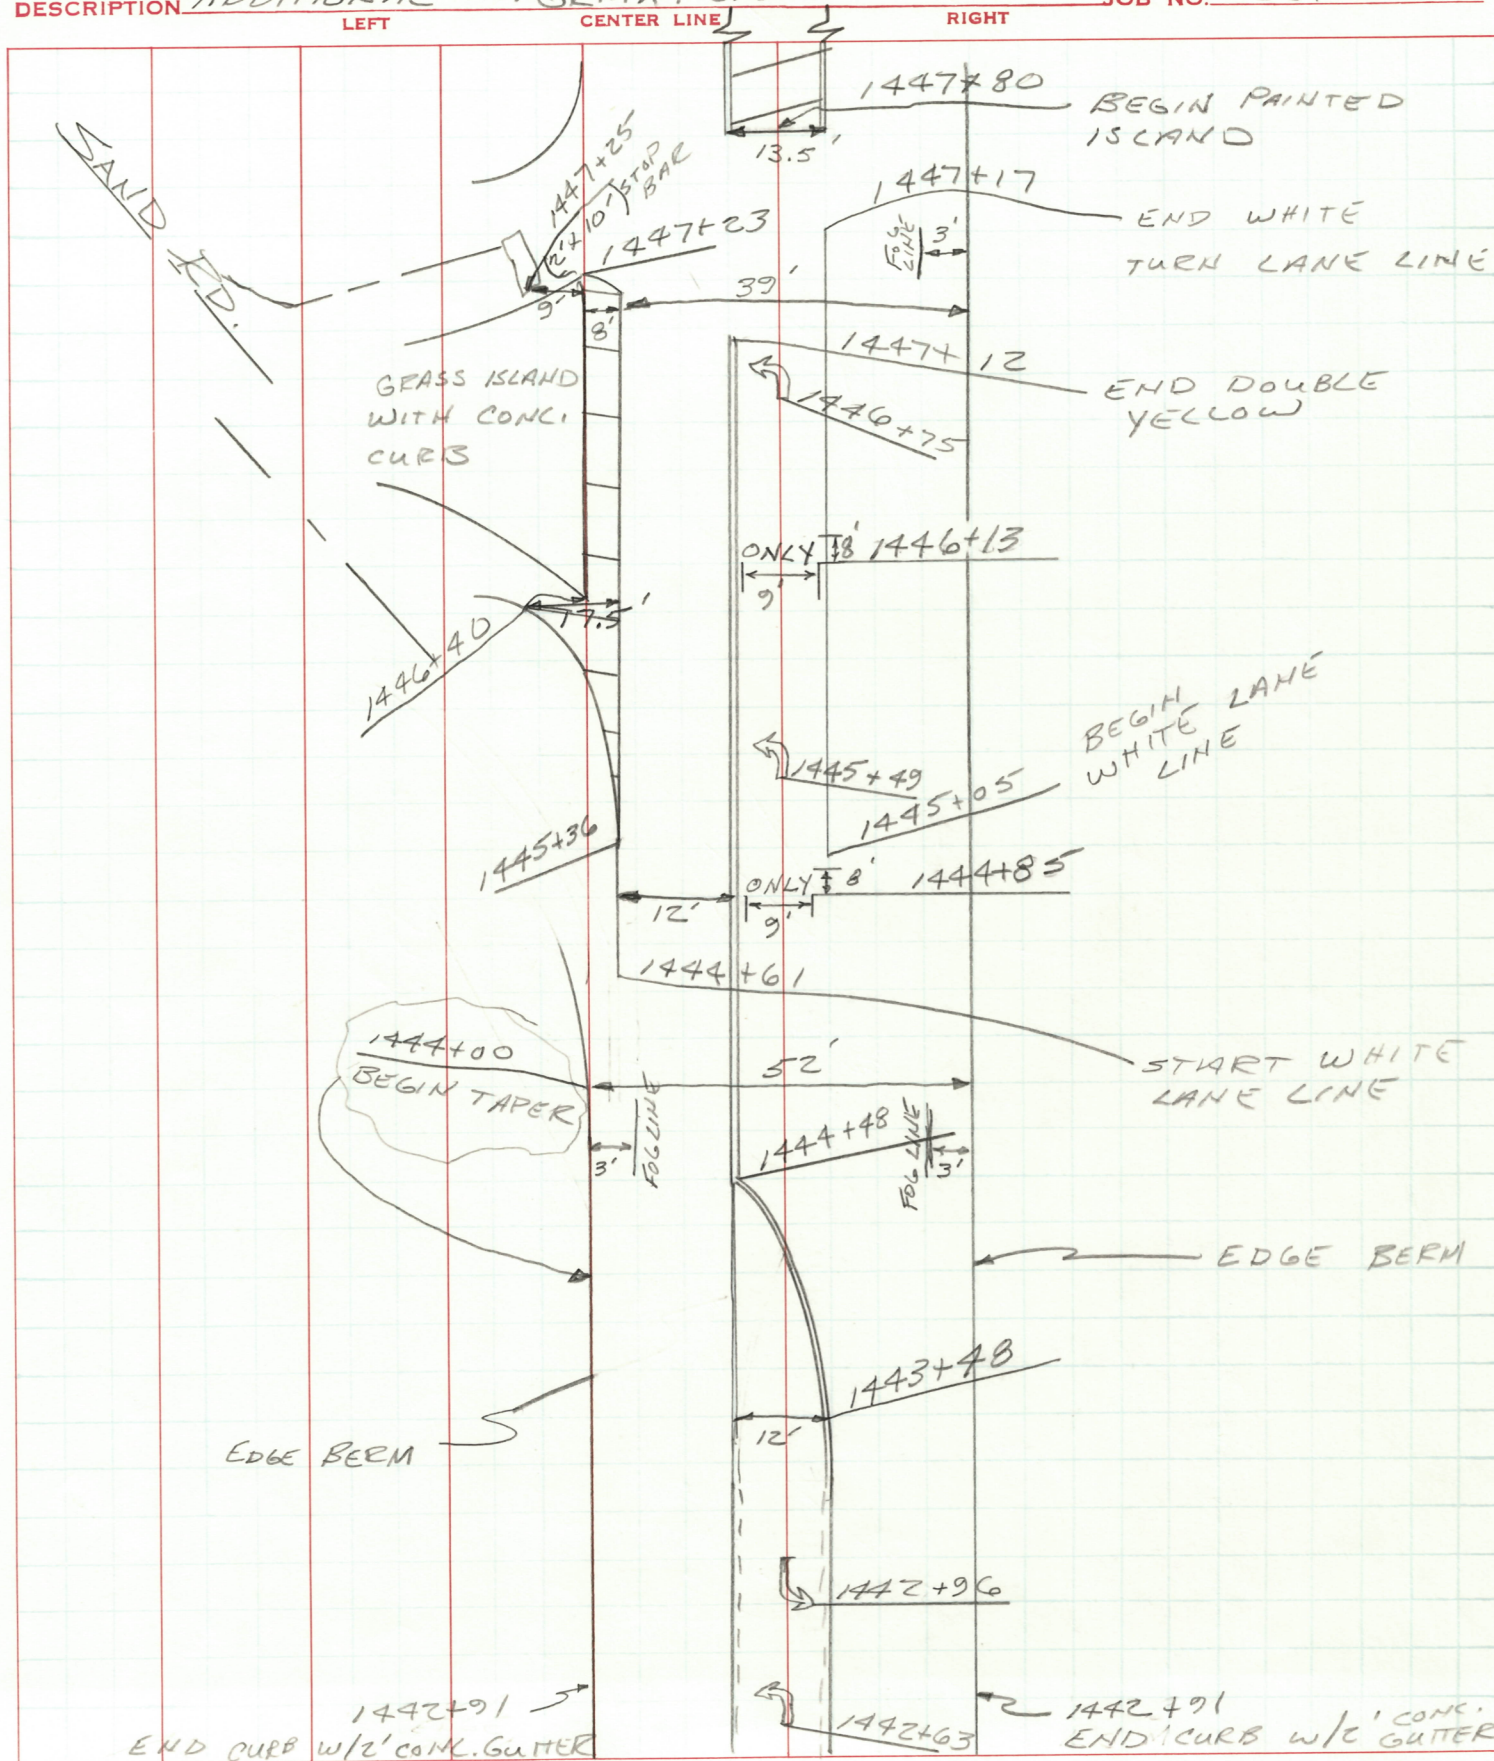

PERSONNEL	TITLE	PERSONNEL	TITLE	COUNTY	DATE	WEATHER	TEMP.
CHENEY				OTTAWA	9-14-1992		
BARBOR	H. TAPE			S. R. #163		SUNNY	
GEYMAN	R. TAPE			SEC. 27.15 - 31.21			80°
DESCRIPTION				ADDITIONAL INFORMATION		JOB NO. 02611C-62	

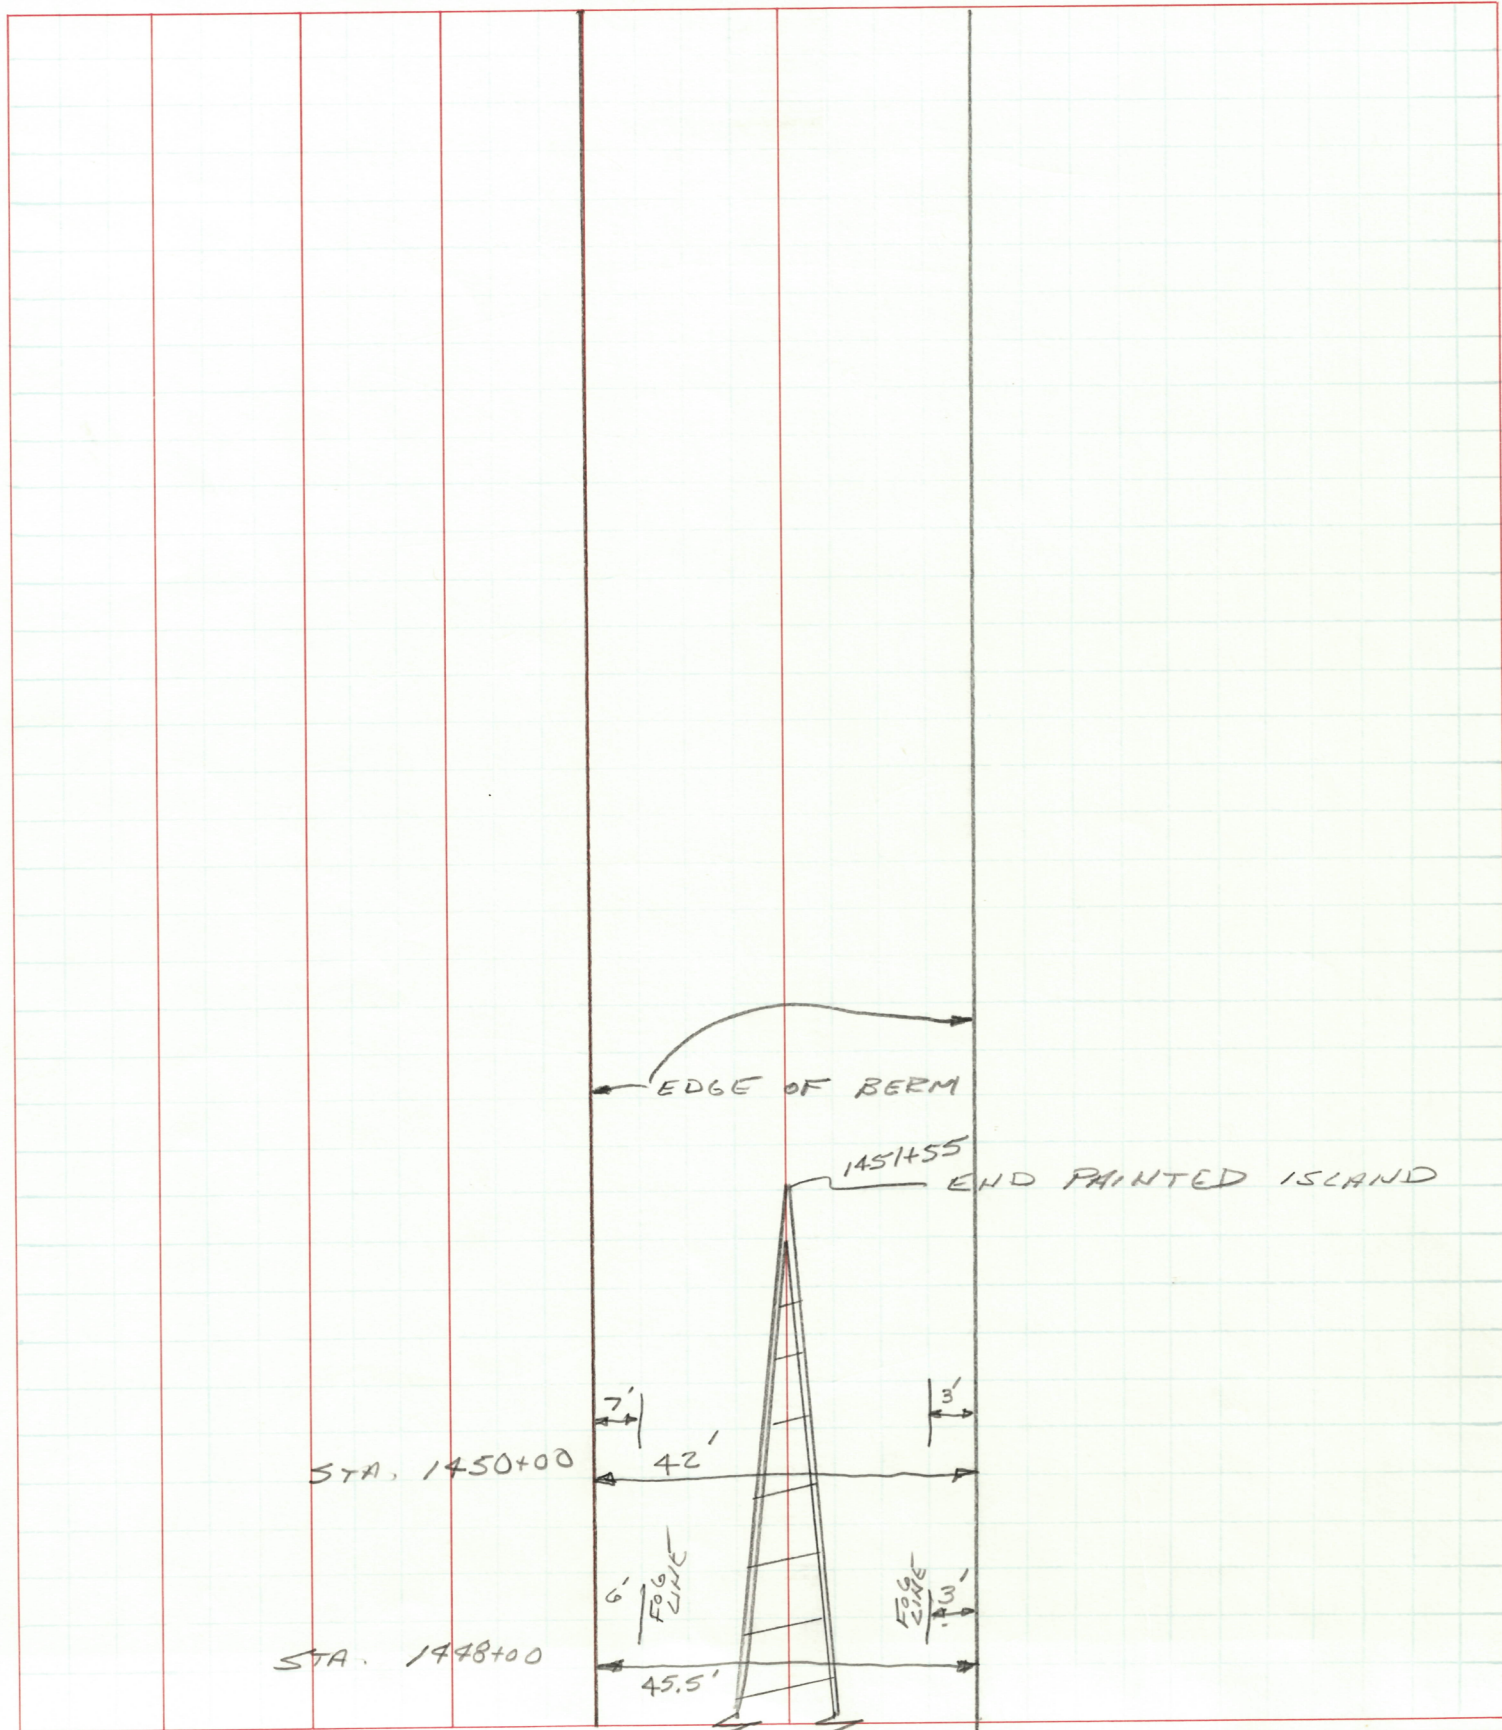

PERSONNEL	TITLE	PERSONNEL	TITLE	COUNTY	DATE
CHENEY				OTTAWA	9-17-1992
BARBOUR	TAPE			S. R. #163	WEATHER SUNNY
				SEC. 27.15	TEMP. 75°
DESCRIPTION				JOB NO. 026112-62	

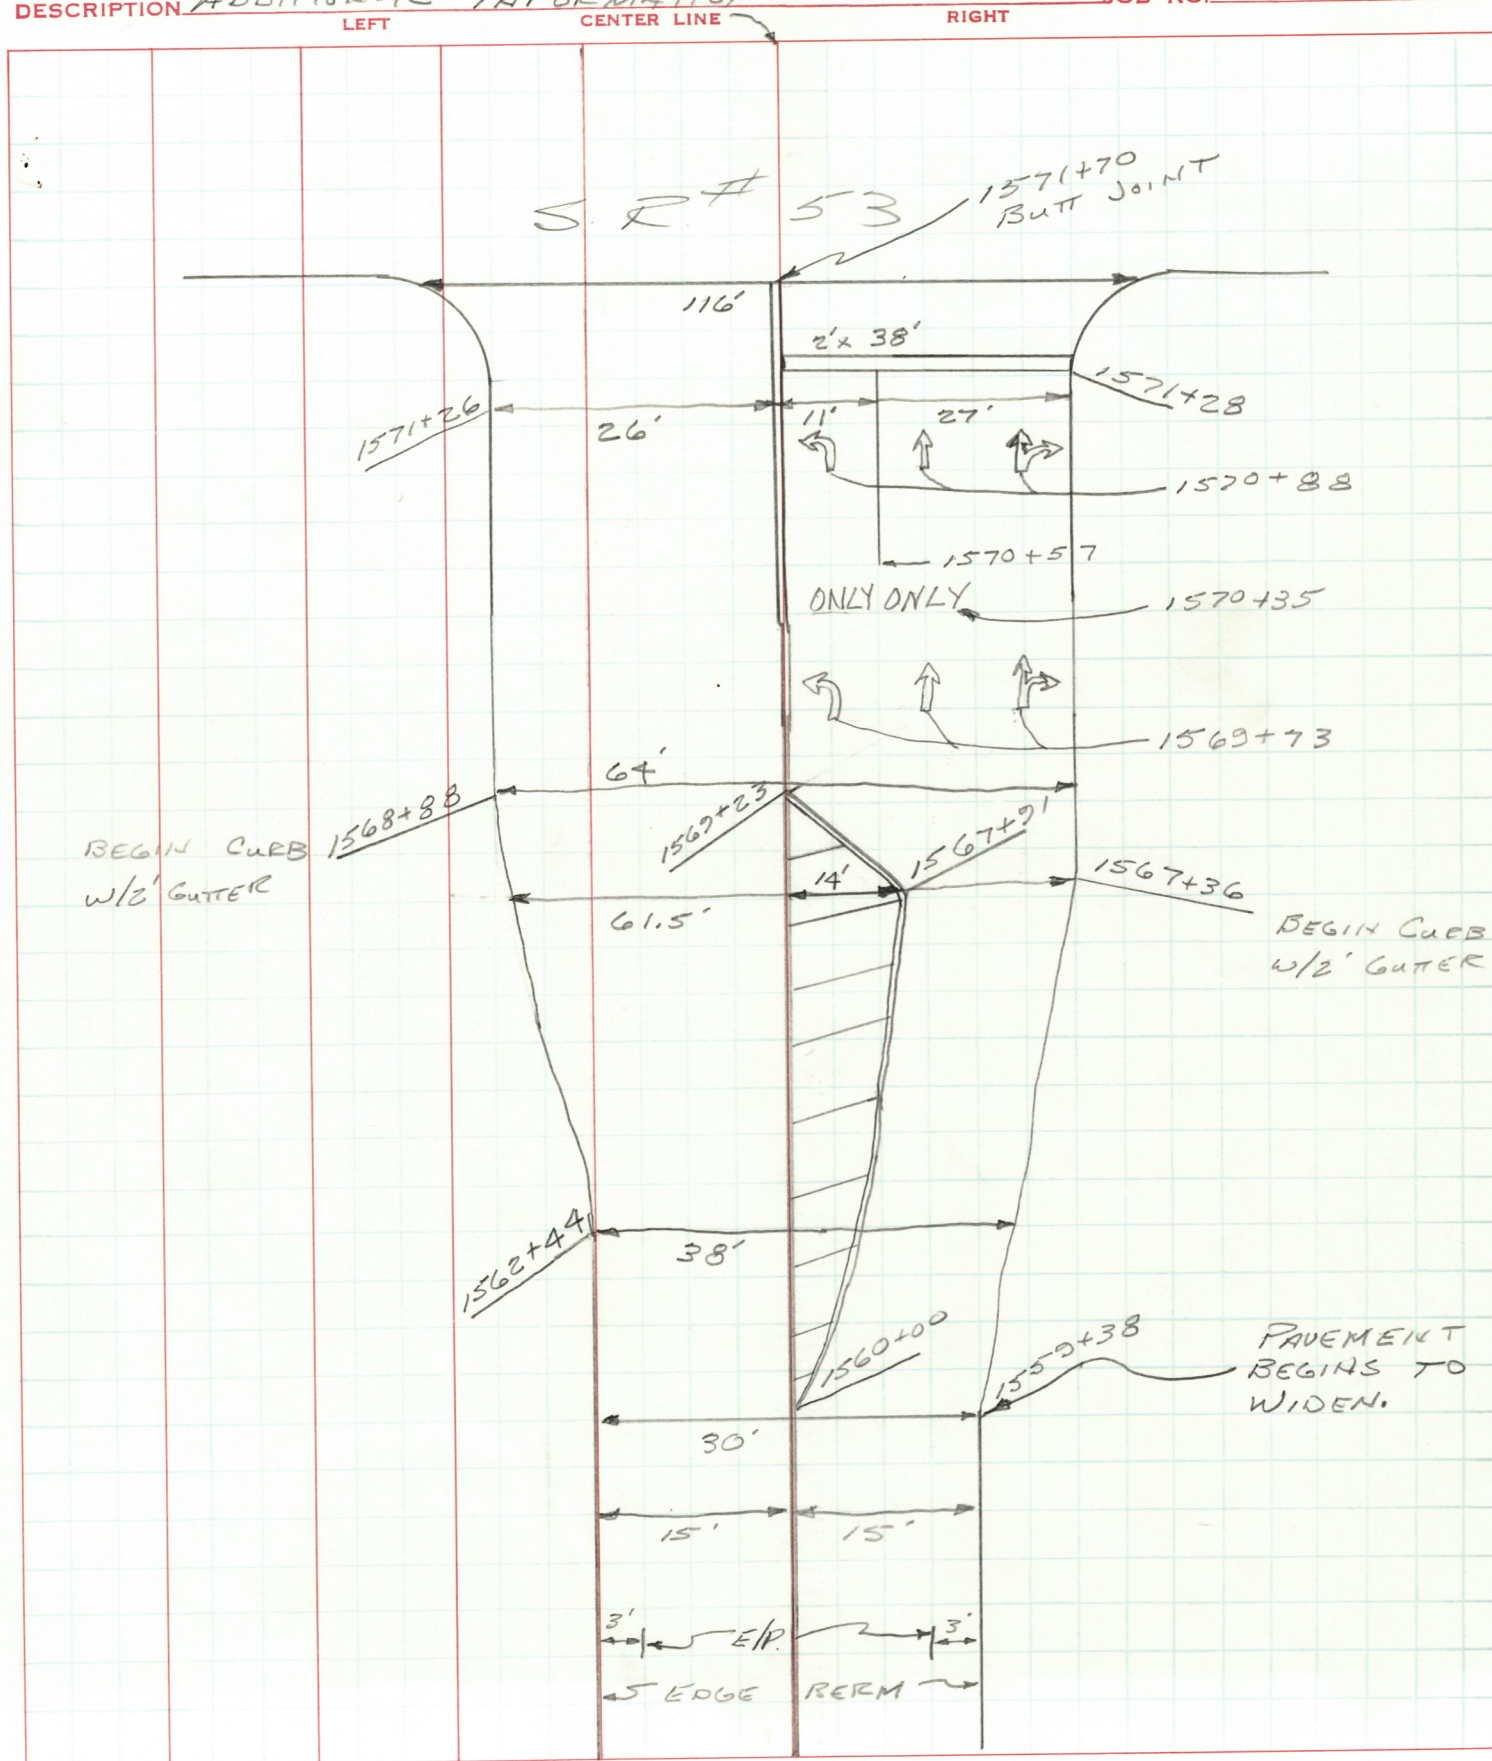

PERSONNEL TITLE PERSONNEL TITLE
 CHENEY M
 BARBOUR TAPE

COUNTY OTTAWA

DATE 2-17-1992

S. R. #163

WEATHER SUNNY

SEC. 27.15

TEMP. 80°

DESCRIPTION ADDITIONAL INFORMATION

JOB NO. 026112-62

