

O.D.O.T. DISTRICT 2 SURVEY OFFICE (USE ONLY)

PERSONNEL

REFERENCE NO. 3

SHEET 3 OF 23

NOTES MILLER

DATE 12/9/22

ROUTE SR 163

H.C. NIESE

WEATHER OVERCAST

COUNTY OTTAWA

R.C. AUBLE

TEMP. 36°

TOWNSHIP CLAY

RHOADES

DWG BY RHOADES

PID 102951

SECTION 6

T 6 N R 13 E

TYPE MONUMENT CMON W/ ODOT DISK

ON SURFACE - ~~BELOW~~ ON

OFFSET Q PAVEMENT 49' LT : ~~RT~~

- TO - EDGE PAVEMENT


STATION: 47+09.03

HORZ.DATUM: NAD83 2011


GEOID: NAVD88 2018

GRID: NORTHING: 674698.047

EASTING: 1722739.544

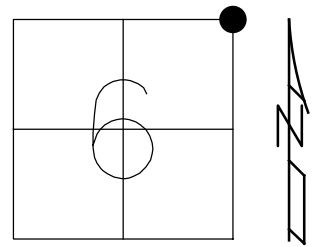

RECORD:
 MONBOX SET
 2003
 FD MONBOX
 W/ 1" IPIN
 REF3
 5/23/16, JFO
 7/15/22, TDN
 FD CMON
 W/ODOT DISK
 COUNTY ENGR.
 DUG TO STONE
 SET CMON ATOP
 NEWREF3
 12/9/22, TDN

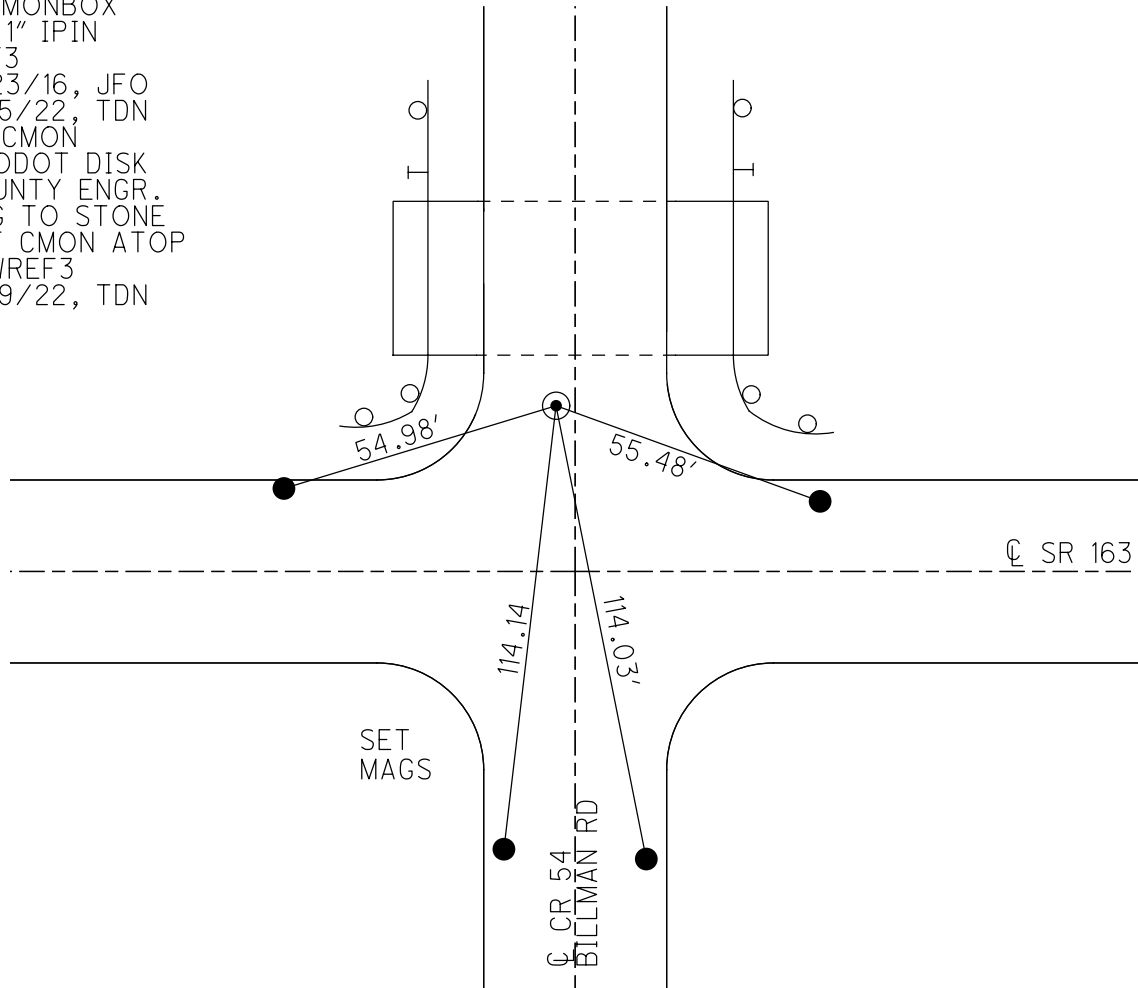


O.D.O.T. DISTRICT 2 SURVEY OFFICE (USE ONLY)

PERSONNEL _____ REFERENCE NO. 3 SHEET 3 OF 23


NOTES RYALL DATE 5/8/03 ROUTE SR 163
 H.C. CANTERBURY WEATHER CLOUDY COUNTY OTTAWA
 R.C. BARNHEISEL TEMP. 58° TOWNSHIP CLAY
 _____ SECTION 6
 _____ T 6 N R 13 E

TYPE MONUMENT MON BOX W/1" IPIN
 ON SURFACE - ~~BELOW~~ ON
 LEFT - ☉ PAV'T ~~= RIGHT~~ 49', 1' W OF ☉ N
TO EDGE PAVEMENT
 S.L.M. 47+09.03

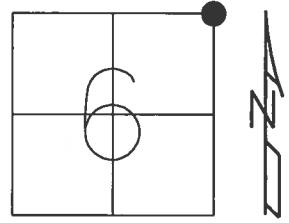

GRID: NORTHING: 674698.975 EASTING: 1722739.427


RECORD:
 MON. BOX SET FROM NEW CONST. 2003
 FD MONBOX W/ 1" IPIN
 REF3
 5/23/16, JFO

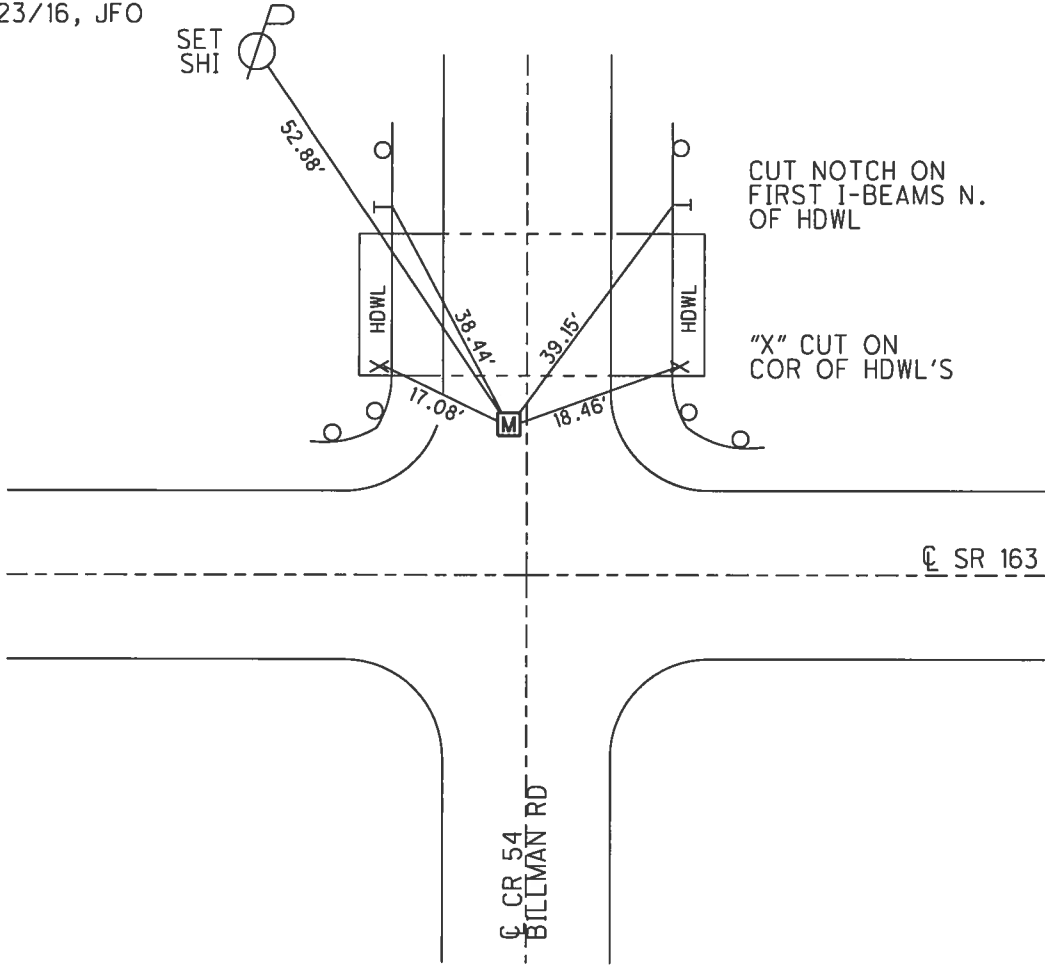

O.D.O.T. DISTRICT 2 SURVEY OFFICE (USE ONLY)

PERSONNEL _____ REFERENCE NO. 3 SHEET 3 OF 23
 NOTES RYALL DATE 05/08/03 ROUTE SR 163
 H.C. CANTERBURY WEATHER CLOUDY COUNTY OTTAWA
 R.C. BARNHISEL TEMP. 58° TOWNSHIP CLAY
 _____ SECTION 6
 T 6 N R 13 E


TYPE MONUMENT MON BOX W/1" IPIN
 ON SURFACE - ~~BELOW~~ ON
 LEFT - CL PAV'T ~~= RIGHT~~ 49', 1' W OF CL N
- TO - EDGE PAVEMENT
 S.L.M. 47+05.74

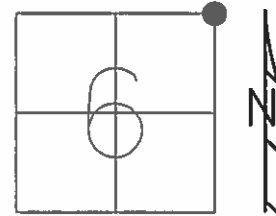

GRID: NORTHING: _____ EASTING: _____

RECORD: MON. BOX SET FROM NEW CONST. 2003

NOTE: 9.2' S. OF S. EDGE OF DECK

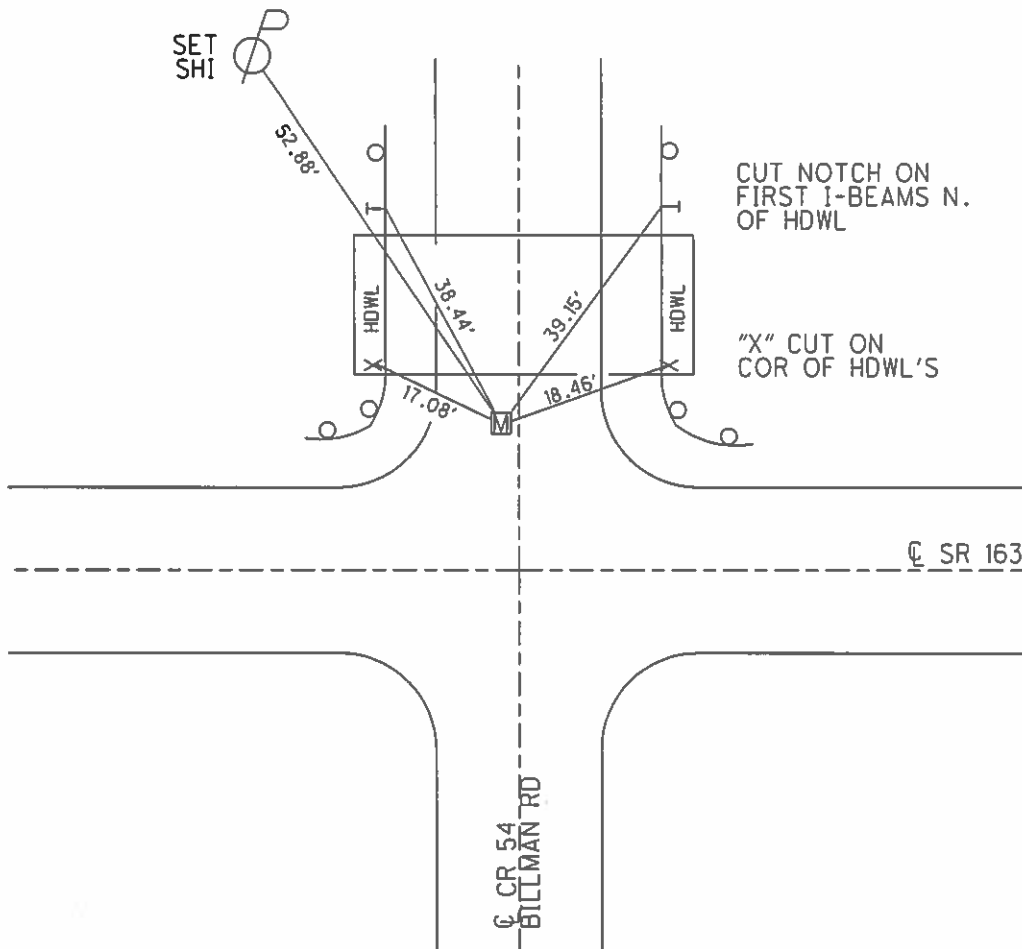

O.D.O.T. DISTRICT 2 SURVEY OFFICE

PERSONNEL _____

REFERENCE NO. 3

SHEET 3 OF 18

NOTES RIPPLE

H.C. Cheney

R.C. Geyman

DATE 10/29/91

WEATHER Sunny

TEMP. 68°

ROUTE S.R. #163

COUNTY OTTAWA

TOWNSHIP CLAY

SECTION 31, 32, 5, 6

T16 N R 13 E

TYPE MONUMENT Set P.K. Nail Washer

ON SURFACE - BELOW

LEFT- & PAV'T. - RIGHT 1.5'


9' TO LT. EDGE PAVEMENT

S.L.M. 47+17

31	32
6	5



Records: 9-27-70
Pd. R.R. spike 2" down

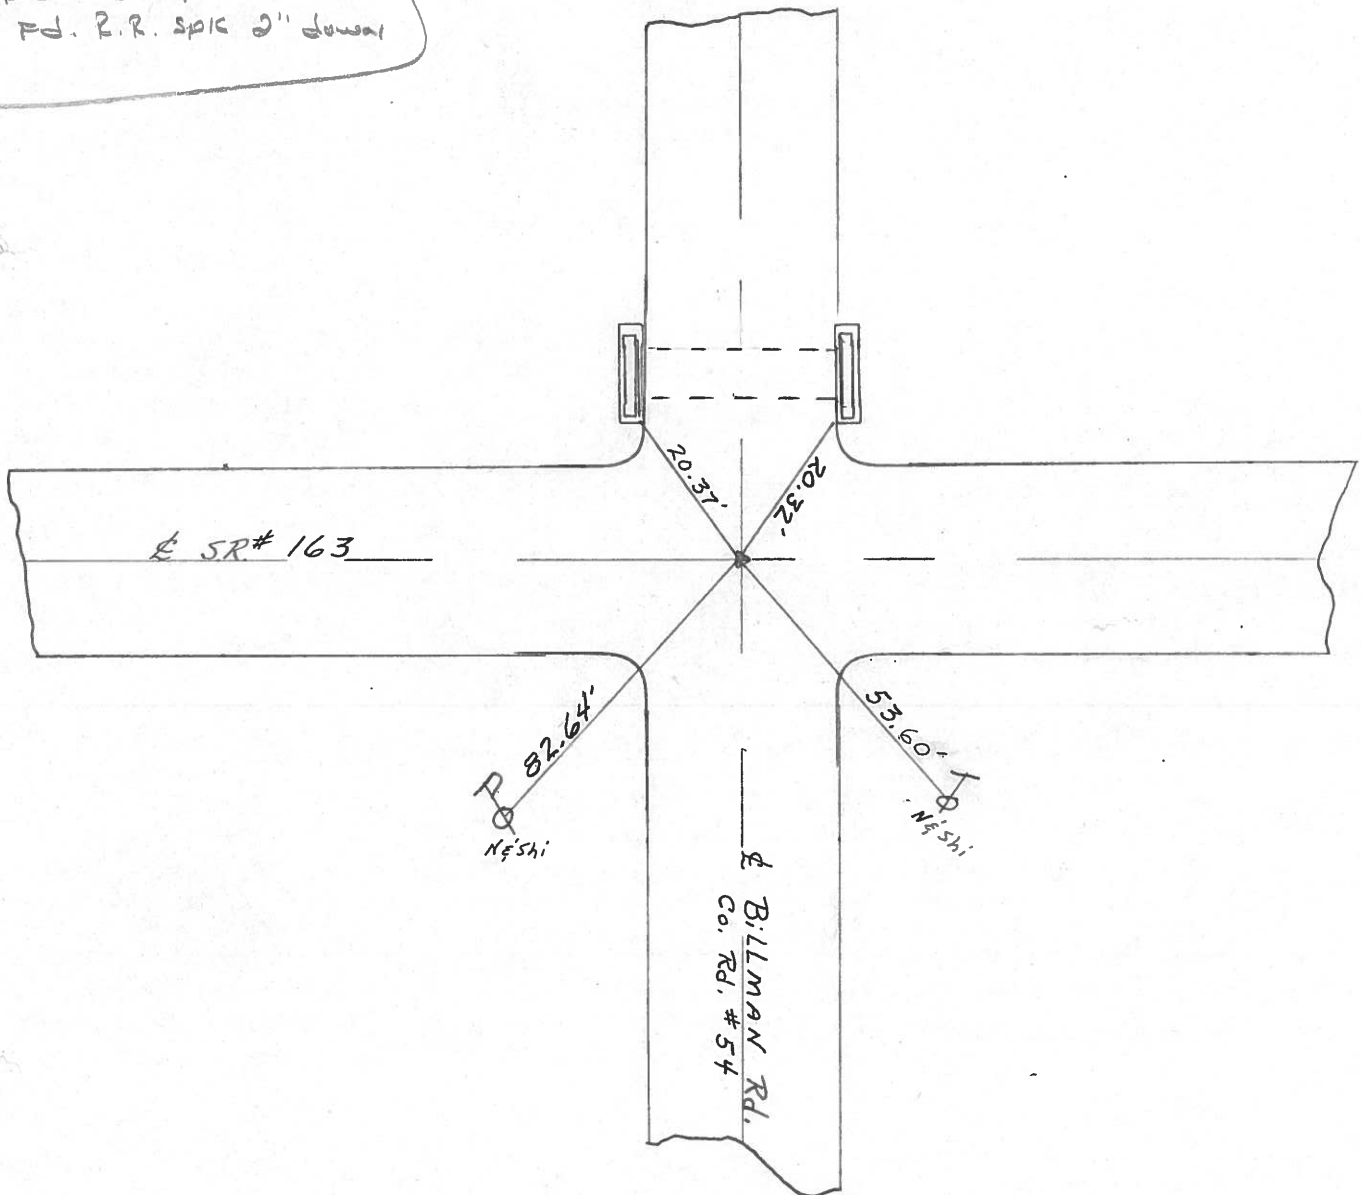

PERSONNEL TITLE PERSONNEL TITLE

Schneider

Mosser

Barbour

Geyman

COUNTY Ottawa

DATE 9-27-70

S. R. 163

WEATHER cloudy

SEC. 6 5 31

TEMP. 50°


DESCRIPTION Clay Twp.

JOB NO.

LEFT

CENTER LINE

RIGHT

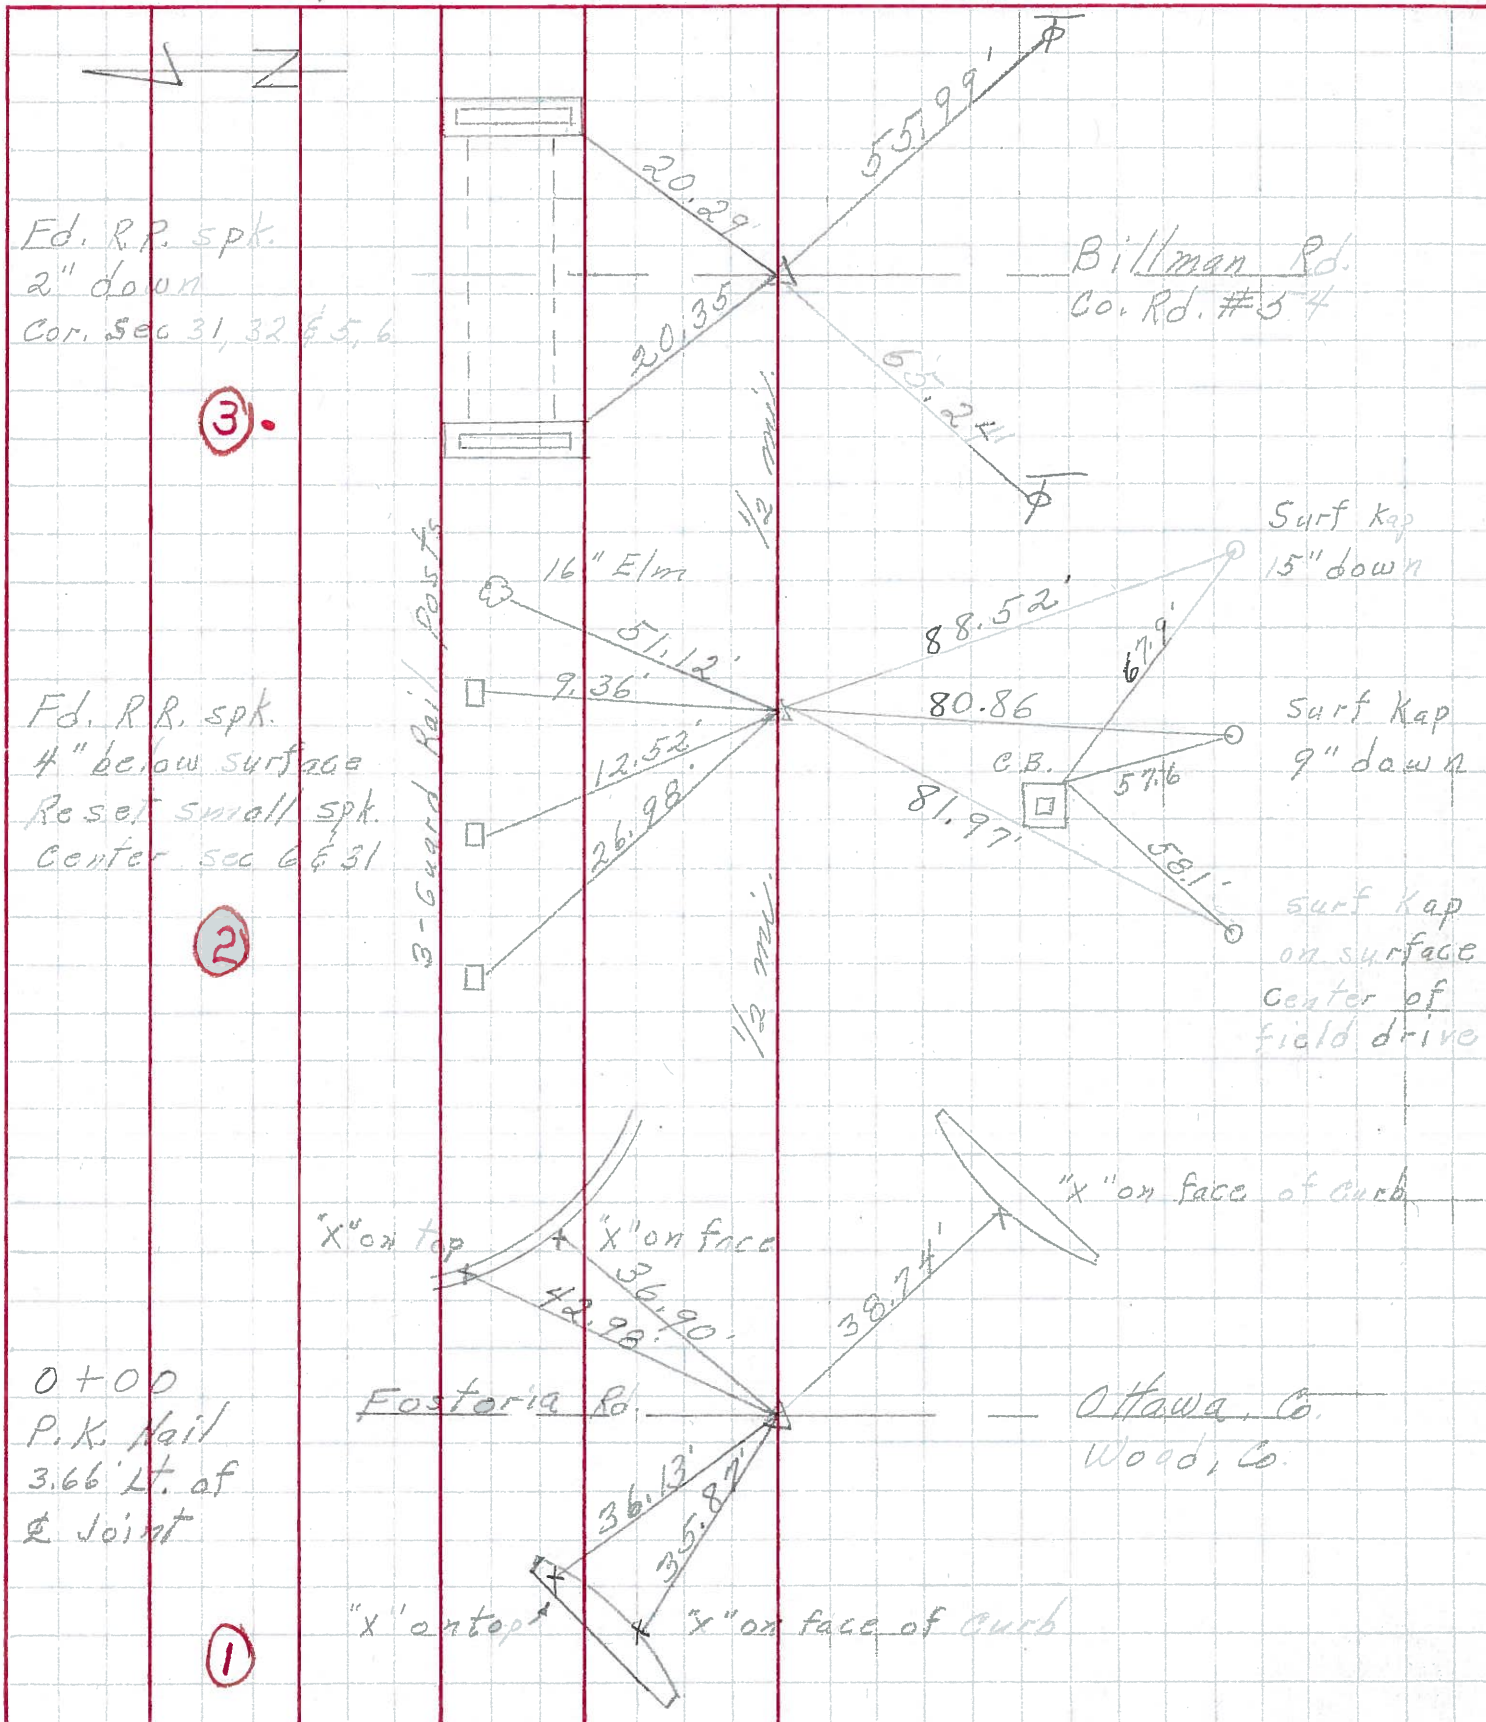

PERSONNEL TITLE PERSONNEL TITLE

Schneider _____
 Mosser _____
 Barbour _____
 Potts _____

COUNTY Ottawa DATE 5-17-68

S. R. 163 WEATHER Cloudy

SEC. Wood Co. Line-East TEMP. 50°

DESCRIPTION Ties for Control Points JOB NO. _____

LEFT CENTER LINE RIGHT

