



O.D.O.T. DISTRICT 2 SURVEY OFFICE (USE ONLY)

PERSONNEL _____ REFERENCE NO. 9 A SHEET 12 OF 23
 NOTES CARSON DATE 5/22/17 ROUTE SR 163
 H.C. O'DONNELL WEATHER FAIR COUNTY OTTAWA
 R.C. POORE TEMP. 55° TOWNSHIP CLAY
 _____ SECTION 4
 _____ T 6 N R 13 E

TYPE MONUMENT MAG/WASHER
 ON SURFACE - ~~BELOW~~ ON _____
~~LEFT~~ - ☉ PAV'T - RIGHT ON _____
 - TO - EDGE PAVEMENT _____
 S.L.M. 137+68.19

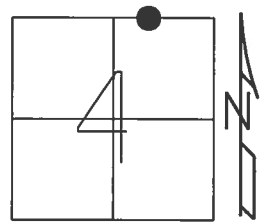


GRID: NORTHING: 674721.734 EASTING: 1731797.859

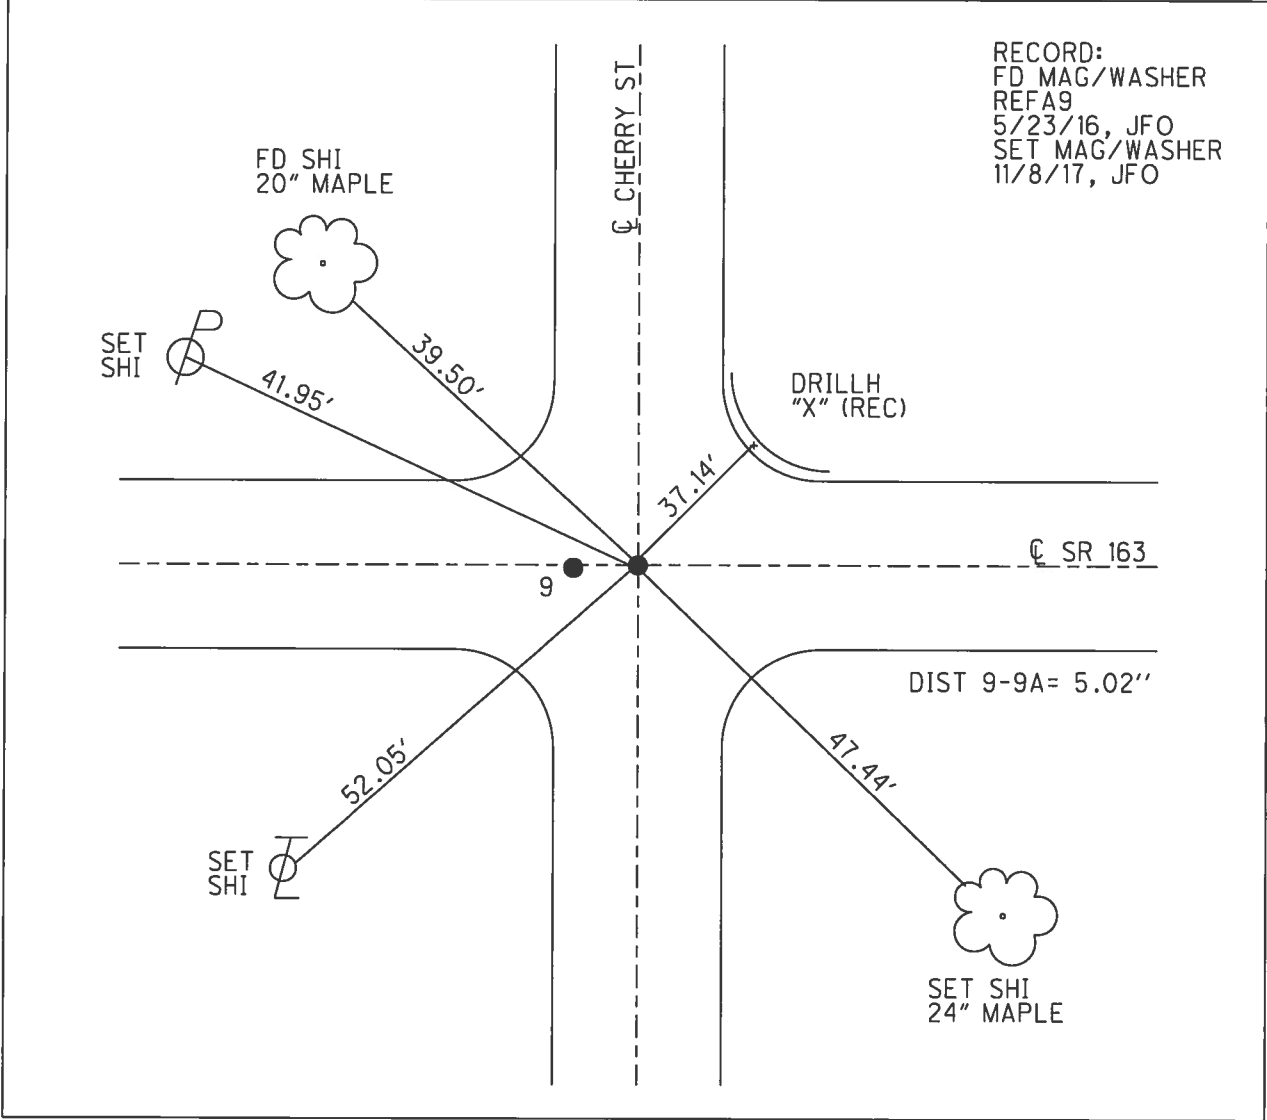

O.D.O.T. DISTRICT 2 SURVEY OFFICE (USE ONLY)


PERSONNEL _____ REFERENCE NO. 9 SHEET 12 OF 23
 NOTES BEAUMONT DATE 5/8/03 ROUTE SR 163
 H.C. HOMAN WEATHER SUNNY COUNTY OTTAWA
 R.C. GLASS TEMP. 50° TOWNSHIP CLAY
 _____ SECTION 4
 _____ T 6 N R 13 E

TYPE MONUMENT CMON
 ON SURFACE - ~~BELOW~~ ON _____
~~LEFT~~ - Q PAV'T - RIGHT ON _____
 - TO - EDGE PAVEMENT
 S.L.M. 138+05

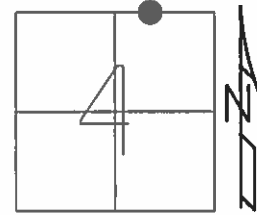

GRID: NORTHING: _____ EASTING: _____

RECORD:
 IPIN IN CONC. MON.

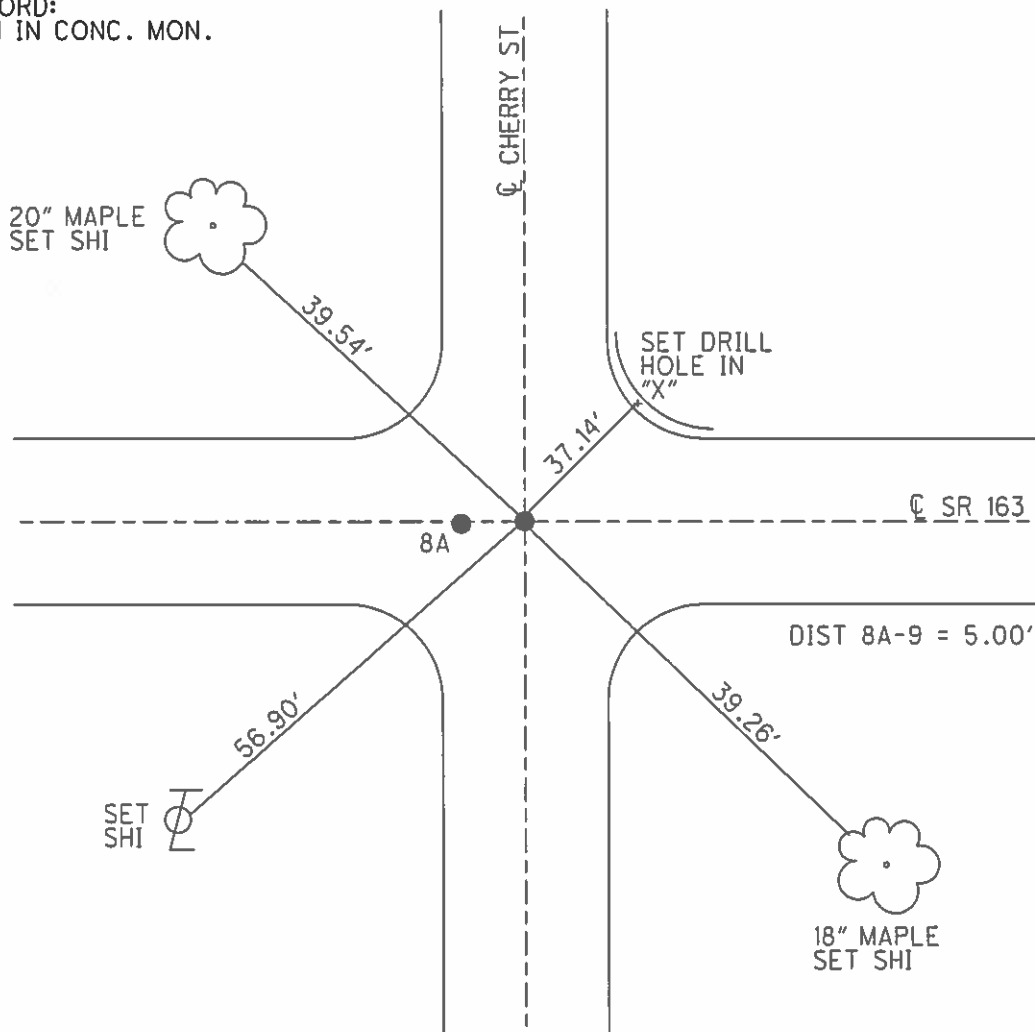

* See notes, Ref #7 *

O.D.O.T. DISTRICT 2 SURVEY OFFICE

PERSONNEL

REFERENCE NO. 9

SHEET 9 OF 18

NOTES RIPPLE

H.C. Cheney

DATE 11/04/91

ROUTE SR#163

R.C. Geyman

WEATHER Cloudy

COUNTY OTTAWA

TEMP. 29°

TOWNSHIP CLAY

SECTION 33E4

T ___ R ___


TYPE MONUMENT SET P.K. NAIL & WASHER

ON SURFACE - ~~BLOW~~ A- B=40

~~LEFT-C~~ PAV'T. - ~~RIGHT~~ yes SR 163

~~12~~ TO ~~RT~~ EDGE PAVEMENT B=4ft wof A


S.L.M. 138+00

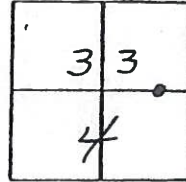

Beaman's notes

Doman HC 5/8/03

Glass RC 50°

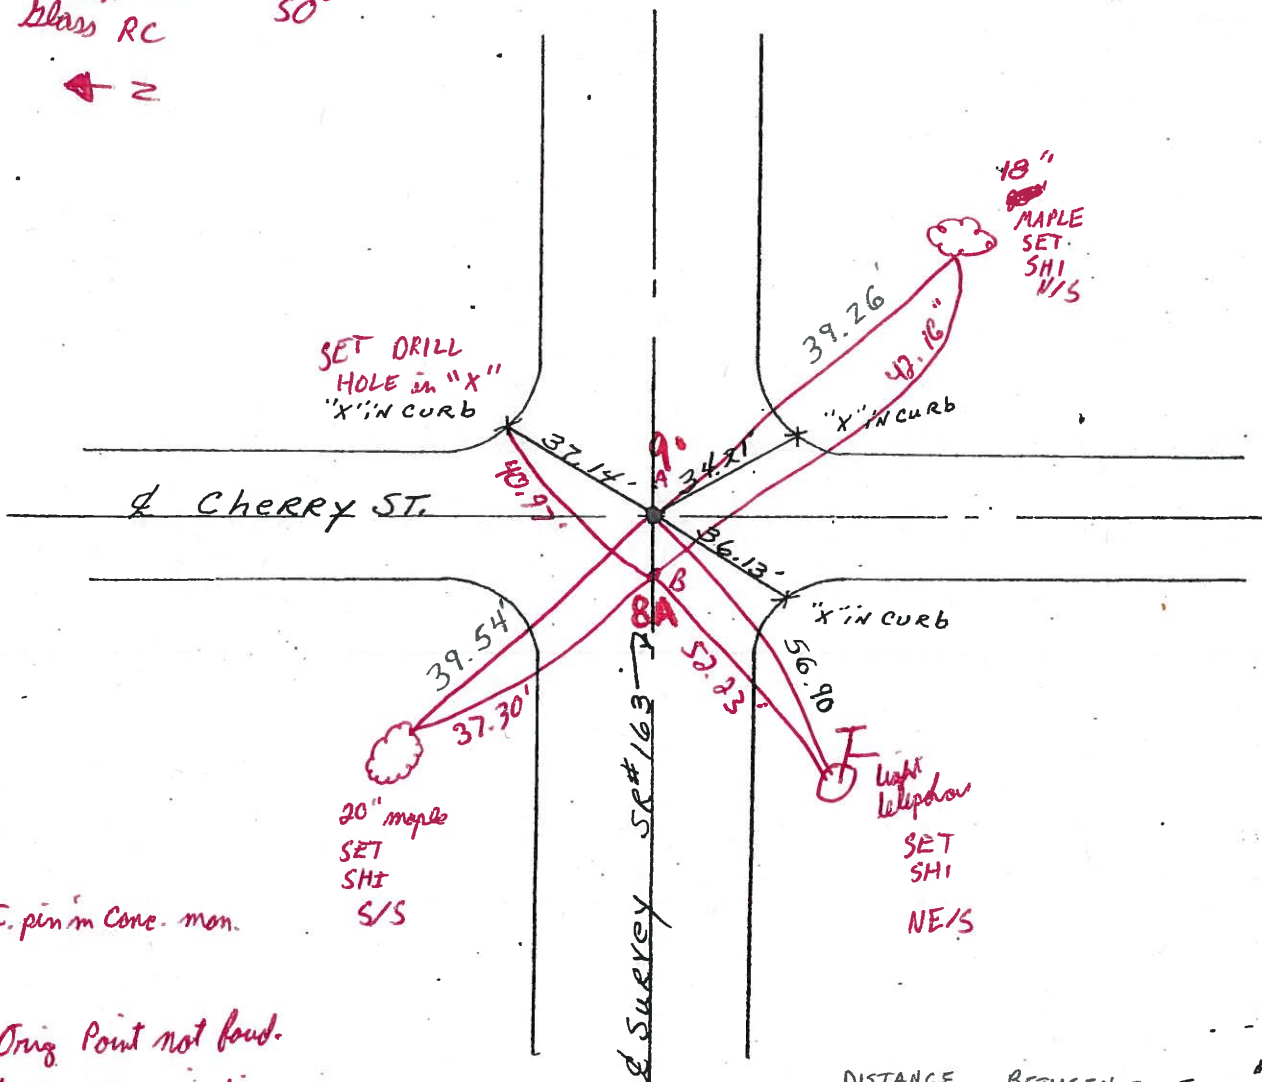

B = I. pin in Conc. mon.

A = Orig. Point not found.

to Dig after grinding

DISTANCE BETWEEN = 5.00'

O.D.O.T. DISTRICT 2 SURVEY OFFICE

PERSONNEL

REFERENCE NO. 9

SHEET 9 OF 18

NOTES RIPPLE

H.C. Cheney

DATE 11/04/91

ROUTE SR#163

R.C. Geyman

WEATHER Cloudy

COUNTY OTTAWA

TEMP. 29°

TOWNSHIP CLAY

SECTION 33E4

T R



TYPE MONUMENT SET PK. NAIL & WASHER

ON SURFACE - BELOW

LEFT - C PAV'T. - RIGHT .50'

12' TO RT EDGE PAVEMENT

S.L.M. 138+00

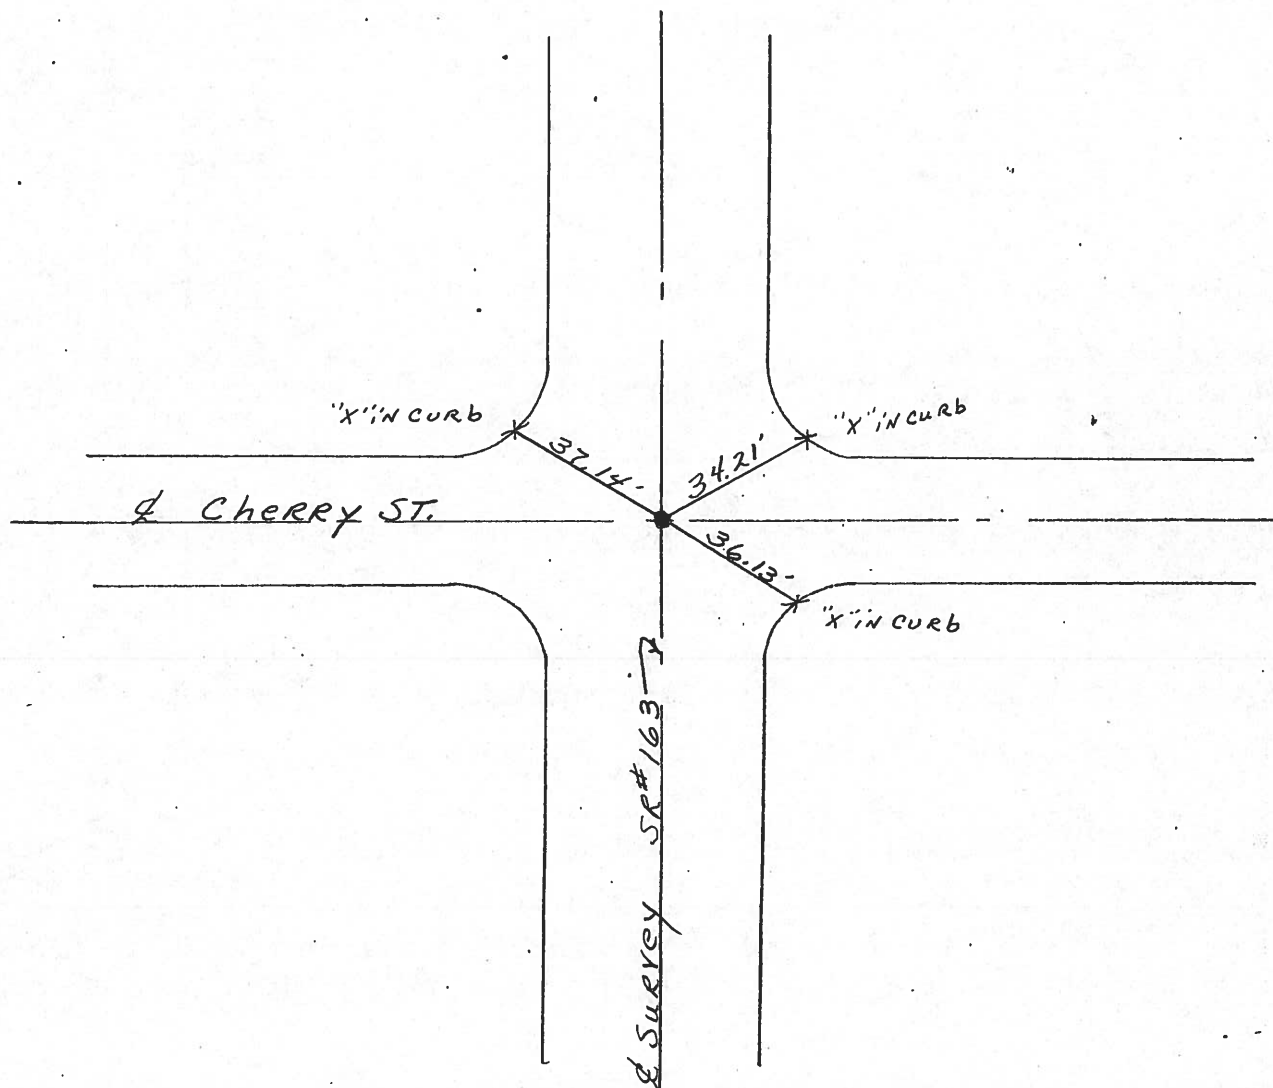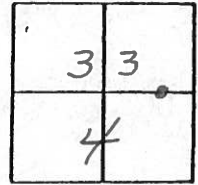


PERSONNEL TITLE PERSONNEL TITLE

COUNTY Ottawa DATE 9-27-70

S. R. 163 WEATHER

SEC. Genoa TEMP.

DESCRIPTION Clay Twp. JOB NO.

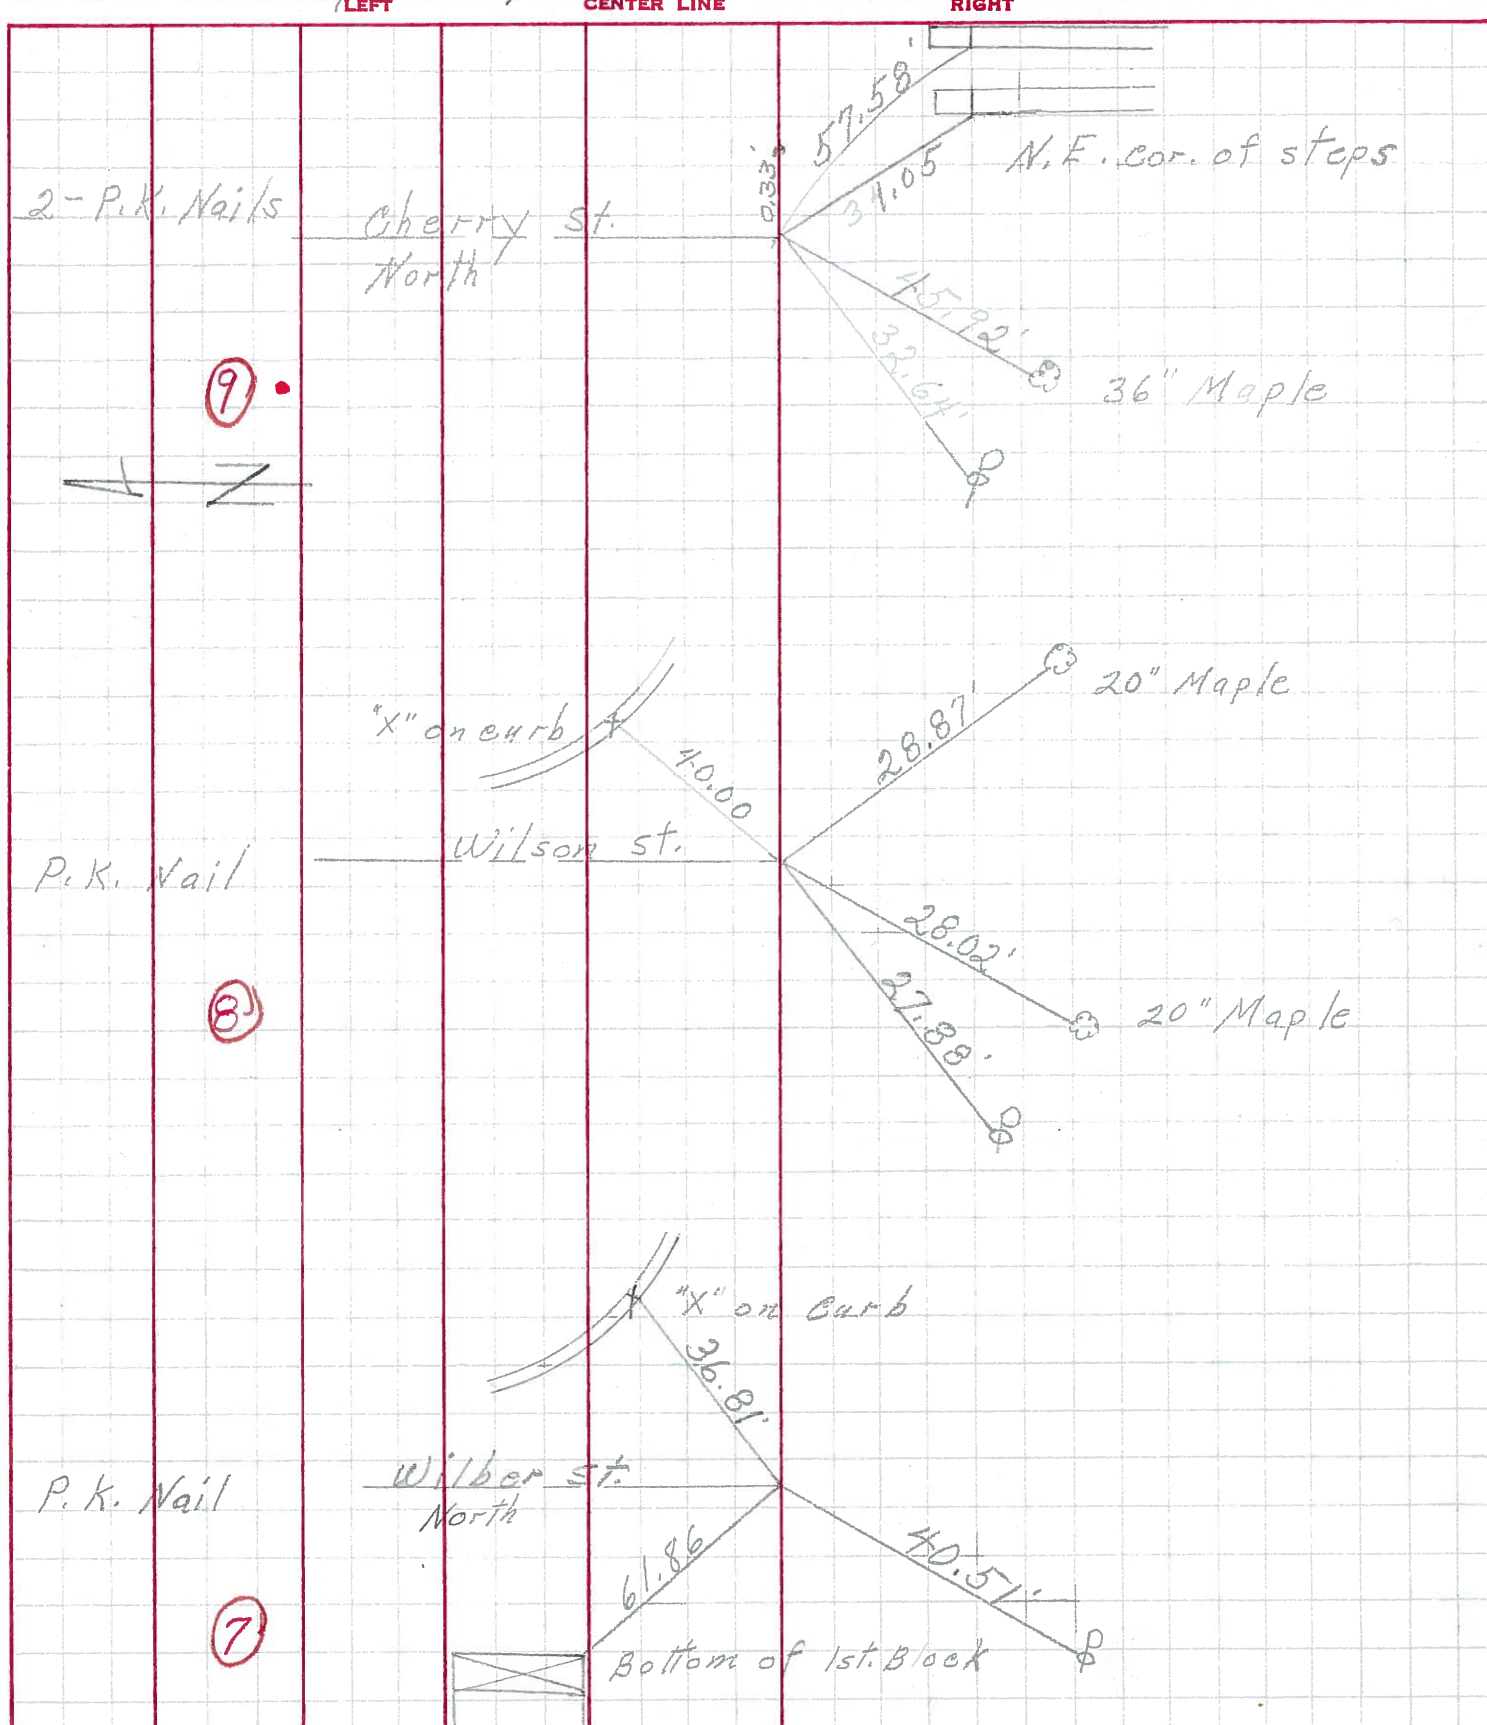

PERSONNEL TITLE PERSONNEL TITLE

Schneider
Messer
Potts

COUNTY Ottawa DATE 3-13-70

S. R. 163 WEATHER Fair

SEC. Genoa TEMP. 25°

DESCRIPTION Ties for Control Points JOB NO.

LEFT CENTER LINE RIGHT

