


O.D.O.T. DISTRICT 2 SURVEY OFFICE (USE ONLY)


PERSONNEL _____ REFERENCE NO. 10 A SHEET 14 OF 23

NOTES CARSON DATE 5/22/17 ROUTE SR 163
 H.C. O'DONNELL WEATHER FAIR COUNTY OTTAWA
 R.C. POORE TEMP. 55° TOWNSHIP CLAY
RHOADES SECTION 4
T 6 N R 13 E

TYPE MONUMENT P.K./WASHER
 ON SURFACE - ~~BELOW~~ ON _____
 LEFT - ☉ PAV'T - RIGHT ON _____
 - TO - EDGE PAVEMENT
 S.L.M. 141+55.57

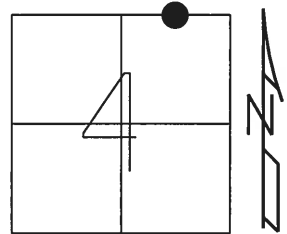

GRID: NORTHING: 674724.723 EASTING: 1732185.226

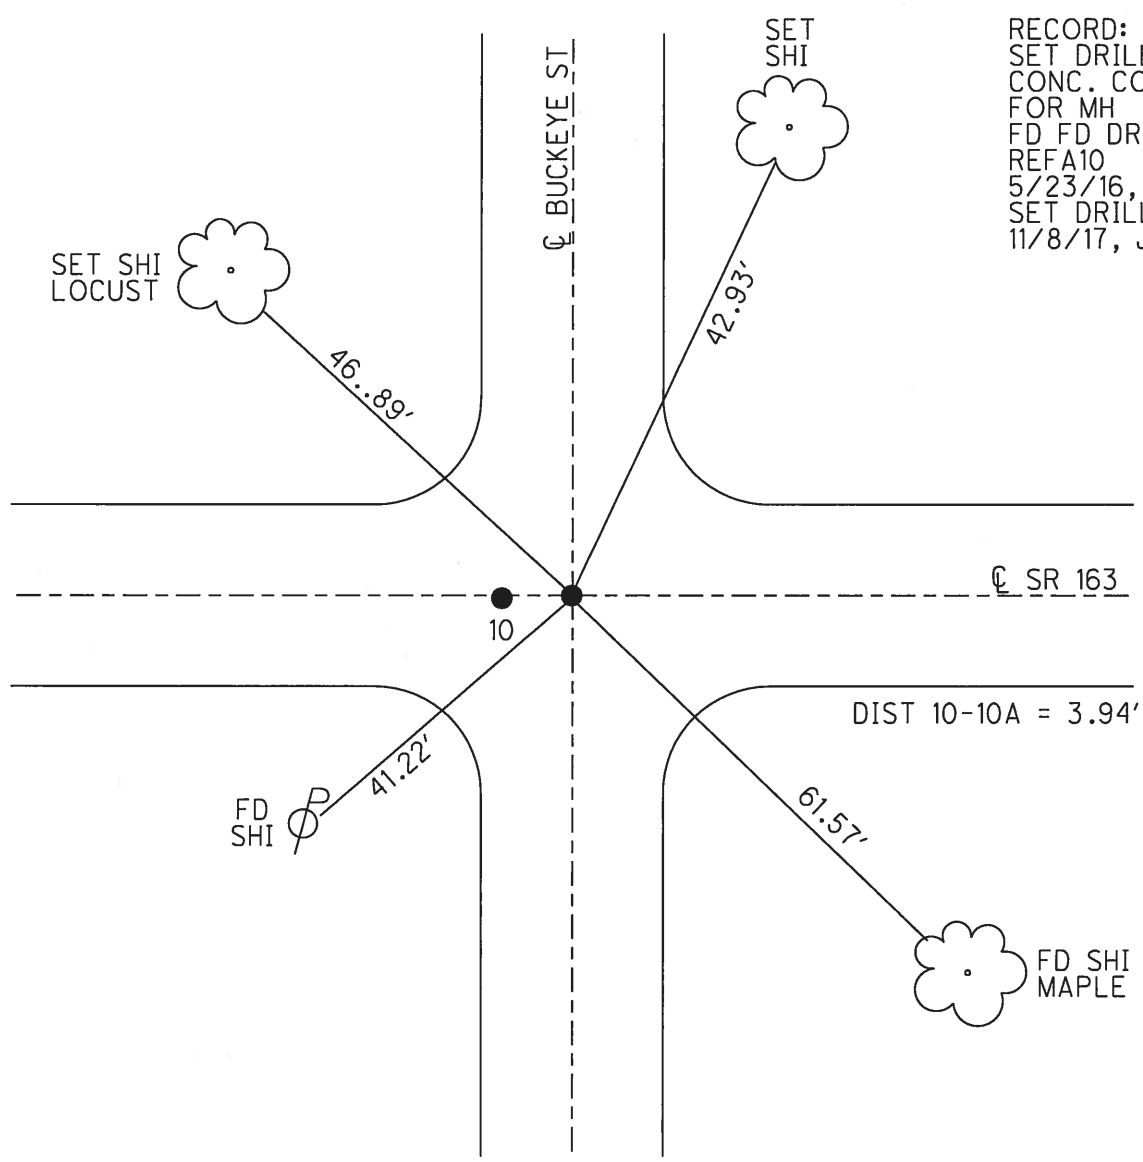


RECORD:
 SET DRILLH IN
 CONC. COLLAR
 FOR MH
 FD FD DRILLH
 REFA10
 5/23/16, JFO
 SET DRILLH
 11/8/17, JFO

O.D.O.T. DISTRICT 2 SURVEY OFFICE (USE ONLY)

PERSONNEL _____ REFERENCE NO. 10 SHEET 14 OF 23


NOTES BEAUMONT DATE 5/8/03 ROUTE SR 163
 H.C. HOMAN WEATHER SUNNY COUNTY OTTAWA
 R.C. GLASS TEMP. 50° TOWNSHIP CLAY
 SECTION 4
 T 6 N R 13 E

TYPE MONUMENT P.K./WASHER
 ON SURFACE ~~BELOW~~ ON
 LEFT - ℄ PAV'T - RIGHT ON
TO EDGE PAVEMENT
 S.L.M. 141+88

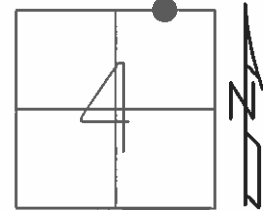

GRID: NORTHING: _____ EASTING: _____

RECORD:
 SET DRILL HOLE
 IN CONC. COLLAR
 FOR MANHOLE
 3-3-04

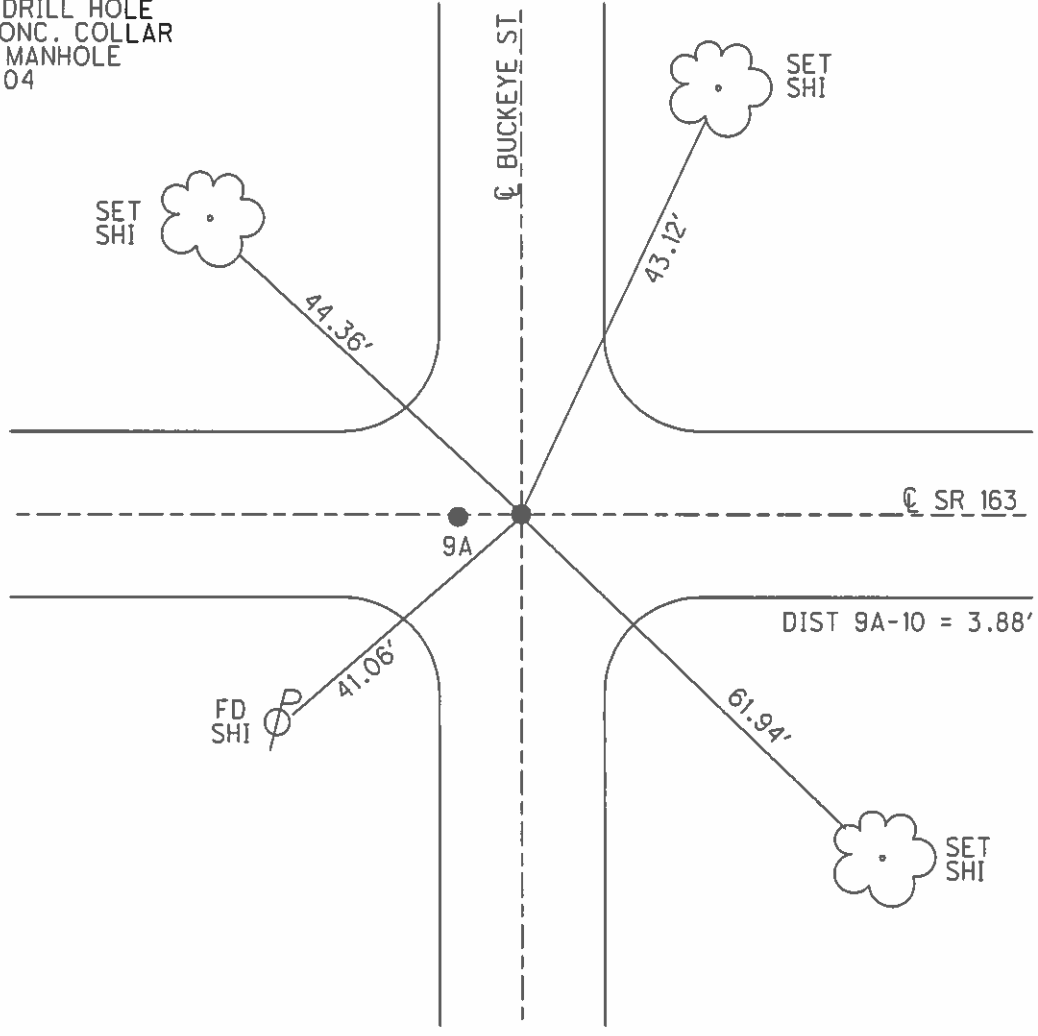

O.D.O.T. DISTRICT 2 SURVEY OFFICE

PERSONNEL

REFERENCE NO. 10

SHEET 10 OF 18

NOTES Ripple

H.C. Cheney

R.G. Geyman

DATE 11/04/91

WEATHER Cloudy

TEMP. 29°

ROUTE SR#163

COUNTY OTTAWA

TOWNSHIP CLAY

SECTION 33E4

T. 6 N. R. 13 E.

TYPE MONUMENT Set P.K. Nailwasher

ON SURFACE - BELOW YES

~~LEFT~~ - CL PAV'T. - RIGHT 1' A=CL BOTH


TO EDGE PAVEMENT B=4' WEST OF BUCKEYE ST.

S.L.M. 141+88

3	3
4	.



Beaumont notes 5/8/03
 Koman HC 50°
 Glass RC

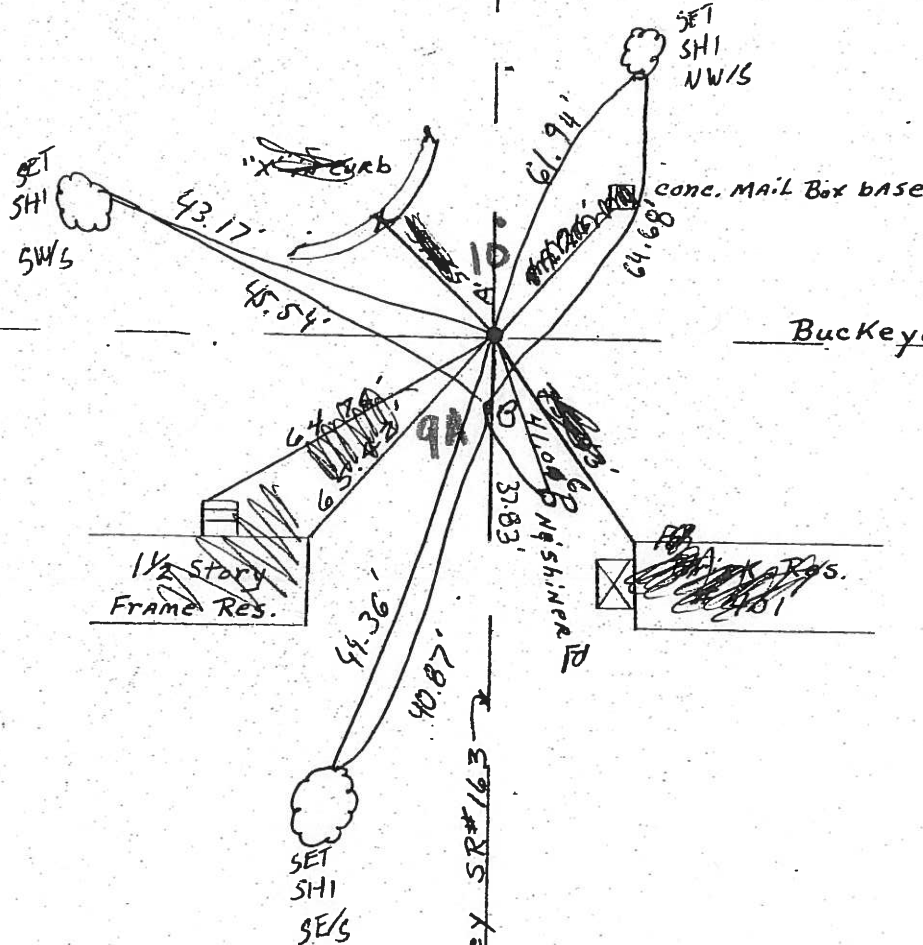

Dist A to B = 3.88'

SURVEY SR#163

Buckeye ST.

O.D.O.T. DISTRICT 2 SURVEY OFFICE

PERSONNEL _____

REFERENCE NO. 10

SHEET 10 OF 18

NOTES Ripple

H.C. Cheney

R.C. Geyman

DATE 11/04/91

WEATHER Cloudy

TEMP. 29°

ROUTE SR#163

COUNTY OTTAWA

TOWNSHIP CLAY

SECTION 33E4

T6 NR 13 E



TYPE MONUMENT Set PK. Nail Washer

ON SURFACE - BELOW

~~LEFT~~ - C PAV'T. - RIGHT 1'


TO EDGE PAVEMENT

S.L.M. 141+88

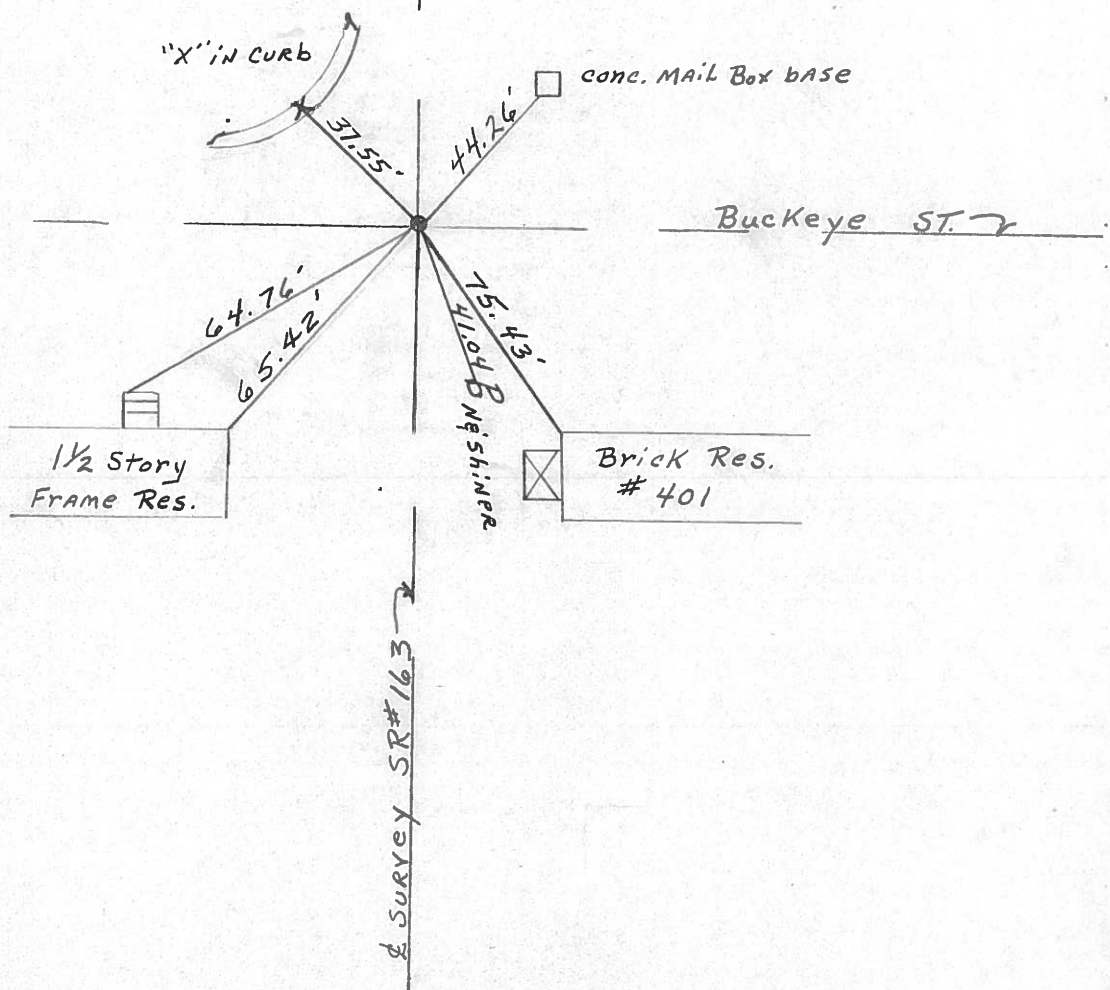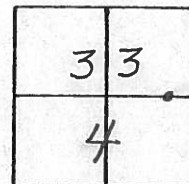

PERSONNEL _____ TITLE _____ PERSONNEL _____ TITLE _____
 COUNTY Ottawa DATE 9-70
 S. R. 163 WEATHER _____
 SEC. Genoa TEMP. _____

DESCRIPTION Clay Twp. LEFT CENTER LINE RIGHT JOB NO. _____

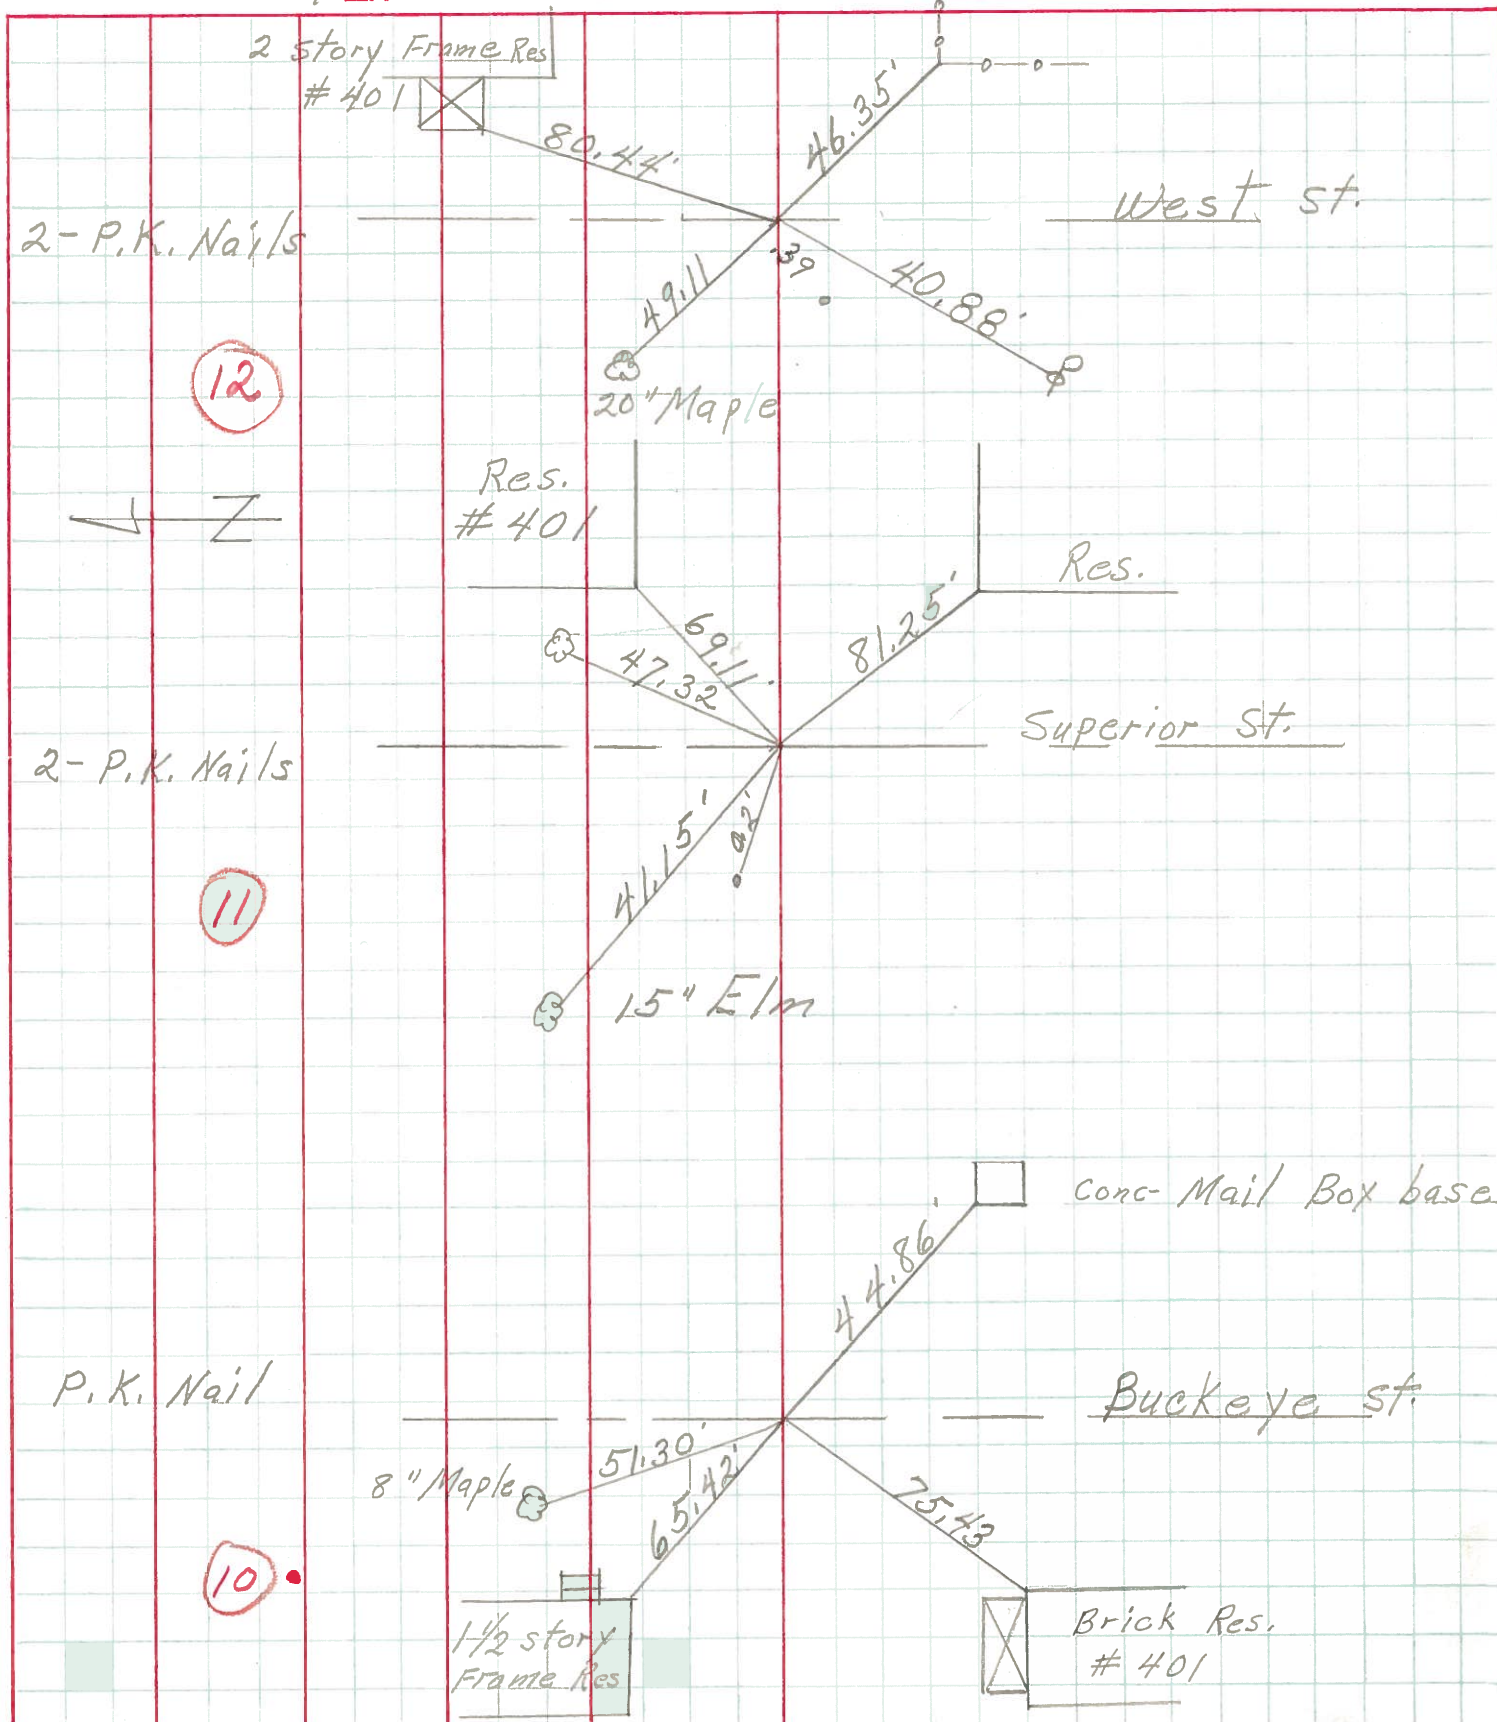

PERSONNEL TITLE PERSONNEL TITLE

Schneider
Mossler
Potts

COUNTY Ottawa DATE 3-13-70

S. R. 163 WEATHER Fair

SEC. Genoa TEMP. 25°

DESCRIPTION Ties for Control Points JOB NO.

LEFT CENTER LINE RIGHT

