


O.D.O.T. DISTRICT 2 SURVEY OFFICE (USE ONLY)

PERSONNEL _____ REFERENCE NO. 13 SHEET 19 OF 23


NOTES BEAUMONT DATE 5/8/03 ROUTE SR 163
 H.C. HOMAN WEATHER SUNNY COUNTY OTTAWA
 R.C. GLASS TEMP. 50° TOWNSHIP CLAY
 _____ SECTION 4
 _____ T 6 N R 13 E

TYPE MONUMENT MONBOX W/1" IPIN
 ON SURFACE - ~~BELOW~~ ON
 LEFT - ☉ PAV'T - RIGHT ON
12' TO RT EDGE PAVEMENT
 S.L.M. 153+17.04

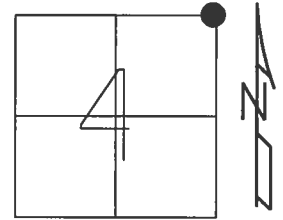

GRID: NORTHING: 674733.230 EASTING: 1733346.661

RECORD:
 MEASURED TO CENTER OF
 MONBOX, 5/8/03
 FD MONBOX
 W/ 1" IPIN
 REF13
 5/23/16, JFO

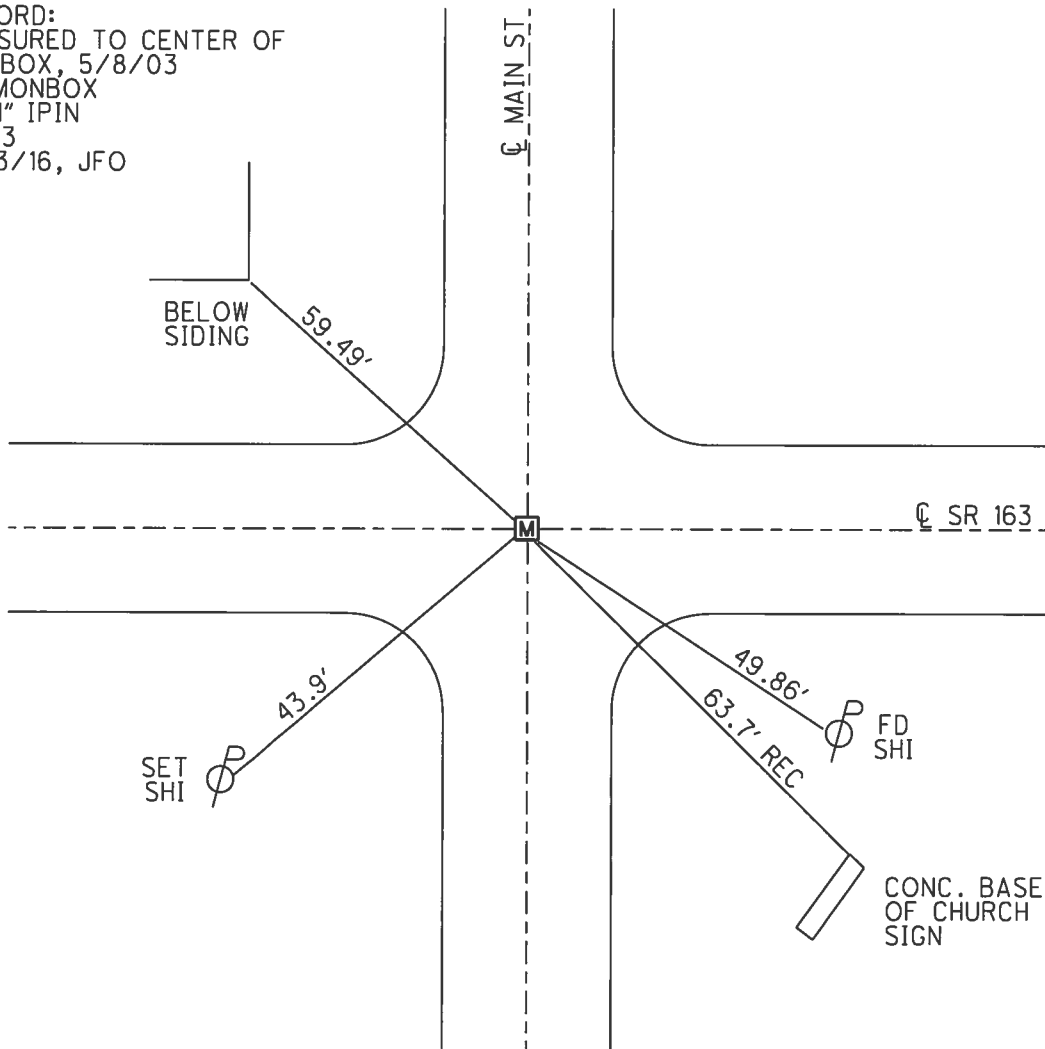


O.D.O.T. DISTRICT 2 SURVEY OFFICE (USE ONLY)

PERSONNEL _____ REFERENCE NO. 13 SHEET 19 OF 23


NOTES BEAUMONT DATE 5/8/03 ROUTE SR 163
 H.C. HOMAN WEATHER SUNNY COUNTY OTTAWA
 R.C. GLASS TEMP. 50° TOWNSHIP CLAY
 SECTION 4
 T 6 N R 13 E

TYPE MONUMENT MONBOX W/IPIN
 ON SURFACE - ~~BELOW~~ ON
 LEFT - ☉ PAV'T - RIGHT ON
12' TO RT EDGE PAVEMENT
 S.L.M. 153+13

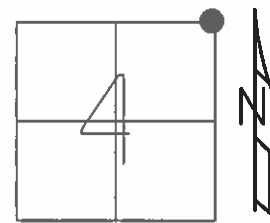

GRID: NORTHING: _____ EASTING: _____

RECORD:
 MEASURED TO CENTER OF
 MONBOX

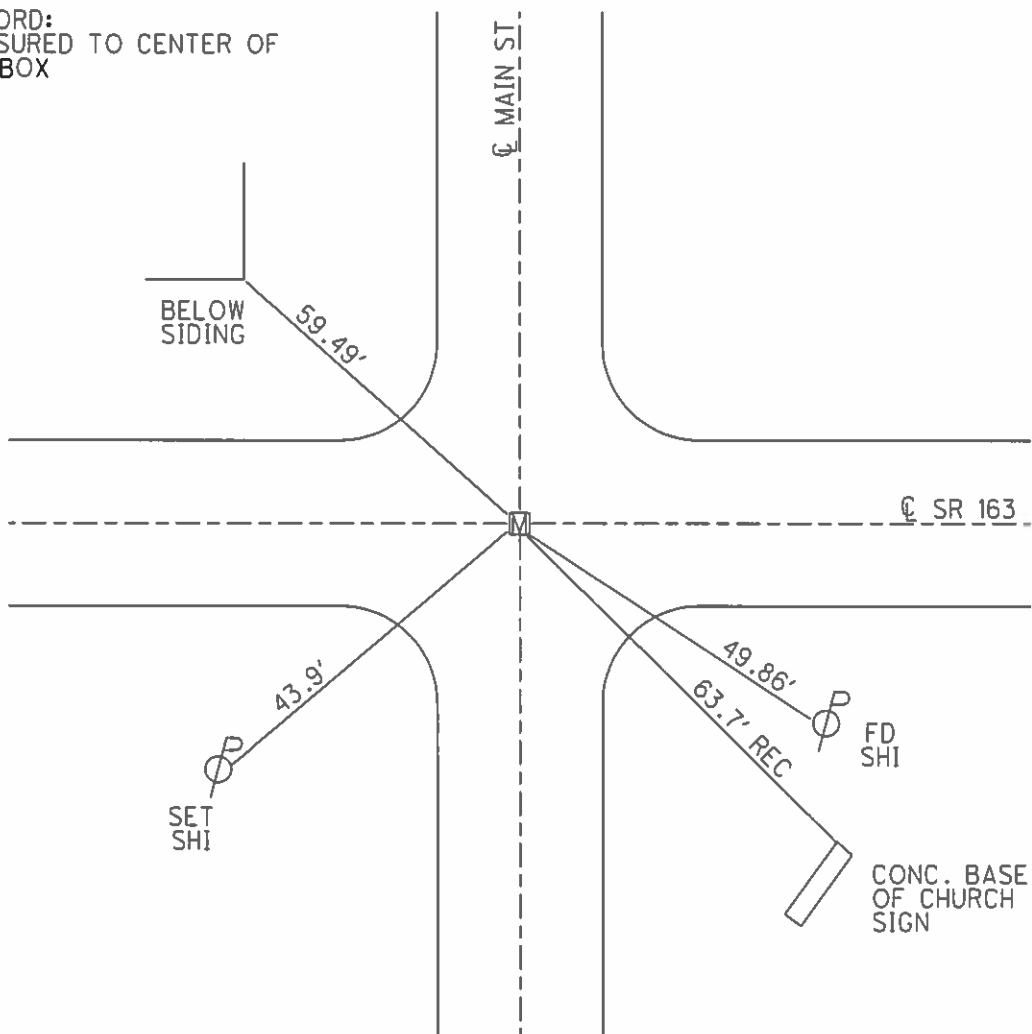

* See notes, Ref. # 7 *

O.D.O.T. DISTRICT 2 SURVEY OFFICE

PERSONNEL

REFERENCE NO. 13

SHEET 13 OF 18

NOTES Ripple

H.C. Cherney

R.G. Geyman

DATE 11/04/91

WEATHER Cloudy

TEMP. 29°

ROUTE SR # 163

COUNTY OTTAWA

TOWNSHIP CLAY

SECTION 33 E 4

T. 6 N. R. 13 E


TYPE MONUMENT Mon. Box w/ I. Pin

ON SURFACE - BELOW

LEFT - ℄ PAV'T. - RIGHT

12' TO RT. EDGE PAVEMENT



S.L.M. 153+52

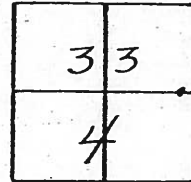

Beaumont notes 5/8/03

Doman IR 50°

Blais RC

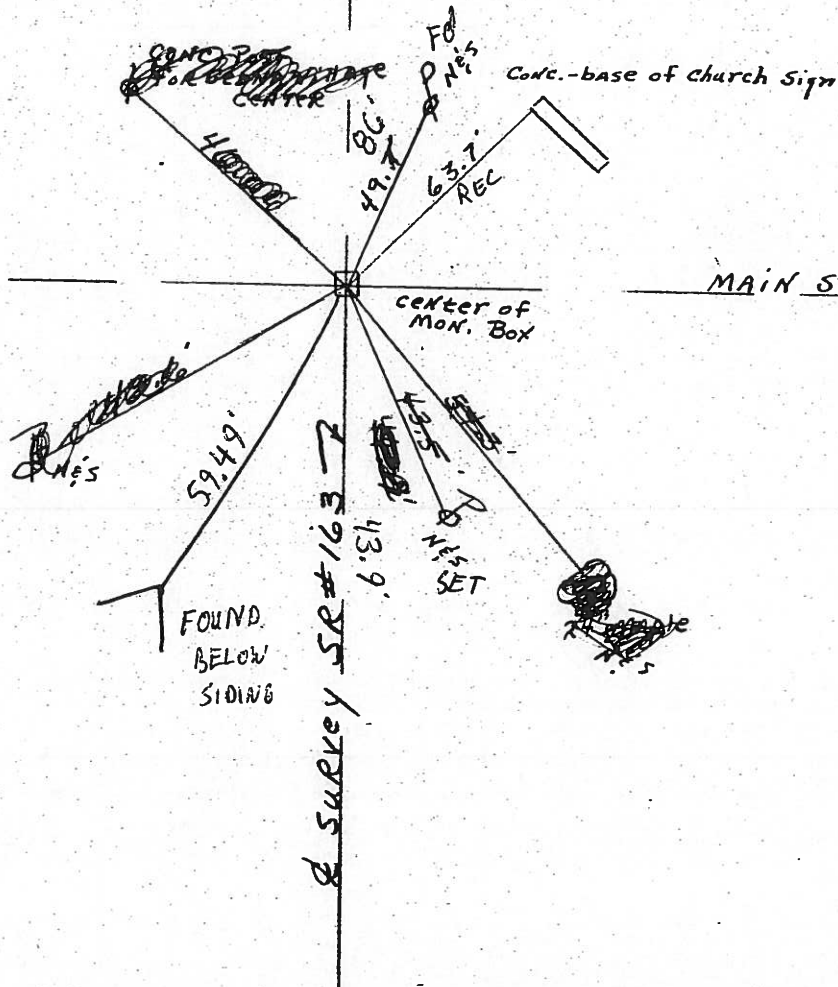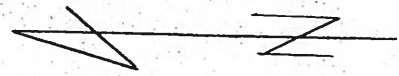

O.D.O.T. DISTRICT 2 SURVEY OFFICE

PERSONNEL

REFERENCE NO. 13

SHEET 13 OF 18

NOTES Ripple

H.C. Cherney

R.G. Geyman

DATE 11/04/91

WEATHER Cloudy

TEMP. 29°

ROUTE SR#163

COUNTY OTTAWA

TOWNSHIP CLAY

SECTION 33E4

T.6 N. R.13 E



TYPE MONUMENT Mon. Box w/I. Pin

ON SURFACE - BELOW

LEFT- & PAV'T. - RIGHT

12' TO RT. EDGE PAVEMENT

S.L.M. 153+52

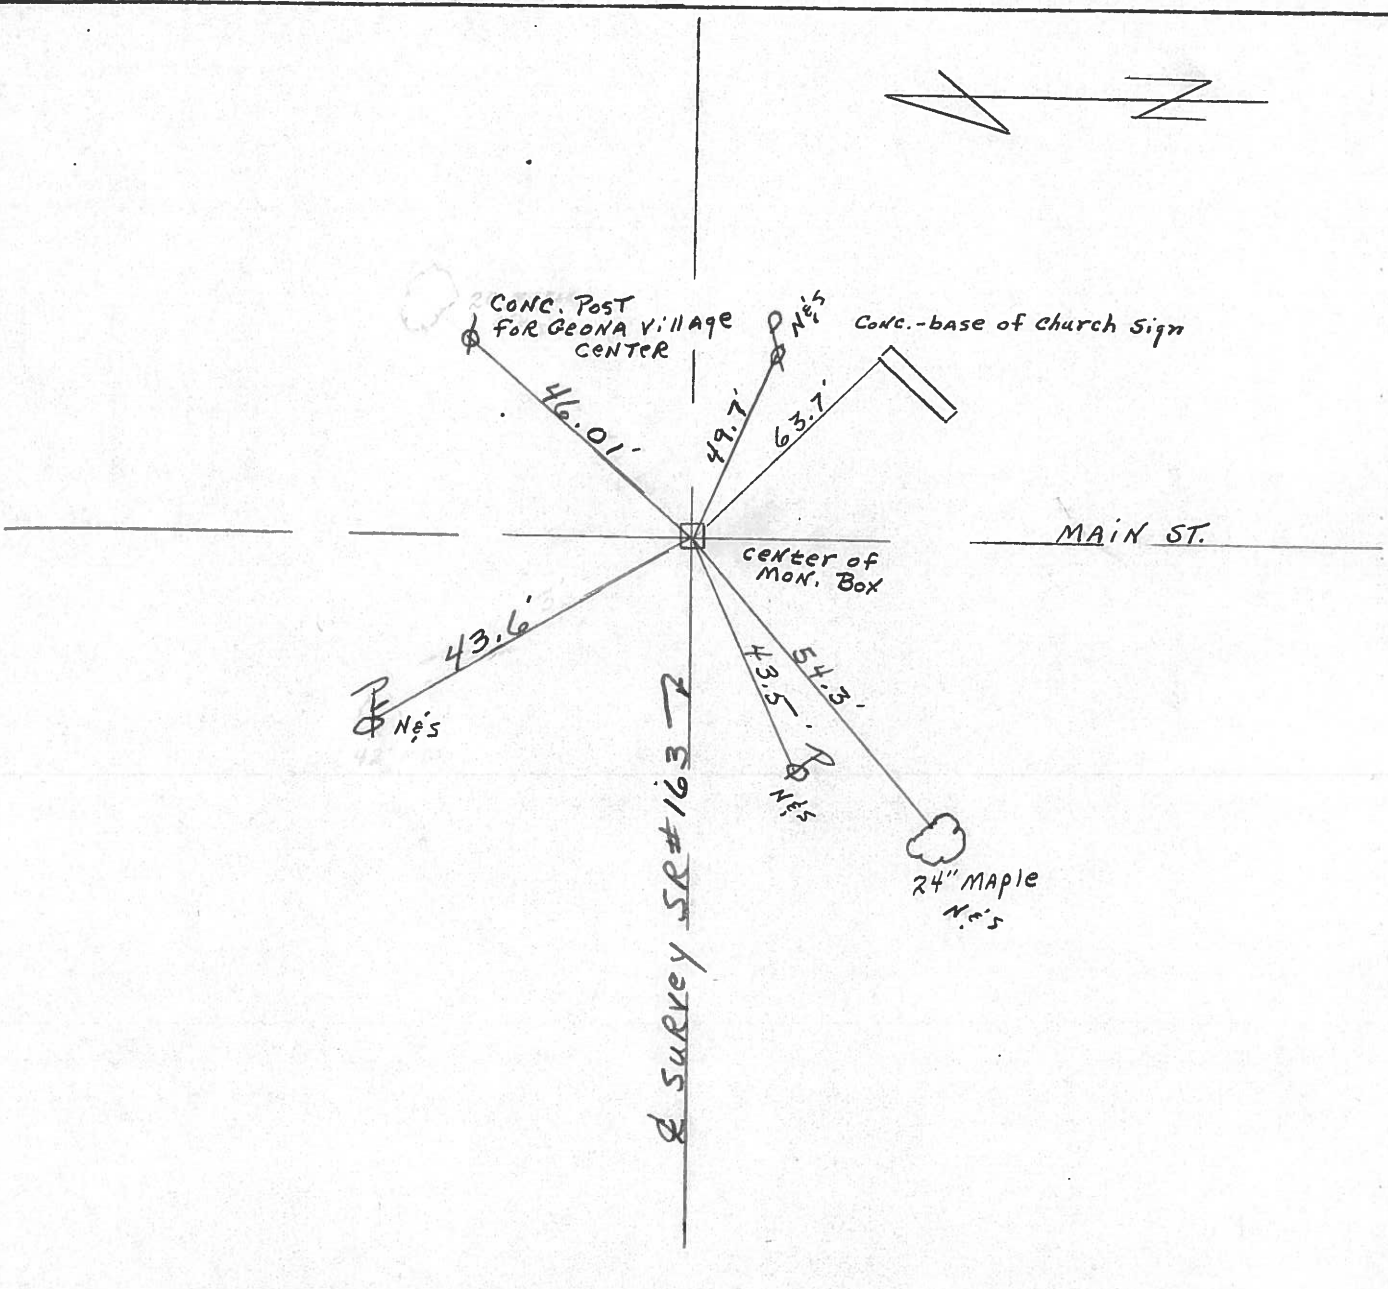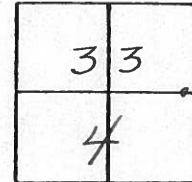

O.D.O.T. DISTRICT 2 SURVEY OFFICE

PERSONNEL _____

REFERENCE NO. 13

SHEET _____ OF _____

NOTES Hoffman

H.C. "

DATE 7-3-90

ROUTE SR 163

R.C. BARNHISEL

WEATHER CLEAR

COUNTY OTTAWA


TEMP. 85'

TOWNSHIP CLAY


SECTION 3

T 6 N R 13 E

TYPE MONUMENT IRON PIN - MONUMENT BOX
 ON SURFACE - BELOW Box at surface - PIN 8" down
 LEFT- & PAV'T. - RIGHT YES
 TO _____ EDGE PAVEMENT
 S.L.M. _____

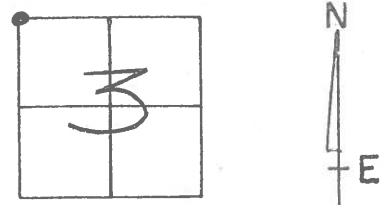


AT & OF
 BOTH PAVEMENTS

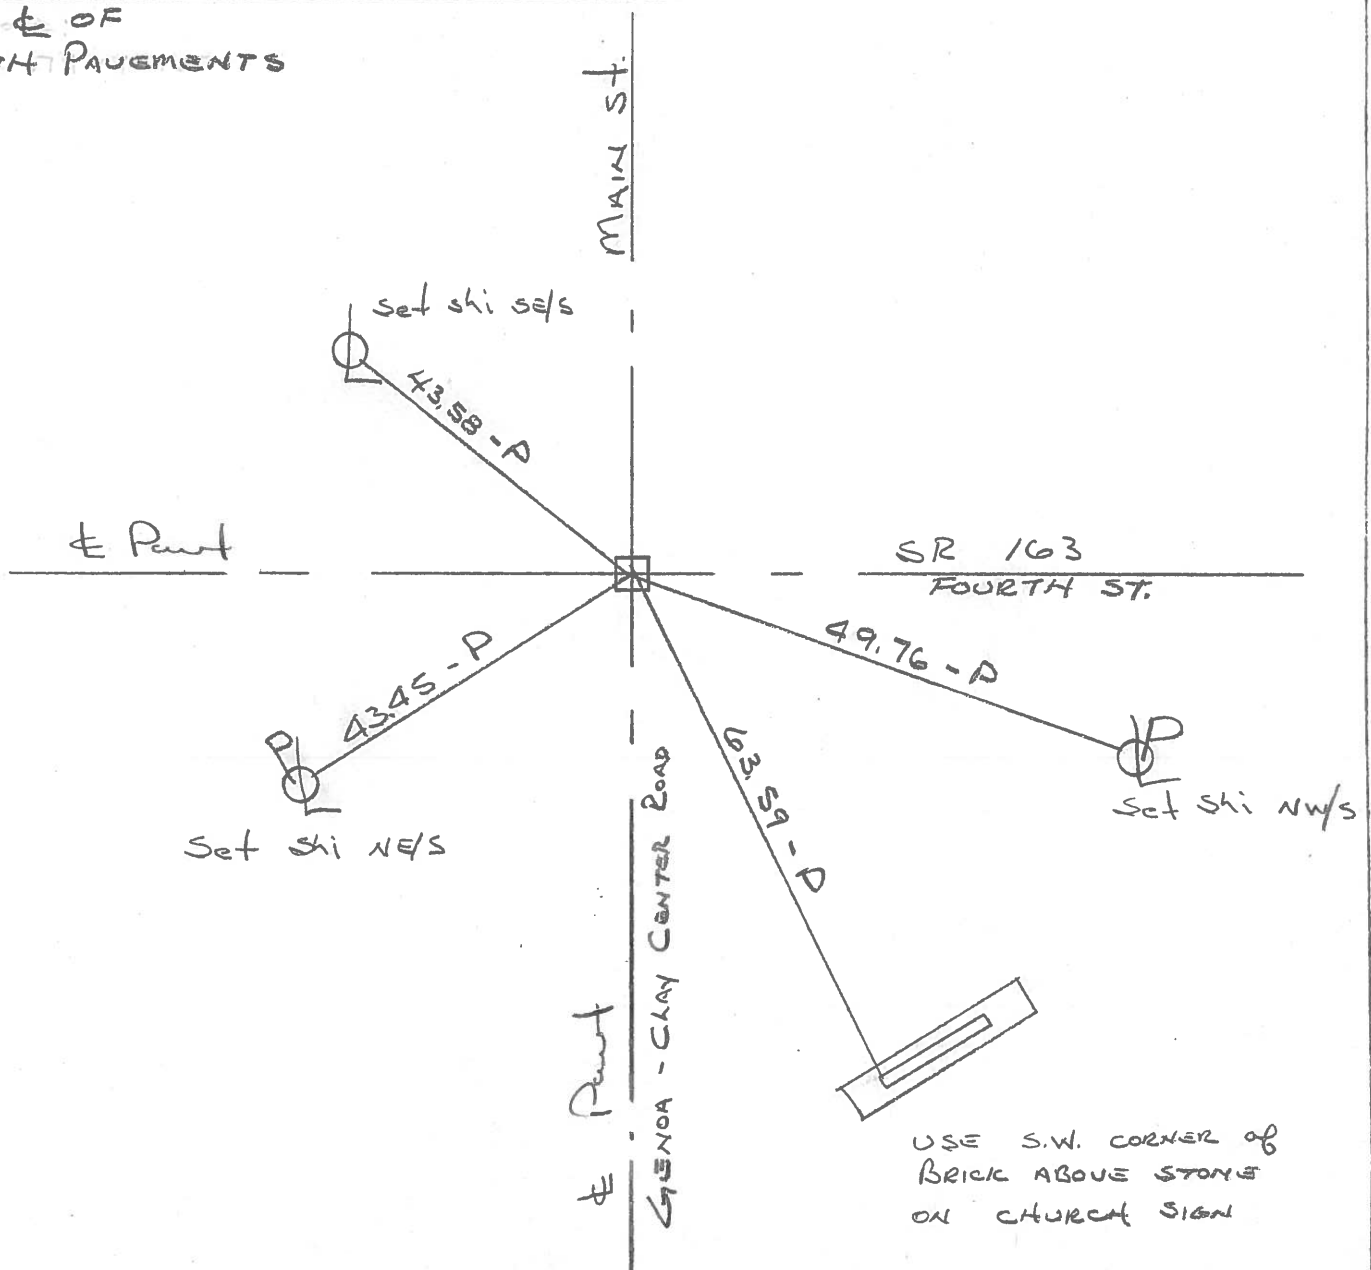

PERSONNEL	TITLE	PERSONNEL	TITLE

COUNTY Ottawa DATE 9-70
 S. R. 163 WEATHER _____
 SEC. Genoa TEMP. _____

DESCRIPTION Clay Twp. JOB NO. _____

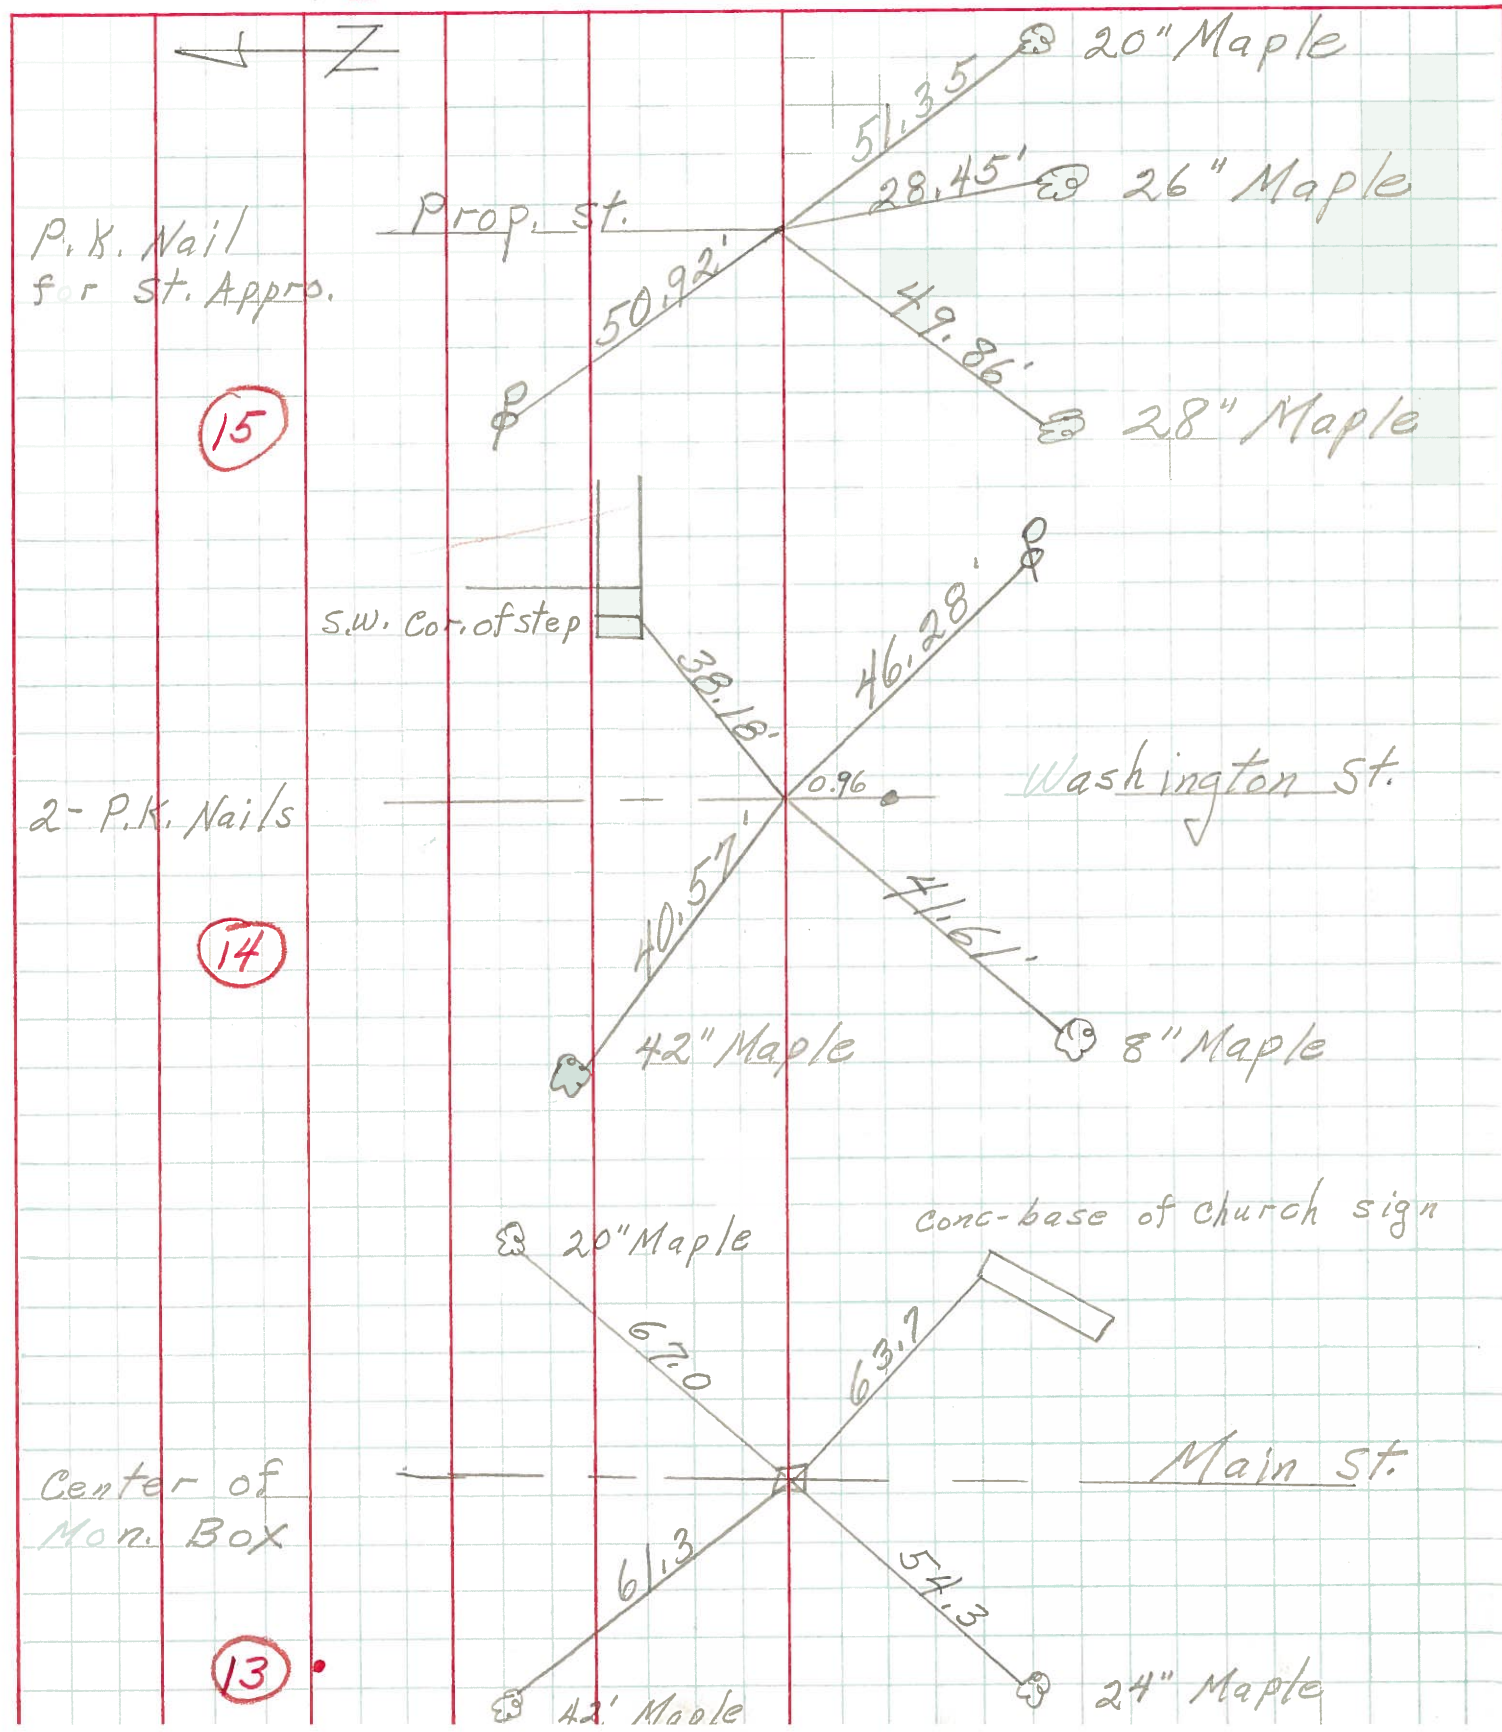

PERSONNEL	TITLE	PERSONNEL	TITLE	COUNTY	DATE
Schneider				Ottawa	3-13-70
Mosser				S. R. 163	WEATHER Fair
Potts				SEC. Genoa	TEMP. 30°

DESCRIPTION Ties for Control Points JOB NO. _____

