


O.D.O.T. DISTRICT 2 SURVEY OFFICE (USE ONLY)


PERSONNEL _____ REFERENCE NO. 20 SHEET 3 OF 20
 NOTES RHOADES DATE 4/29/13 ROUTE SR 163
 H.C. CODER WEATHER CLOUDY COUNTY OTTAWA
 R.C. LAU TEMP. 57° F TOWNSHIP CLAY
 SECTION 2
 T 6 N R 13 E

TYPE MONUMENT PK/WASHER
 ON SURFACE - ~~BELOW~~ ON
~~LEFT~~ - Q PAV'T - RIGHT 0.5'
10.0' TO RT. EDGE PAVEMENT
 S.L.M. 233+30.5

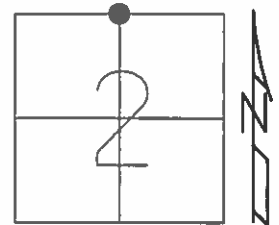

Grid: Northing: 674788.445 Easting: 1741336.555

RECORD:
 PK/WASHER ATOP
 NAIL/WASHER
 STA. 233+24.41
 7/23/85
 SET PK/WASHER
 9-24-1993 RCC
 FD. PK/WASHER
 7-26-2002 MB
 FD. PK/WASHER
 1-03-12 MC
 SET MAG/WASHER
 REF20
 6-06-2013
 FD MONBOX
 NEWREF20
 5-01-14 TMR

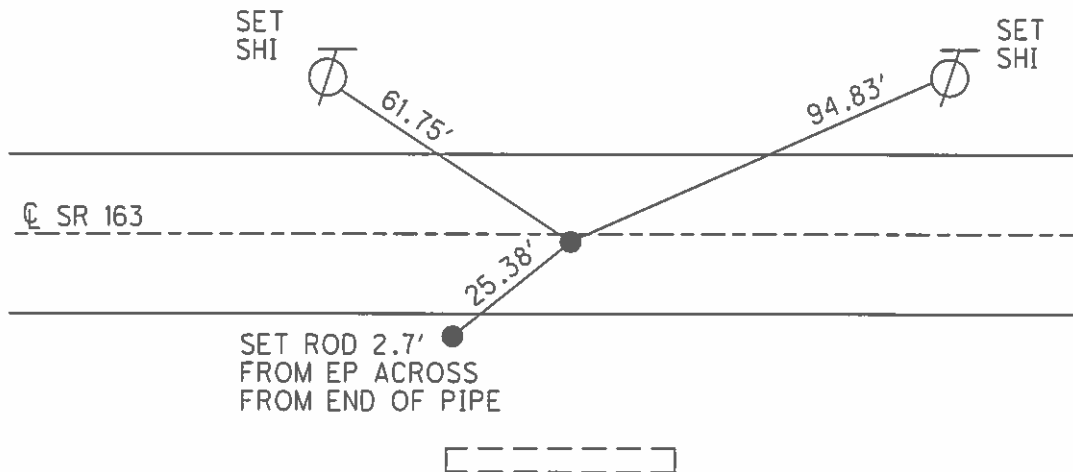

O.D.O.T. DISTRICT 2 SURVEY OFFICE

PERSONNEL

REFERENCE NO. 20

SHEET 1 OF 24

NOTES RIPPLE

H.C. BARBOUR

DATE 6-15-1993

ROUTE #163

R.C. GEYMAN

WEATHER SUNNY

COUNTY OTTAWA

TEMP. 75°

TOWNSHIP CLAY

SECTION 2

T 6 N R 13 E


TYPE MONUMENT PK/WASHER

ON SURFACE - BELOW ON

LEFT - 0 PAV'T. - RIGHT 0.5'

10' TO Rt. EDGE PAVEMENT

S.L.M. 233+30.5

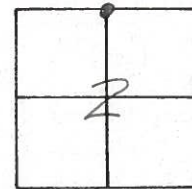


RECORD: 7-23-1985

PK/WASHER ATOP

NAIL/WASHER

STA. 233+24.41

SET PK/WASHER
9-24-1993
RCC

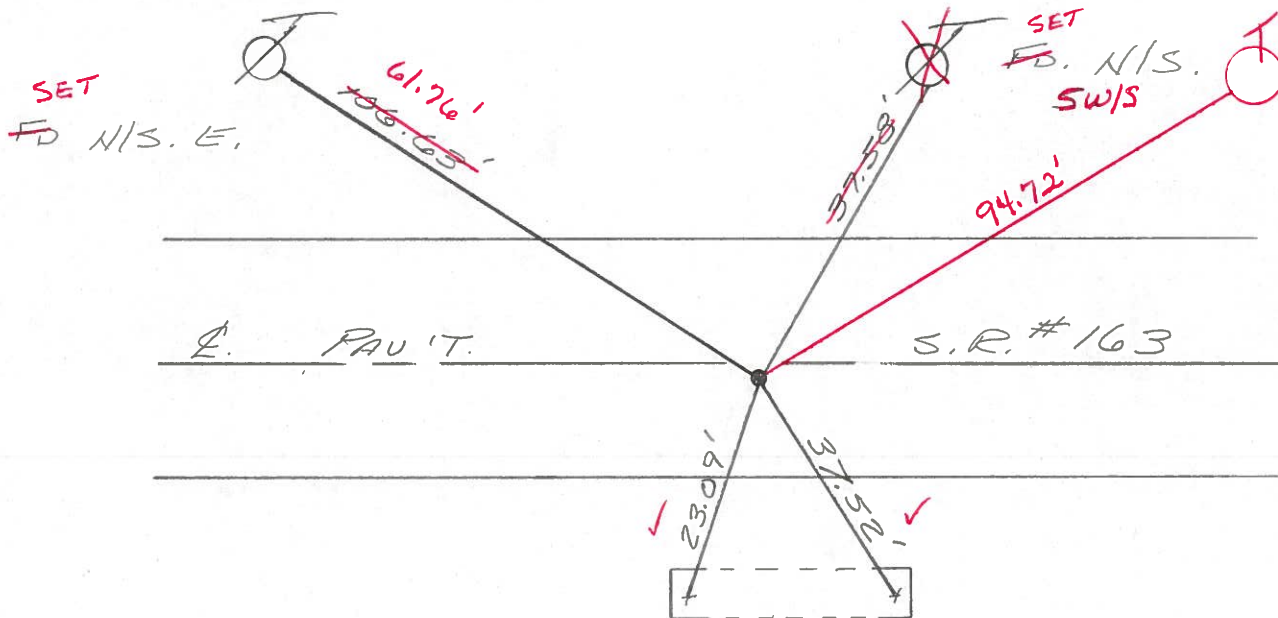

CUT $4\frac{1}{2}$ IN
12" CONC. PIPE

Fd PK/washer
7-26-02
MB

Preventive Maintenance
Microsurfaced 2002
Existing Point Uncovered
Date 11-29-02

Resurfaced 1993

O.D.O.T. DISTRICT 2 SURVEY OFFICE

2

PERSONNEL


NOTES Cronin
H.C. Ripple
R.C. Barbour
Geyman

REFERENCE NO. 20
DRAWN 7/30/85
DATE 7/23/85
WEATHER SUNN
TEMP. 71°

SHEET OF


ROUTE 163
COUNTY OTTAWA
TOWNSHIP CLAY
SECTION 2
T. 6 N. R. 13 E

TYPE MONUMENT P.K. & WASHER atop NAIL
ON SURFACE - BELOW WASHER - ON SURFACE
LEFT - & PAINT - RIGHT 0.5' Lt. & PAINT
TO EDGE PAVEMENT
S.L.M. 4.42

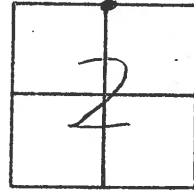

S.R. # 163

233+24.41

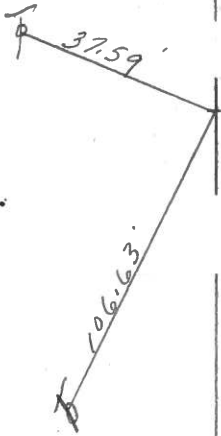


PERSONNEL TITLE PERSONNEL TITLE

COUNTY Ottawa DATE 9-70

S. R. 163 WEATHER

SEC. 2 & 35 TEMP.

DESCRIPTION Clay Twp. LEFT CENTER LINE RIGHT JOB NO.

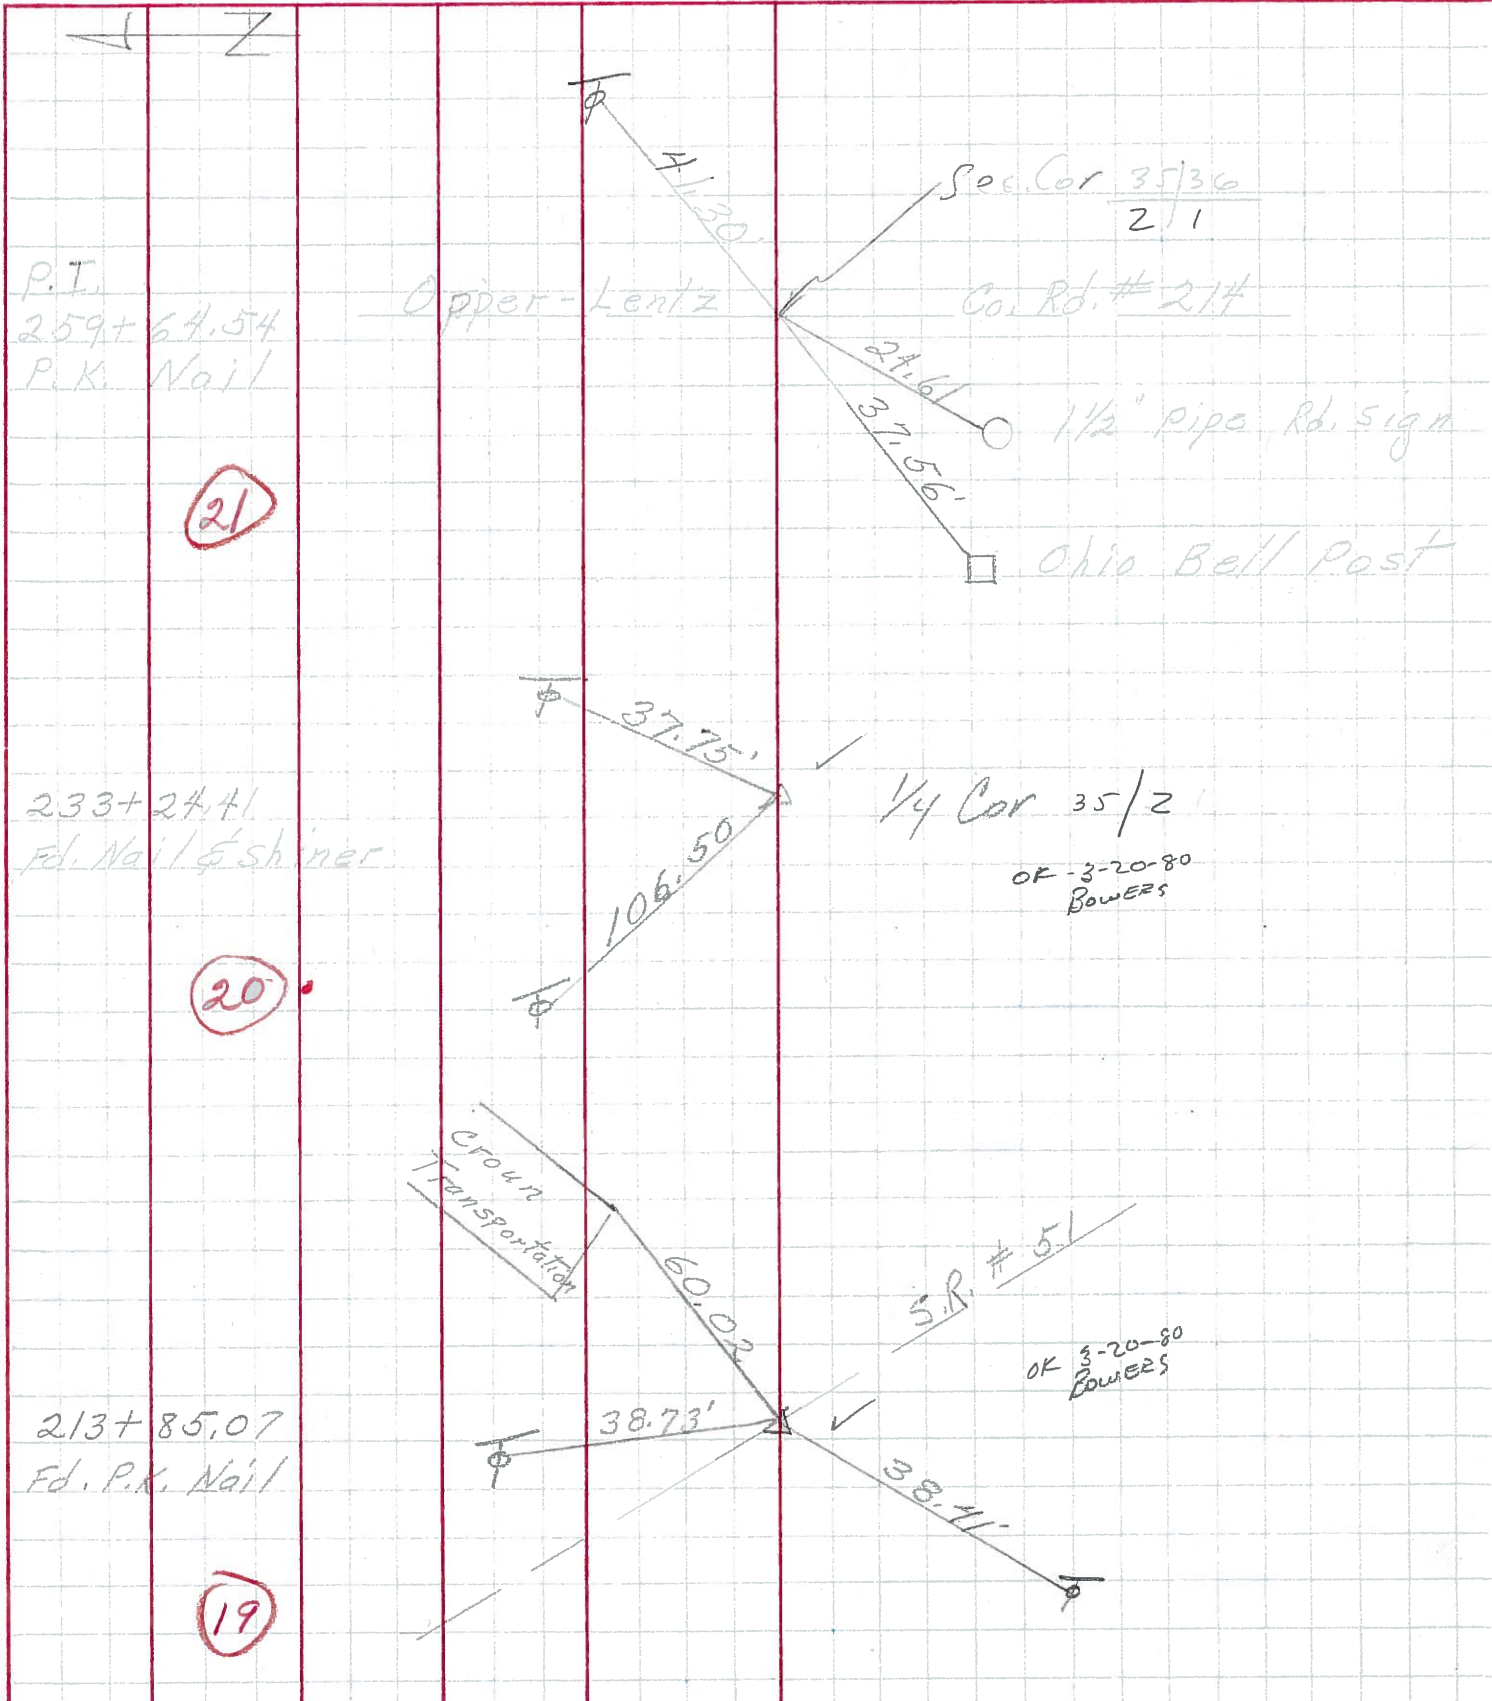

PERSONNEL TITLE PERSONNEL TITLE

COUNTY Ottawa DATE Jan 1961

S. R. 163 WEATHER

SEC. 3.24 TEMP.

DESCRIPTION Control Points JOB NO.

LEFT CENTER LINE RIGHT

