


O.D.O.T. DISTRICT 2 SURVEY OFFICE (USE ONLY)


PERSONNEL _____ REFERENCE NO. 21 SHEET 4 OF 20
 NOTES RHOADES DATE 5/6/13 ROUTE SR 163
 H.C. CODER WEATHER FAIR COUNTY OTTAWA
 R.C. ROUSOS TEMP. 69° F TOWNSHIP CLAY
 _____ SECTION 2
 _____ T 6 N R 13 E

TYPE MONUMENT P.K./WASHER
 ON SURFACE - ~~BELOW~~ ON _____
~~LEFT~~ - Q PAV'T - RIGHT 0.5'
10.0' TO RT. EDGE PAVEMENT
 S.L.M. 259+77

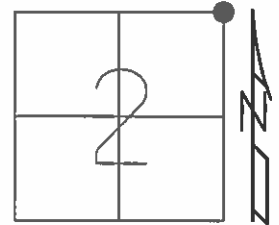

Grid: Northing: 674807.920 Easting: 1743976.375

RECORD: P.I.
 STA: 259+64.54
 PK/WASHER ATOP
 PK NAIL 7-23-1985
 SET PK/WASHER
 9-24-1993 RCC
 FD. PK/WASHER
 7-26-2002 MB
 FD. PK/WASHER
 1-03-12 MC
 SET MAG/WASHER
 REF21
 6-06-2013
 FD MON BOX
 NEWREF215-01-14 TMR

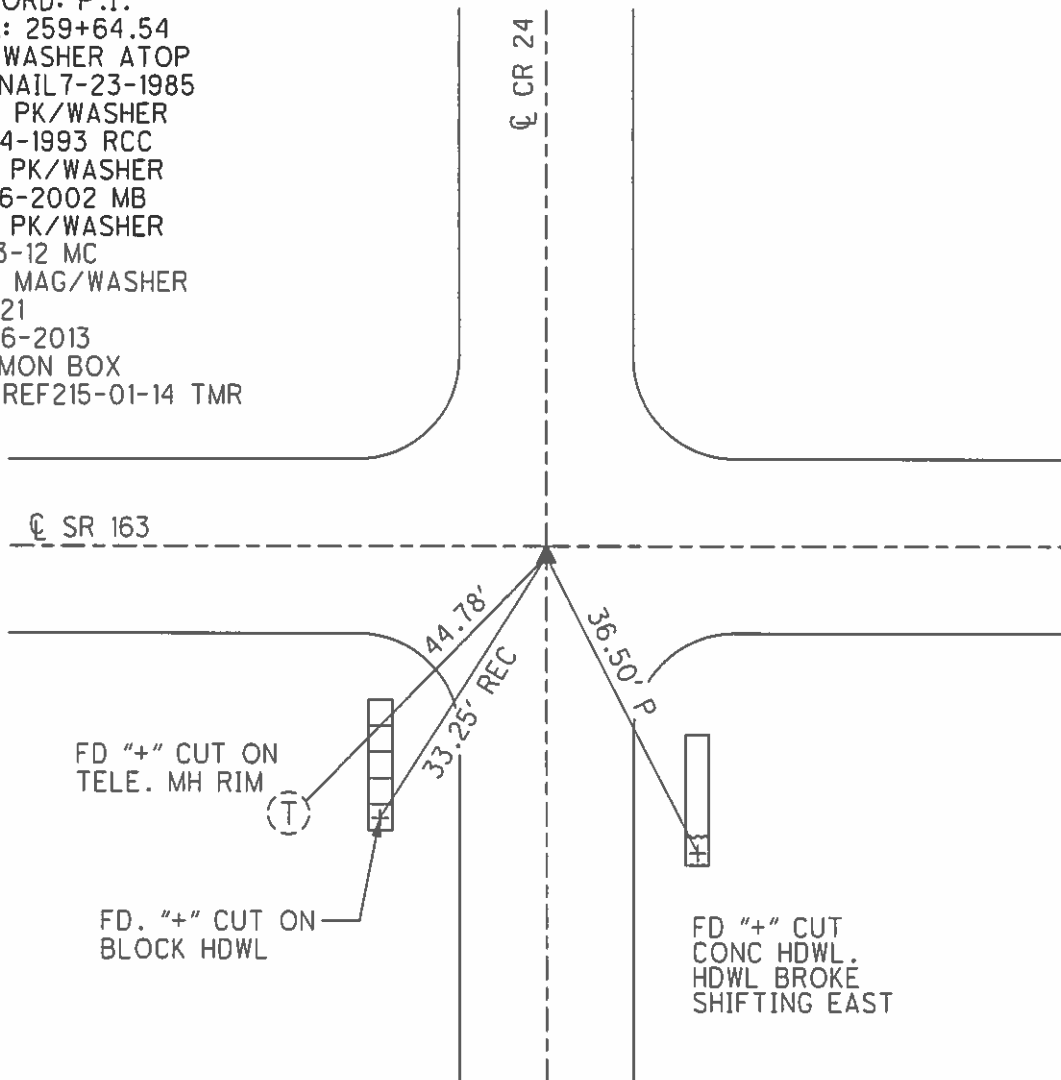

FD "+" CUT ON TELE. MH RIM

FD. "+" CUT ON BLOCK HDWL

FD "+" CUT CONC HDWL. HDWL BROKE SHIFTING EAST

O.D.O.T. DISTRICT 2 SURVEY OFFICE

PERSONNEL

REFERENCE NO. 21

SHEET 2 OF 24

NOTES RIPPLE

H.C. BARBOUR

R.C. GEYMAN

DATE 6-15-1993

WEATHER SUNNY

TEMP. 75°

ROUTE #163

COUNTY OTTAWA

TOWNSHIP CLAY

SECTION 2

T G N R 13 E


TYPE MONUMENT BROKEN P.K. NAIL

ON SURFACE - ~~BELOW~~ ON

~~10' TO RT. EDGE PAV'T.~~ - RIGHT 0.5'

10' TO RT. EDGE PAVEMENT

S.L.M. 259+77

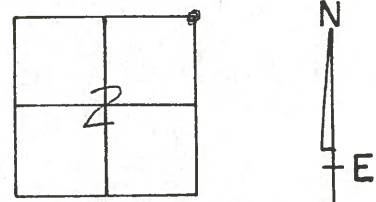

RECORDED: 7-23-1985

P.I.

STA. 259+64.54

PK/WASHER ATOP

P.K.

SET PK/WASHER
9-24-1993
RCC

~~SET~~ ^{Fd} N/S.
W. EDGE
C.R.D.

~~FD N/S.~~
S.



BLOCK
HDWL.

CONC.
HDWL.
HDWL BROKE &
SHIFTED EAST

FD "4" CUTS

Fd PK/washer
7-26-02
MB

Preventive Maintenance
Microsurfaced 2002
Existing Point Uncovered
Date 11-29-02

O.D.O.T. DISTRICT 2 SURVEY OFFICE

③

PERSONNEL

NOTES CROVIN
 H.C. RIPPLE
 R.C. BARBOUR
GEYMAN



REFERENCE NO. 21

DRAWN 7/30/85
 DATE 7/23/85
 WEATHER SUNNY
 TEMP. 71°

SHEET _____ OF _____

ROUTE 163
 COUNTY OTTAWA
 TOWNSHIP CLAY
 SECTION 2
T 6 N R 13 E

TYPE MONUMENT PK. & WASHER AT OP PK.
 ON SURFACE - BELOW ON SURFACE
 LEFT - & PAV'T. - RIGHT 0.5' RT. & PAVMT
 TO _____ EDGE PAVEMENT
 S.L.M. 4.92

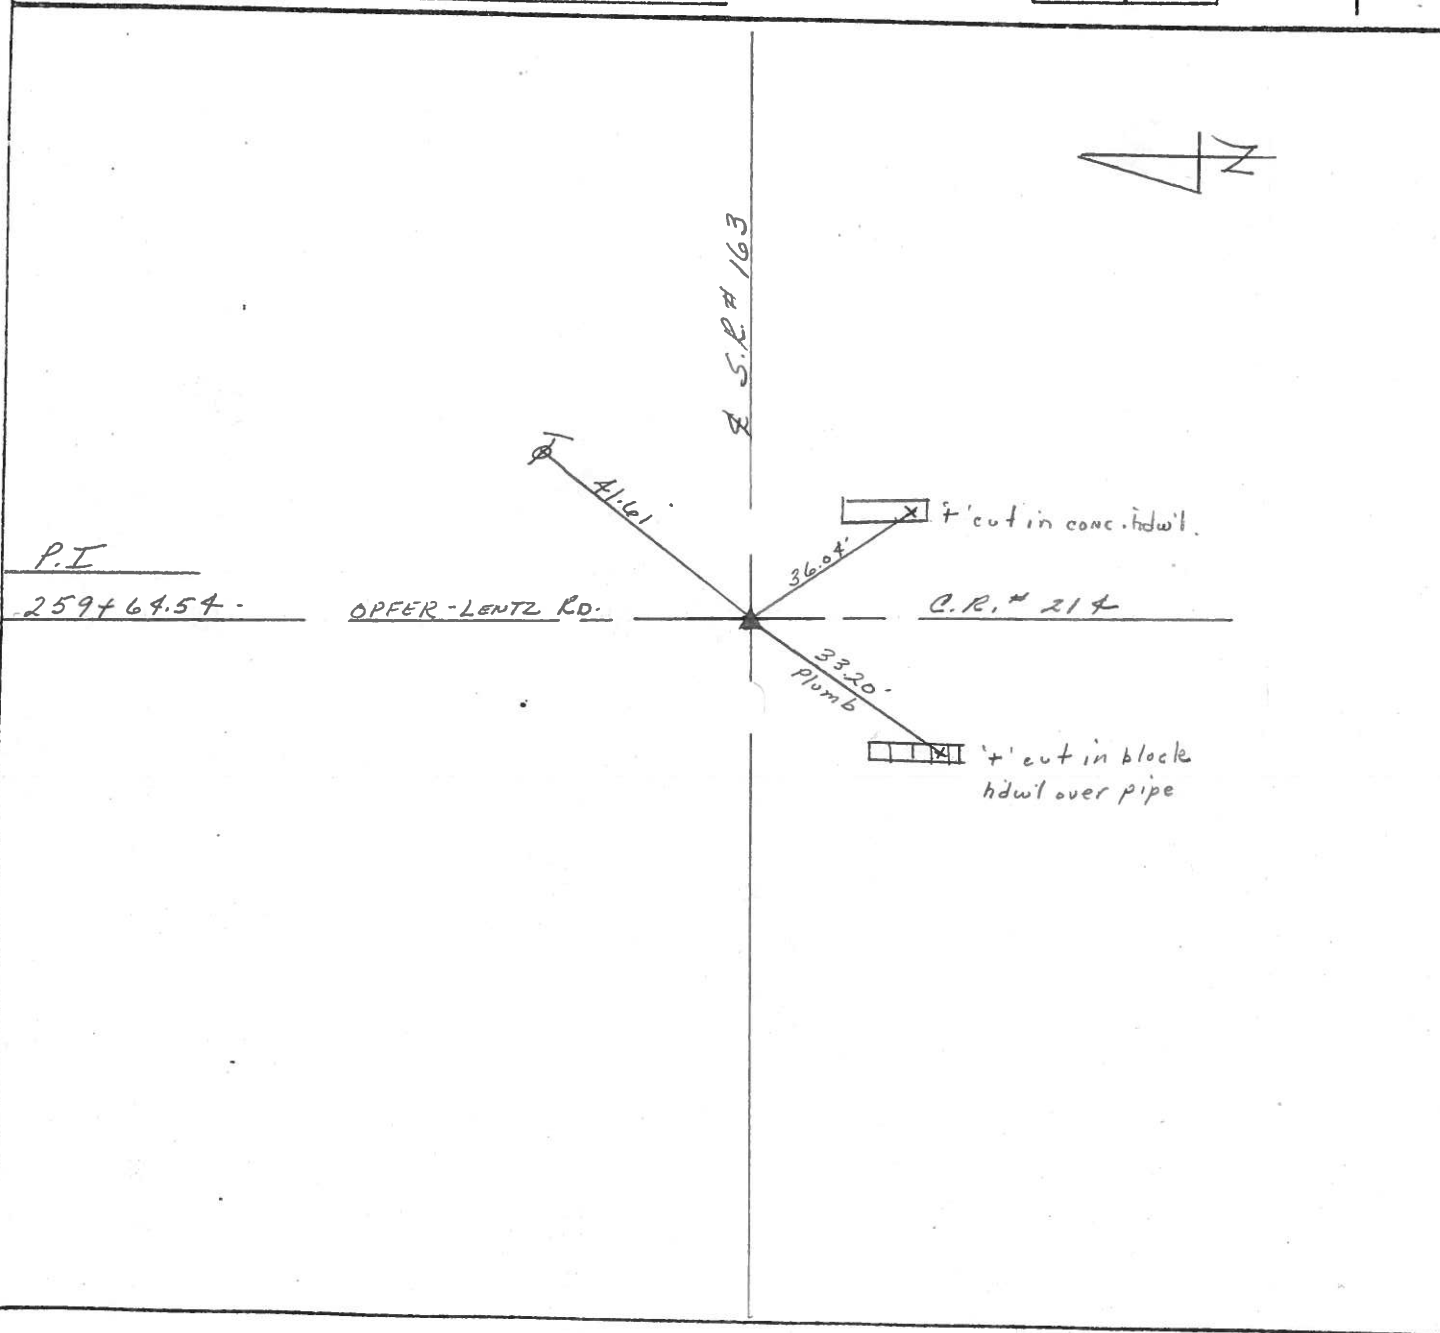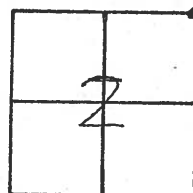


PERSONNEL TITLE PERSONNEL TITLE

COUNTY Ottawa DATE 9-70

S. R. 163 WEATHER

SEC. 2 & 35 TEMP.

DESCRIPTION Clay Twp. LEFT CENTER LINE RIGHT JOB NO.

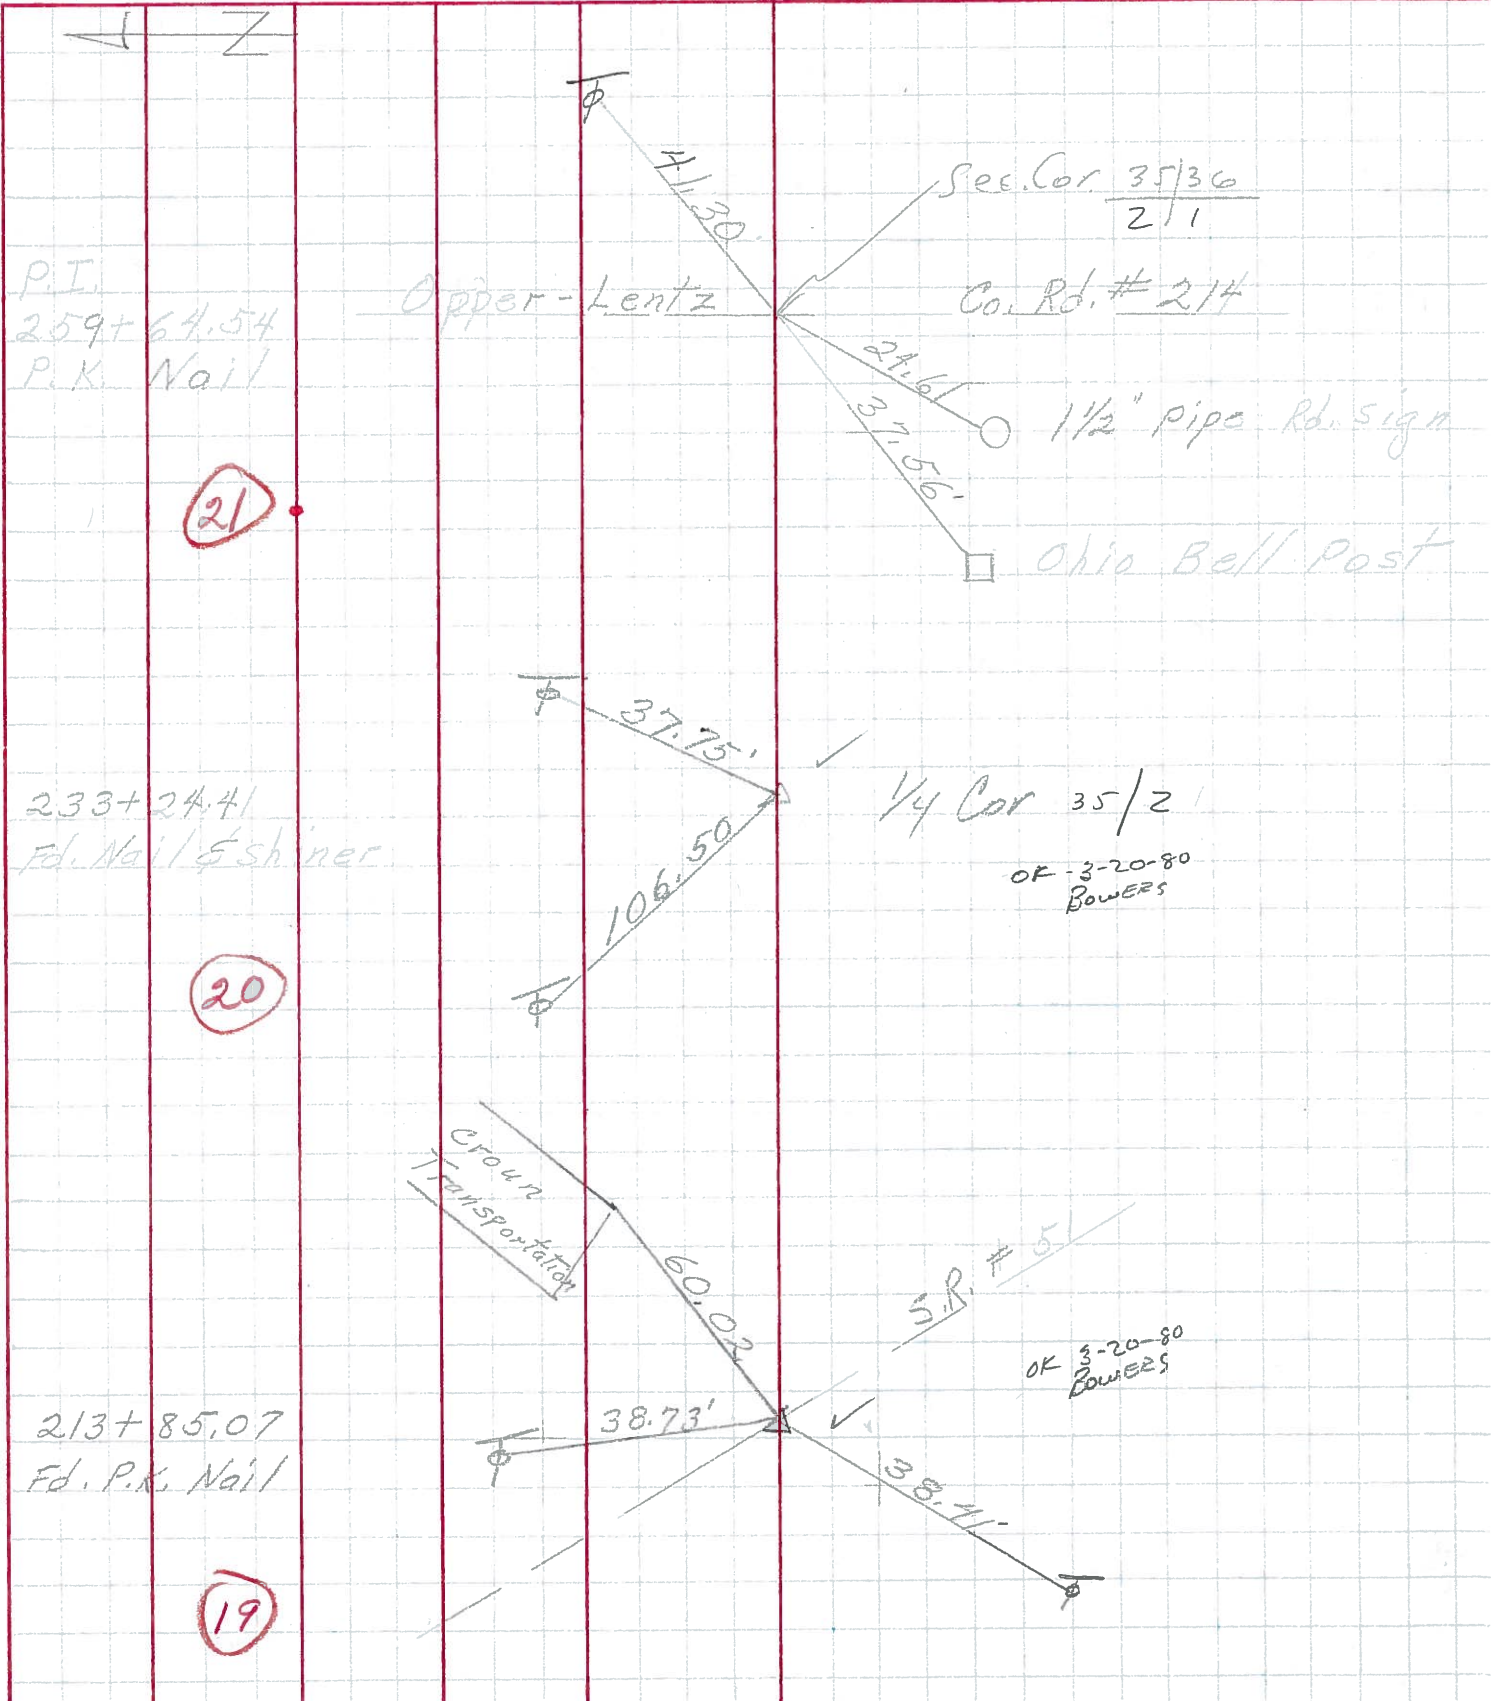

PERSONNEL TITLE PERSONNEL TITLE

COUNTY Ottawa DATE Jan 196

S. R. 163 WEATHER

SEC. 3.24 TEMP.

DESCRIPTION control points JOB NO.

LEFT

CENTER LINE

RIGHT

