


O.D.O.T. DISTRICT 2 SURVEY OFFICE (USE ONLY)

PERSONNEL \_\_\_\_\_ REFERENCE NO. 29A SHEET 14 OF 20  
 NOTES RHOADES DATE 5/15/13 ROUTE SR 163  
 H.C. CODER WEATHER WINDY COUNTY OTTAWA  
 R.C. ROUSOS TEMP. 78° F TOWNSHIP HARRIS  
 \_\_\_\_\_ SECTION 5  
 \_\_\_\_\_ T6 N R14 E


TYPE MONUMENT MONBOX  
 ON SURFACE - ~~BELOW~~ ON  
 LEFT - ☉ PAV'T - RIGHT -  
- TO - EDGE PAVEMENT  
 S.L.M. 421+67

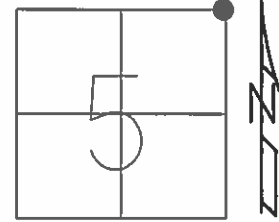

Grid: Northing: 674797.273 Easting: 1760138.634

DIST. 29-29A = 4.58'

RECORD:  
 SET MON. BOX @ SECTION CORNERS  
 OVER FND 2-3/4" HEX HEAD I PIN  
 11" UNDER PAVT.; OVER  
 RR SPK 22" BELOW; OVER  
 STONE 9"X6"X8" HARD HEAD  
 STONE 26" BELOW  
 5-15-20, RGN  
 FD MAG NAIL, MON BOX DID  
 NOT GET RAISED WITH LAST  
 PAVING.  
 7-26-02, MB  
 FD MON BOX AND PK/WASHER  
 1-3-12, M.C.

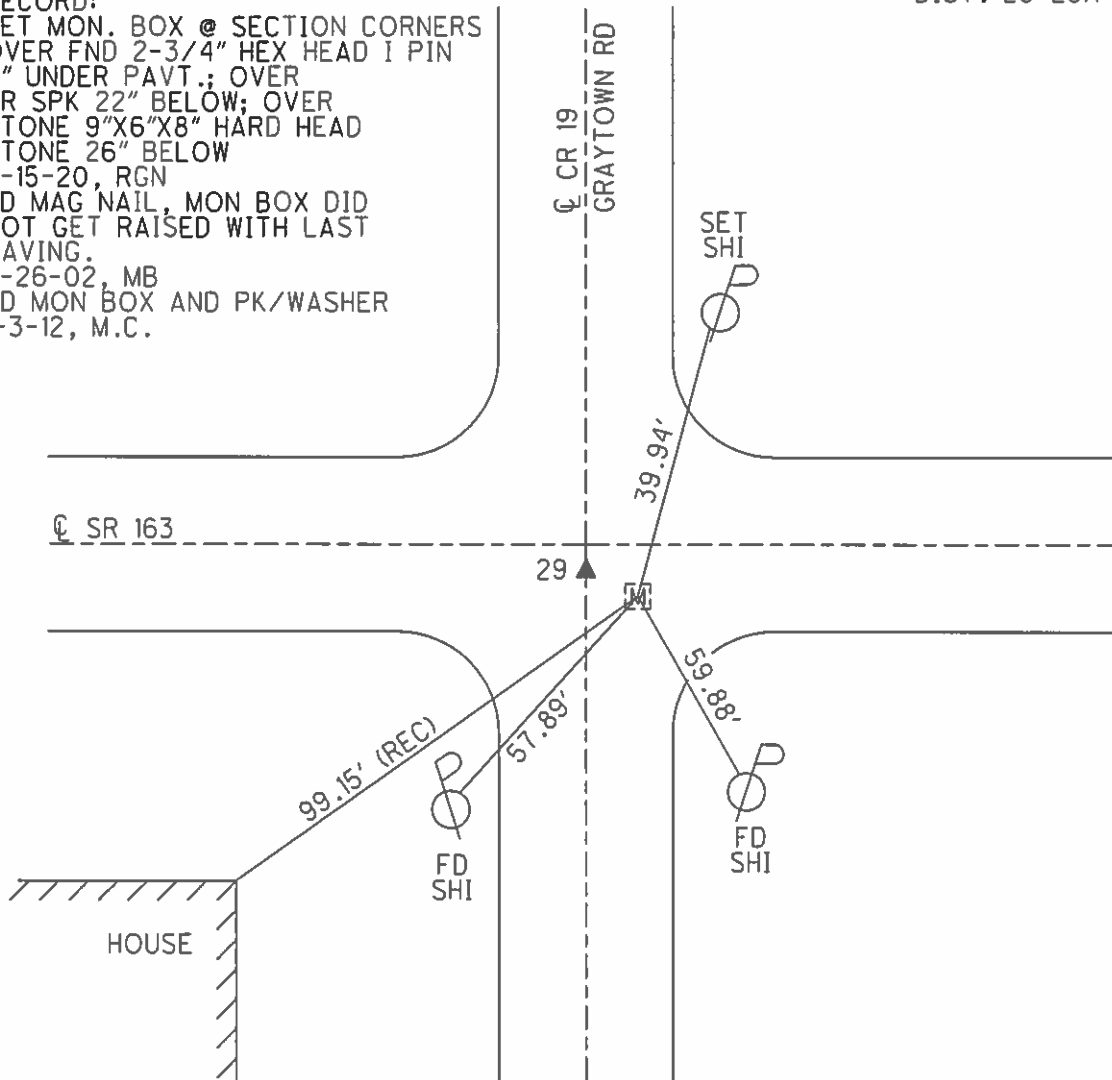

PERSONNEL TITLE PERSONNEL TITLE

Schneider \_\_\_\_\_ Potts \_\_\_\_\_

COUNTY Ottawa DATE 12-12-68  
11-16-66

Masser \_\_\_\_\_

S. R. 163 WEATHER Cloudy


Barbour \_\_\_\_\_

SEC. 3.24 TEMP. 30°

Redding \_\_\_\_\_

DESCRIPTION \_\_\_\_\_ JOB NO. \_\_\_\_\_

LEFT CENTER LINE RIGHT

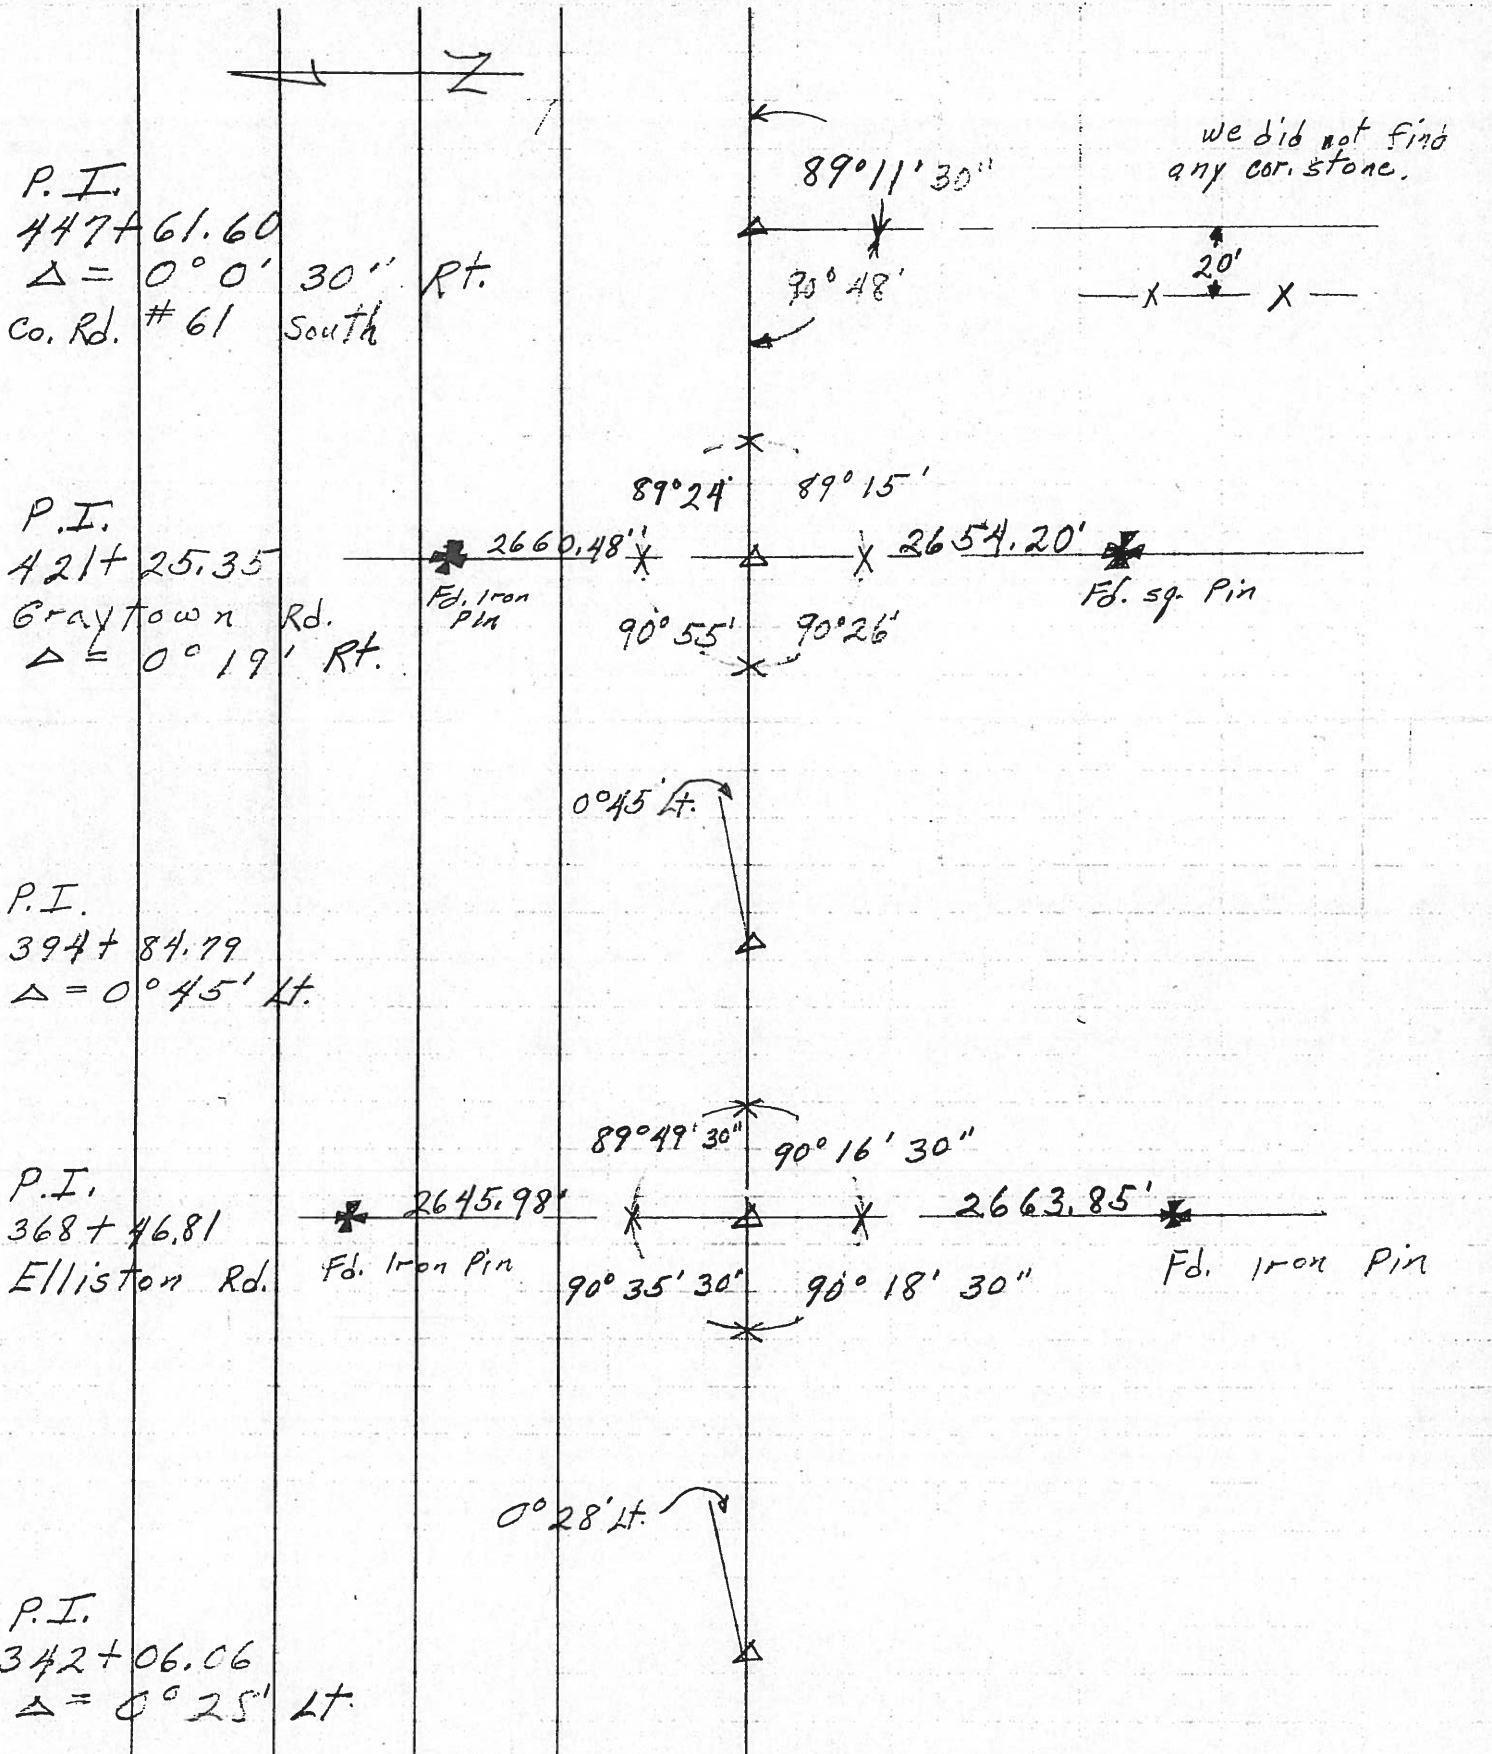

PERSONNEL	TITLE	PERSONNEL	TITLE
Hawk		Kowaleski	
Ash			
Krabill			
Peltier			

COUNTY Ottawa DATE 5-3-50  
 S. R. #163 WEATHER Fair  
 SEC. Sec. D. & G. TEMP. 70°

DESCRIPTION \_\_\_\_\_ JOB NO. \_\_\_\_\_

